
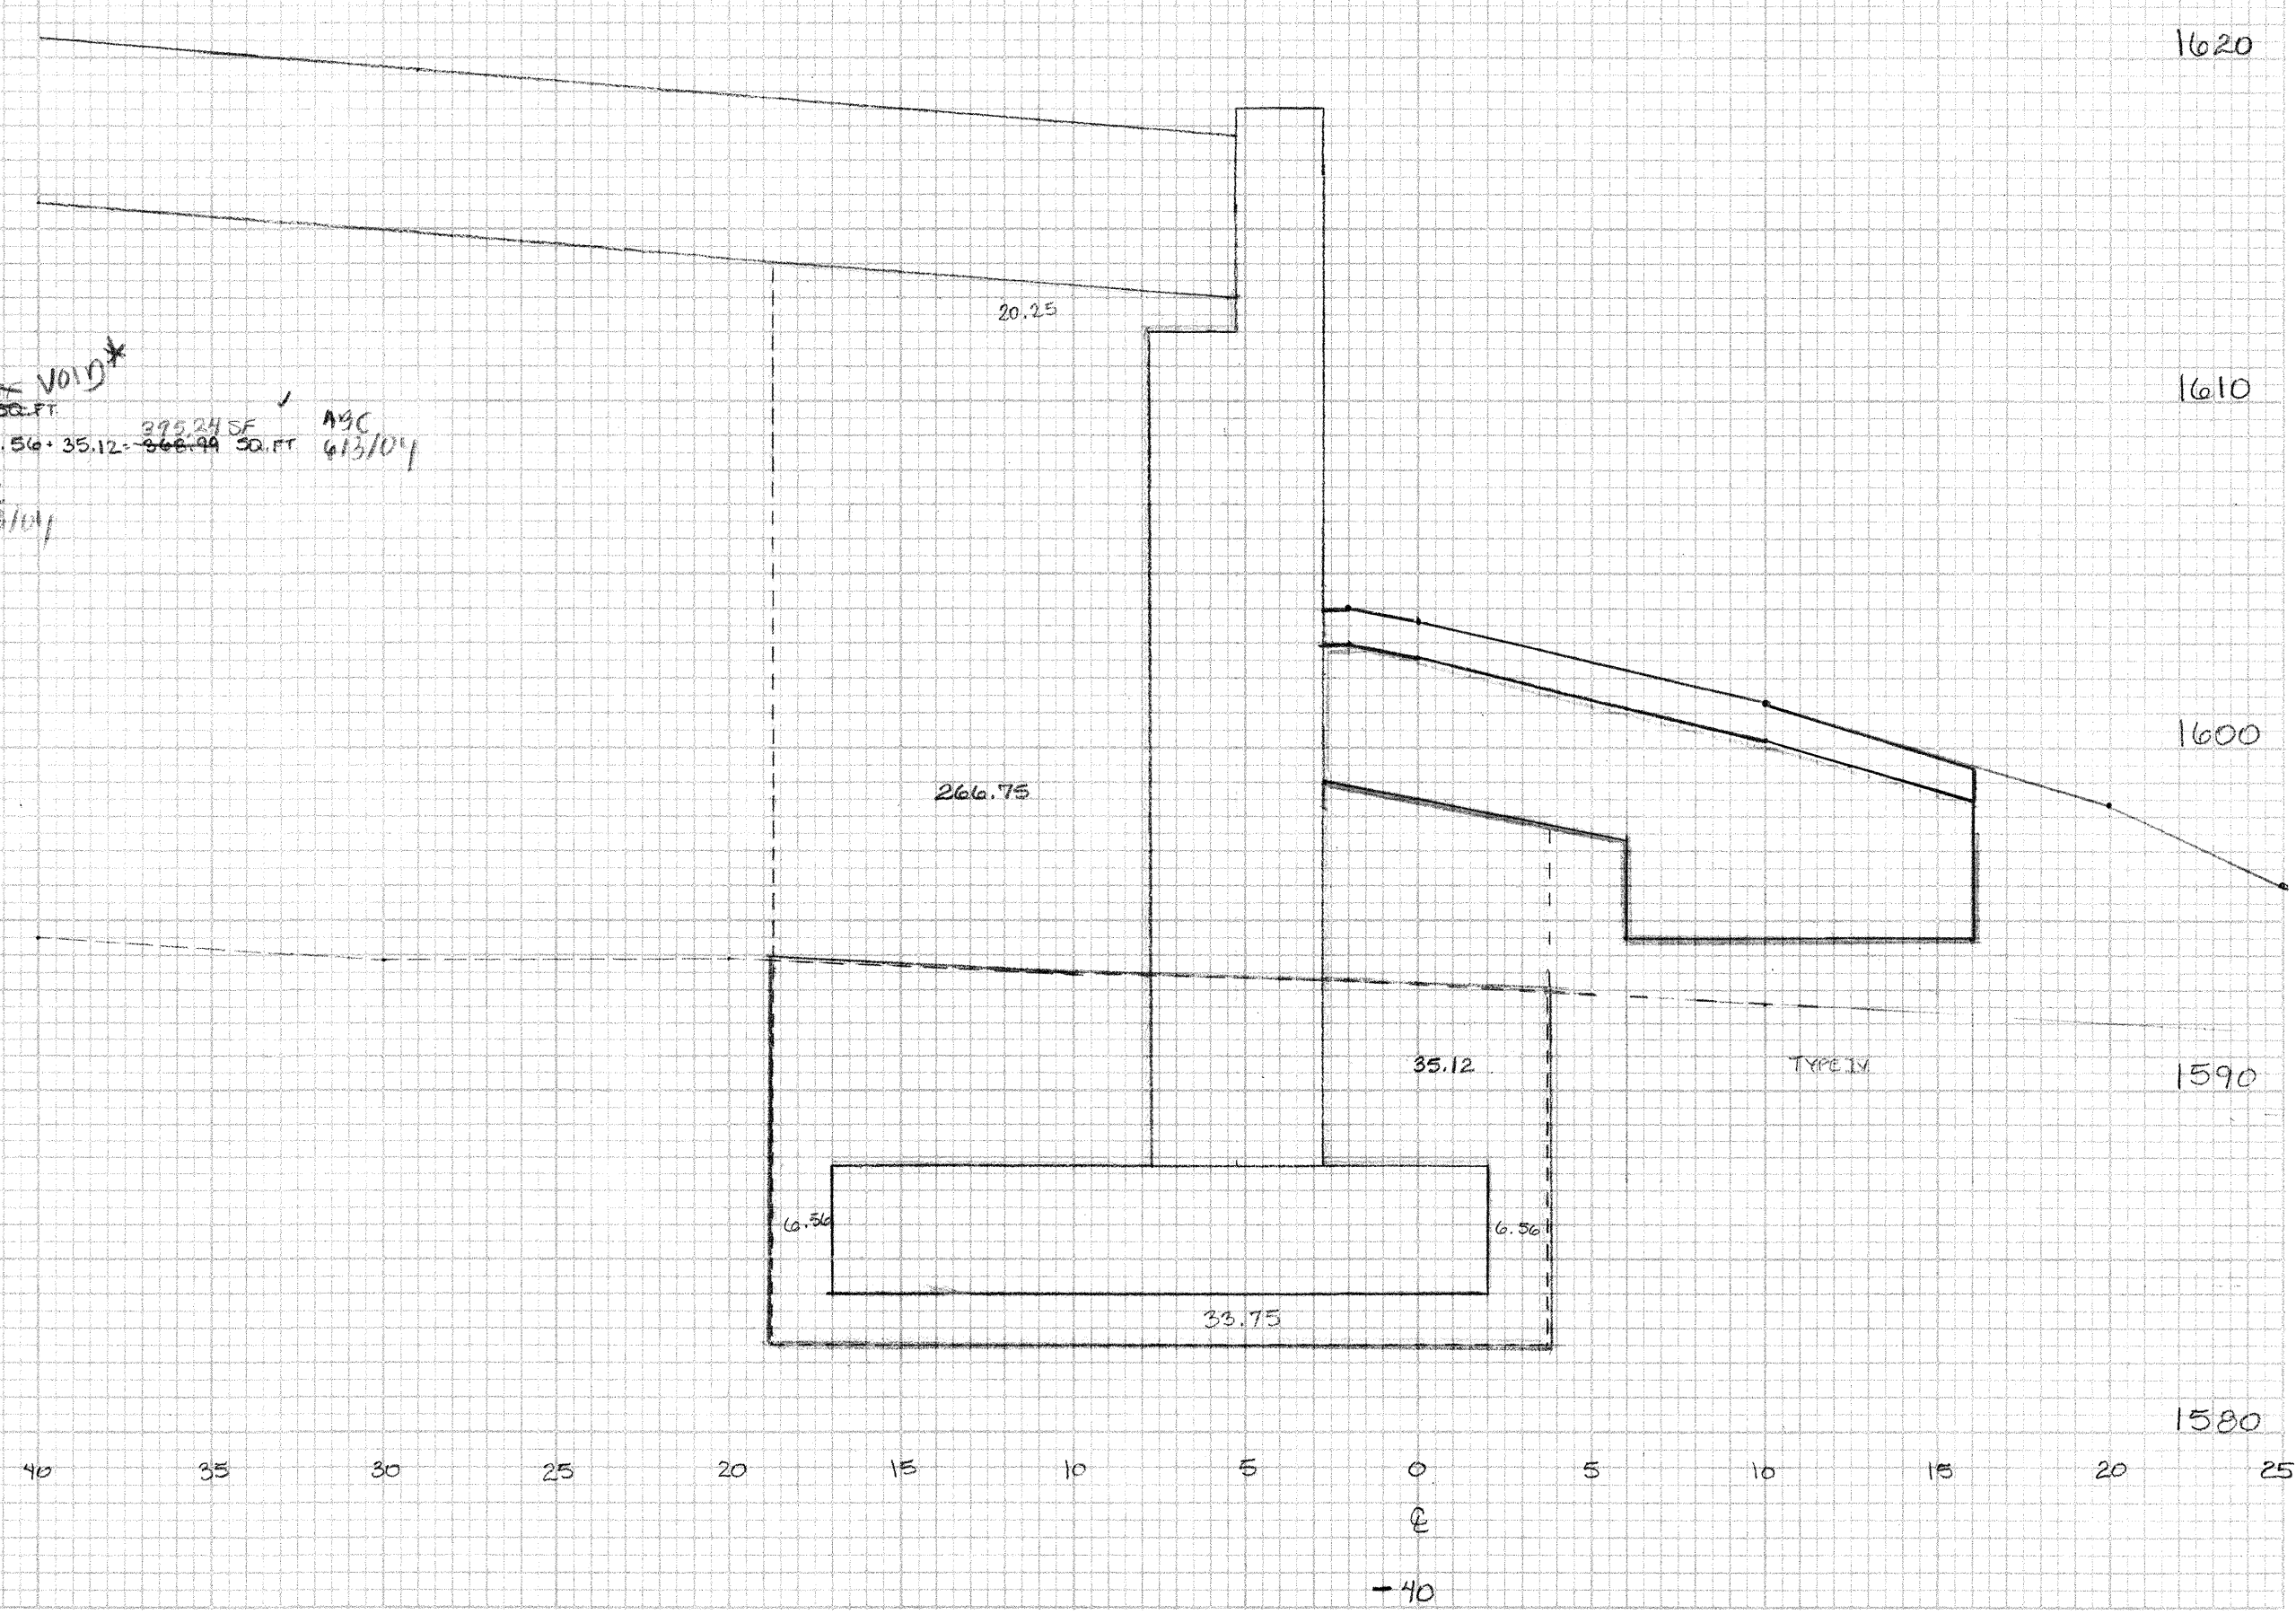
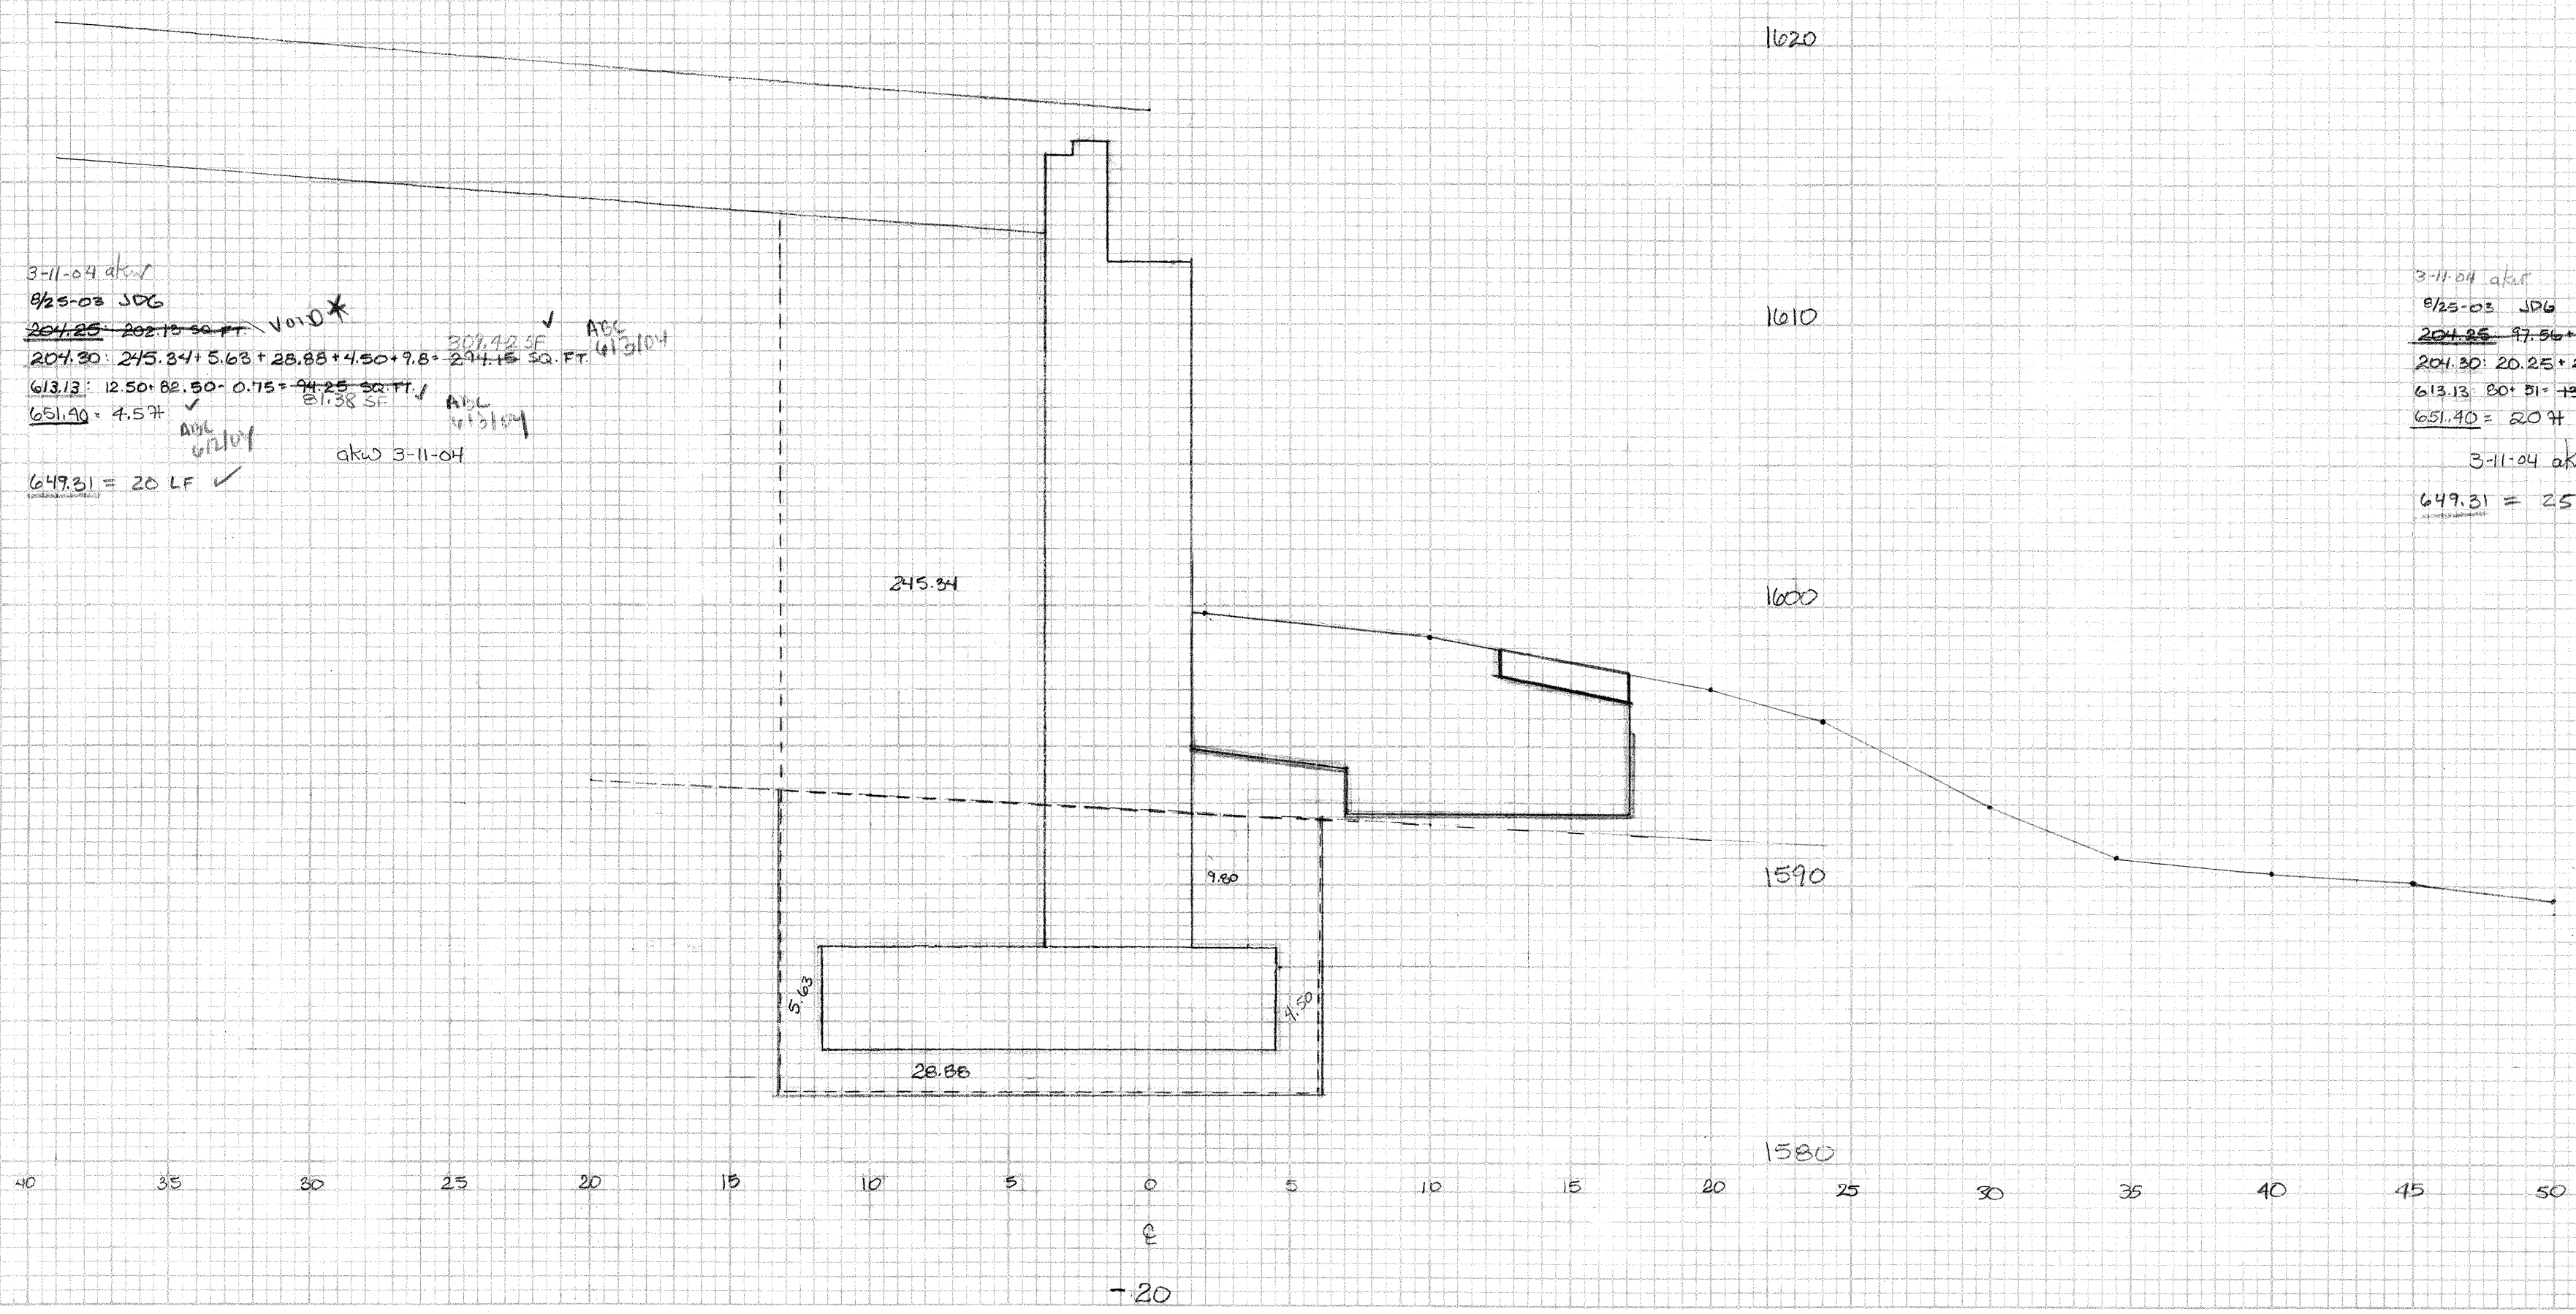
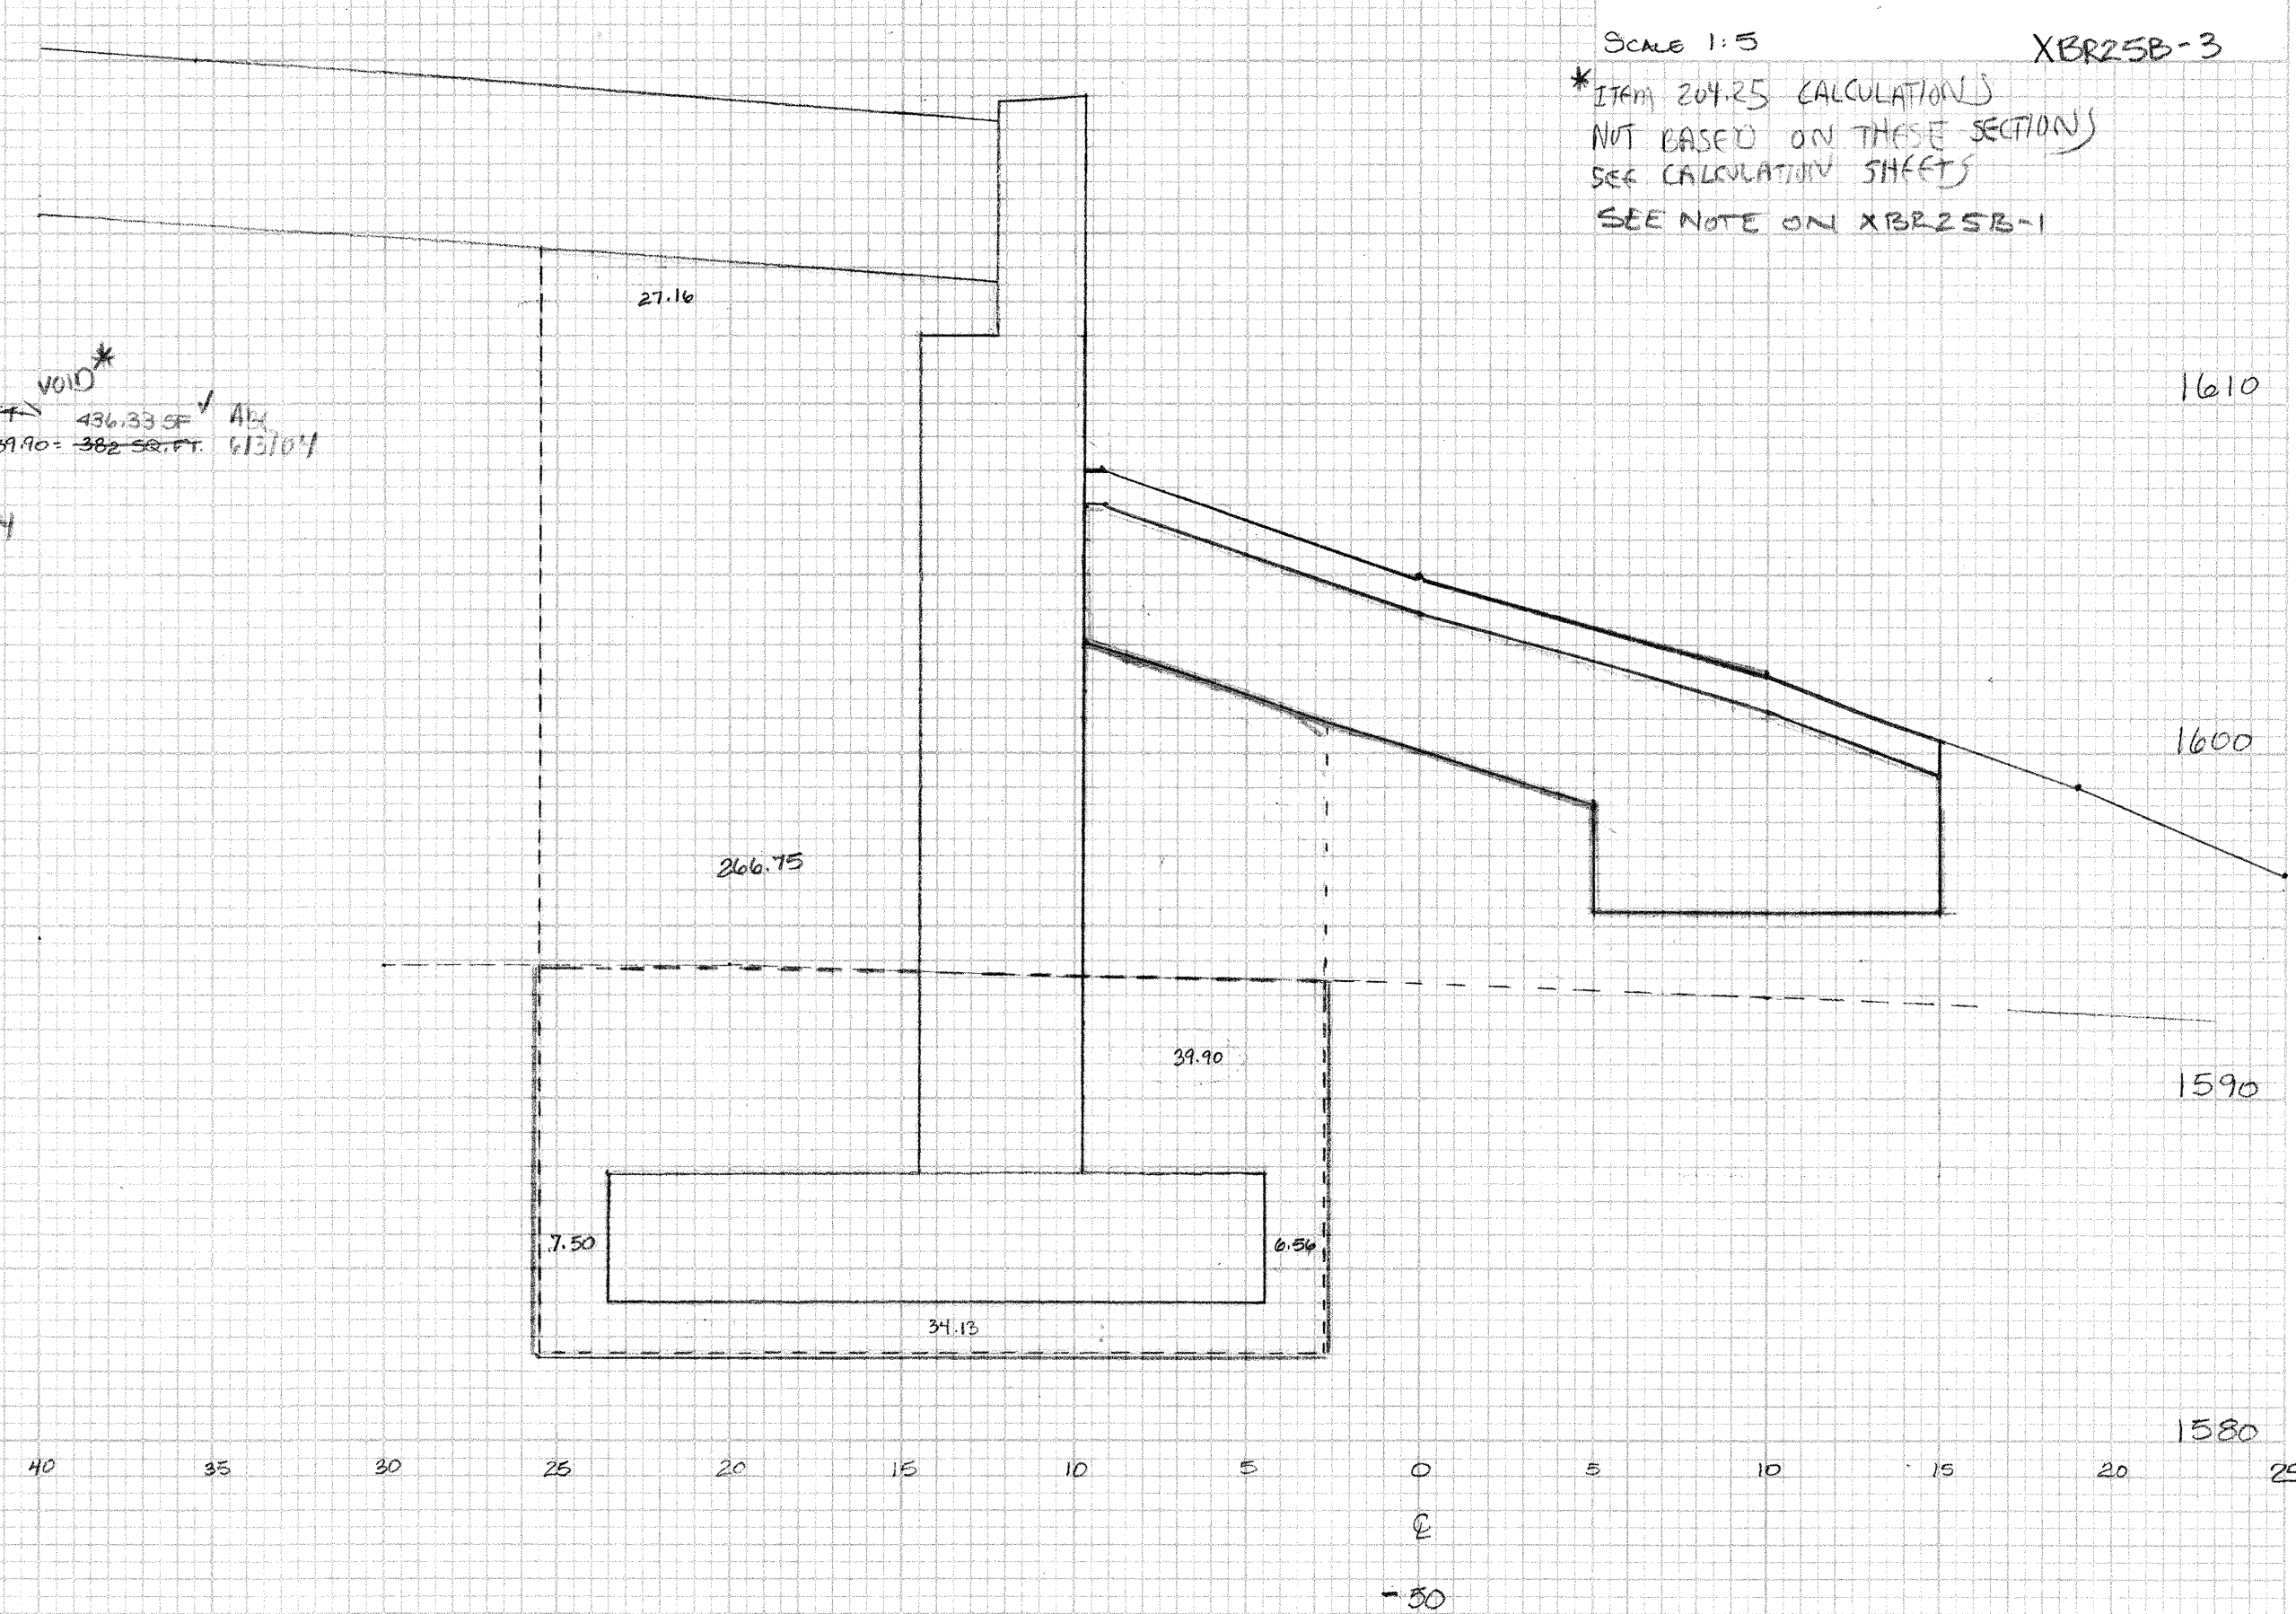


Scale 1:5
 XBR25B-3
 * ITEM 204.25 (CALCULATION)
 NOT BASED ON THESE SECTIONS
 SEE CALCULATIVE SHEETS
 SEE NOTE ON XBR25B-1

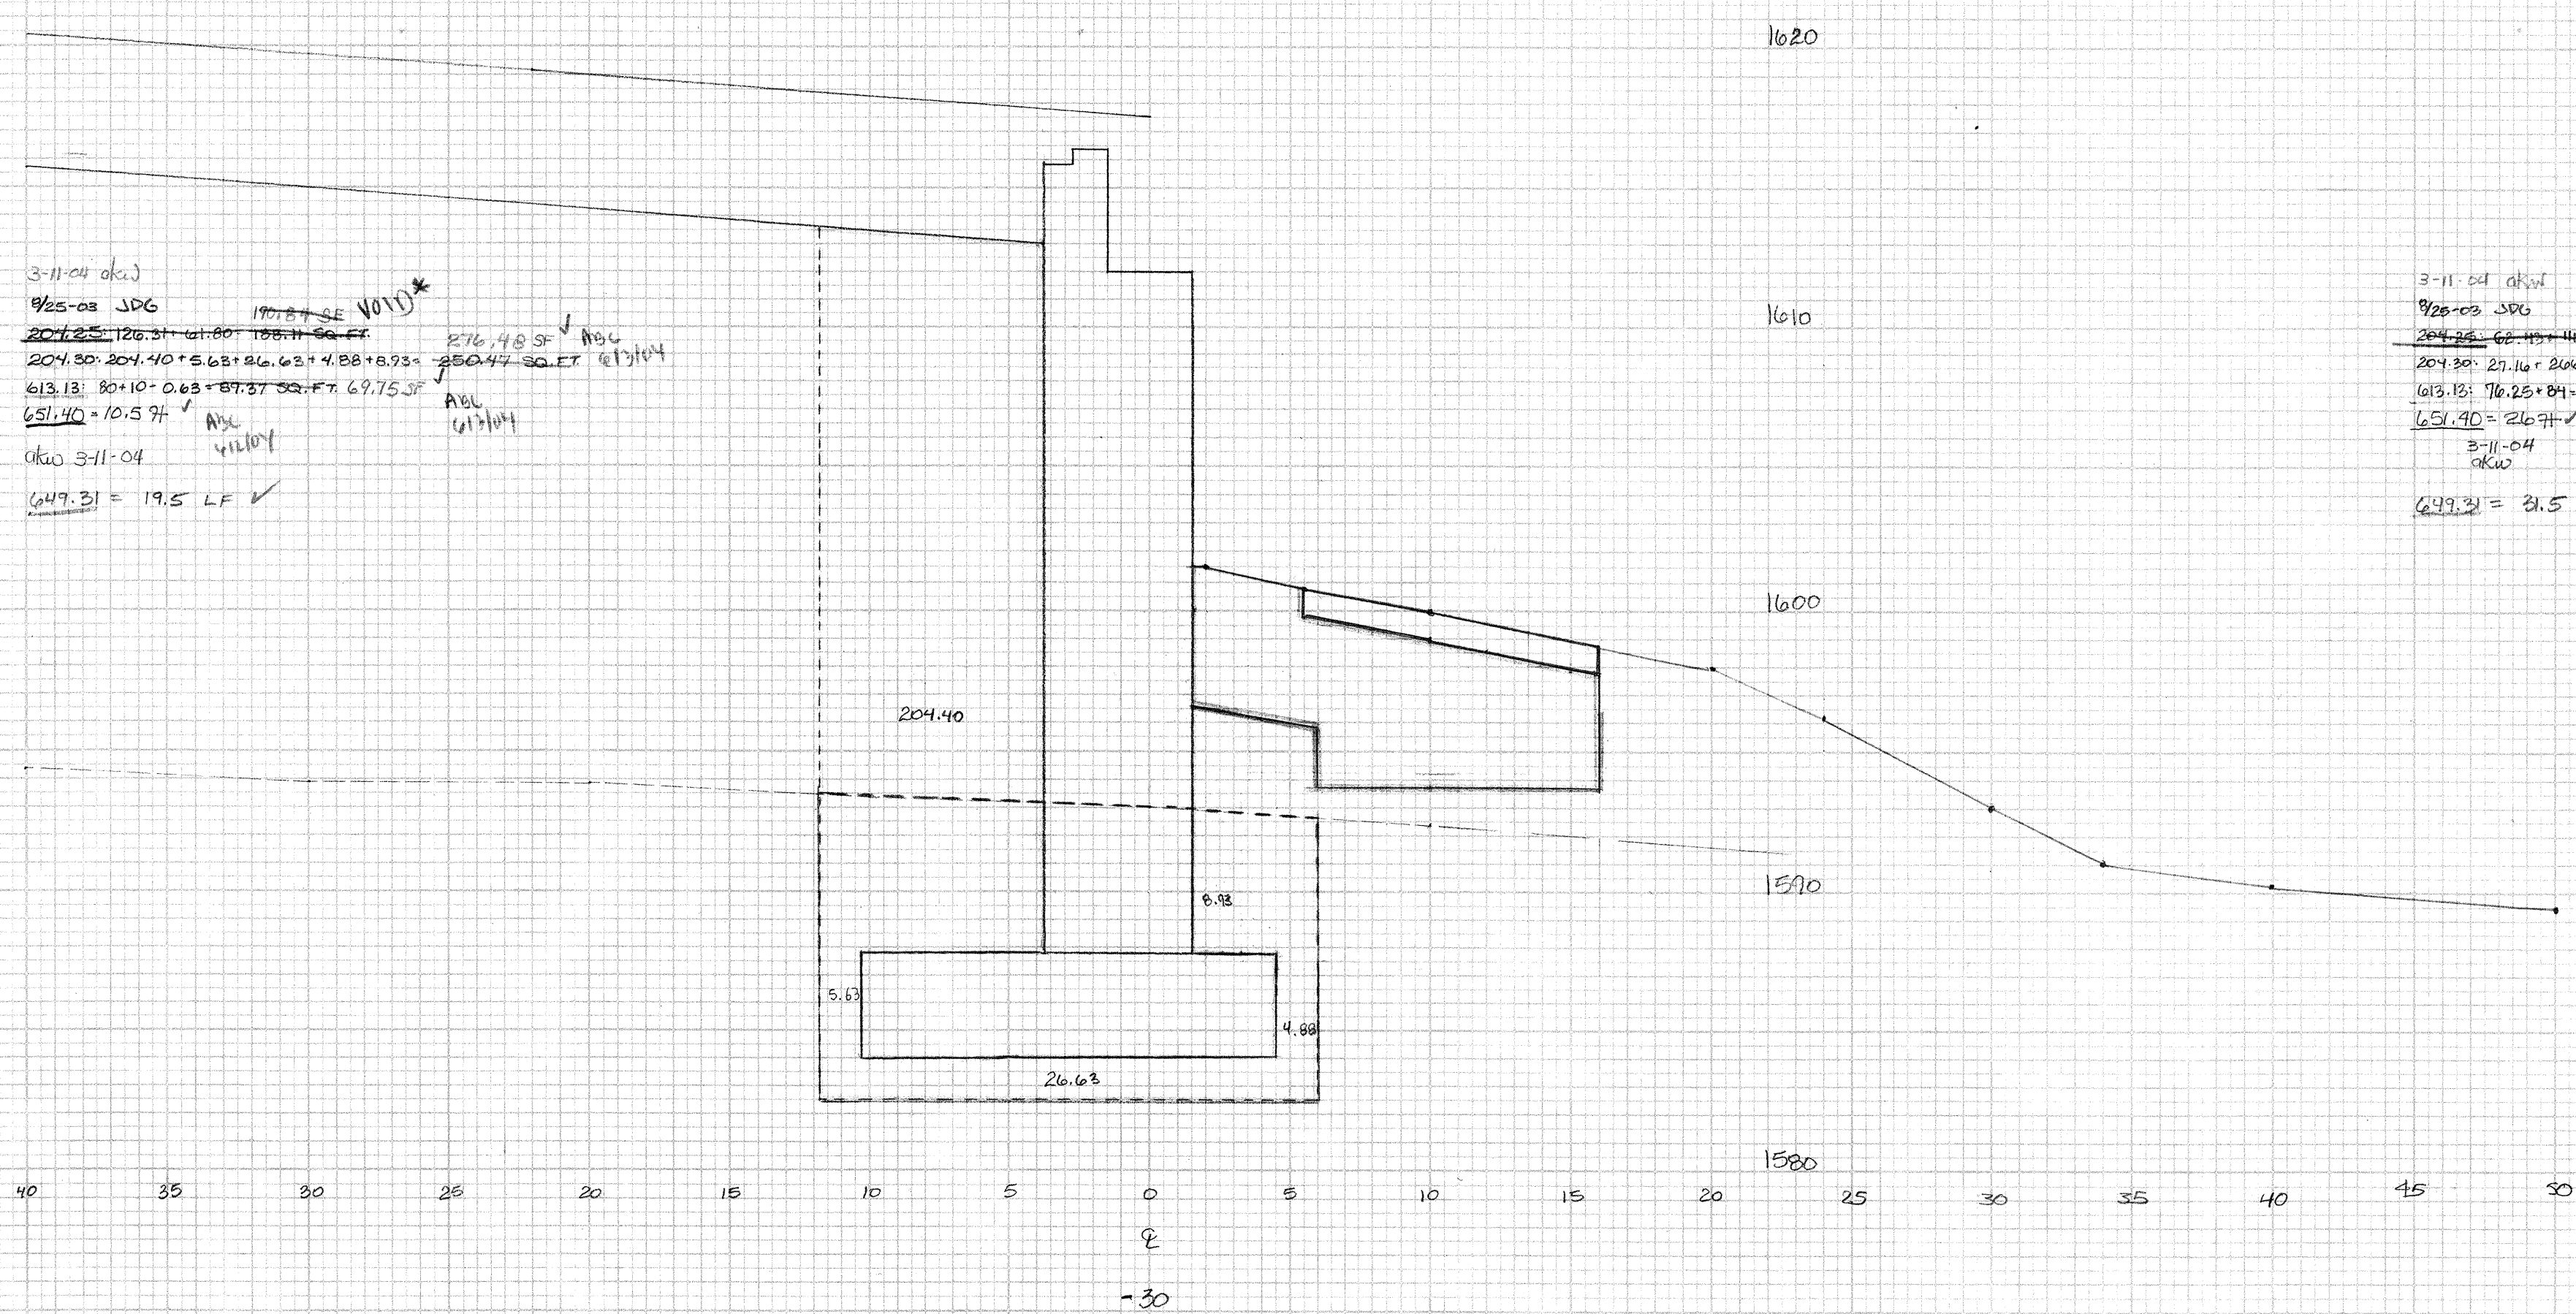

FINAL SURVEY
 SURVIVED
 COPIED
 PLOTTED
 DATE
 BY
 NO.
 AREA
 CHECKED

ORIGINAL SURVEY
 SURVIVED
 COPIED
 PLOTTED
 DATE
 BY
 NO.
 AREA
 CHECKED