

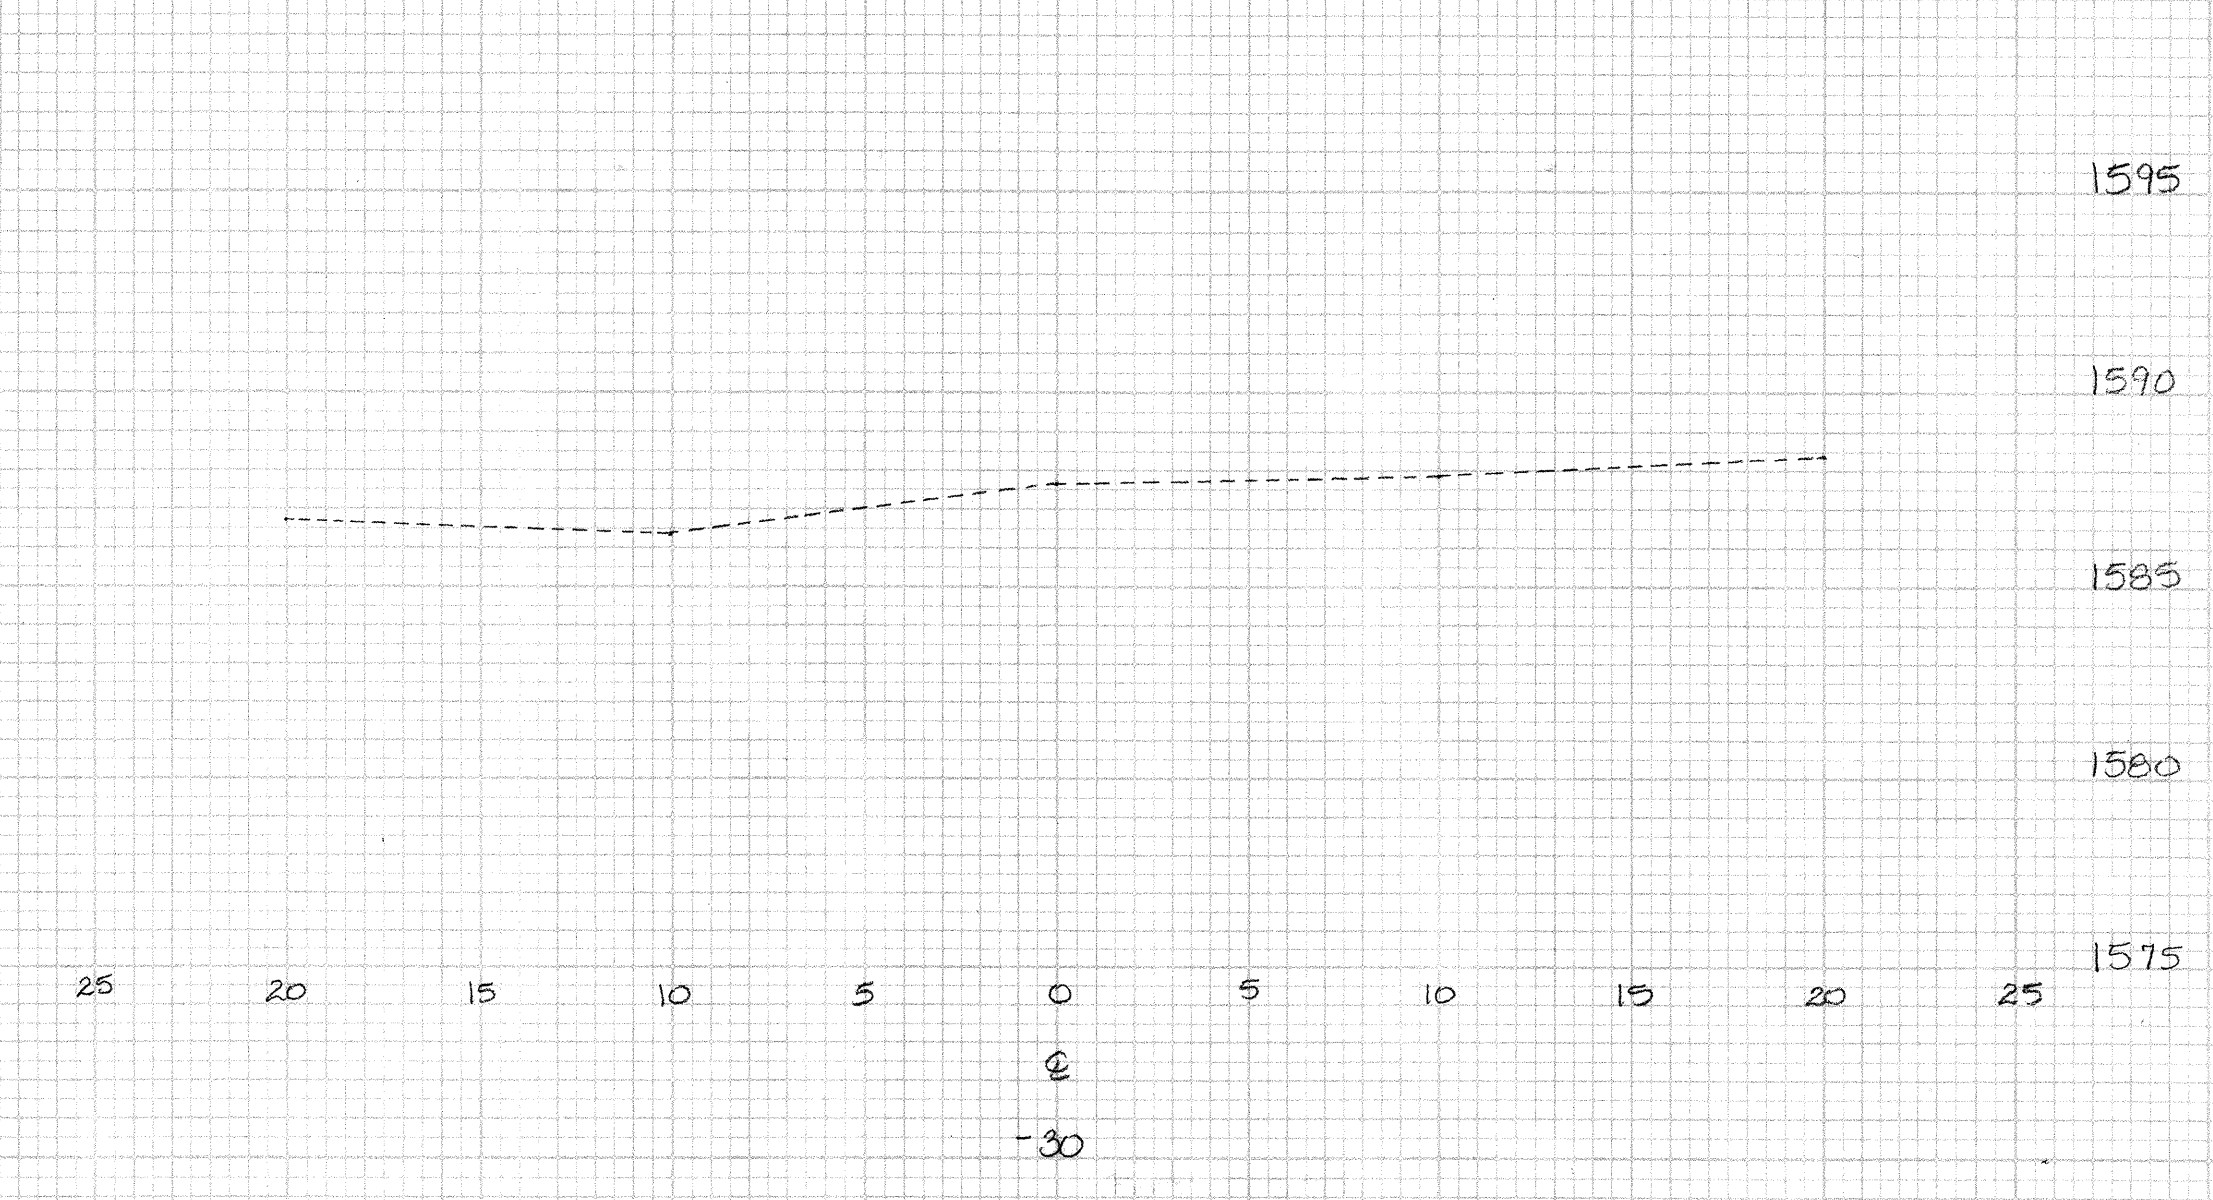
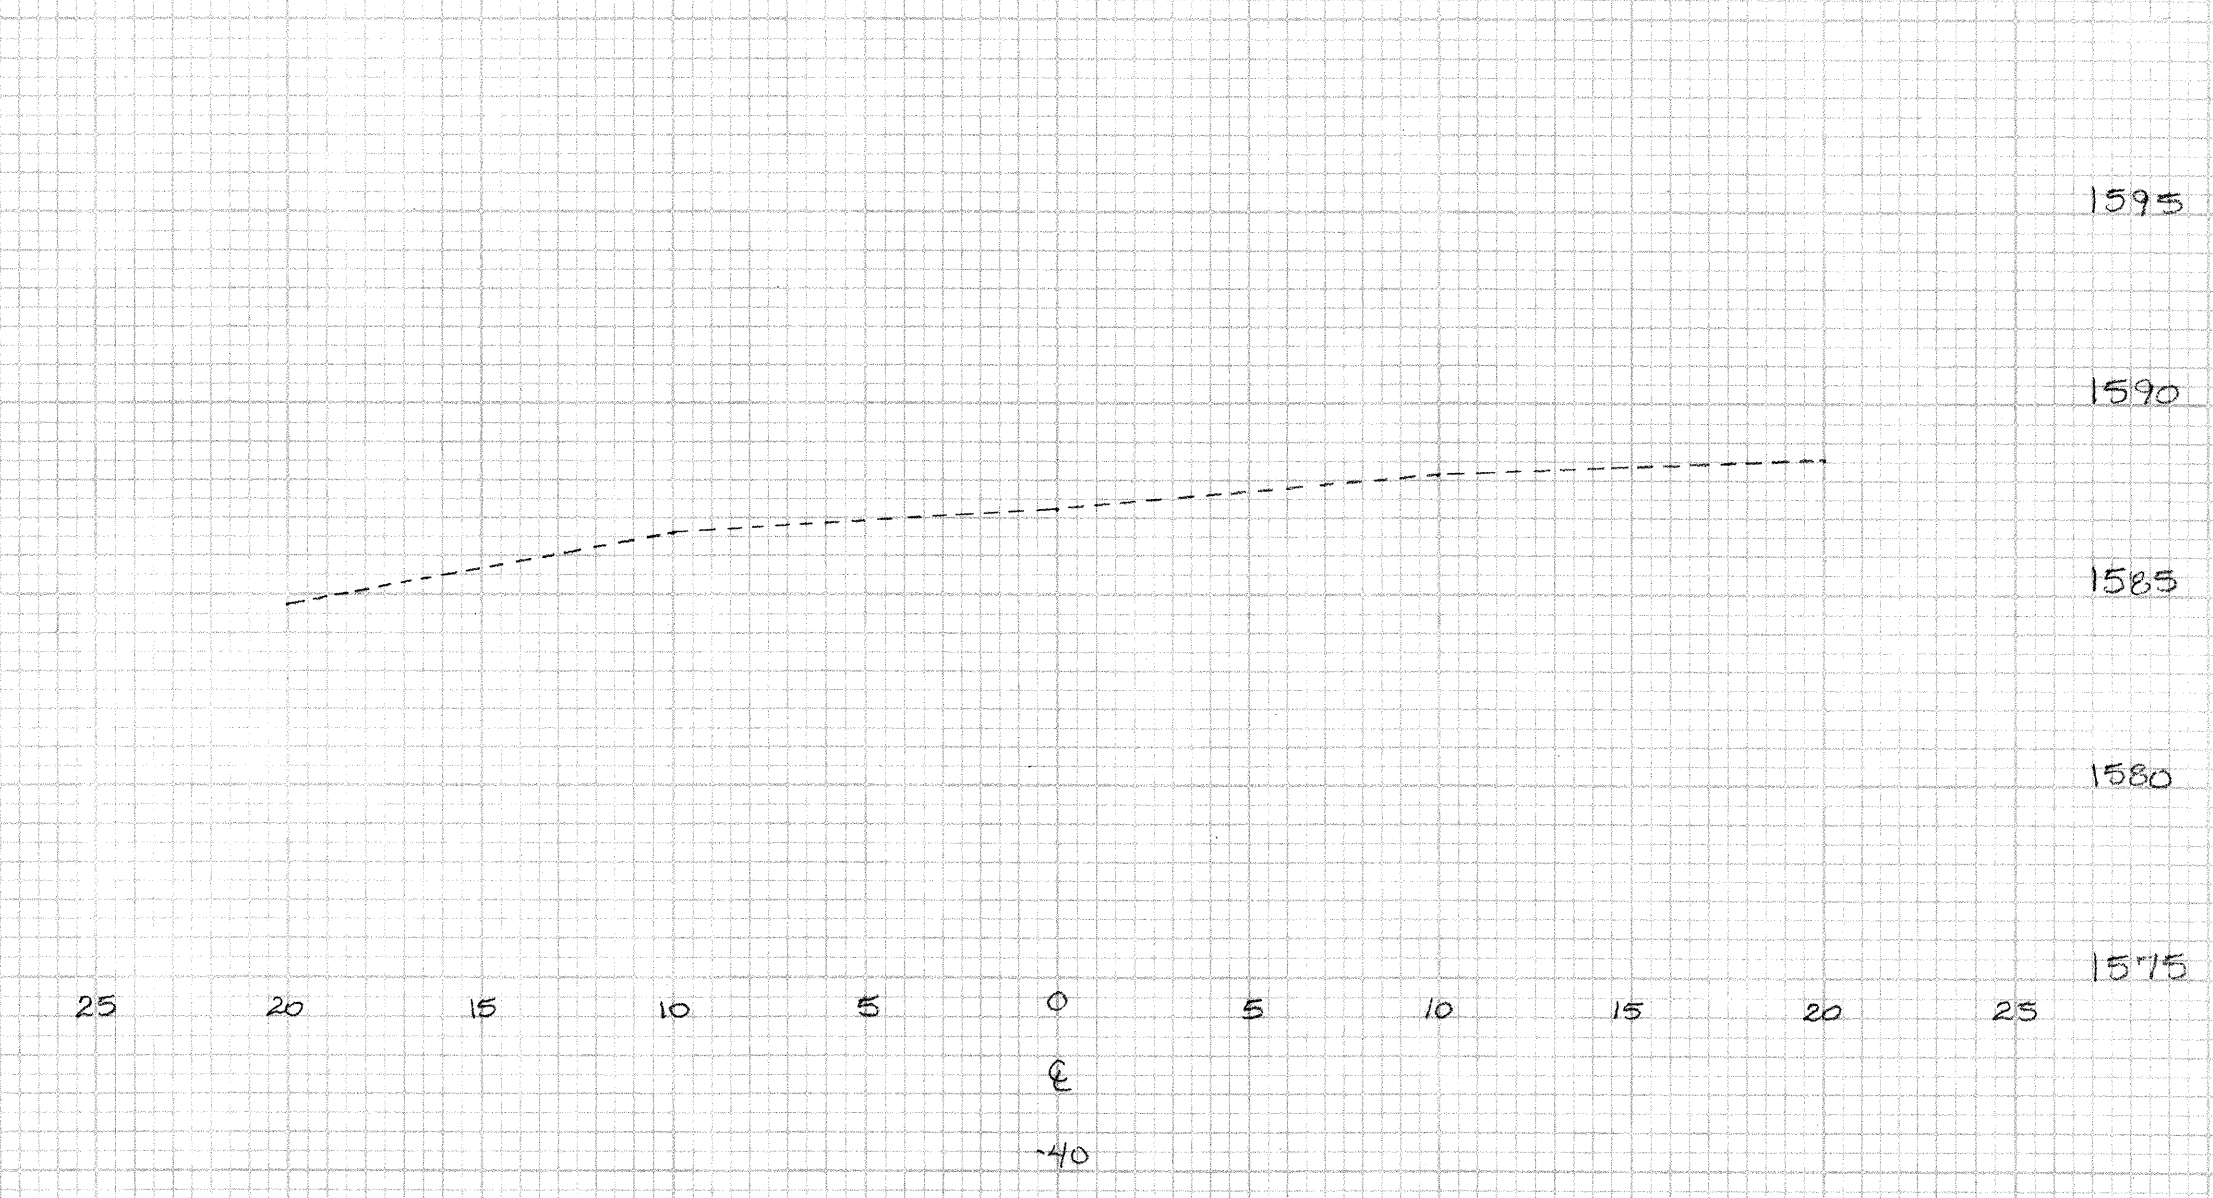


DATE
BY
REVISED
SURVEY
PLOT
TEMPLATE
INSTEAD OF
AREAS
NO. AREAS CHECKED



DATE
BY
REVISED
SURVEY
PLOT
TEMPLATE
INSTEAD OF
AREAS
NO. AREAS CHECKED

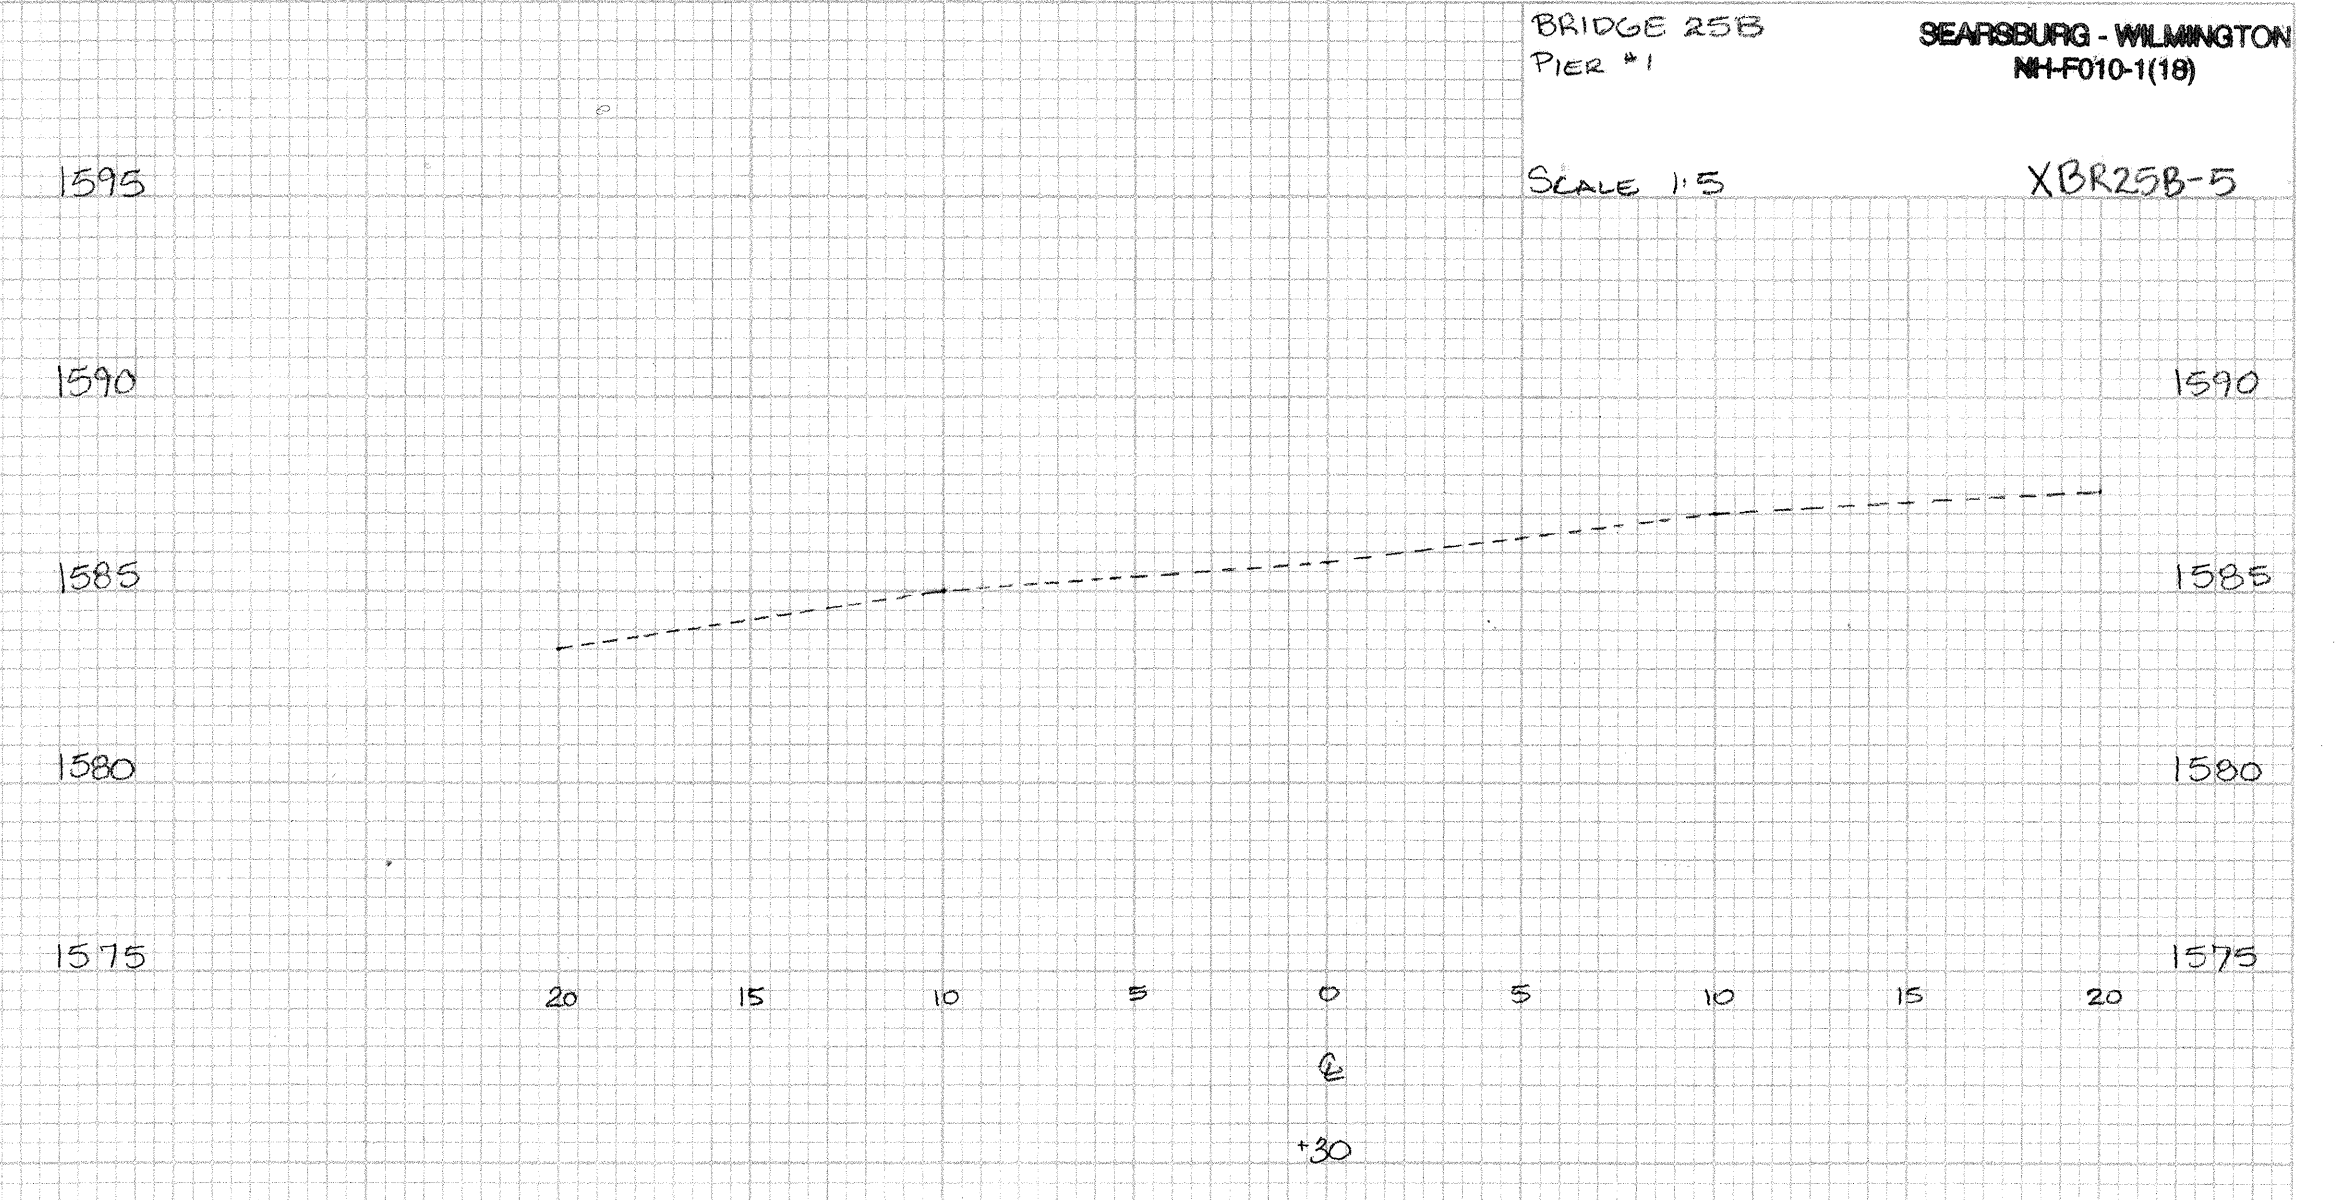

3-28-04 dlu
92a-03 JDB
208.30 140.50 SF
613.13 7.54+15.15+28.28=157.97 SF
208.27 25.17 SF
3-31-04
aEW
A/C
6/13/04

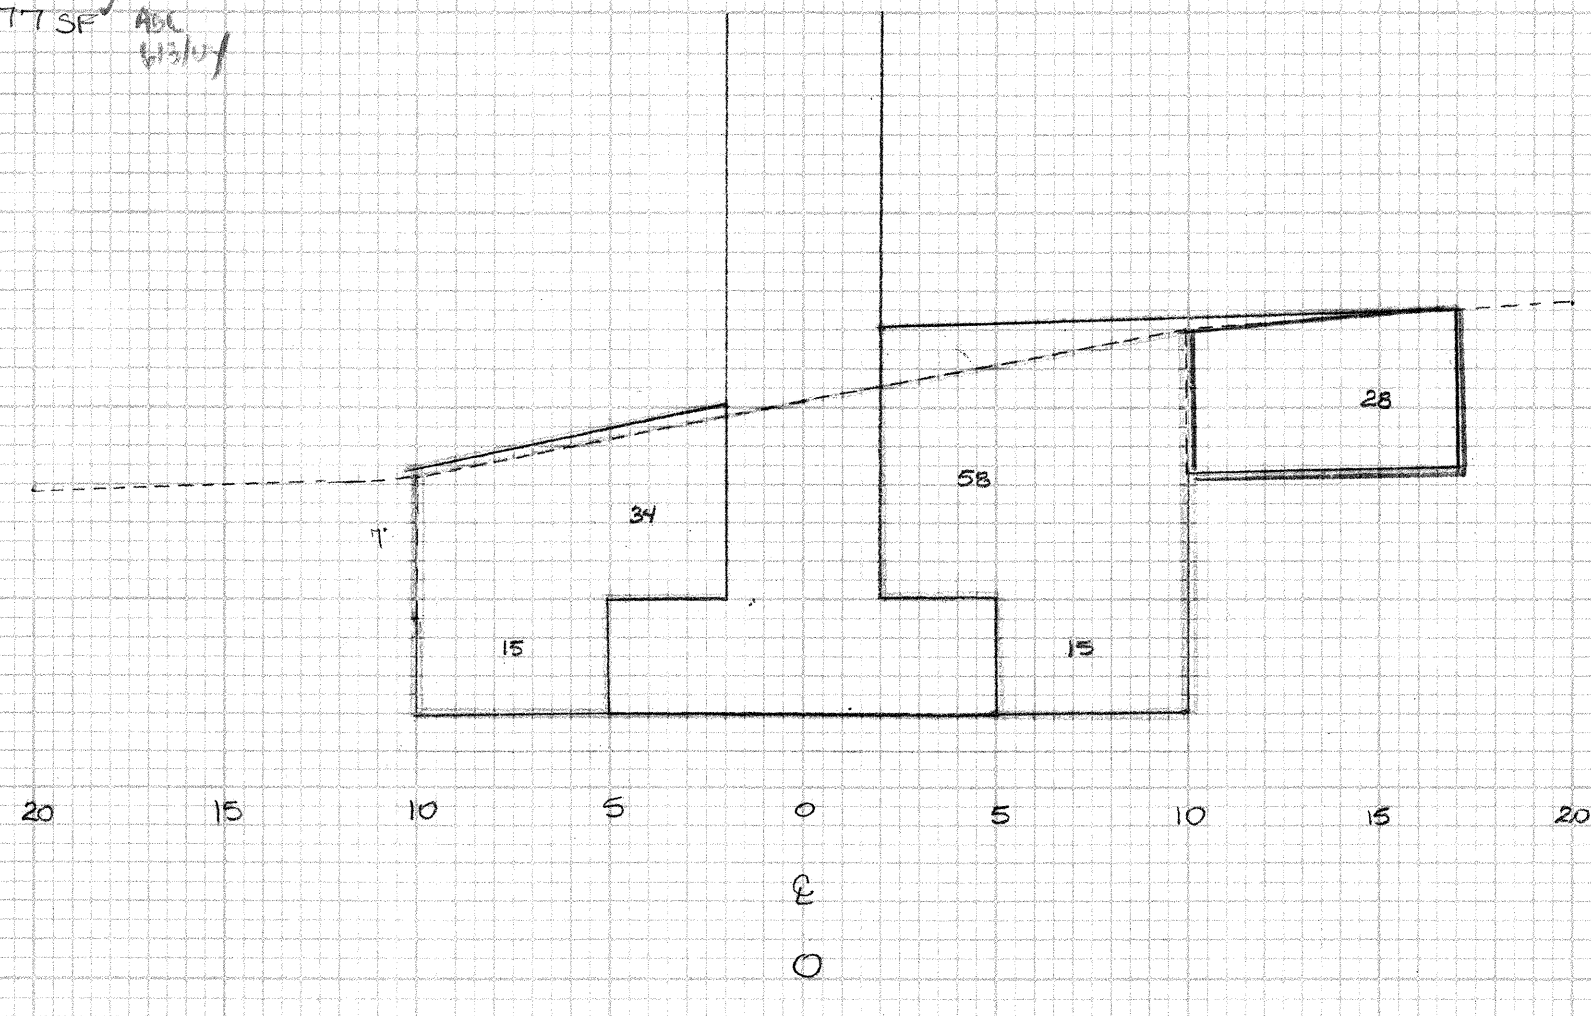


3-28-04 dlu
92a-03 JDB
208.30 91+108.50=199.50 SF
613.13 7.54+15.15+18.16+28=168.85 SF
208.27 28.48 SF
3-30-04
aEW
A/C
6/13/04

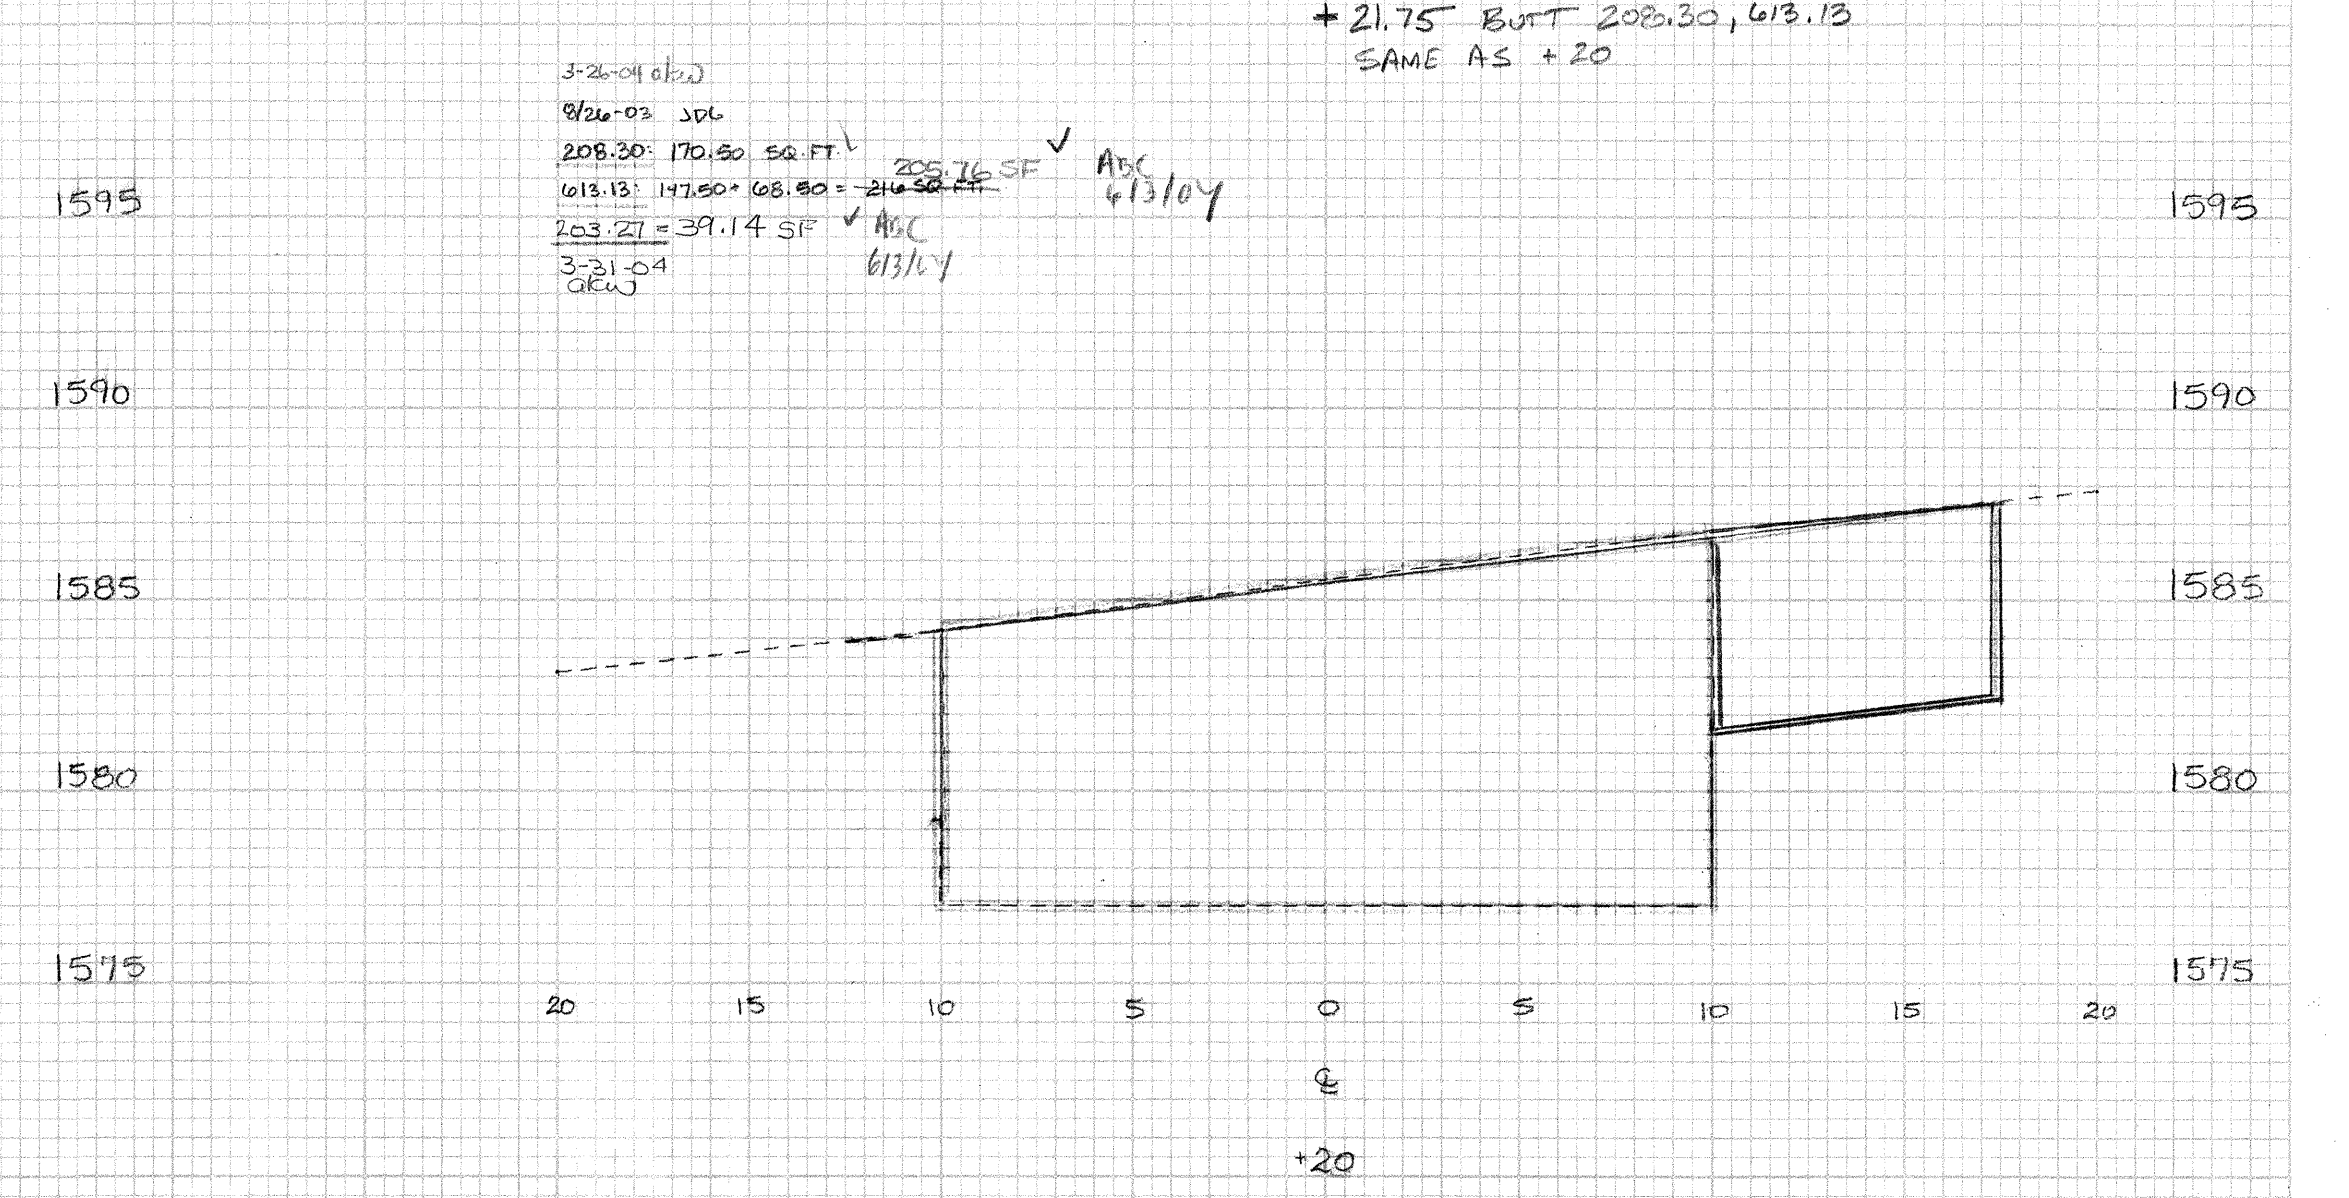
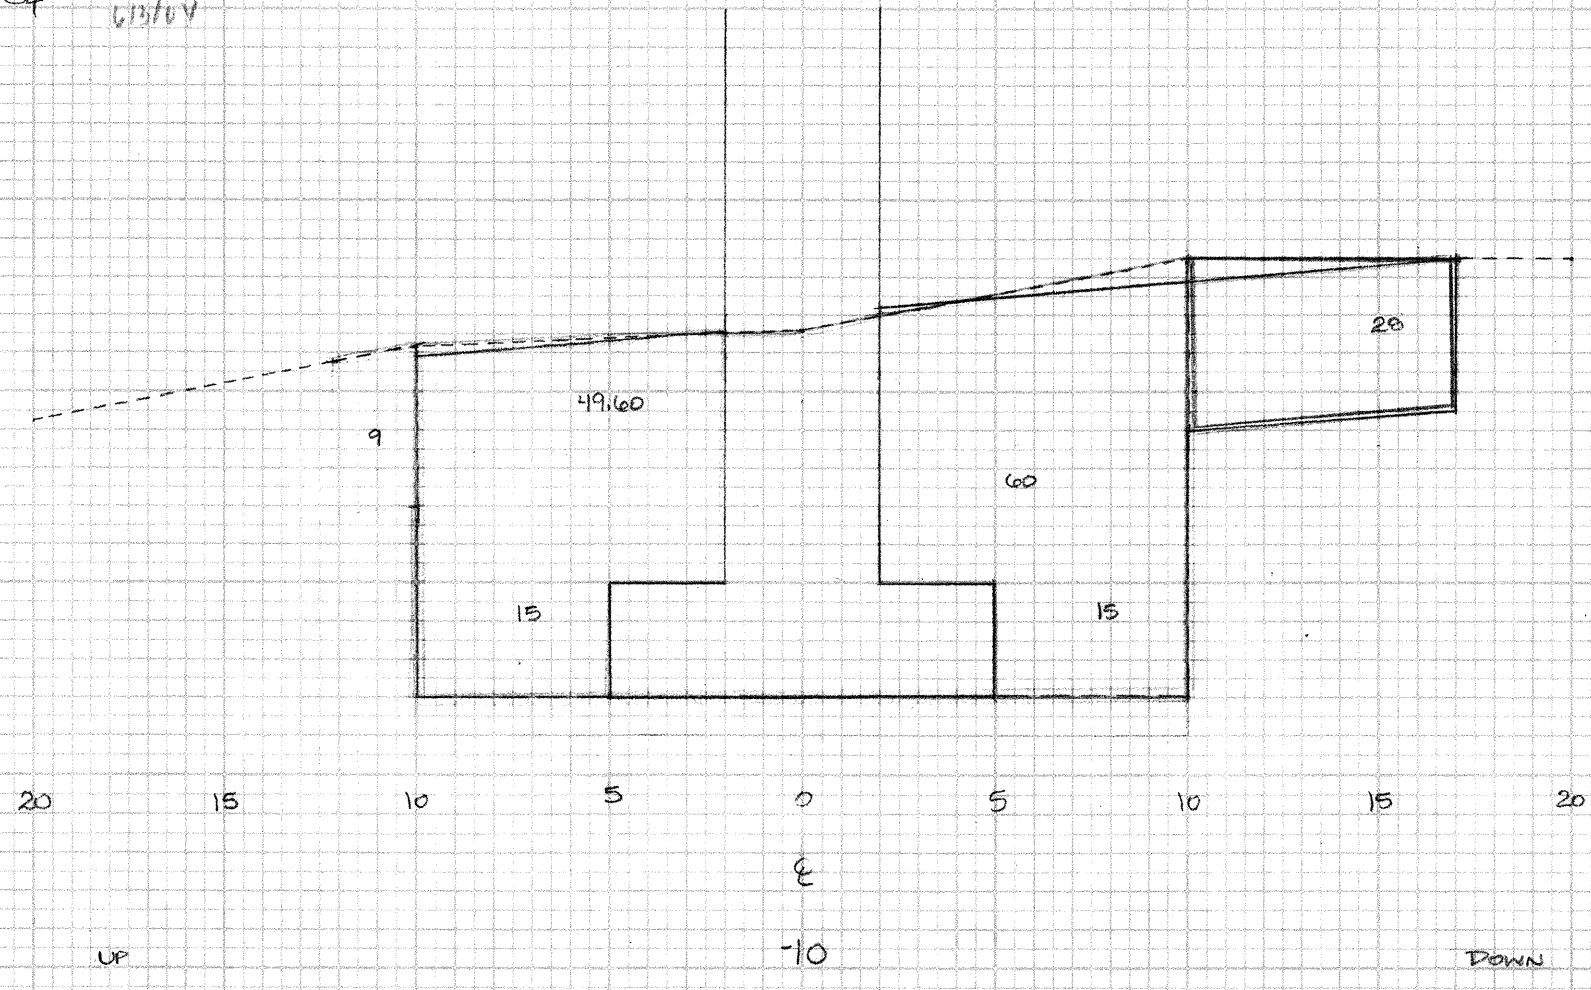


3-28-04 dlu
92a-03 JDB
208.30 170.50 SF
613.13 17.50+18.16+28=63.66 SF
208.27 37.14 SF
3-31-04
aEW
A/C
6/13/04

+21.75 BUT 208.30, 613.13
SAME AS +20

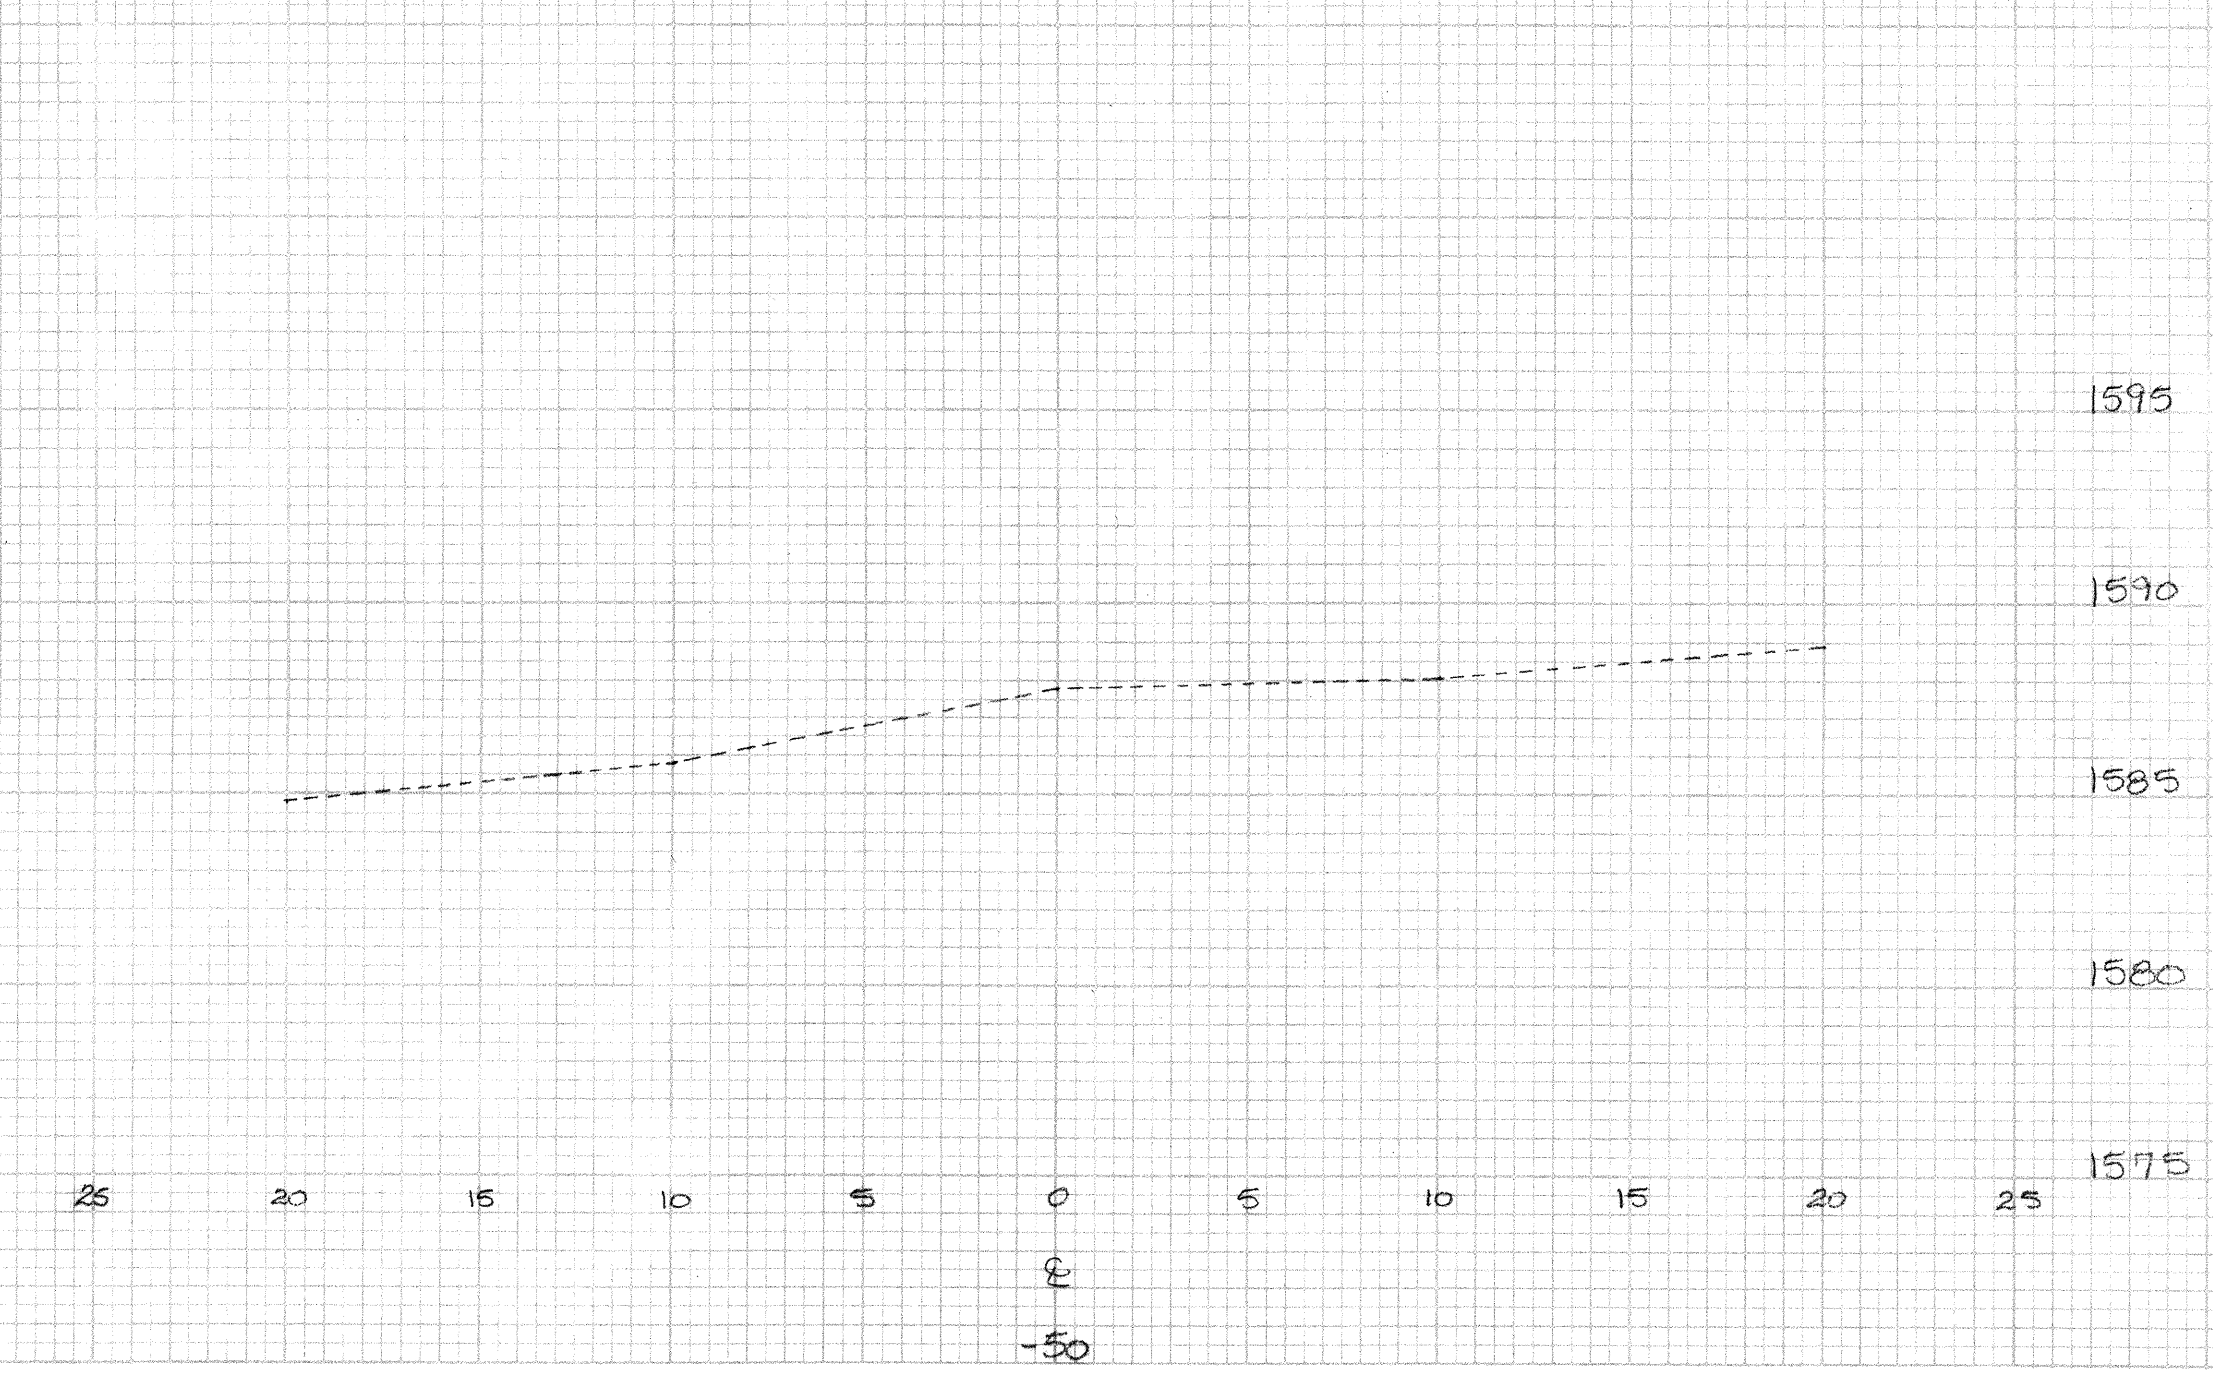

3-28-04 dlu
92a-03 JDB
208.30 131.04+25=156.04 SF
613.13 17.50+18.16+28=63.66 SF
208.27 36.81 SF
3-30-04
aEW
A/C
6/13/04

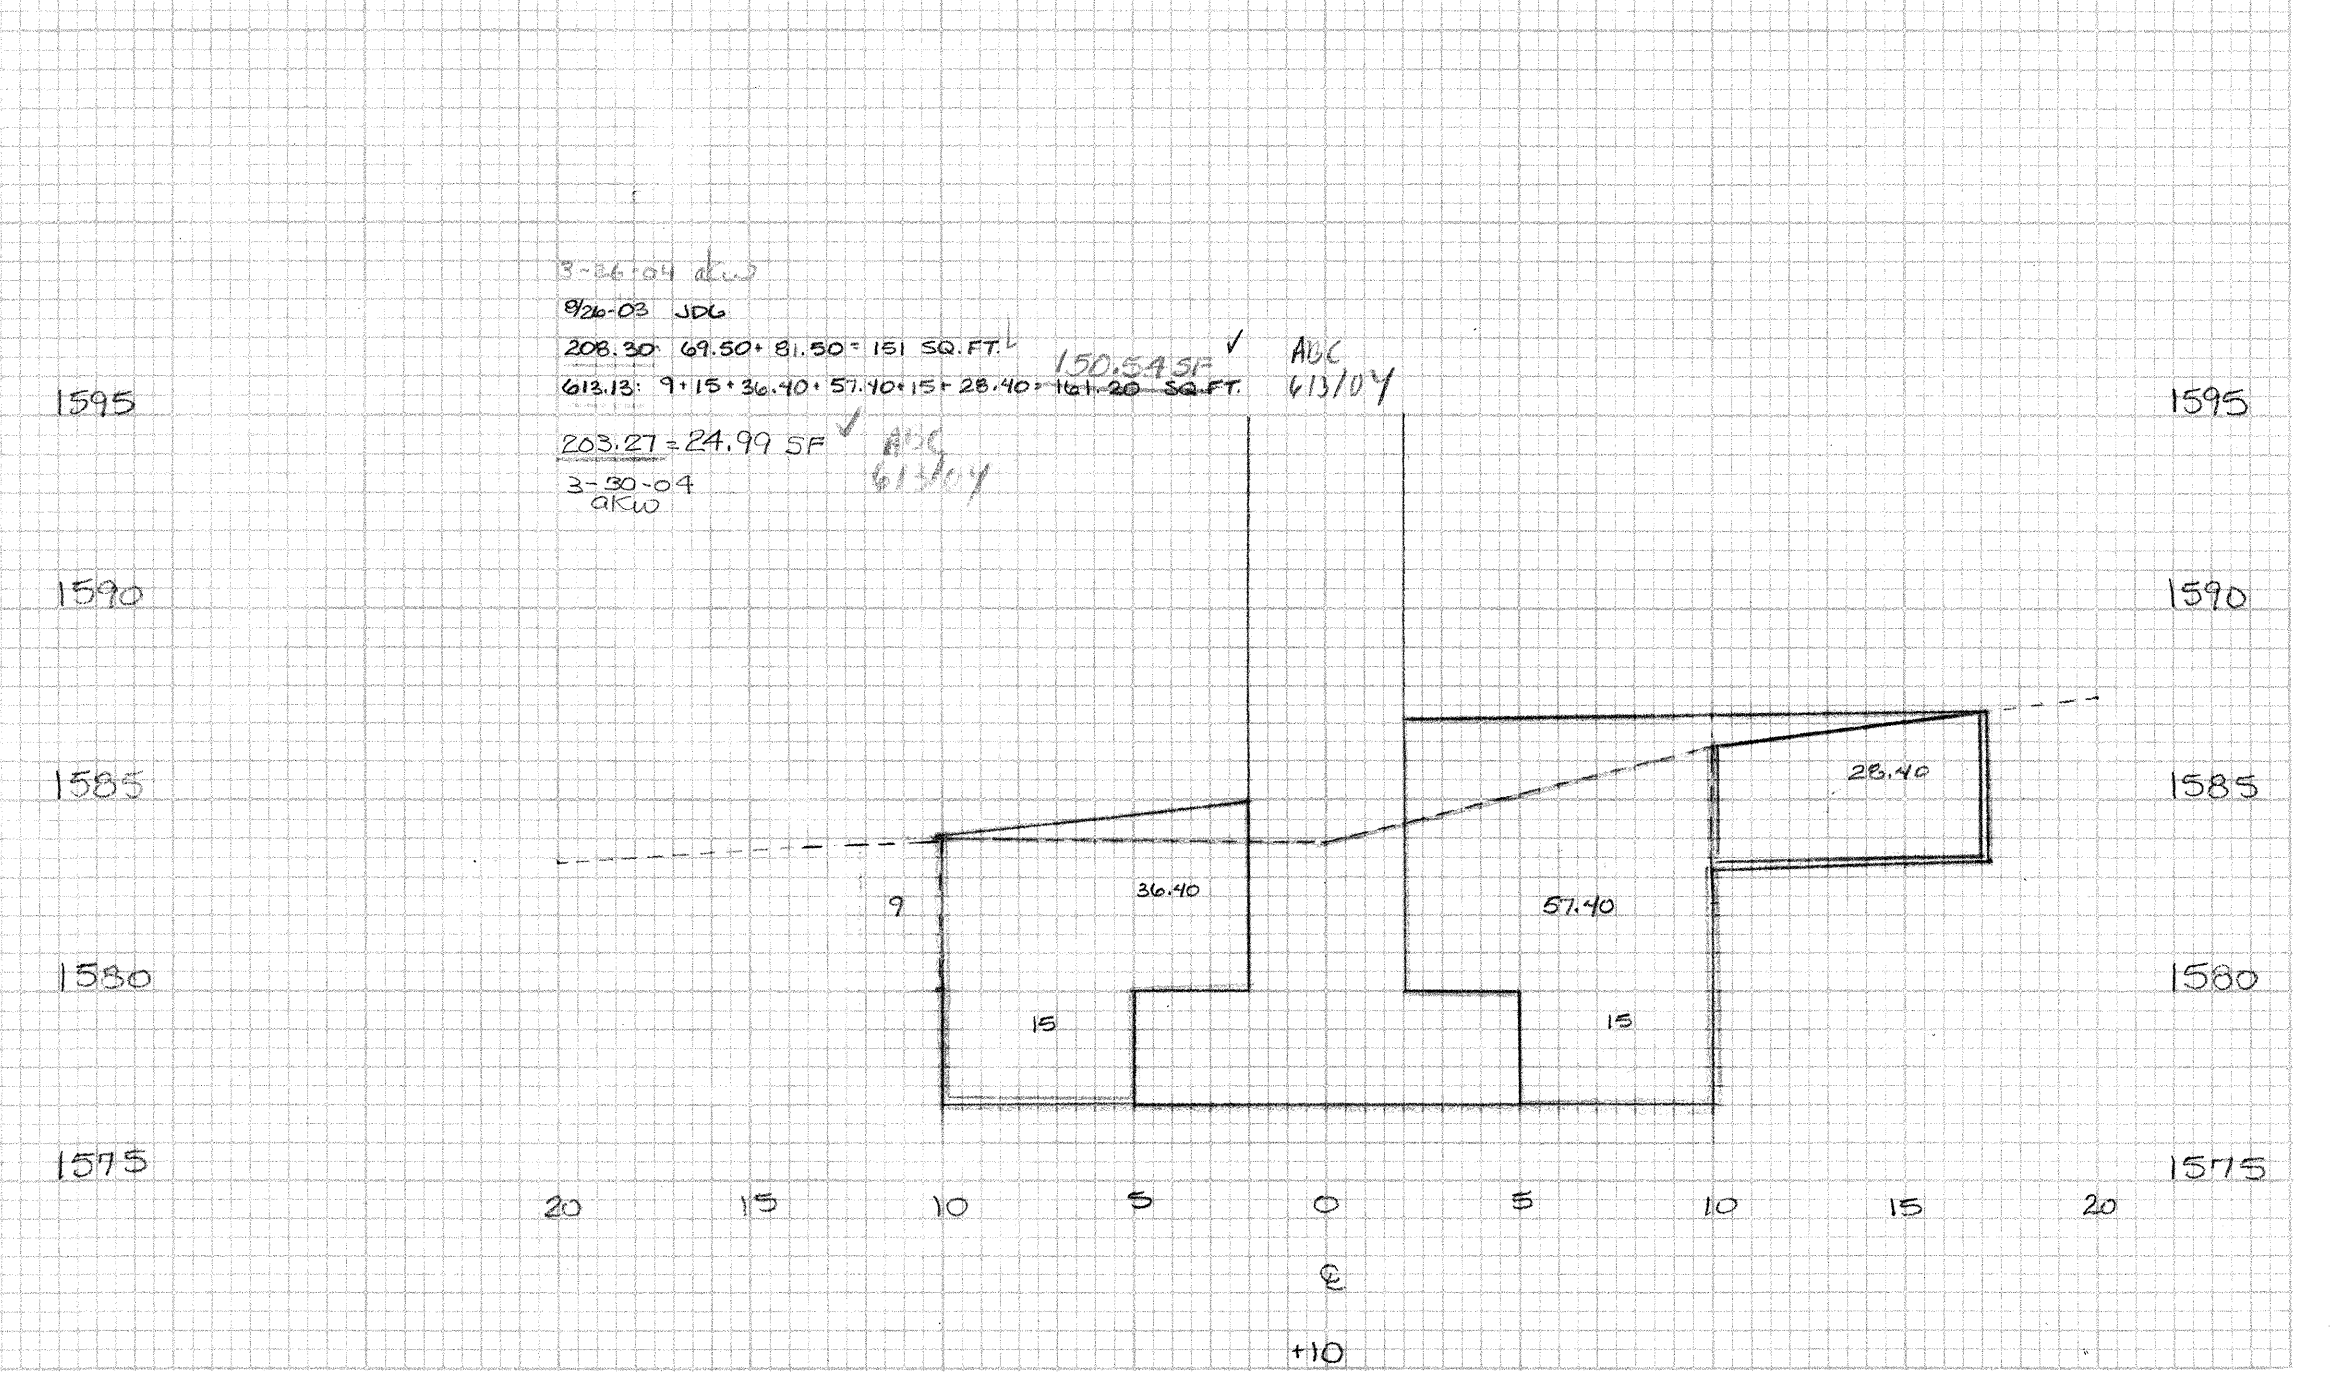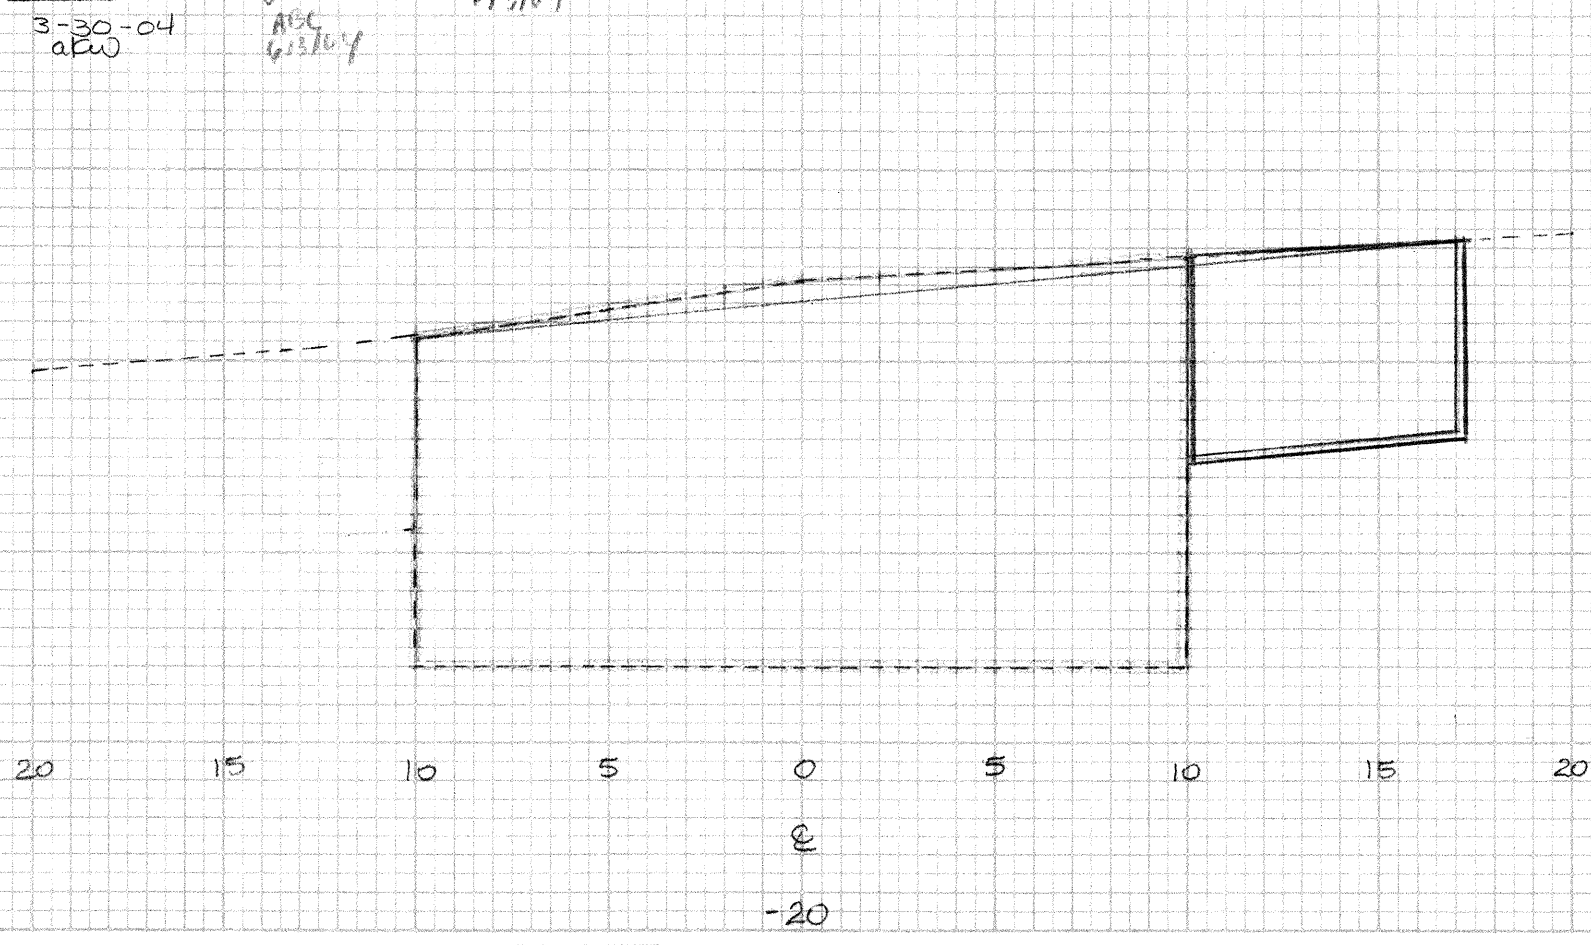

3-28-04 dlu
92a-03 JDB
208.30 61.50+81.50=143 SF
613.13 7.15+36.40+57.10+15+28.40+16.50=146.55 SF
208.27 24.99 SF
3-30-04
aEW
A/C
6/13/04