


FINAL SURVEY
 SURVEYED BY: _____
 DATE: _____
 NOTE BOOK: _____
 AREA: _____
 NO. AREAS CIRCLED: _____


ORIGINAL SURVEY
 SURVEYED BY: _____
 DATE: _____
 NOTE BOOK: _____
 AREA: _____
 NO. AREAS CIRCLED: _____

8/26-03 JRC
 208.80: 116.25 + 100.75 + 217.50 FT ✓
 613.13: 116 + 87.50 + 208.50 SQ. FT. 223.20 SF ✓
 203.27: 46.49 SF ✓
 4/13/04

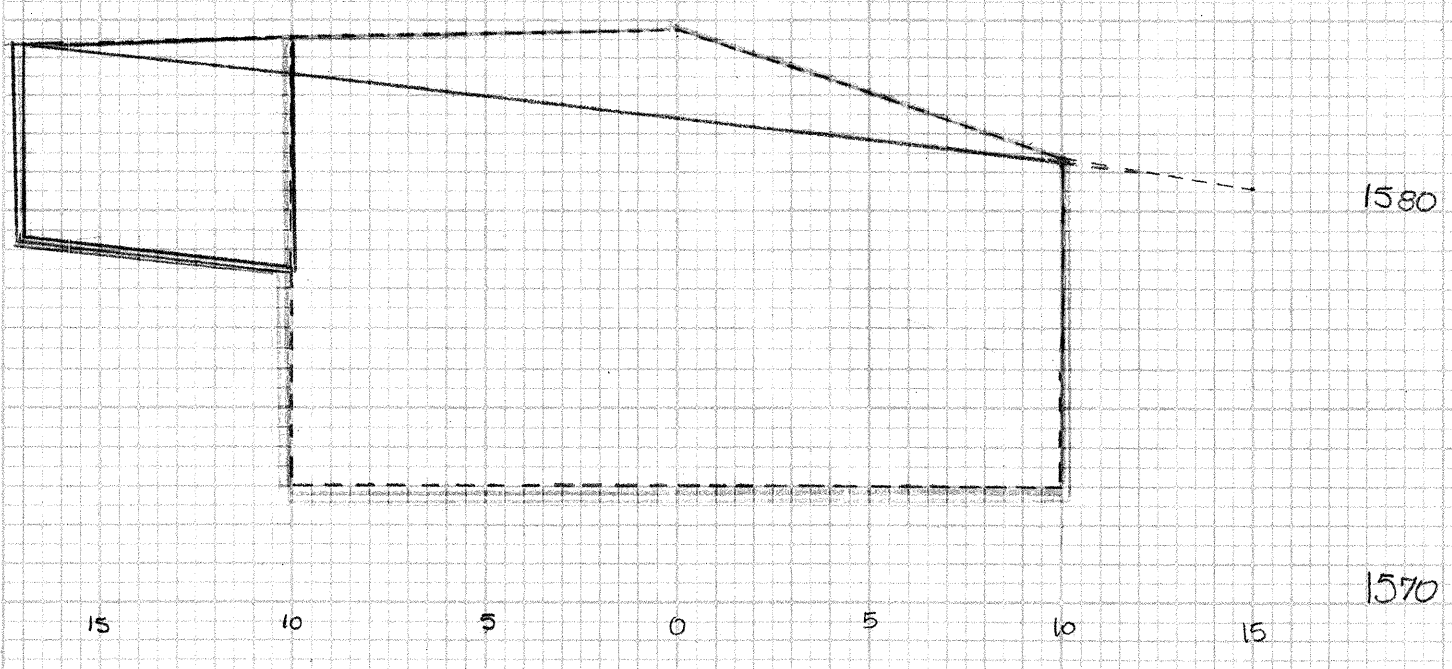


-20.5 BUTT 208.80, 613.13
 SAME AS -20


15 10 5 0 5 10 15
 1570
 1580

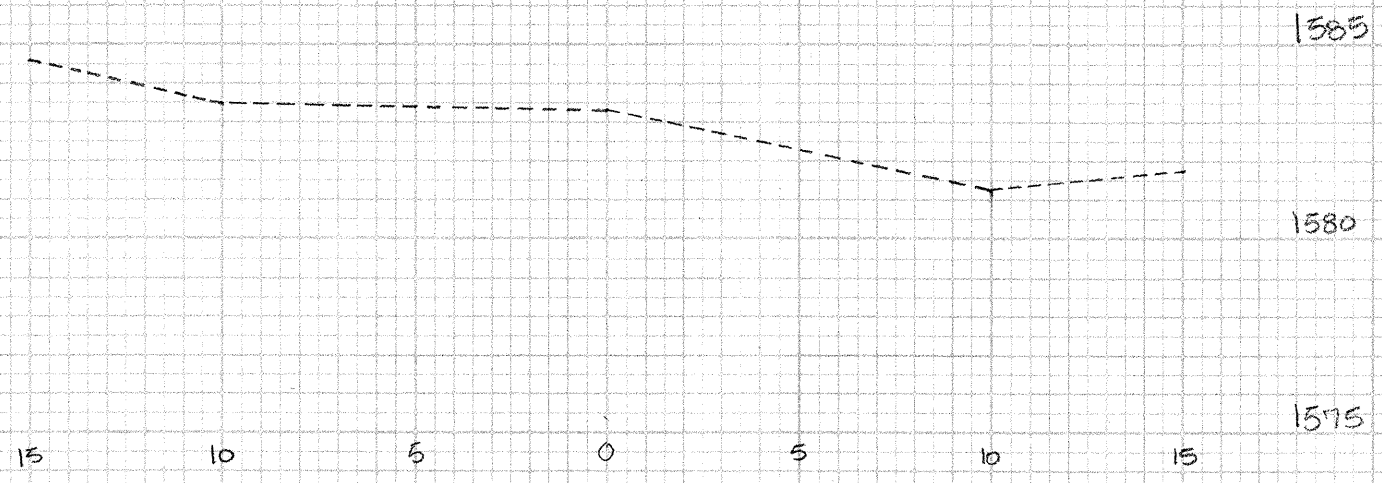

15 10 5 0 5 10 15
 1575
 1580

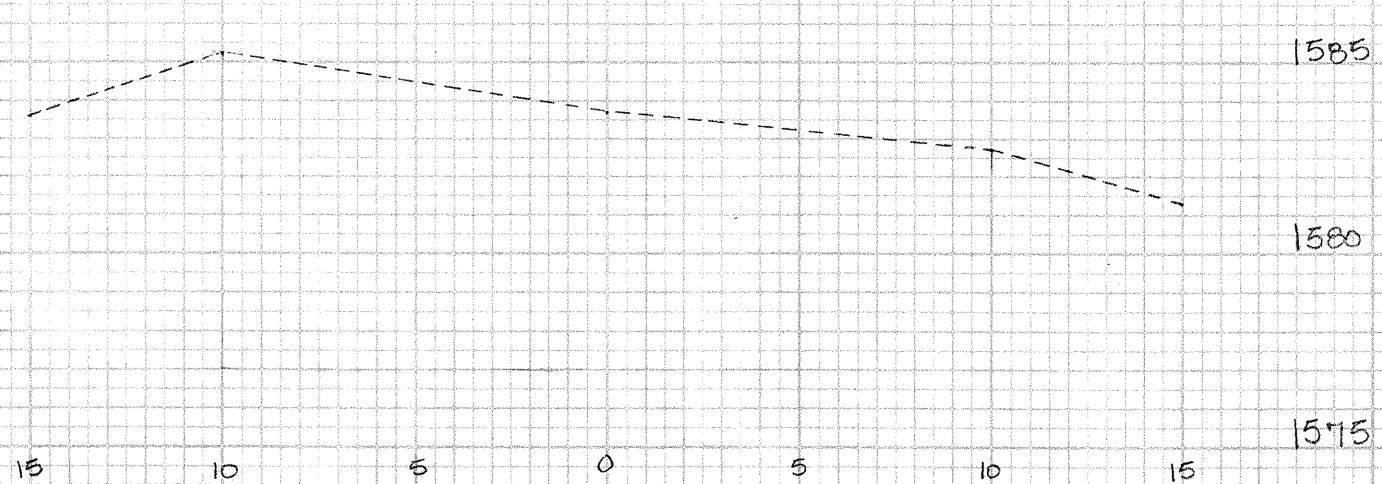


15 10 5 0 5 10 15
 1575
 1580

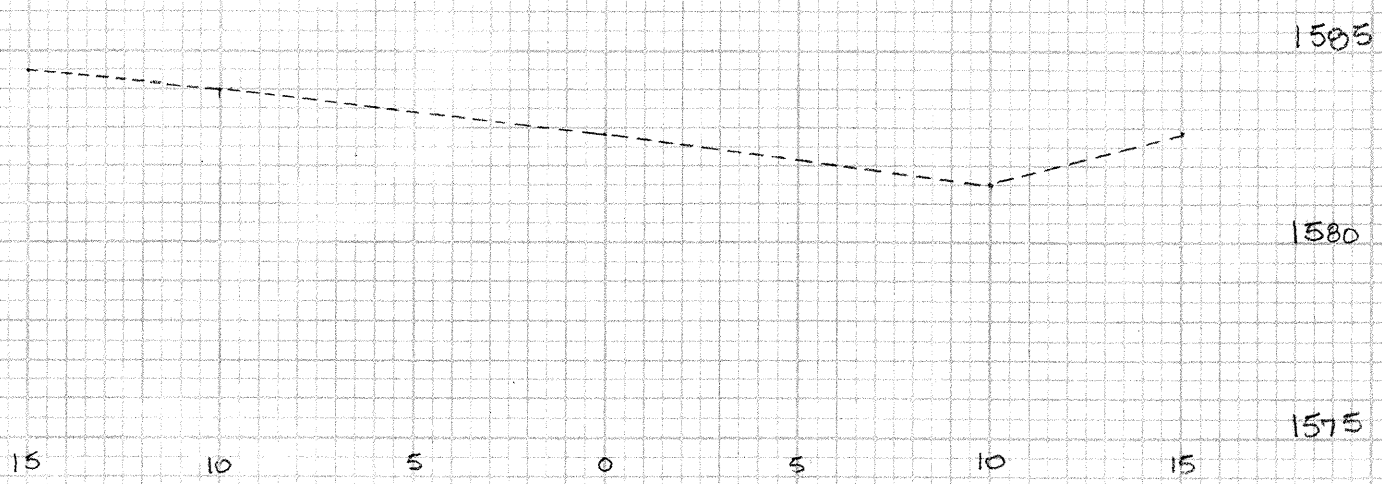


15 10 5 0 5 10 15
 1575
 1580

3/21-04 dkw
 8/26-03 JRC
 208.80: 101.75 + 98.50 + 200.25 SQ. FT ✓
 613.13: 35 + 53.60 + 15 + 15 + 46.00 + 10 + 14.25 + 46.25 SQ. FT ✓
 203.27: 31.5 SF ✓
 3-27-04

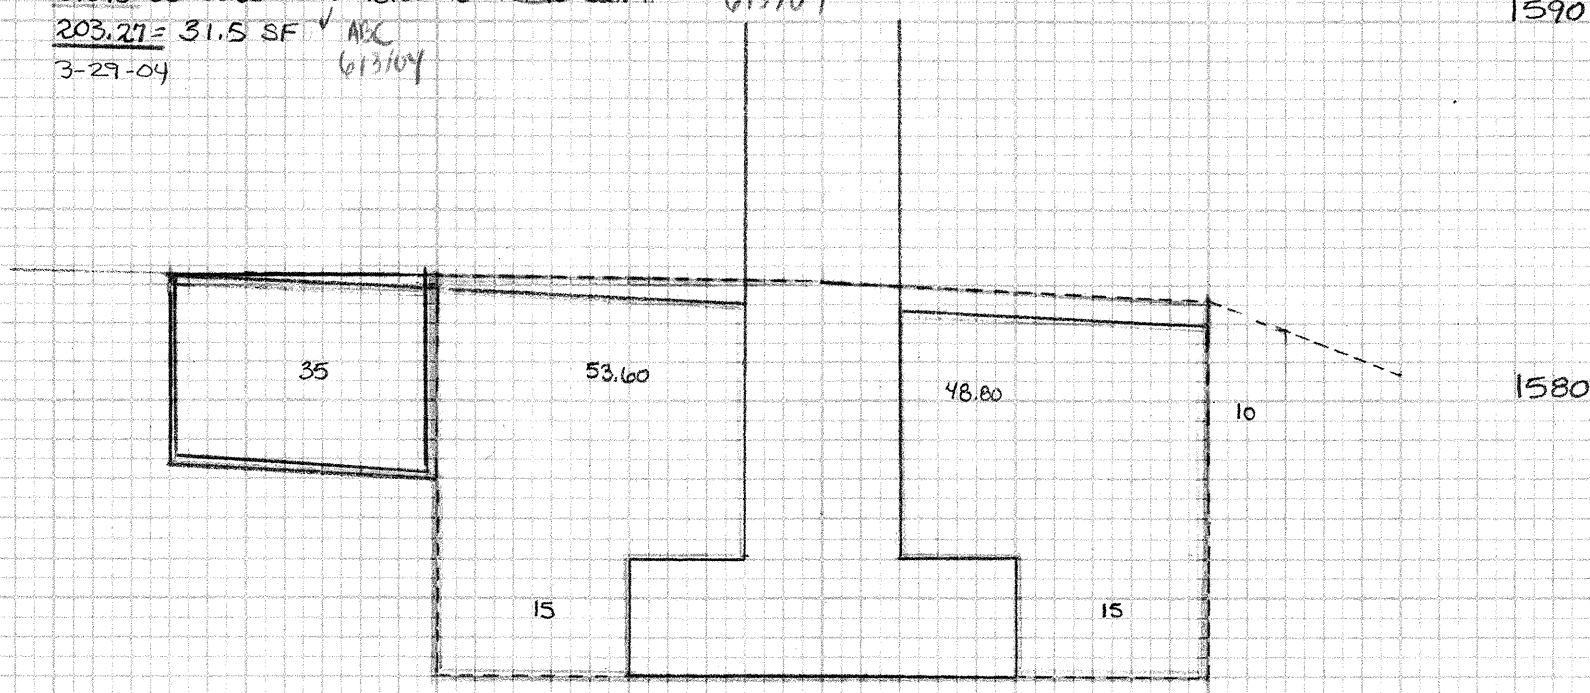


20 15 10 5 0 5 10 15
 1570
 1590

8/26-03 JRC
 208.80: 104.50 + 92.50 + 197.50 FT ✓
 613.13: 35 + 59.40 + 15 + 15 + 50 + 10 + 18 + 40.50 FT ✓
 203.27: 34.85 SF ✓
 3-29-04

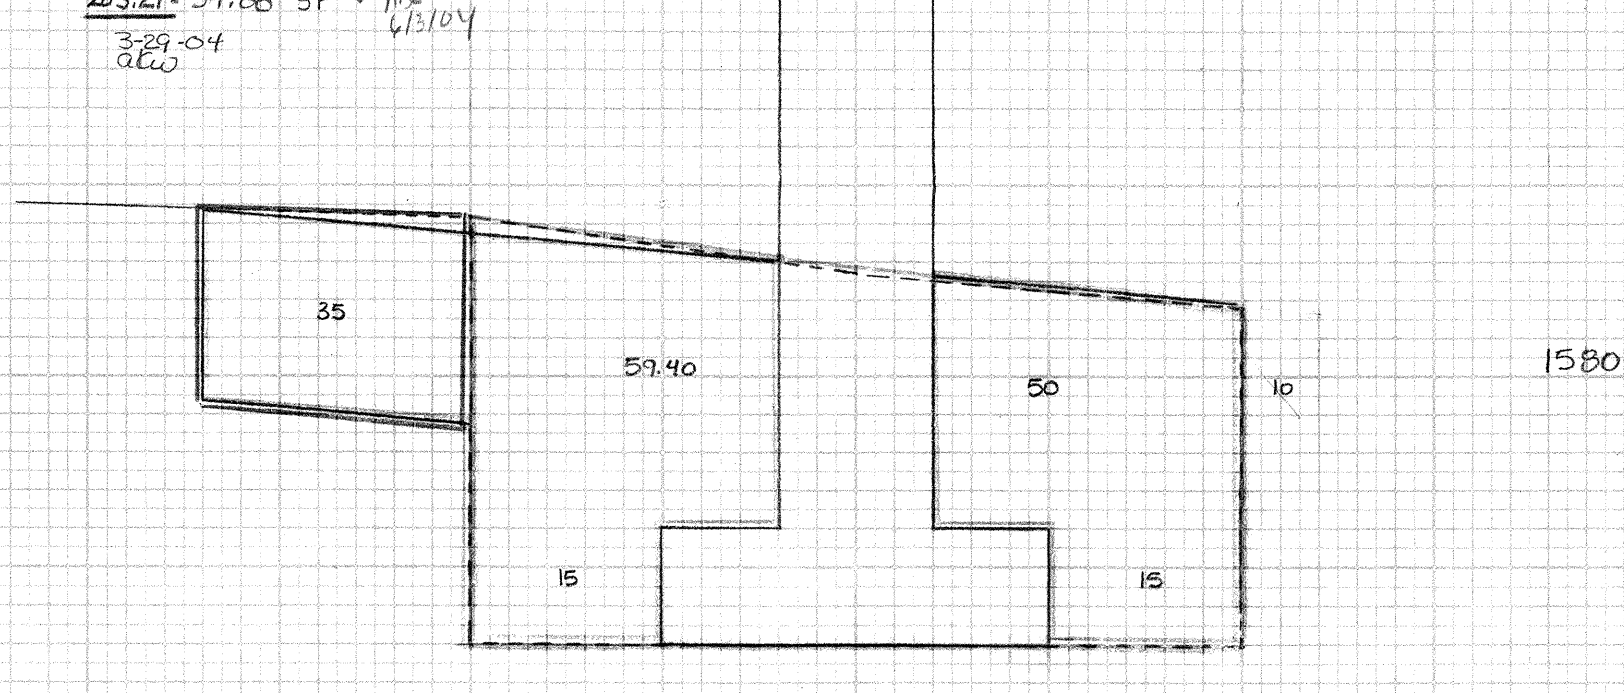


20 15 10 5 0 5 10 15
 1570
 1590

3-29-04 dkw
 8/26-03 JRC
 208.80: 102.50 + 82.50 + 185.50 FT ✓
 613.13: 35 + 55.60 + 15 + 15 + 40.80 + 10 + 14.25 + 46.25 FT ✓
 203.27: 39.92 SF ✓
 dkw 3-29-04

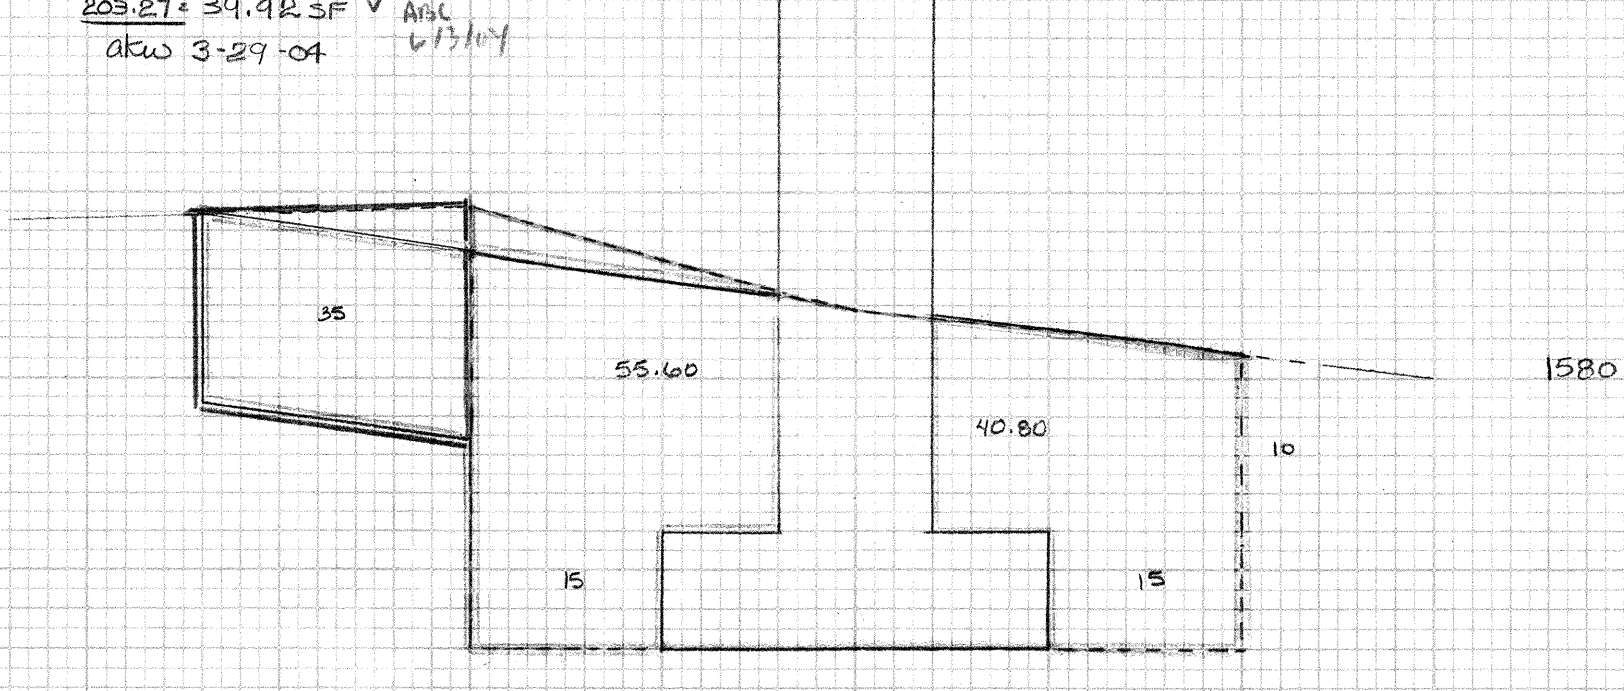

20 15 10 5 0 5 10 15
 1570
 1590

3-26-04 dkw
 8/26-03 JRC
 208.80: 101 + 86.40 + 58.10 + 185.50 SQ. FT ✓
 613.13: 147.50 + 99 + 24 + 50 SQ. FT. 230.95 SF ✓
 203.27: 32.16 SF ✓
 3-29-04 dkw

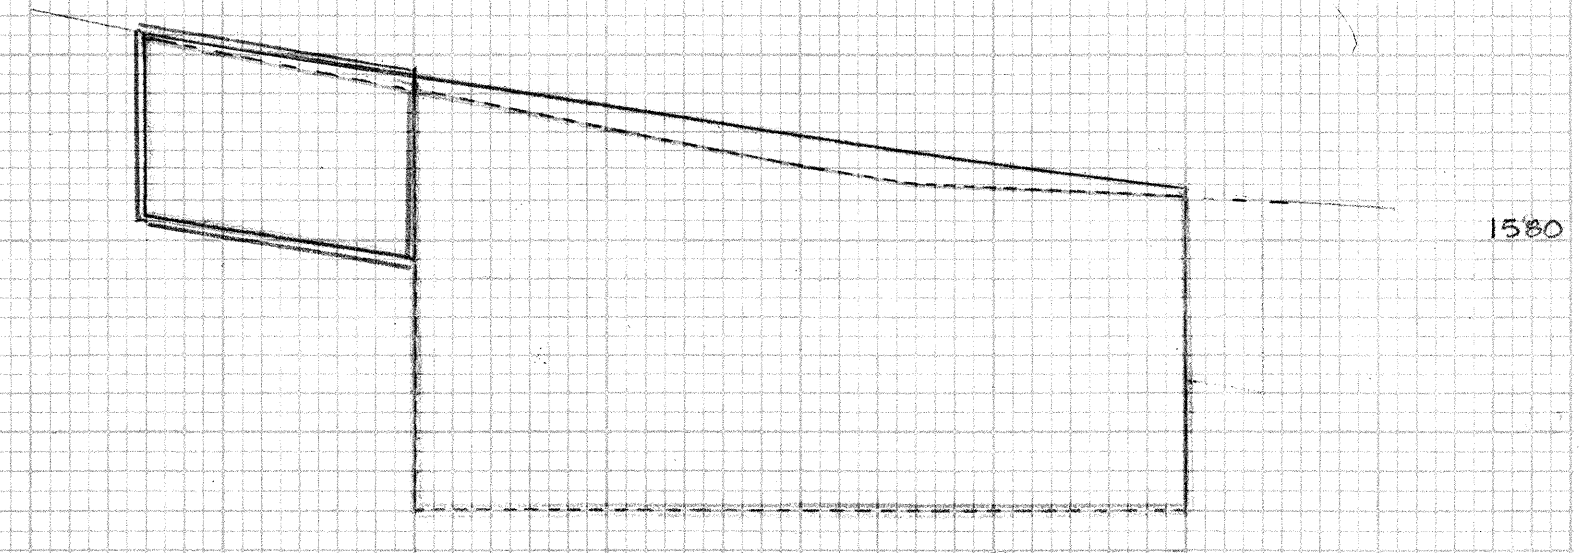

20 15 10 5 0 5 10 15
 1570
 1590