

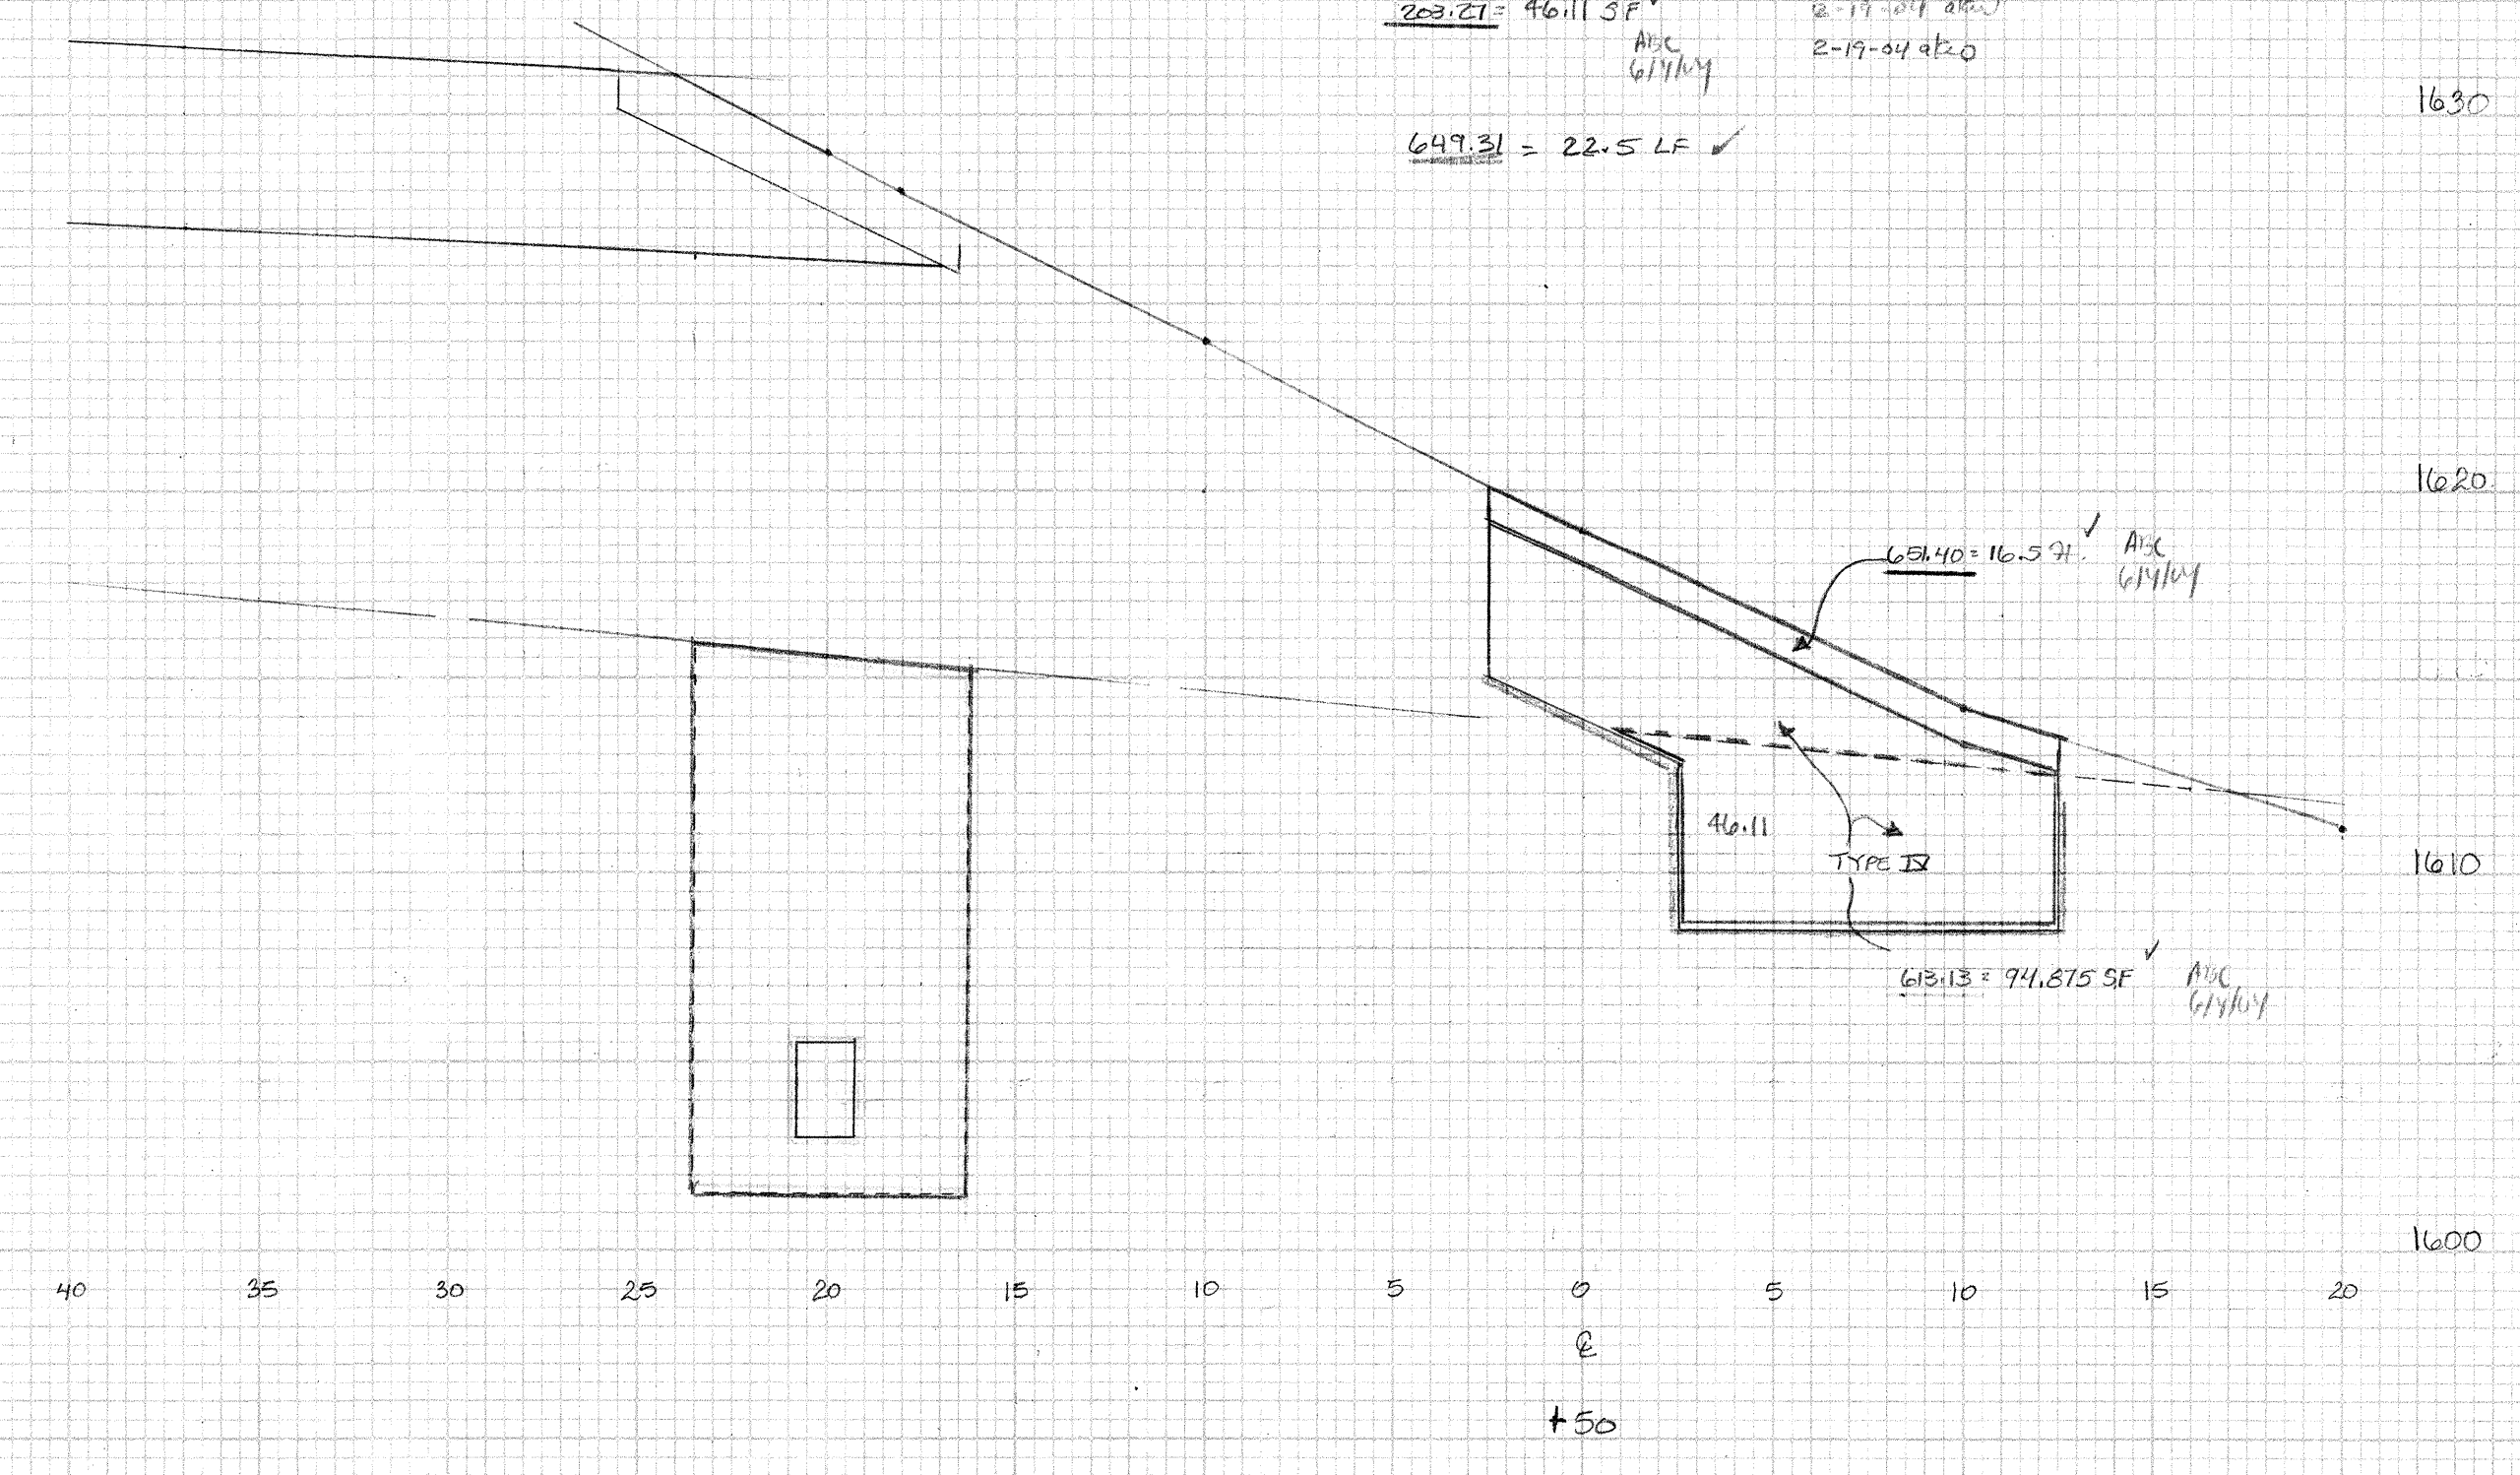


SCALE 1:5 XBR25A-1
* ITEM 204.25 (CALCULATION)
NOT BASED ON THESE SECTIONS
SEE CALCULATION SHEET IN BRIDGE
COMP. BINDER 204.25-25A-A1 A1-2
204.25-25A-A2 (TYP) ABUT #1


204.30 = 98.29 SQ. FT. ✓
204.27 = 102.04 SQ. FT. ✓
203.27 = 96.11 SF ✓
649.31 = 22.5 LF ✓
649.31 = 22.5 LF ✓
649.31 = 22.5 LF ✓

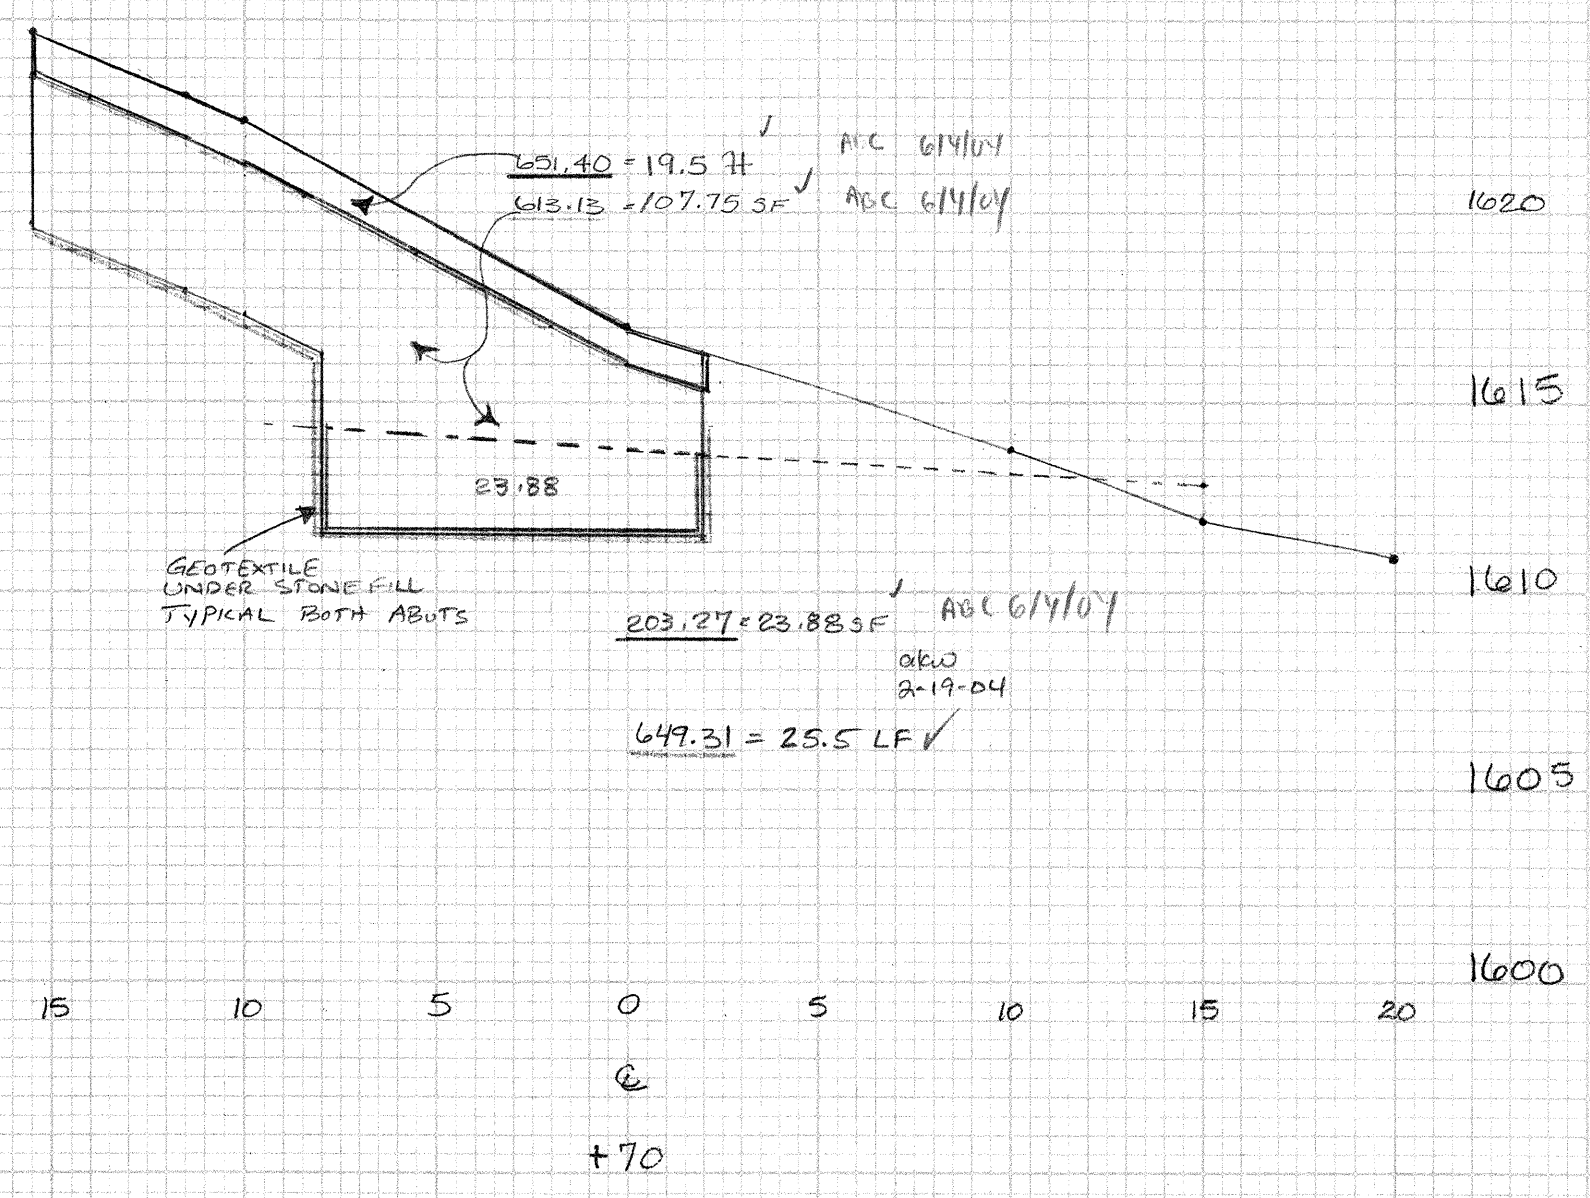

+53.75 ZERO GRAN BACKFILL

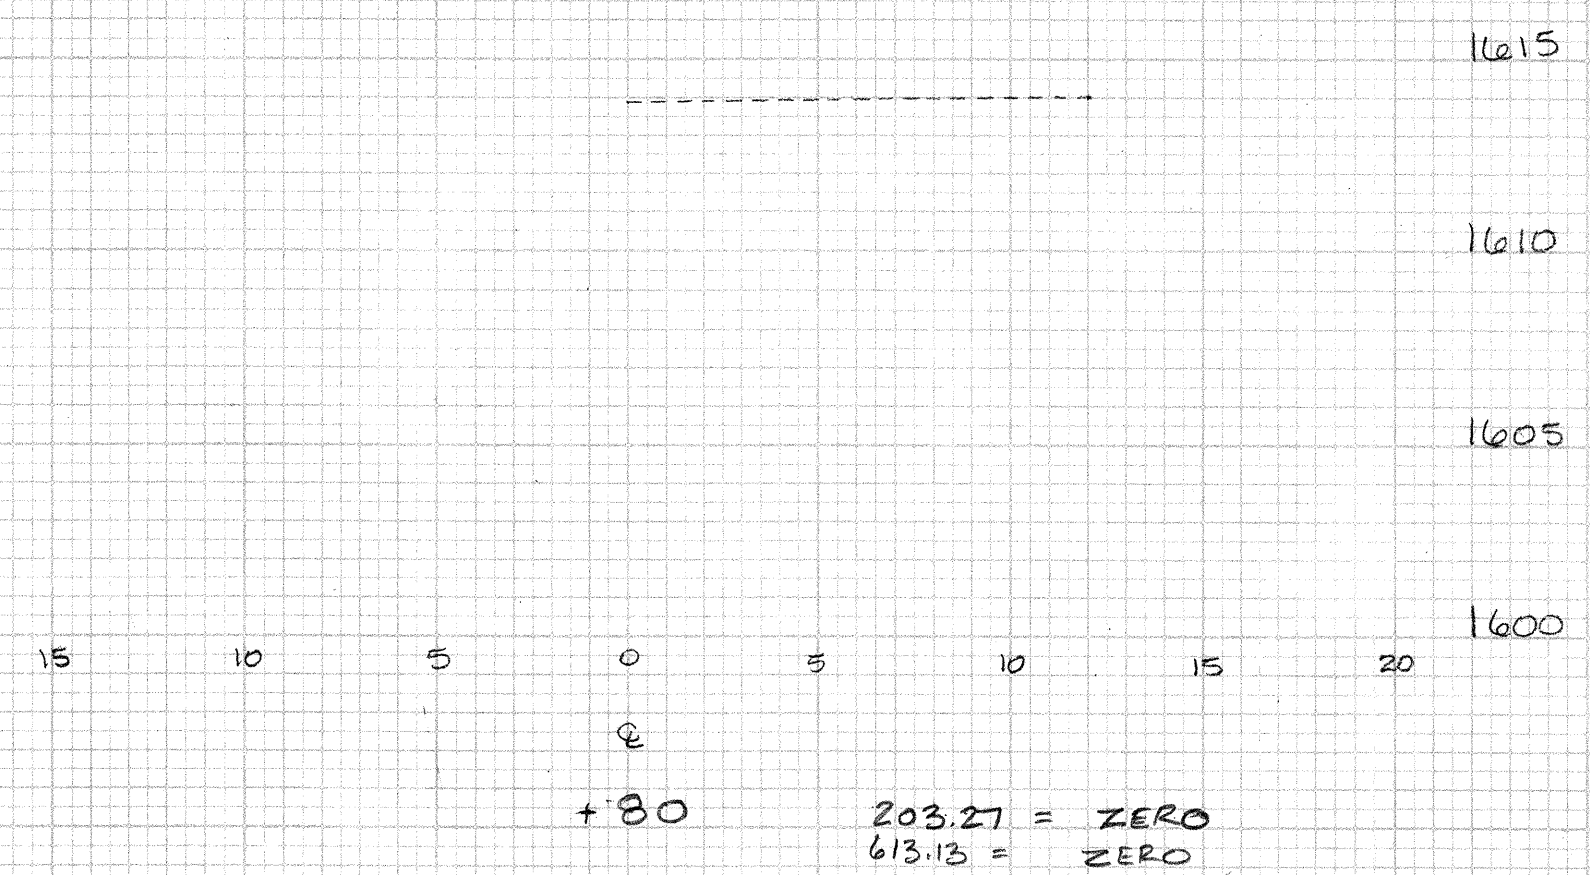

203.27 = ZERO
613.13 = ZERO
649.31 = ZERO ✓
A/C
2/1/05

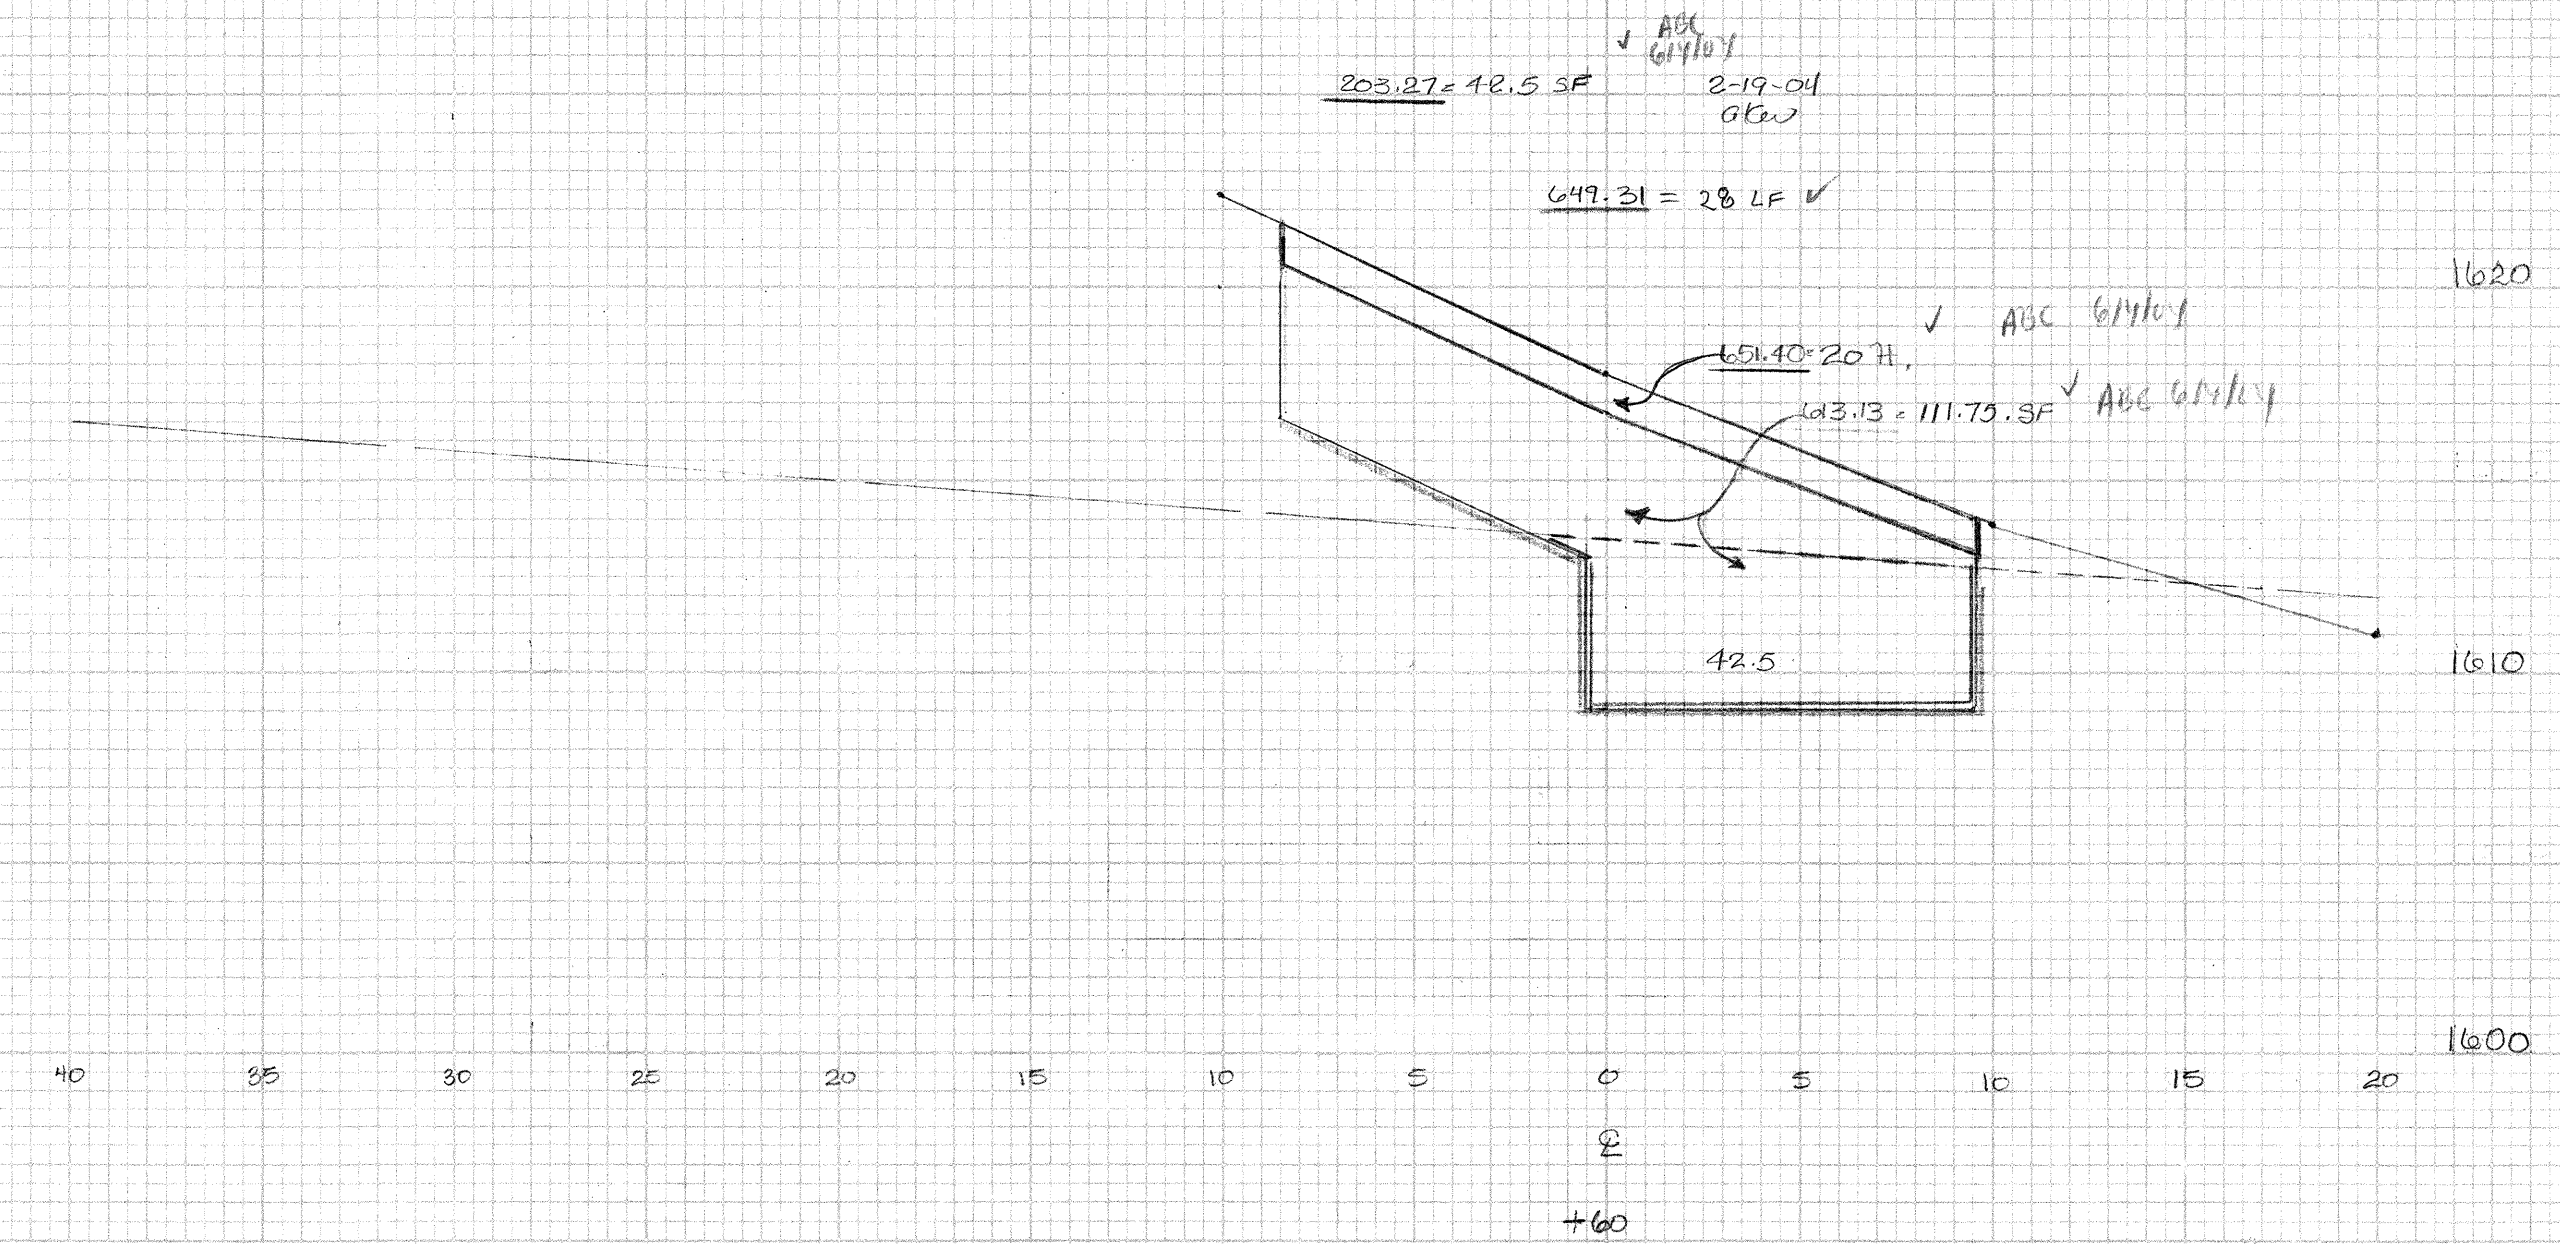

FINAL SURVEY BY DATE
REVISED SURVEY BY DATE
NOTE BOOK NO. DATE
APPAR. NO. DATE

ORIGINAL SURVEY BY DATE
REVISED SURVEY BY DATE
NOTE BOOK NO. DATE
APPAR. NO. DATE