



FINAL SURVEY  
 SURVEYED, PLOTTED, AND CHECKED  
 DATE: \_\_\_\_\_ BY: \_\_\_\_\_  
 NOTE BOOK AREA: \_\_\_\_\_  
 NO. \_\_\_\_\_ AREA CHECKED: \_\_\_\_\_


**VOID\***  
 204.25 - 259.21 SQ. FT.  
 204.30 - 253.80 - 7.20 + 55.58 + 6.88 + 9.58 + 37.83 + 320.79 SQ. FT.  
 203.27 = 96.50 SF  
 2-17-04  
 ABL  
 6-4-04

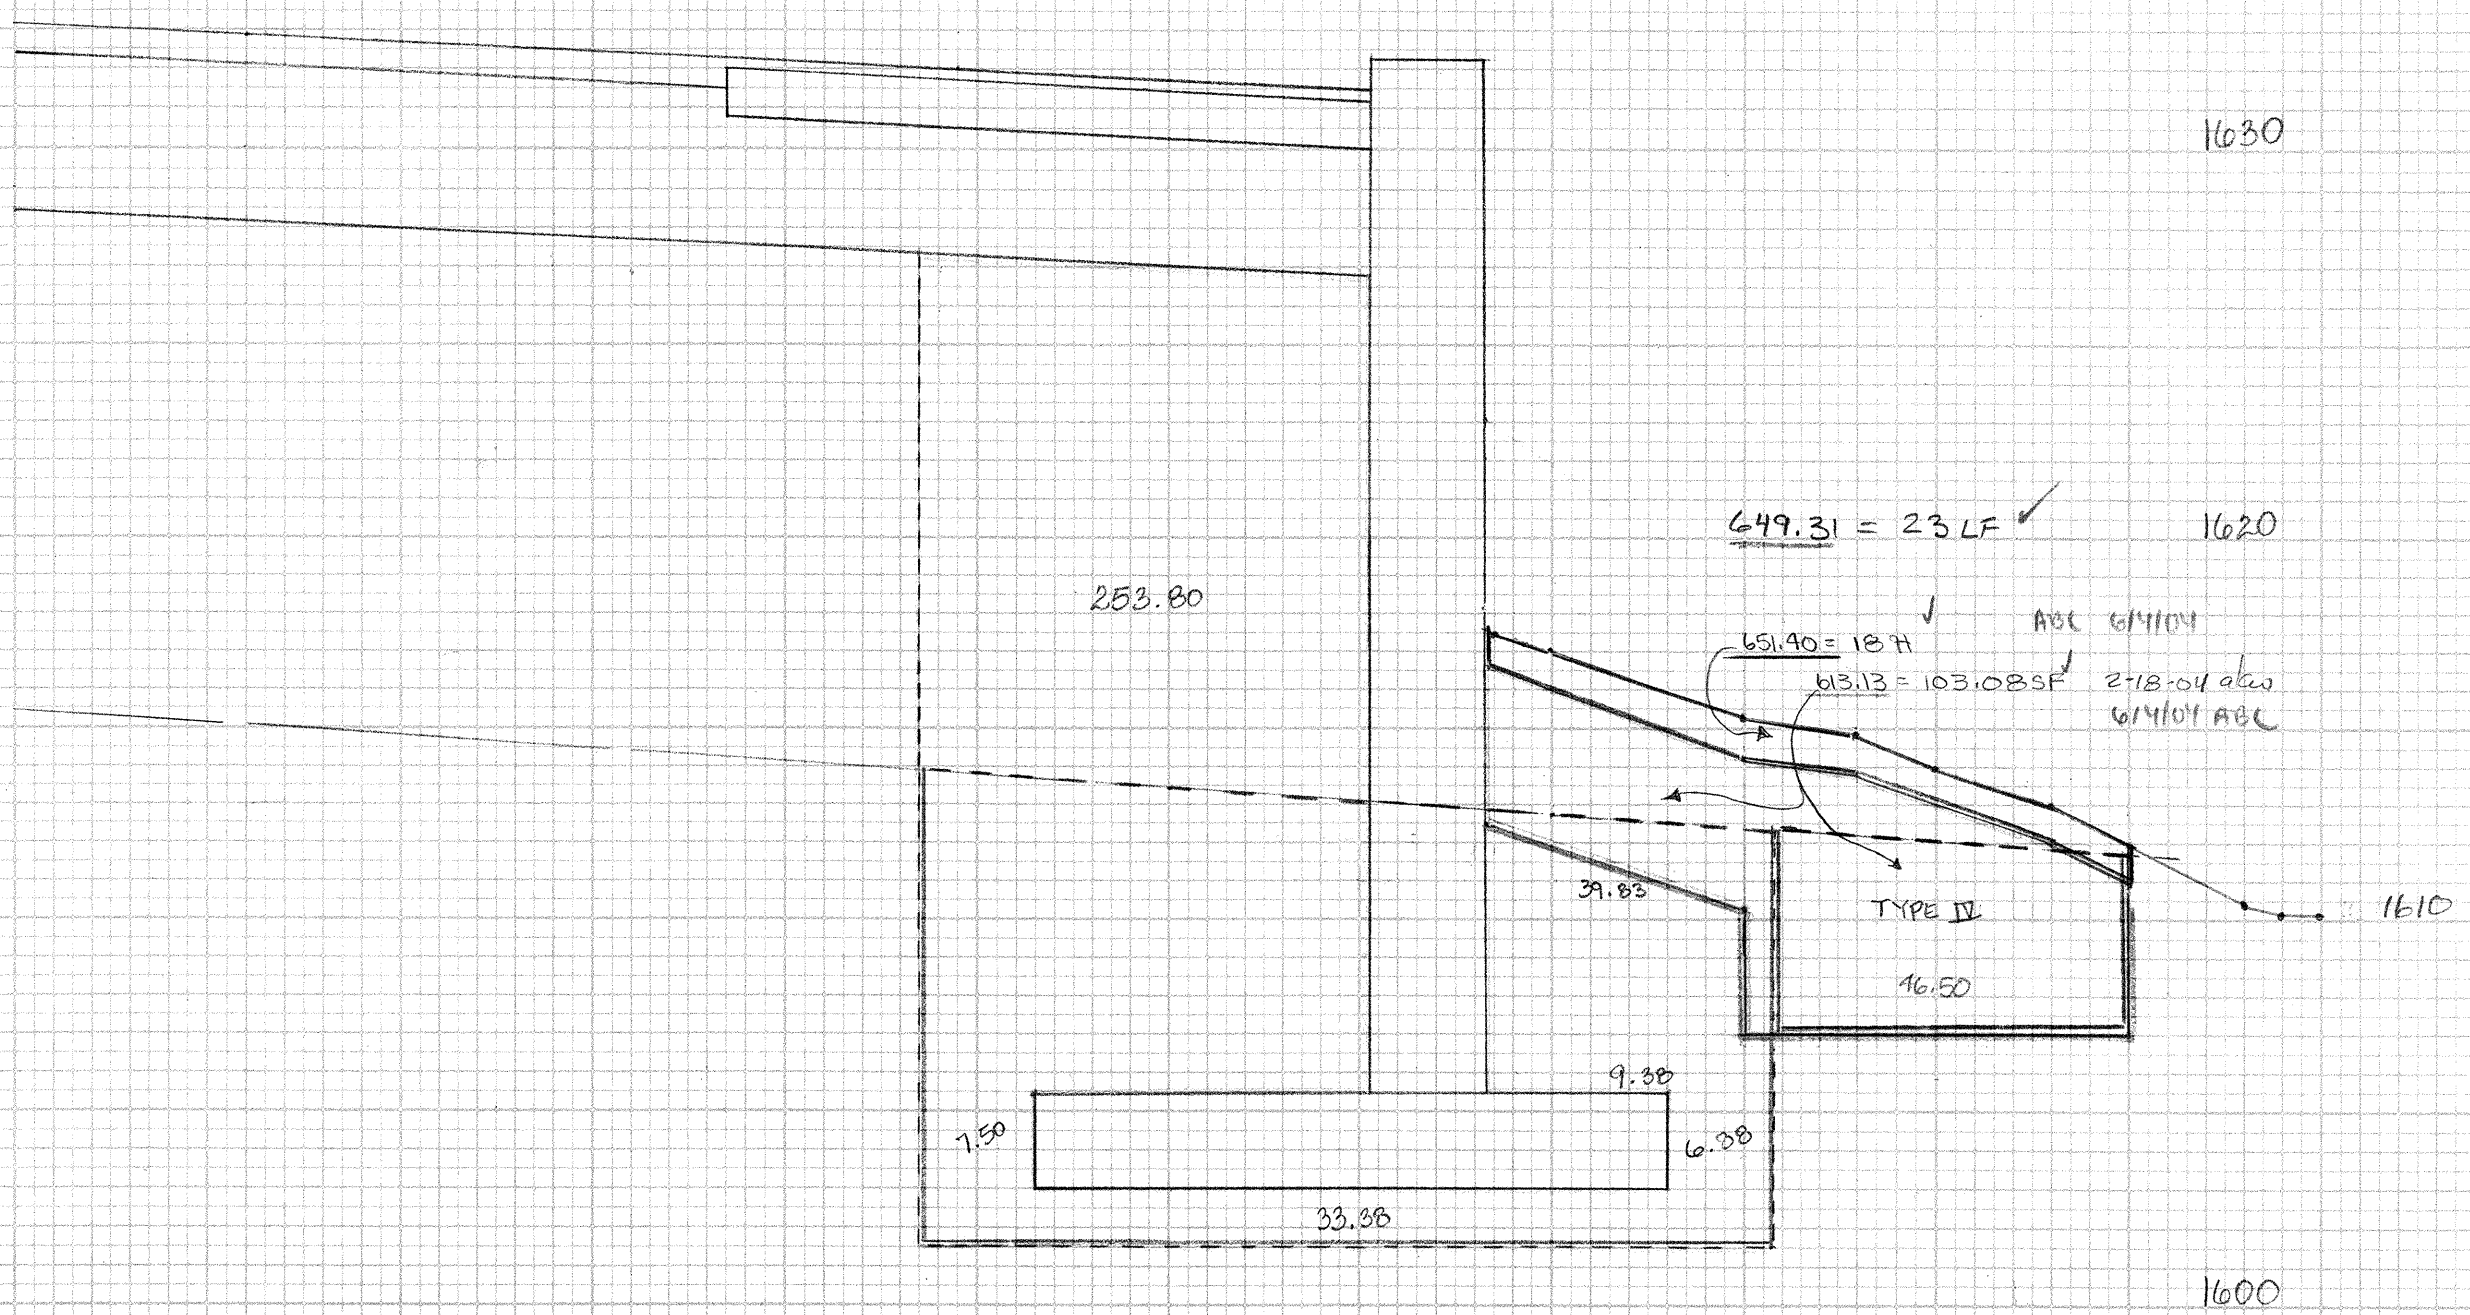


ABL 6/4/04  
 384.73  
 204.30 - 252.33 - 8.10 + 55.58 + 6.88 + 58.51 + 391.22 SQ. FT.  
 203.27 = 49.79 SF  
 2-17-04  
 ABL  
 6/4/04

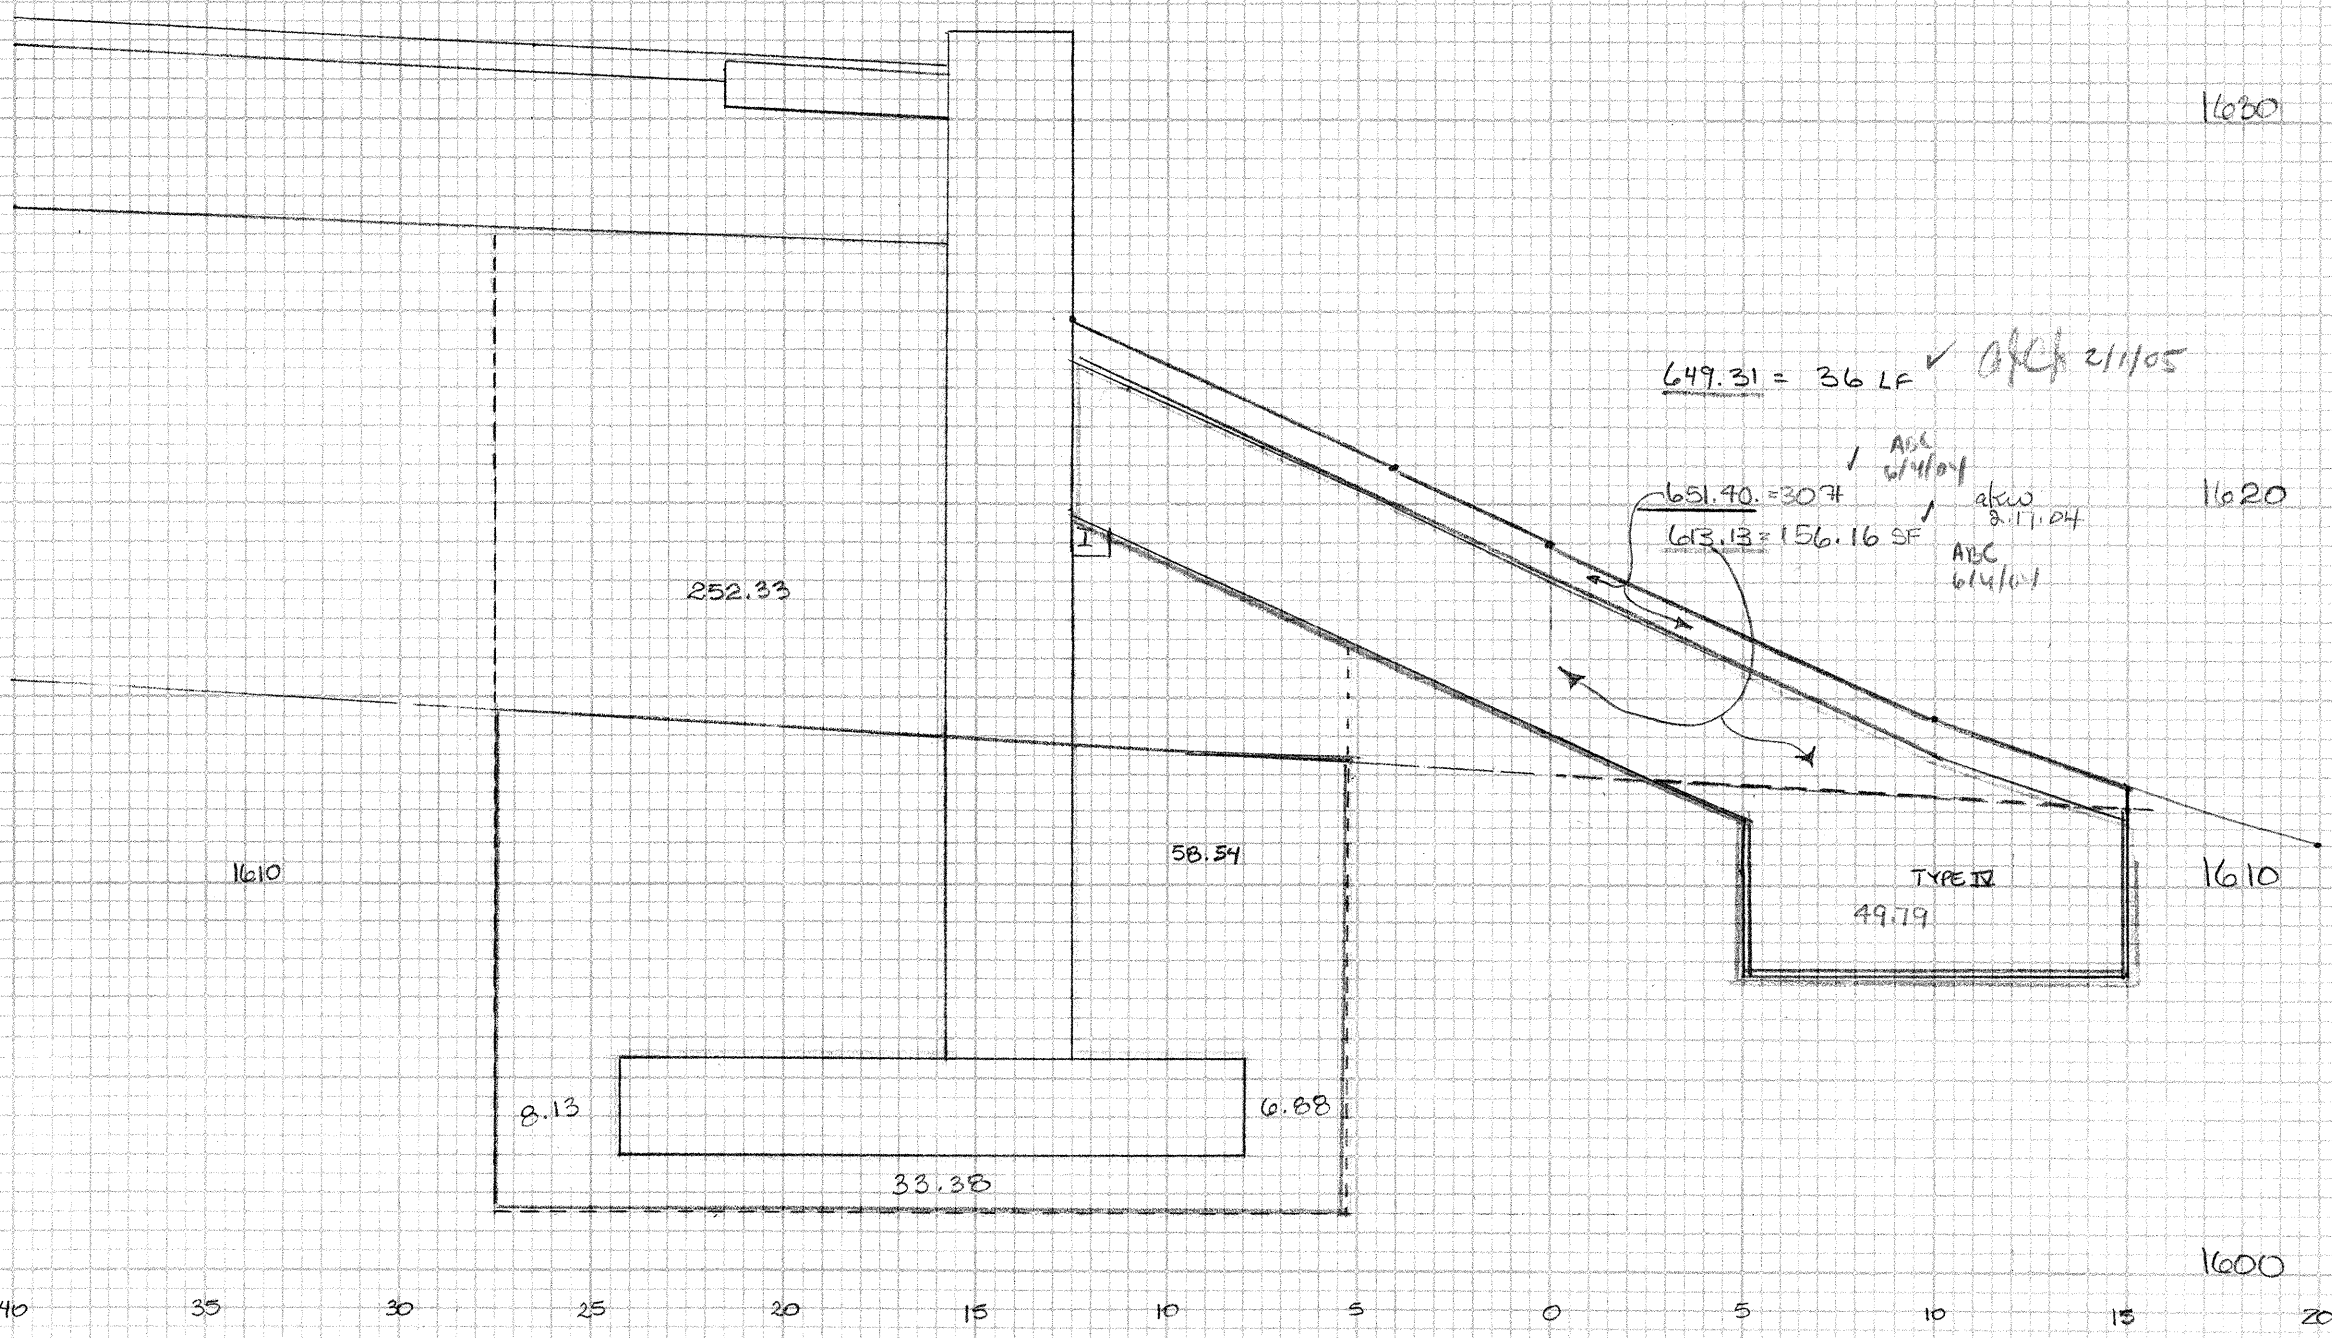

**VOID\***  
 204.25 - 187.45 SQ. FT.  
 204.30 - 182.10 - 5.12 + 27.75 + 5 + 5 + 17.88 + 273.03 SQ. FT.  
 203.27 = 86.55 SF  
 2-17-04  
 ABL  
 6/4/04

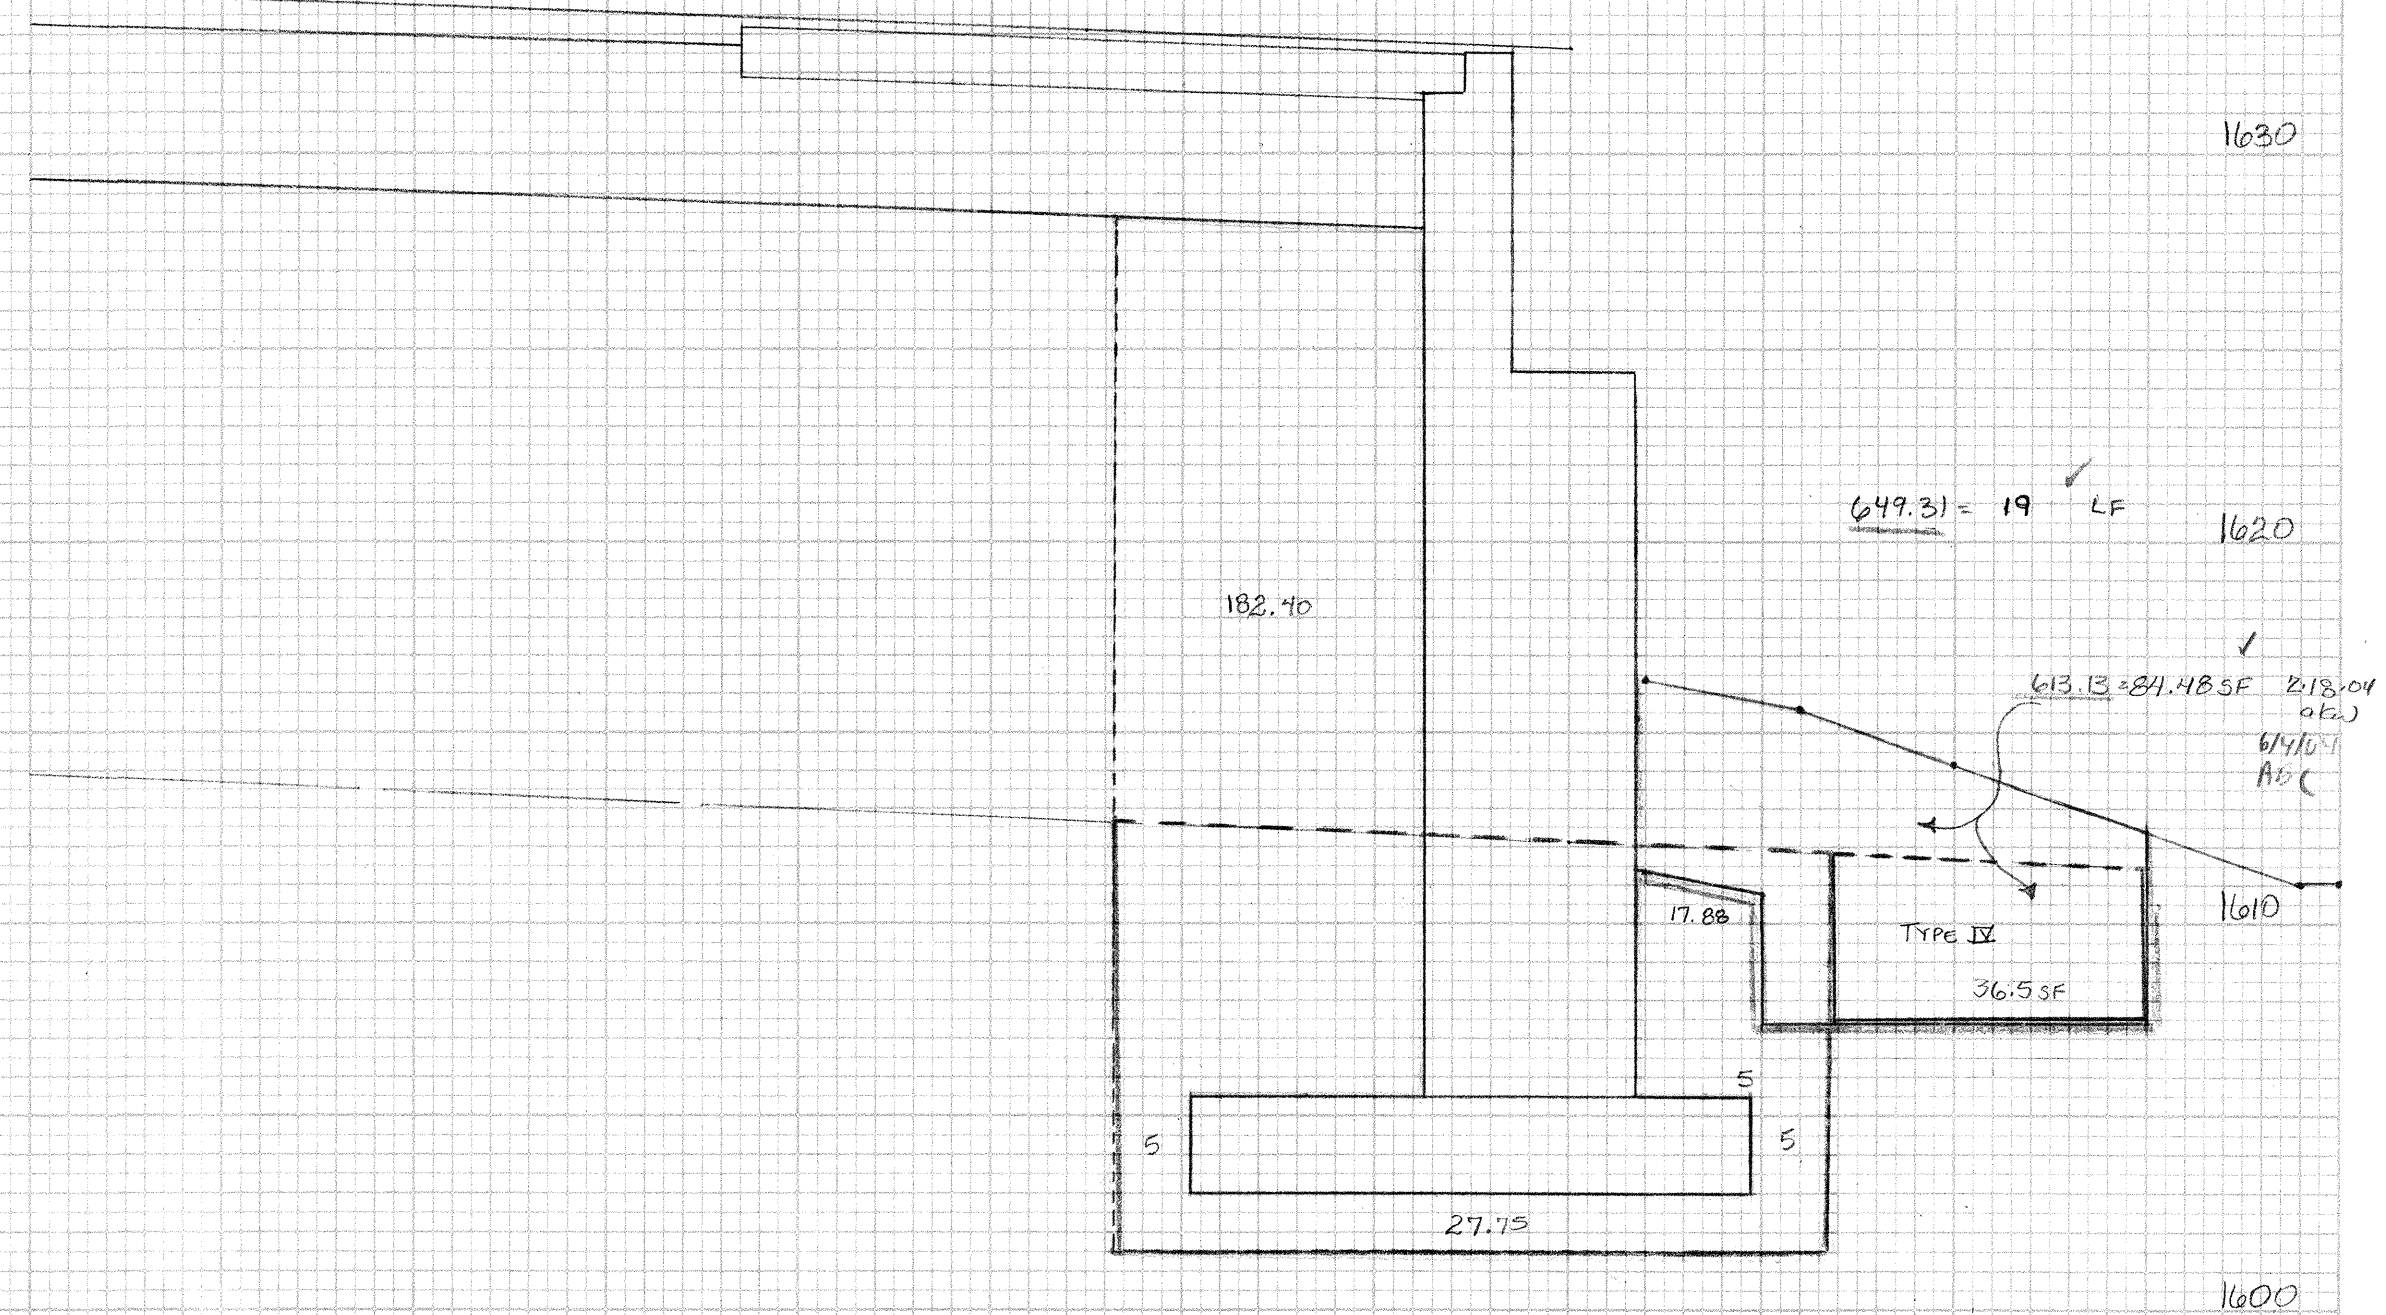

ABL 6/4/04  
 254.75 SF  
 204.30 - 175.40 - 5.12 + 27.75 + 5 + 5 + 18.85 + 237 SQ. FT.  
 203.27 = 37.97 SF  
 2-17-04  
 ABL  
 6/4/04

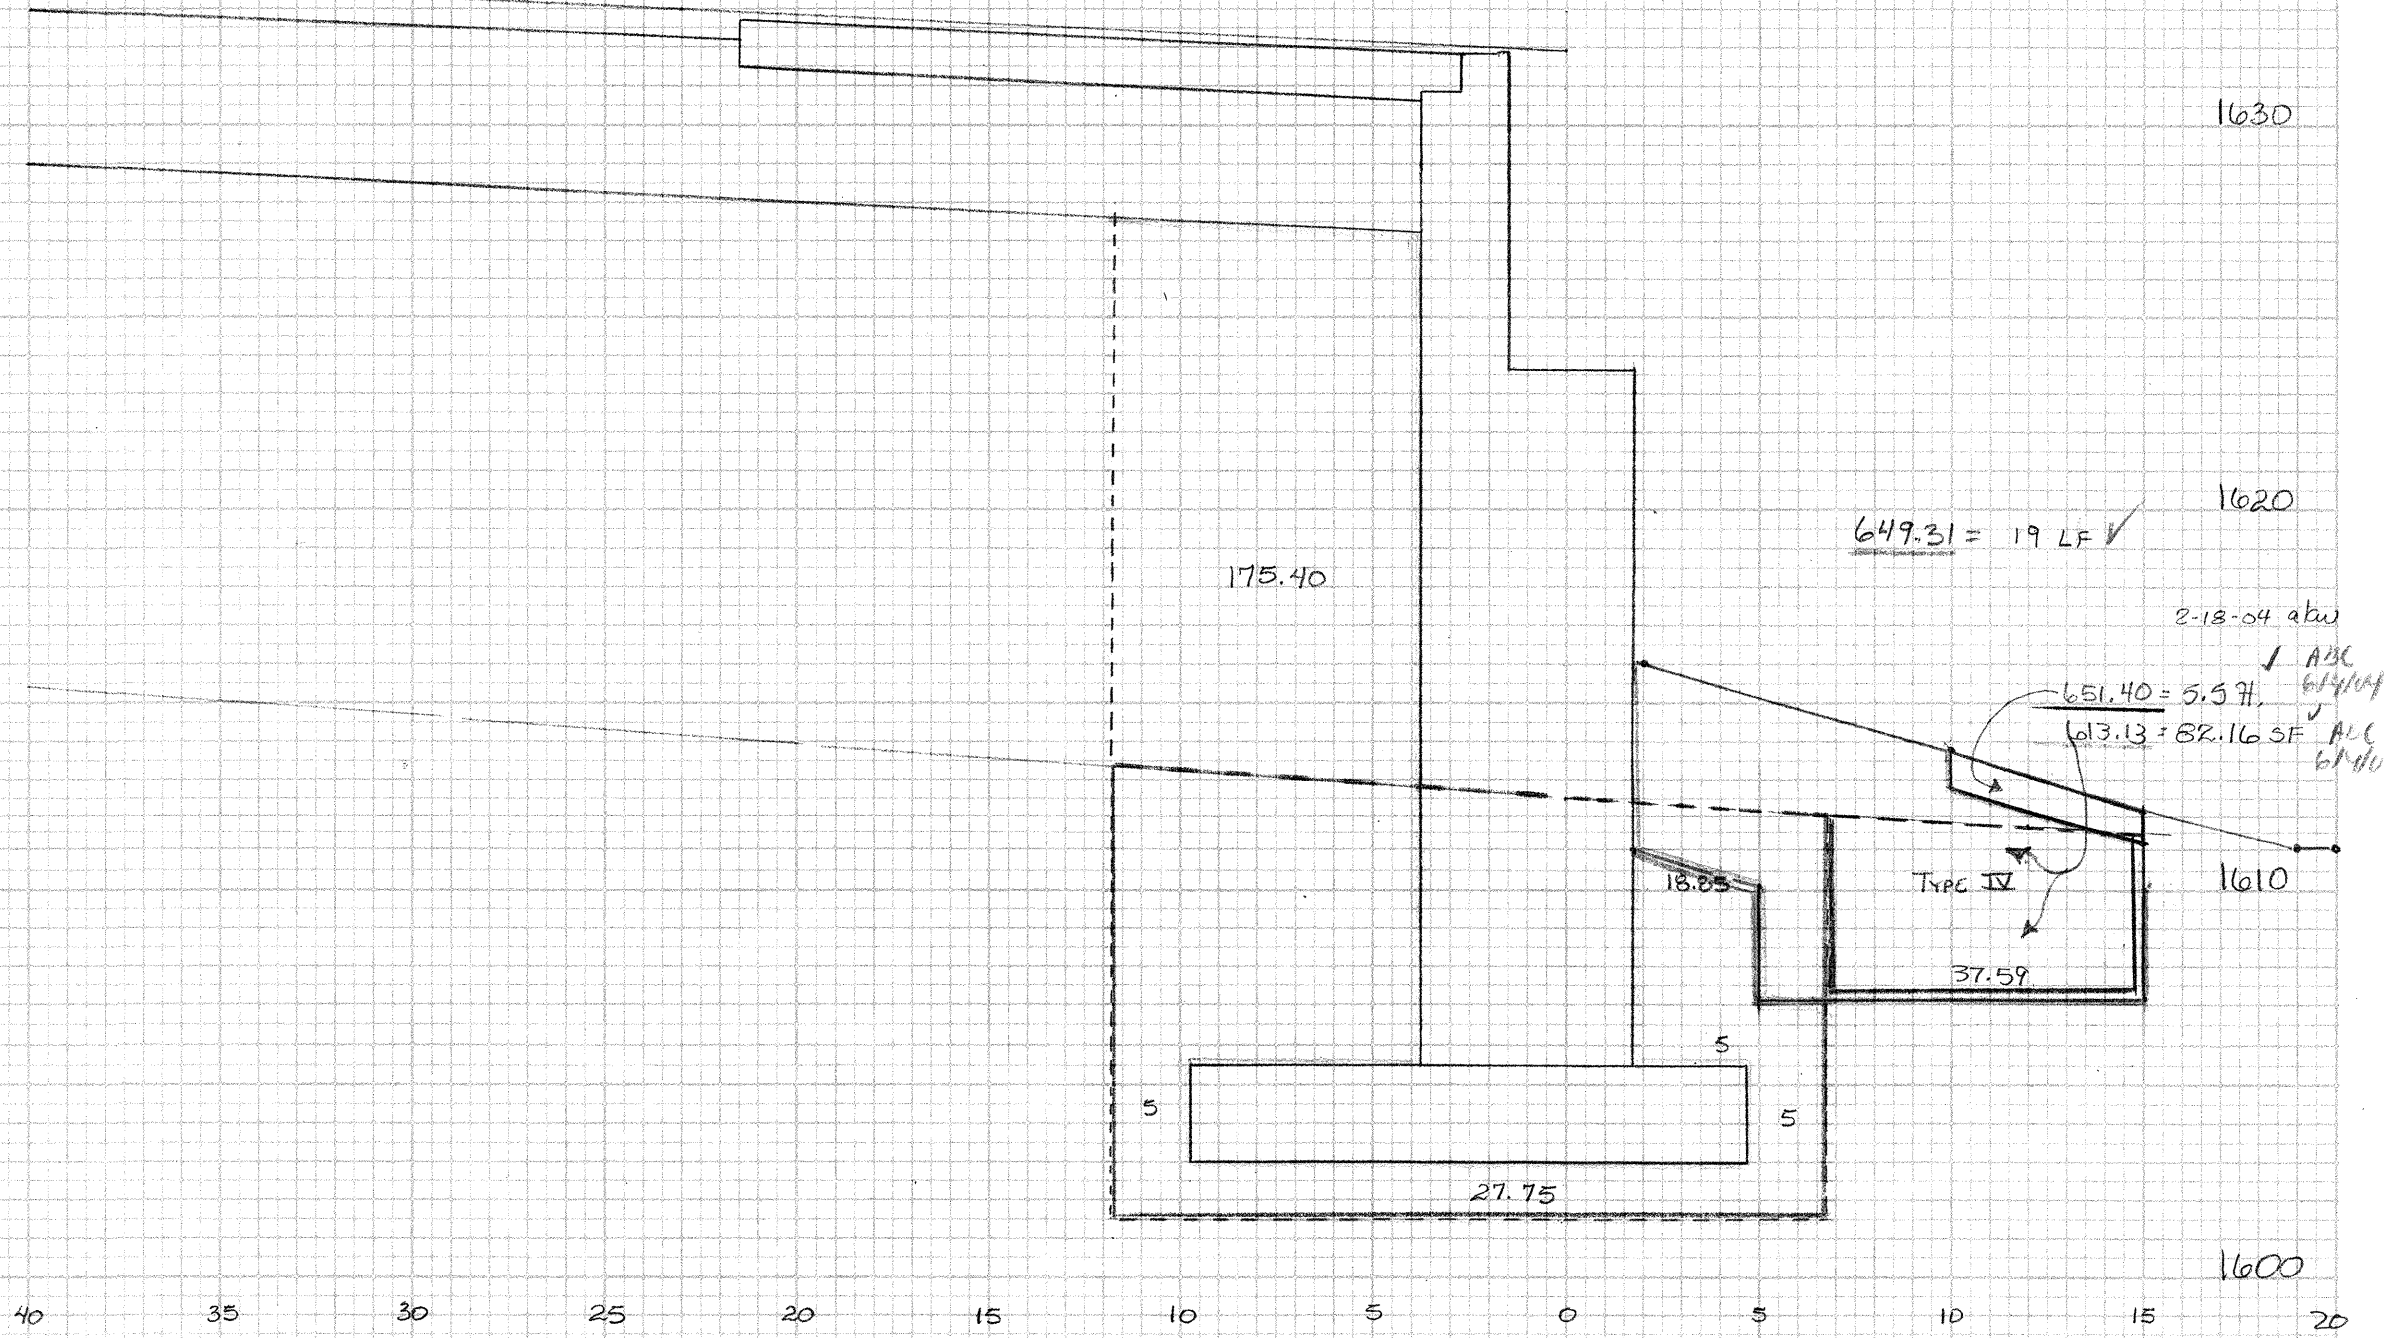

BR25A  
 ABUT #1  
 SCALE 1:5  
 \* ITEM 204.25 CALCULATION NOT BASED ON THESE SECTIONS SEE CALCULATION SHEETS SEE NOTE ON XBR25A-1