
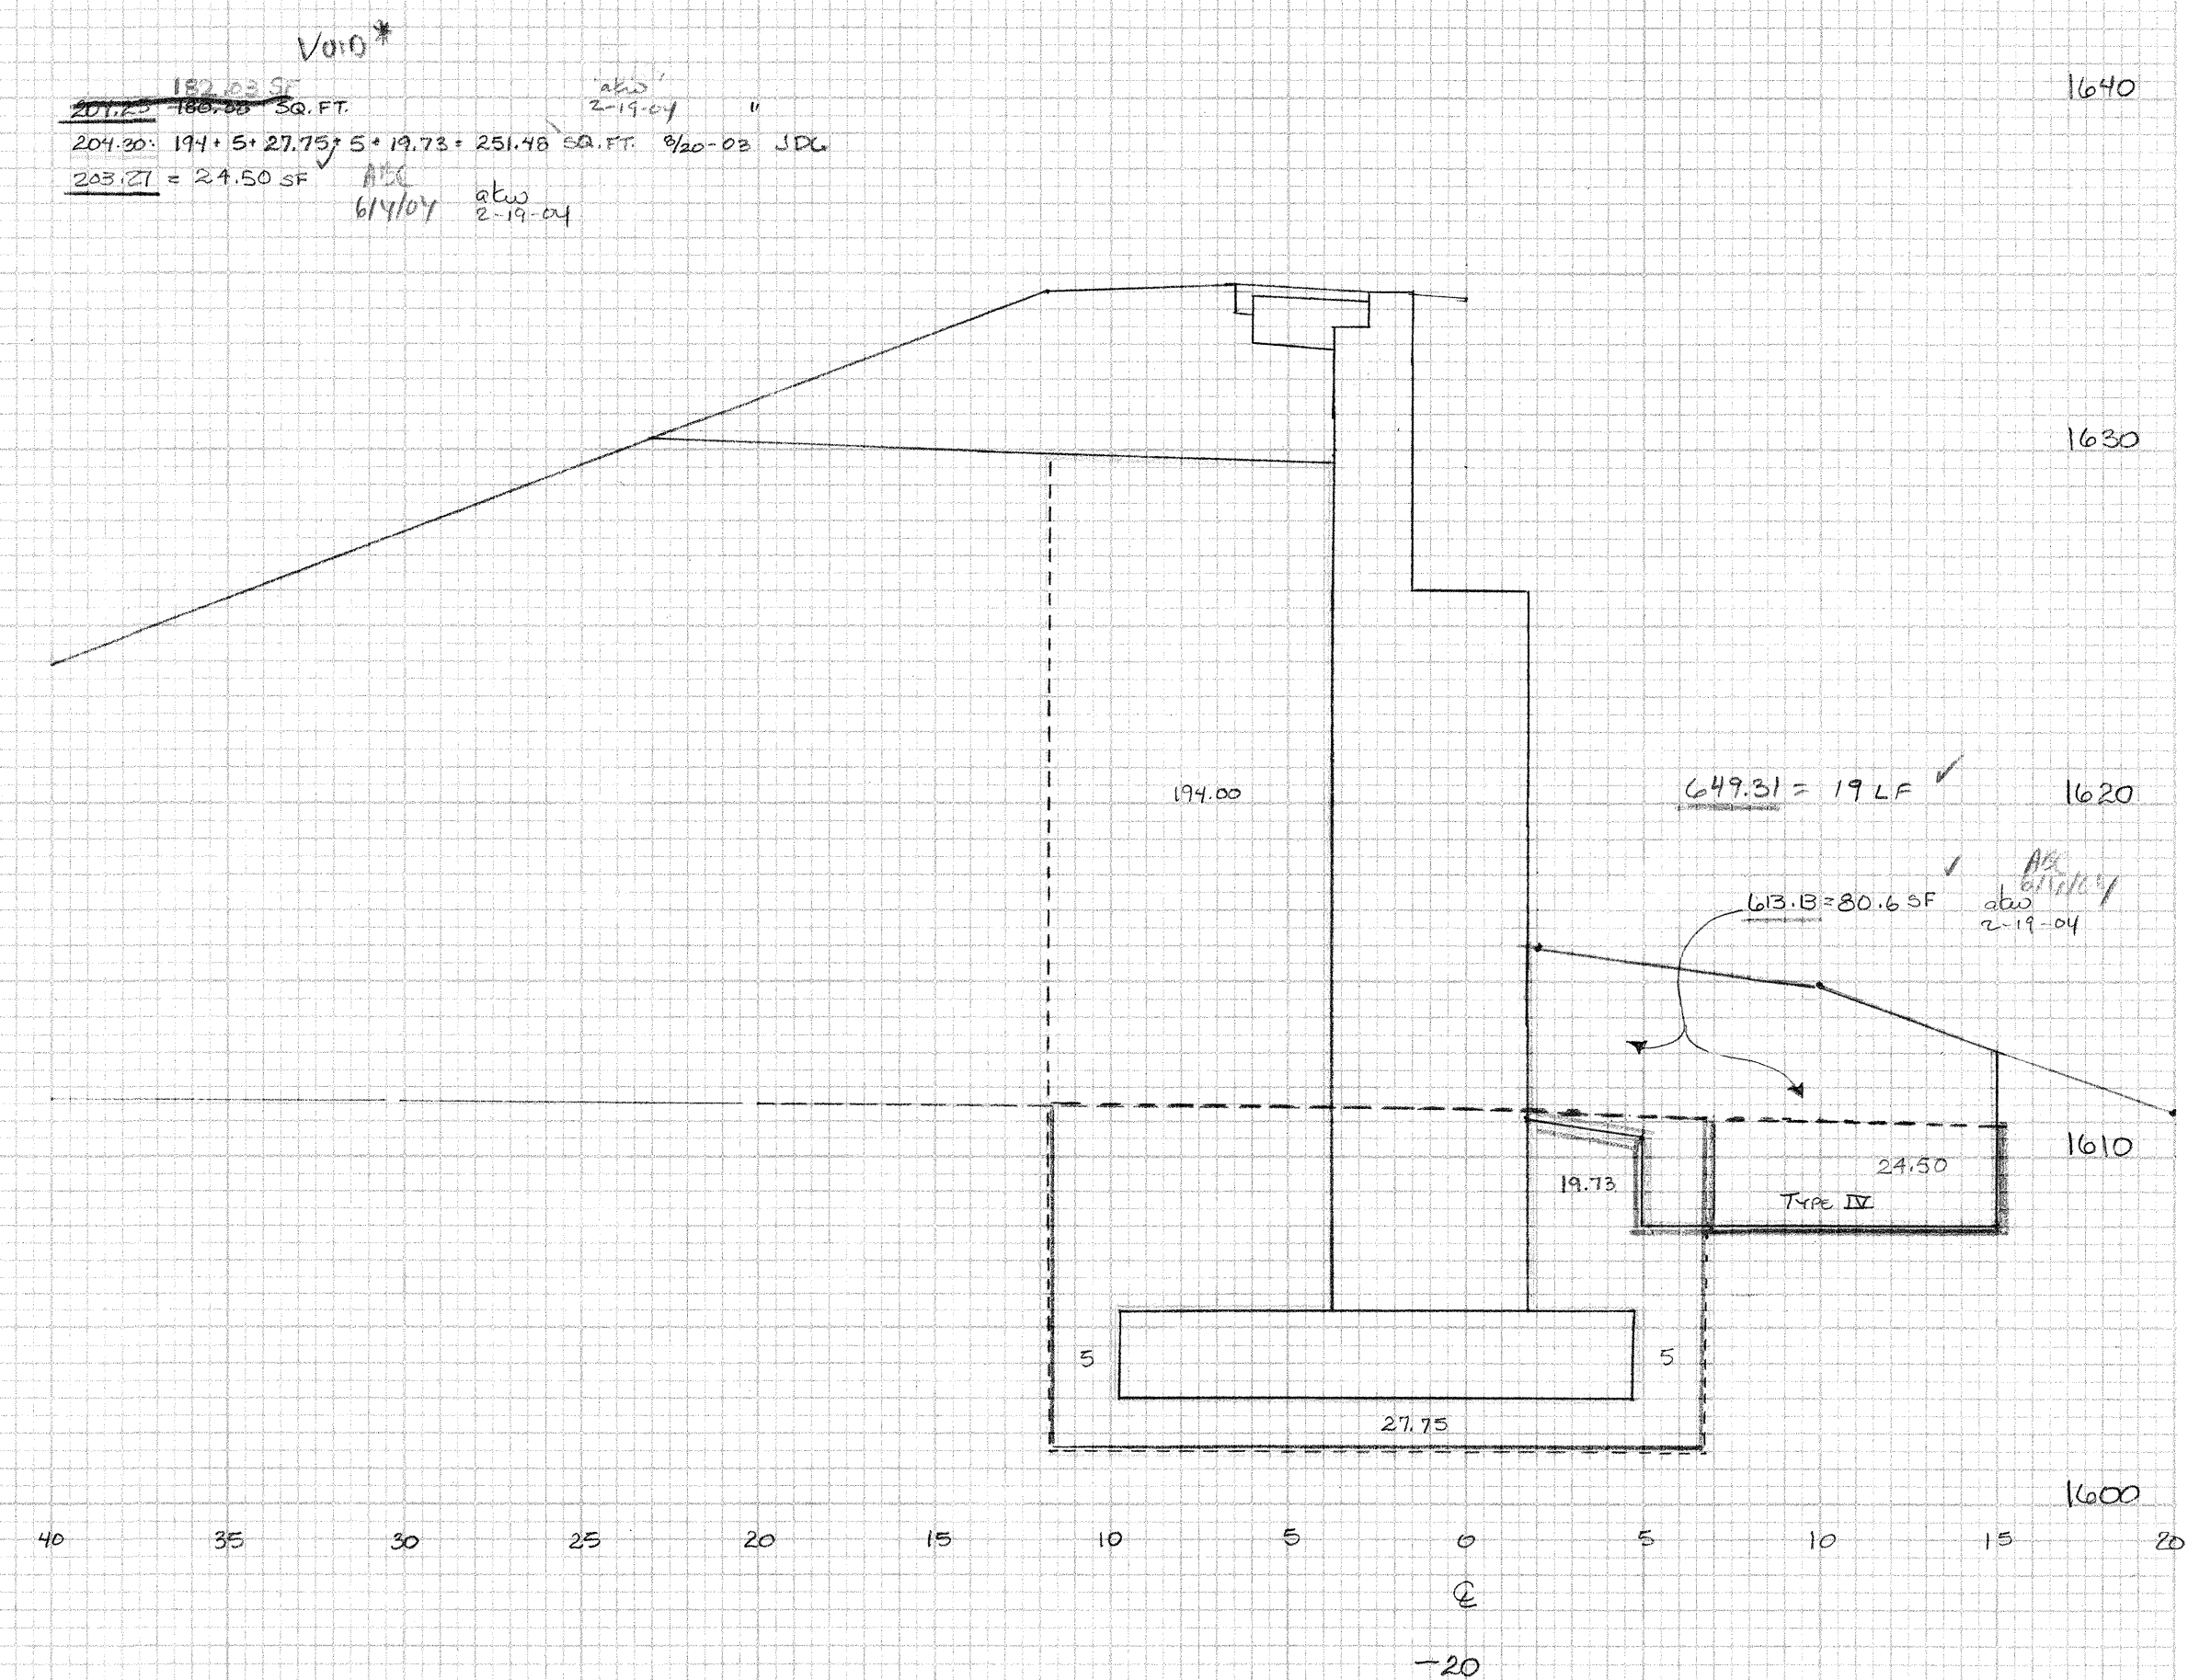
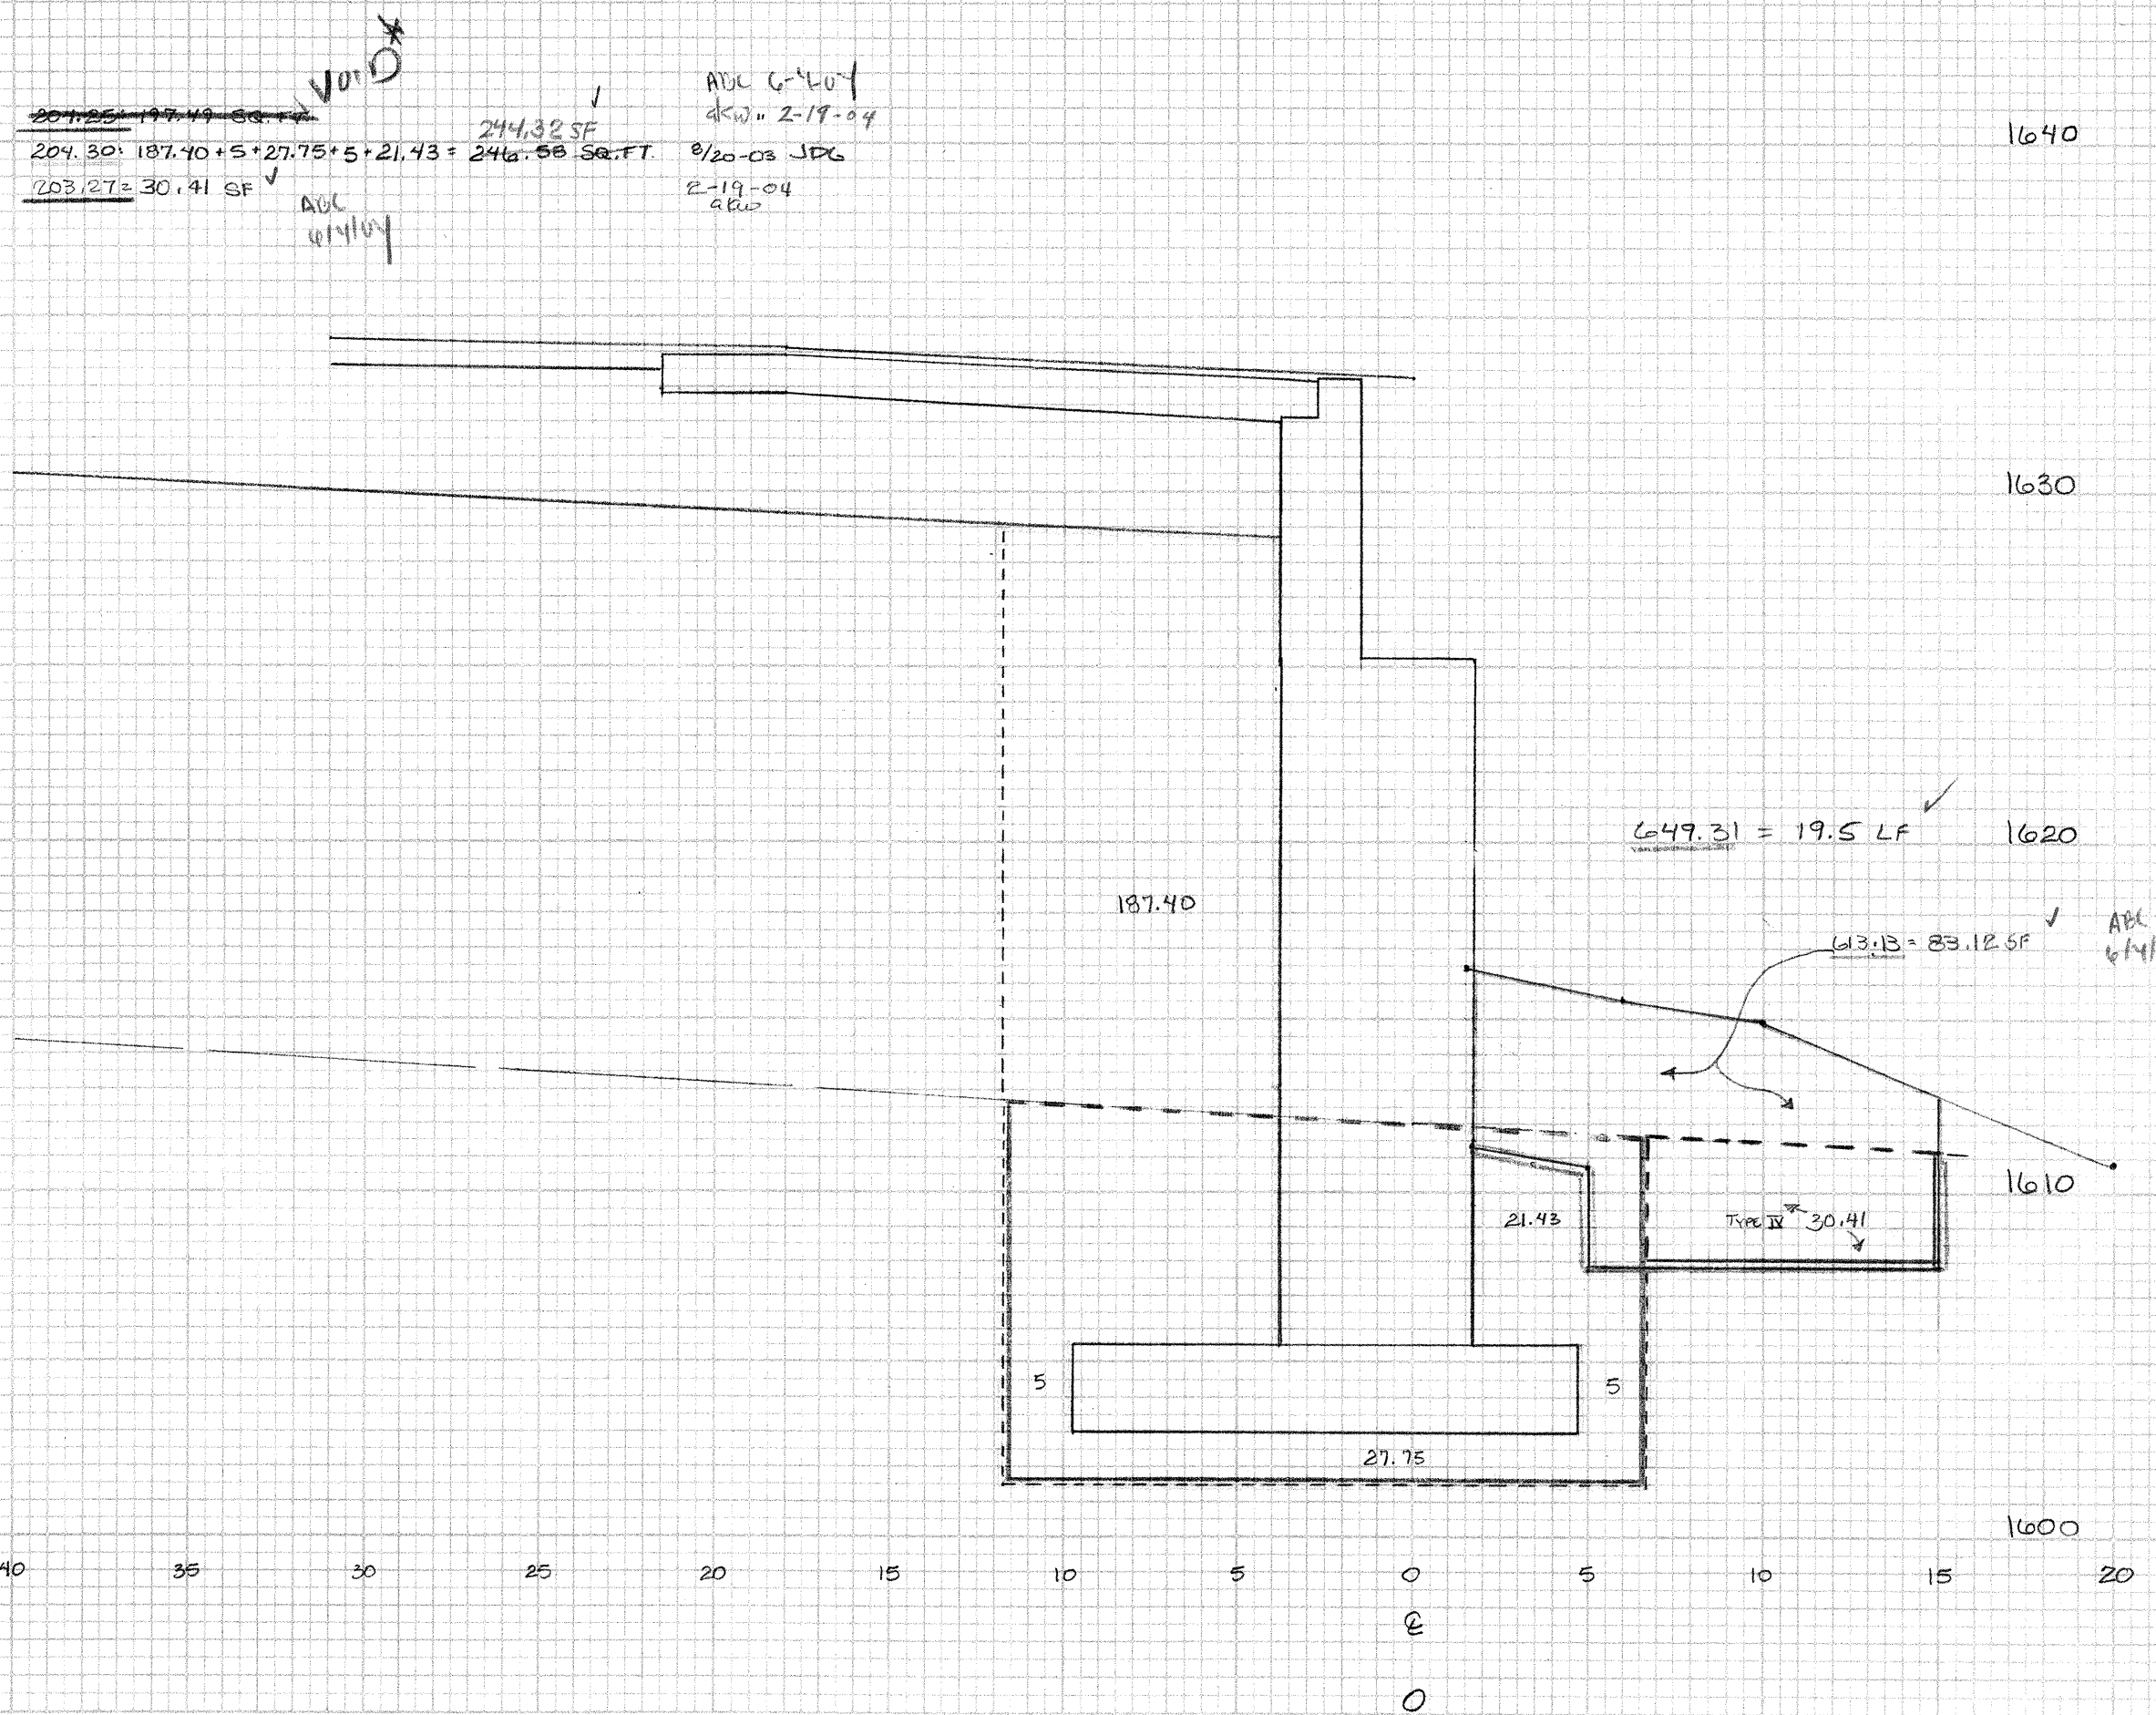
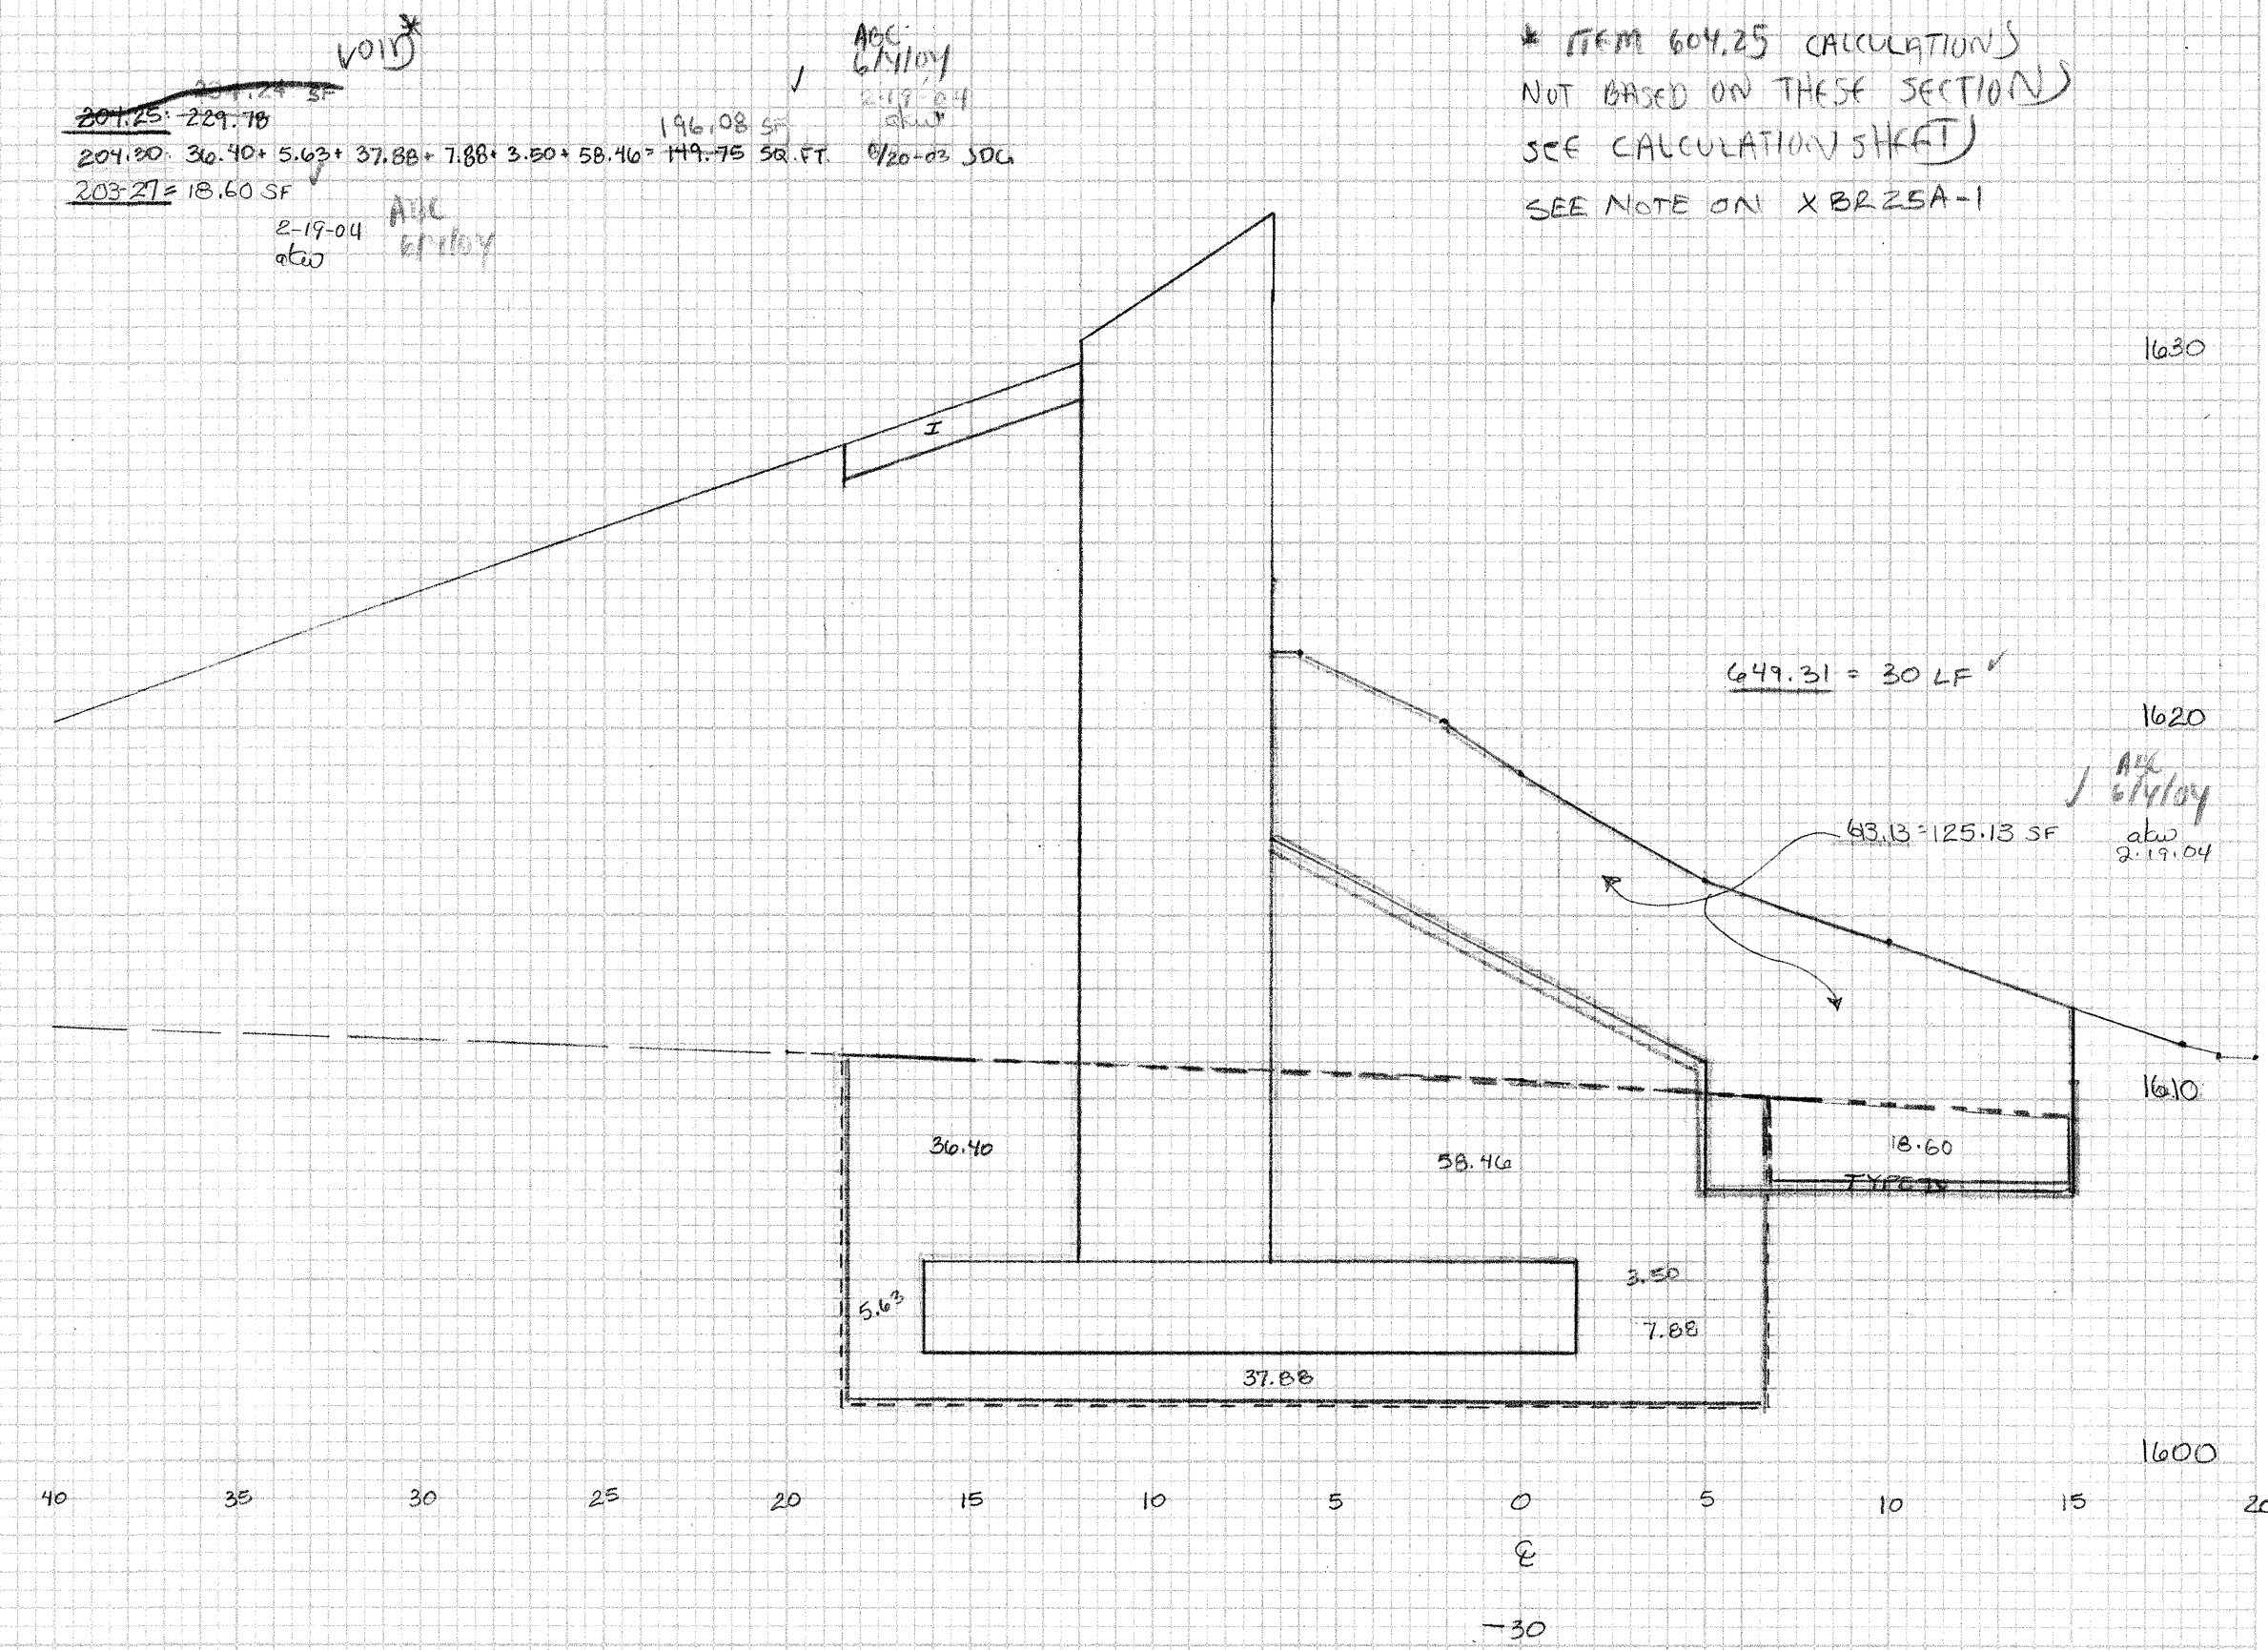


FINAL SURVEY
 SURVEYED BY: _____
 PLOTTED BY: _____
 NOTE BOOK NO.: _____
 AREA & DISTANCE: _____

ORIGINAL SURVEY
 SURVEYED BY: _____
 PLOTTED BY: _____
 NOTE BOOK NO.: _____
 AREA & DISTANCE: _____

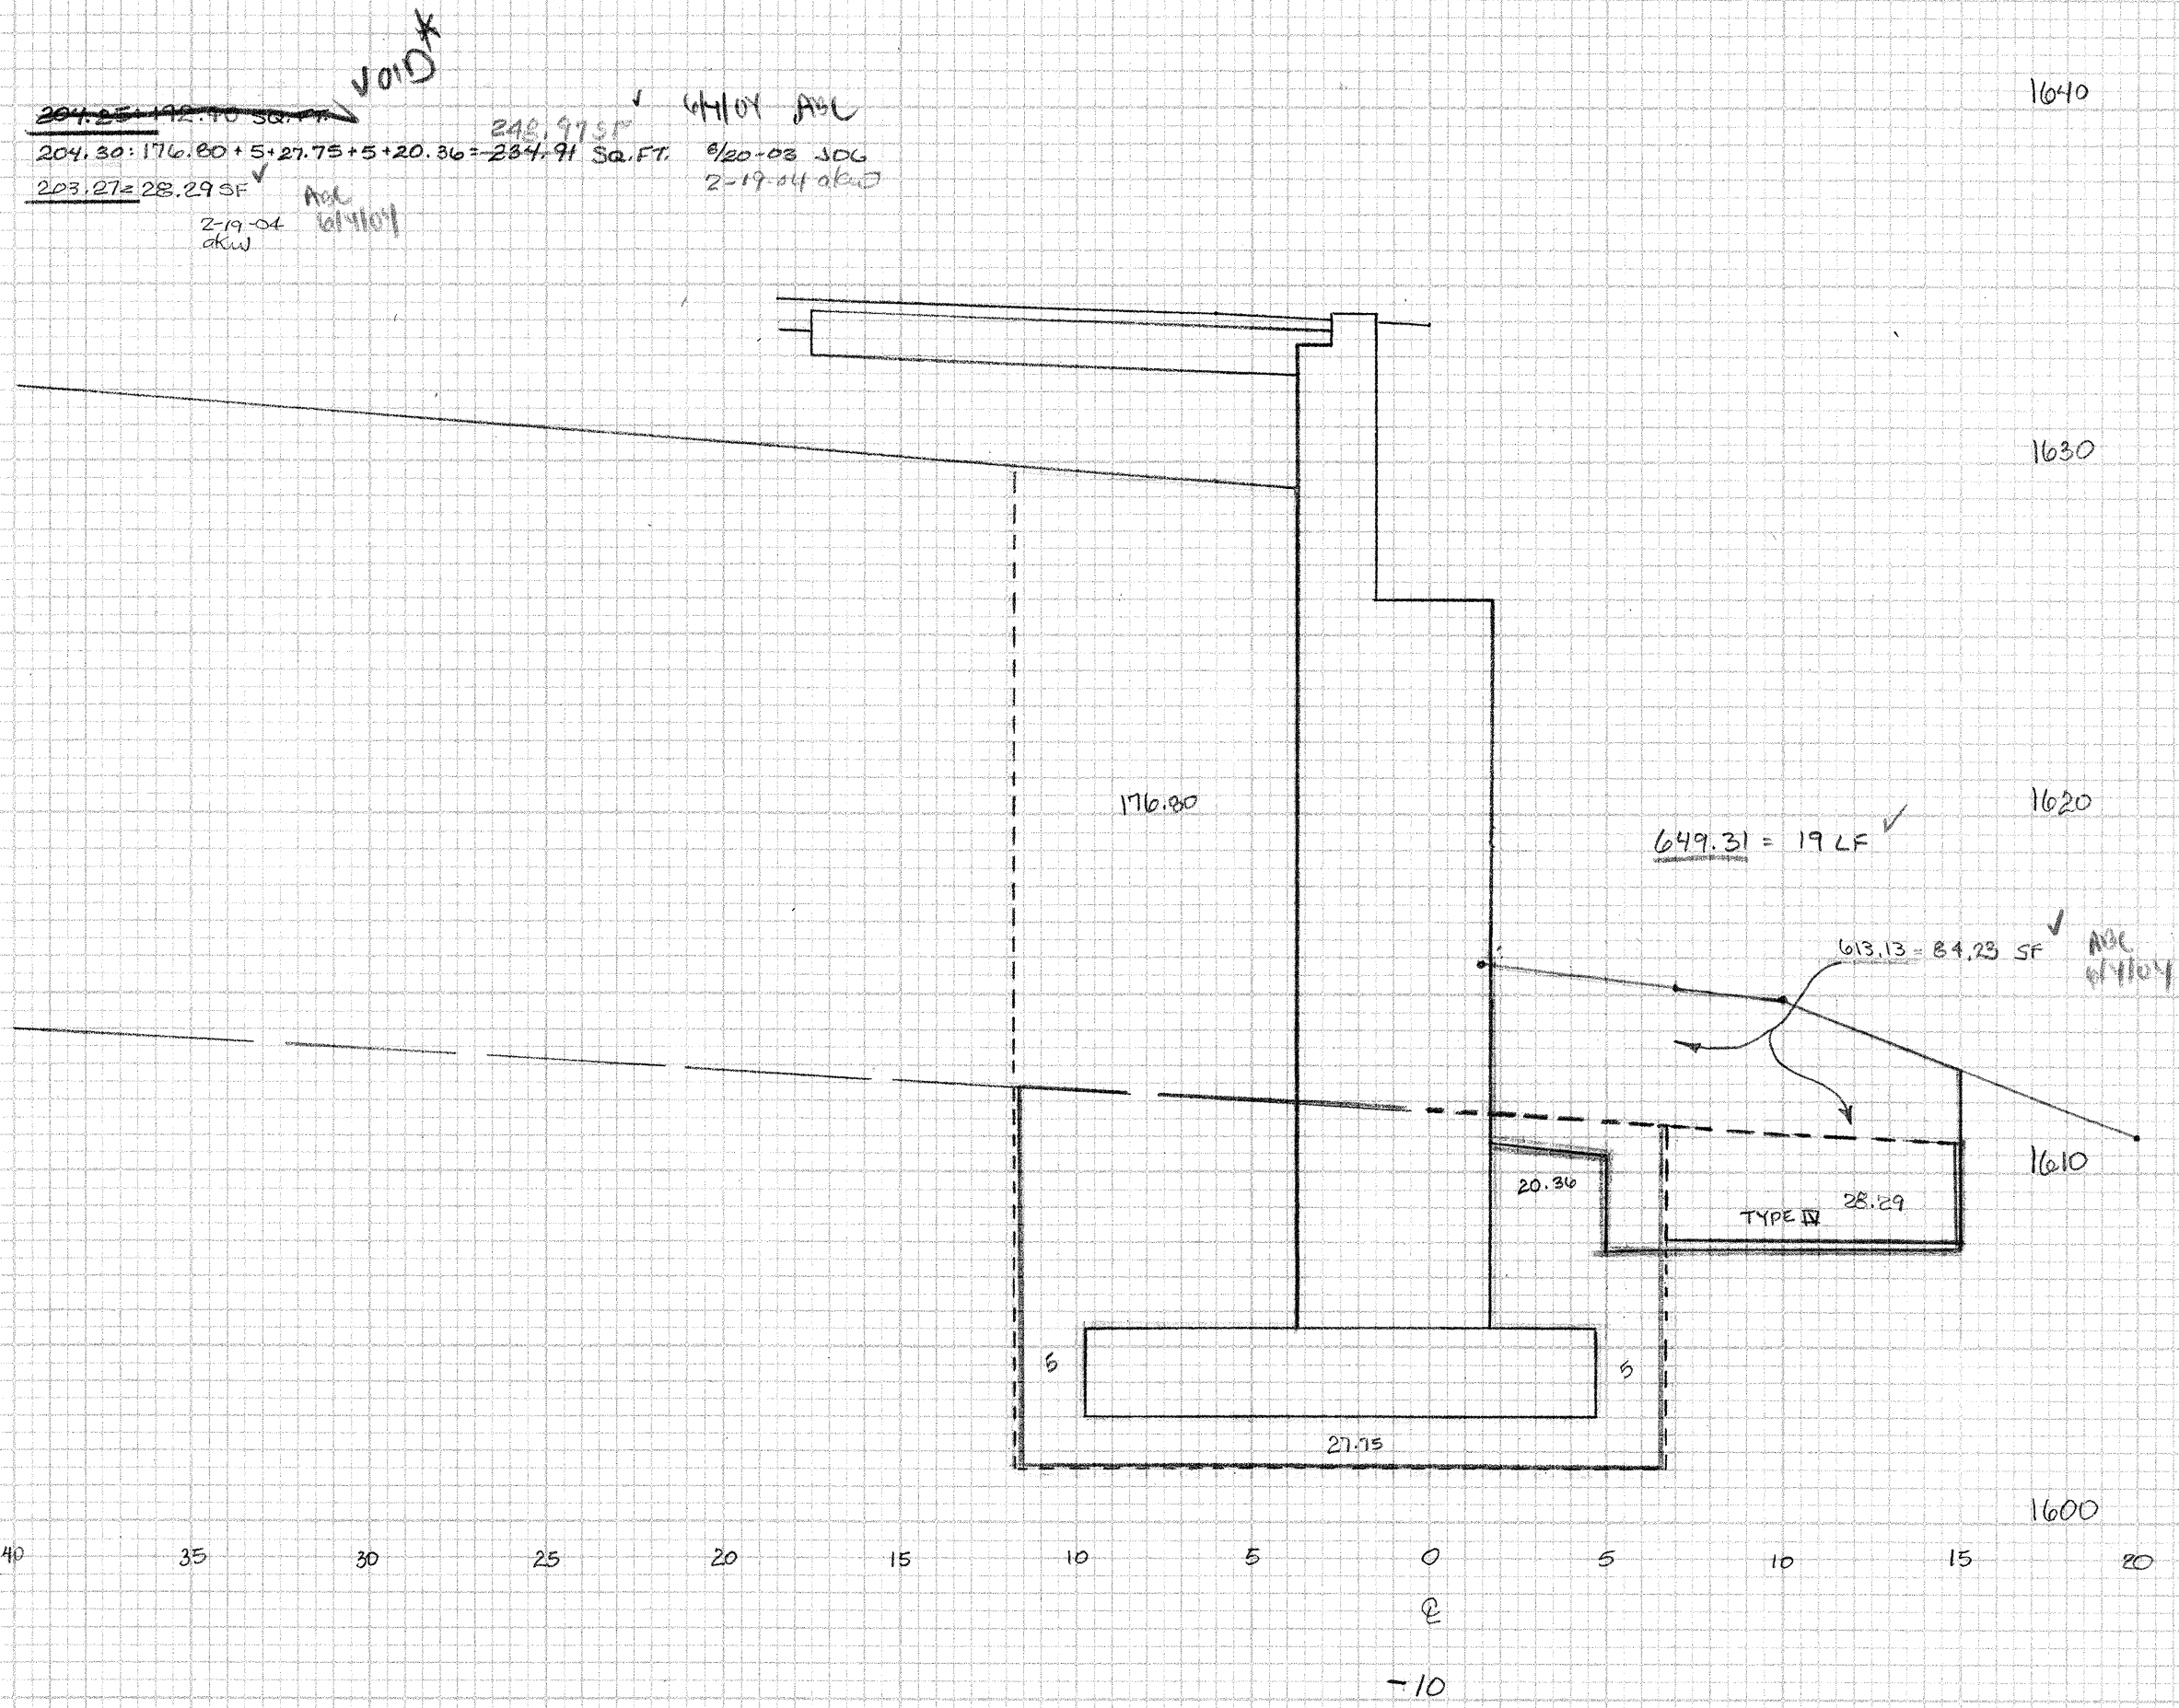

BR 25A
 ABUT #1
 SEARSBURG - WILMINGTON
 NH-F010-1(18)
 SCALE 1"=5'
 XBR25A-3
 * ITEM 604.25 CALCULATIONS
 NOT BASED ON THESE SECTIONS
 SEE CALCULATION SHEET
 SEE NOTE ON XBR25A-1