

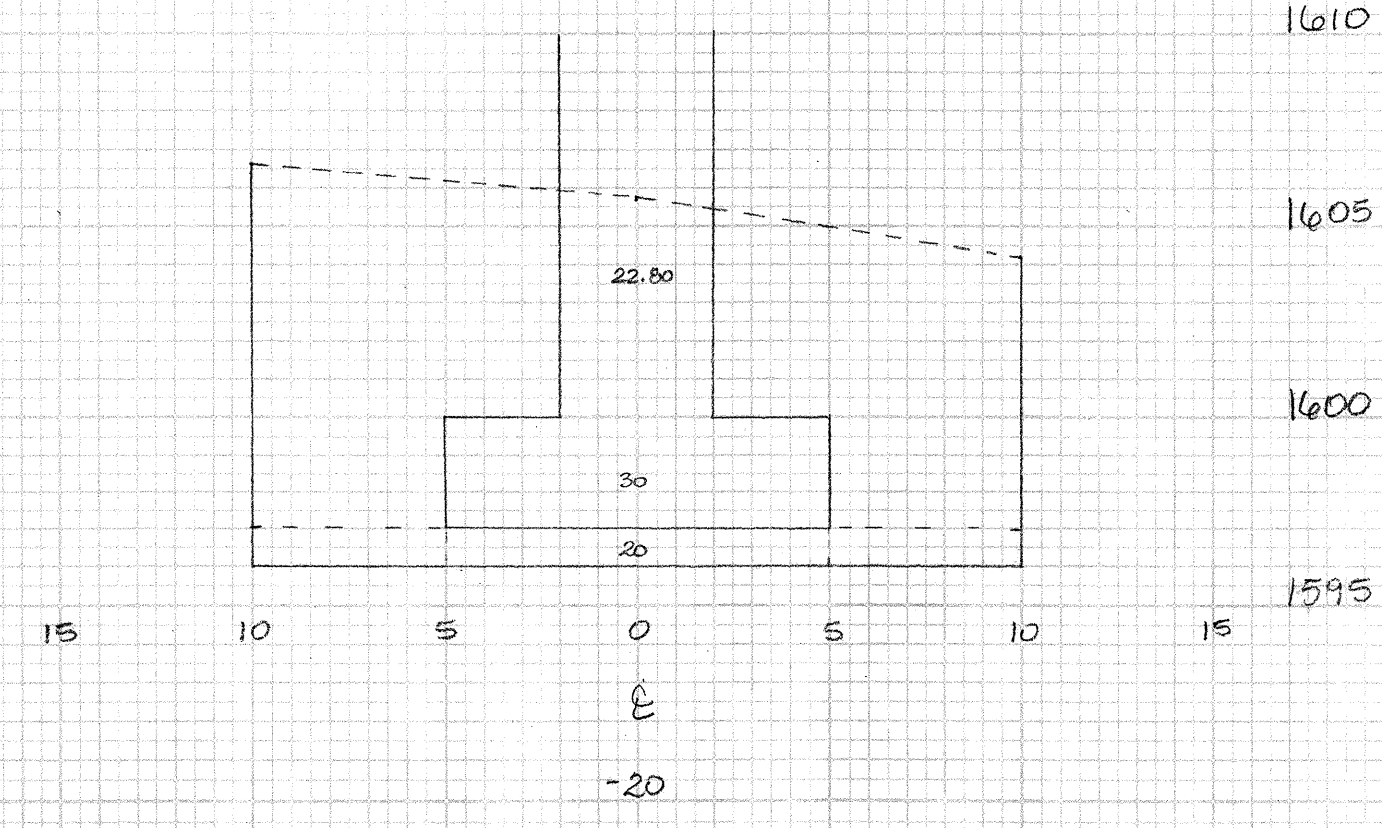


FINAL SURVEY
DATE: _____ BY: _____
NO. _____


208.30: 101.75 + 70 = 171.75 SF
613.13: 191.75 - (20 * 20 + 22.80) = 118.95 SF

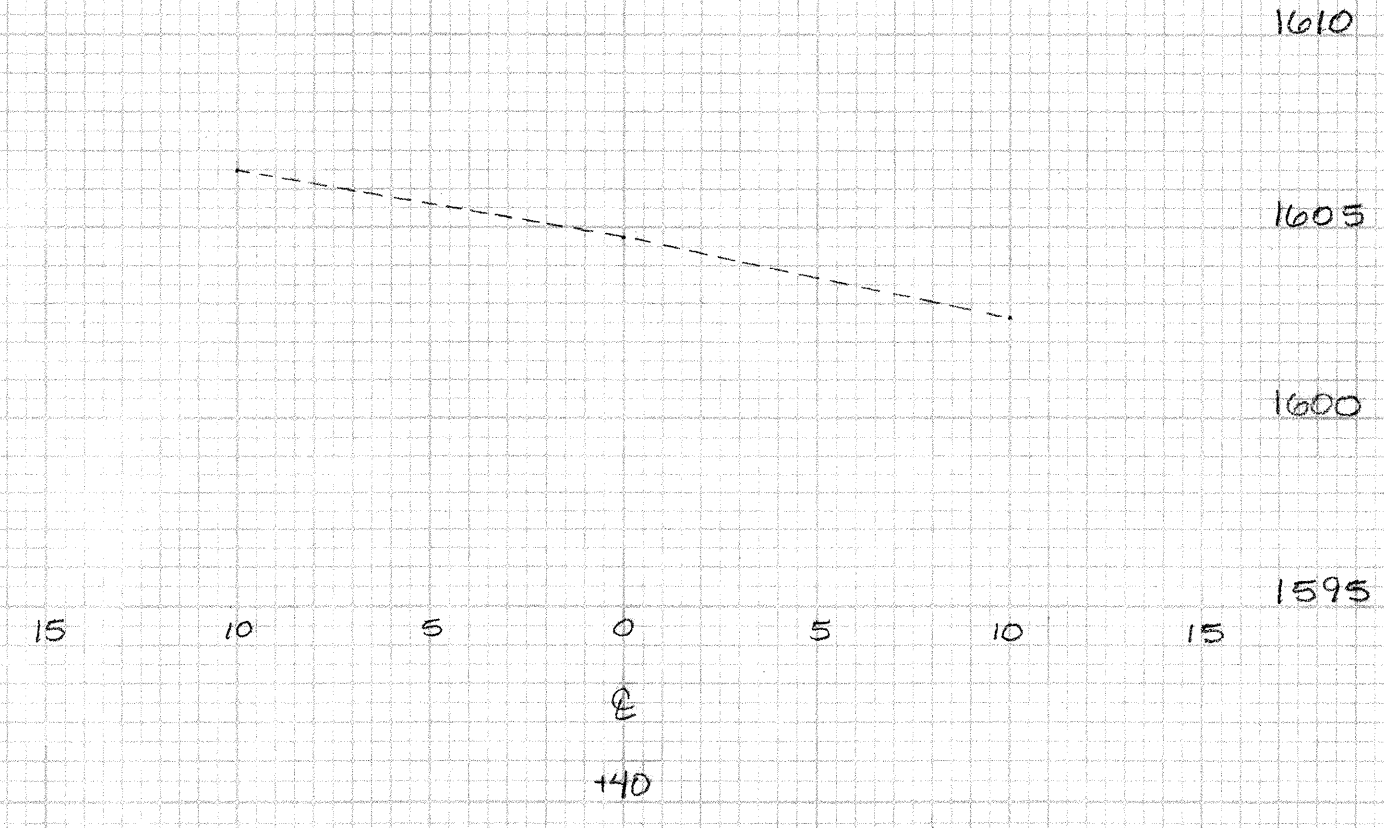


208.30: 88 + 69.60 + 15.40 = 173 SF
613.13: 173 - (20 * 20 + 20 * 20) = 102.60 SF

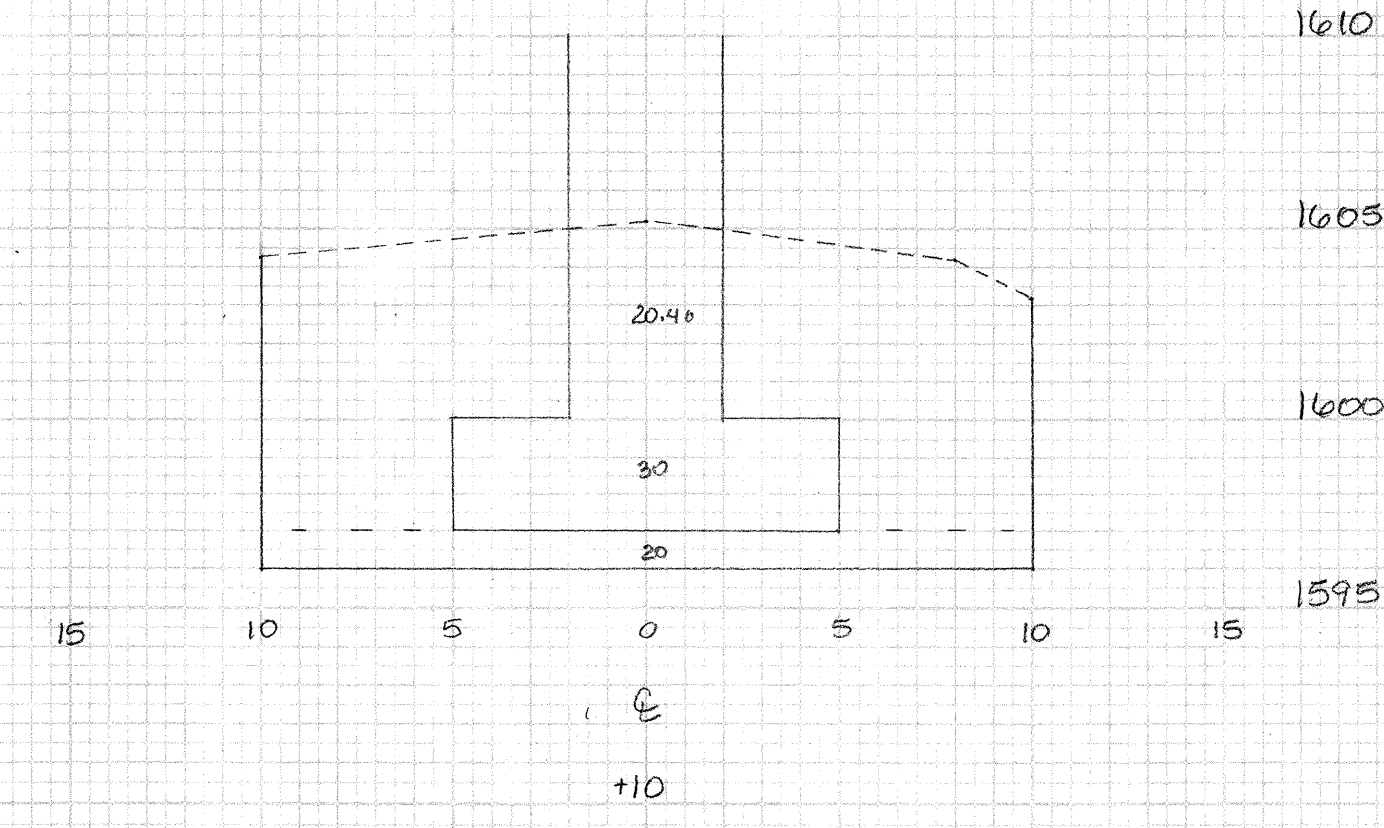


208.30: 185.85 + 16.85 = 202.70 SF
613.13: 202.70 - 20 = 182.70 SF

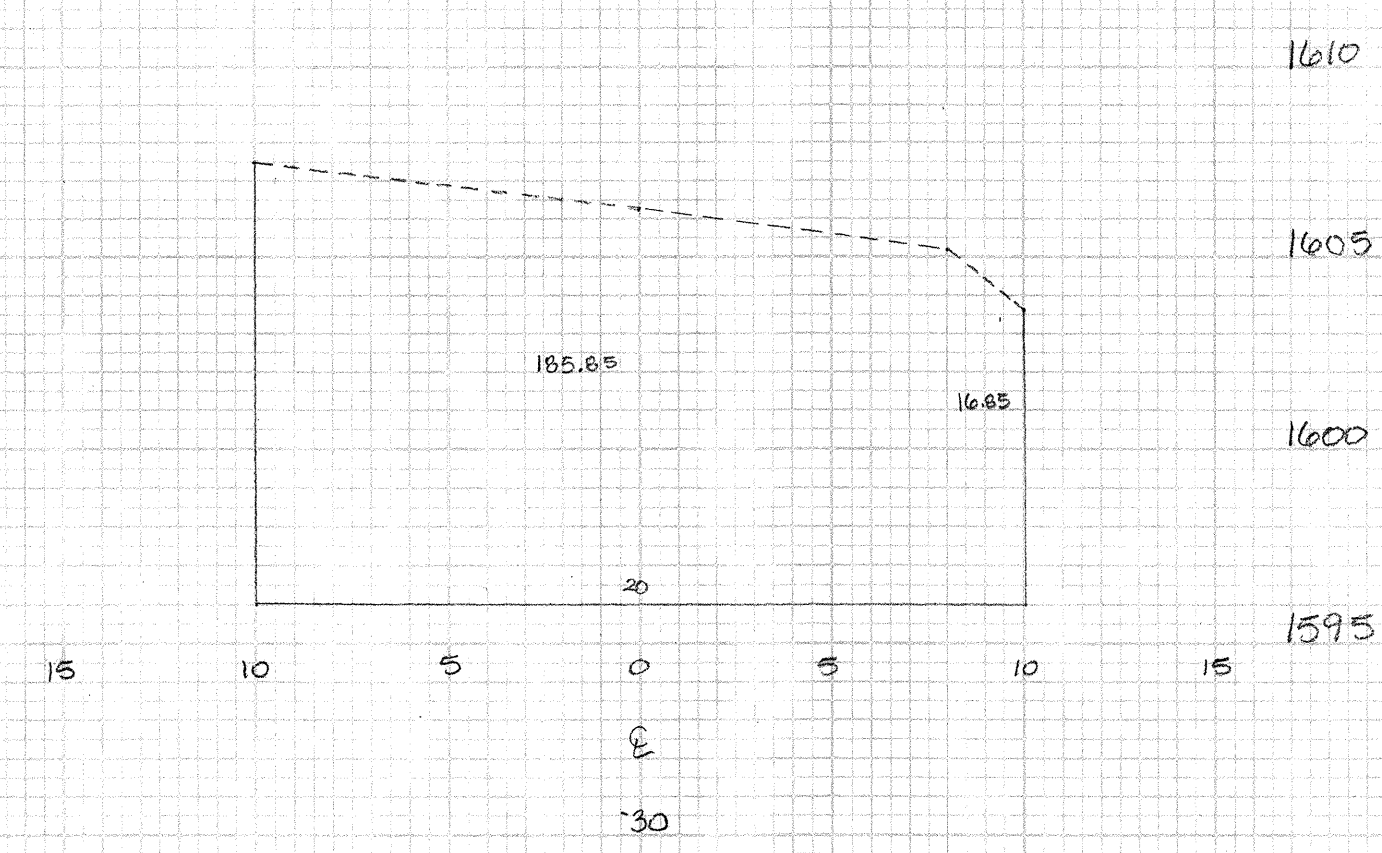

208.30: 91.55 + 68.85 + 24 = 179.88 SF
613.13: 179.88 - (21.80 * 20 + 20 * 20) = 107.90 SF

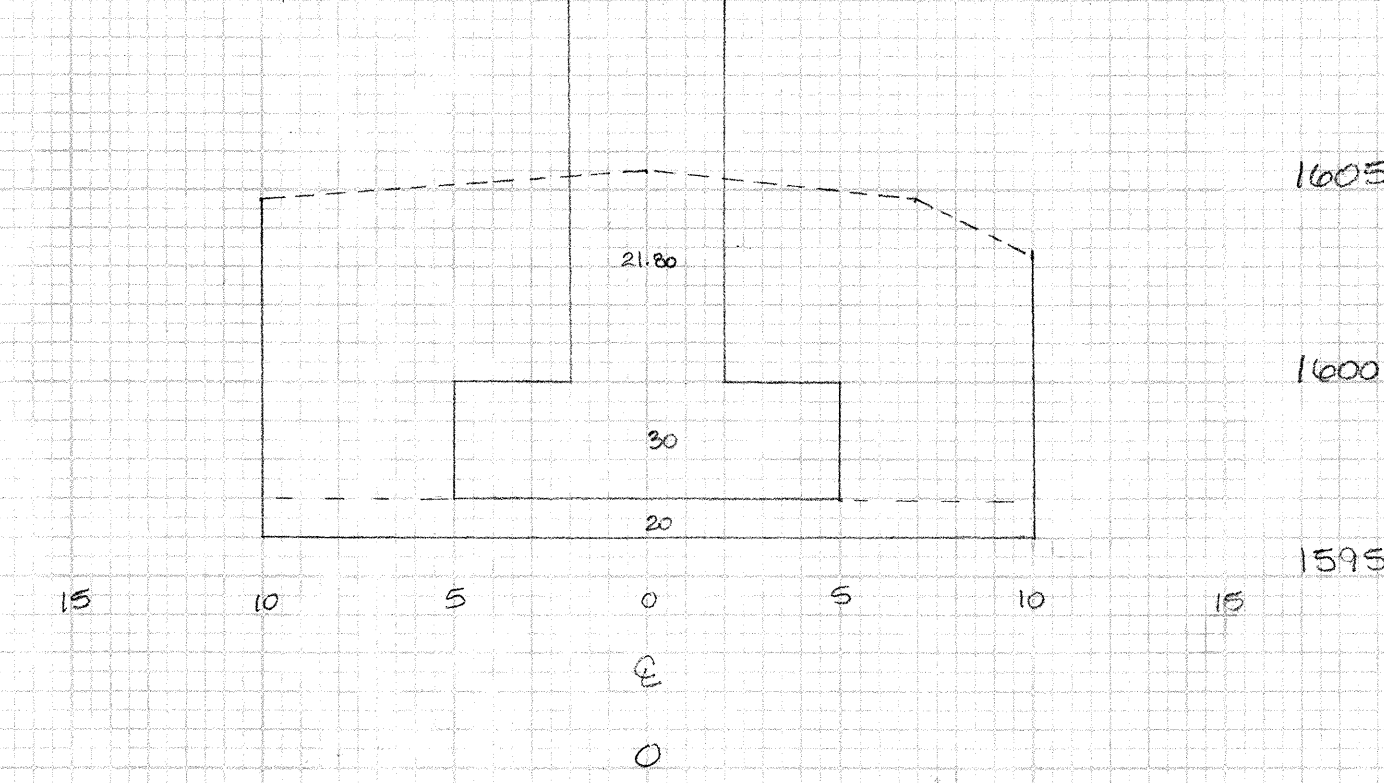


208.30: 97.75 + 49.95 + 29.30 = 177.00 SF
613.13: 177.00 - 20 = 157.00 SF

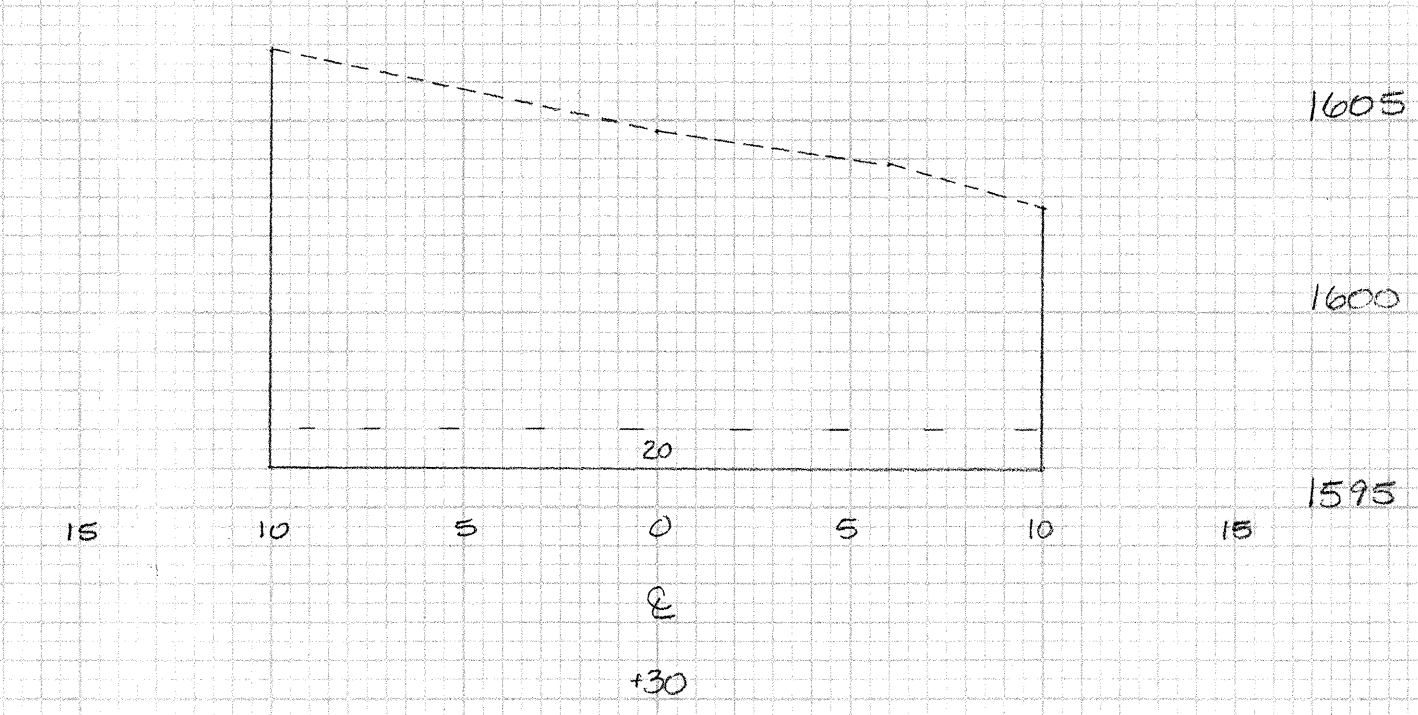

ORIGINAL SURVEY
DATE: _____ BY: _____
NO. _____

208.30: 35.5 + 89.75 = 125.25 SF
613.13: 125.25 - (20 * 20 + 20 * 20) = 111.10 SF

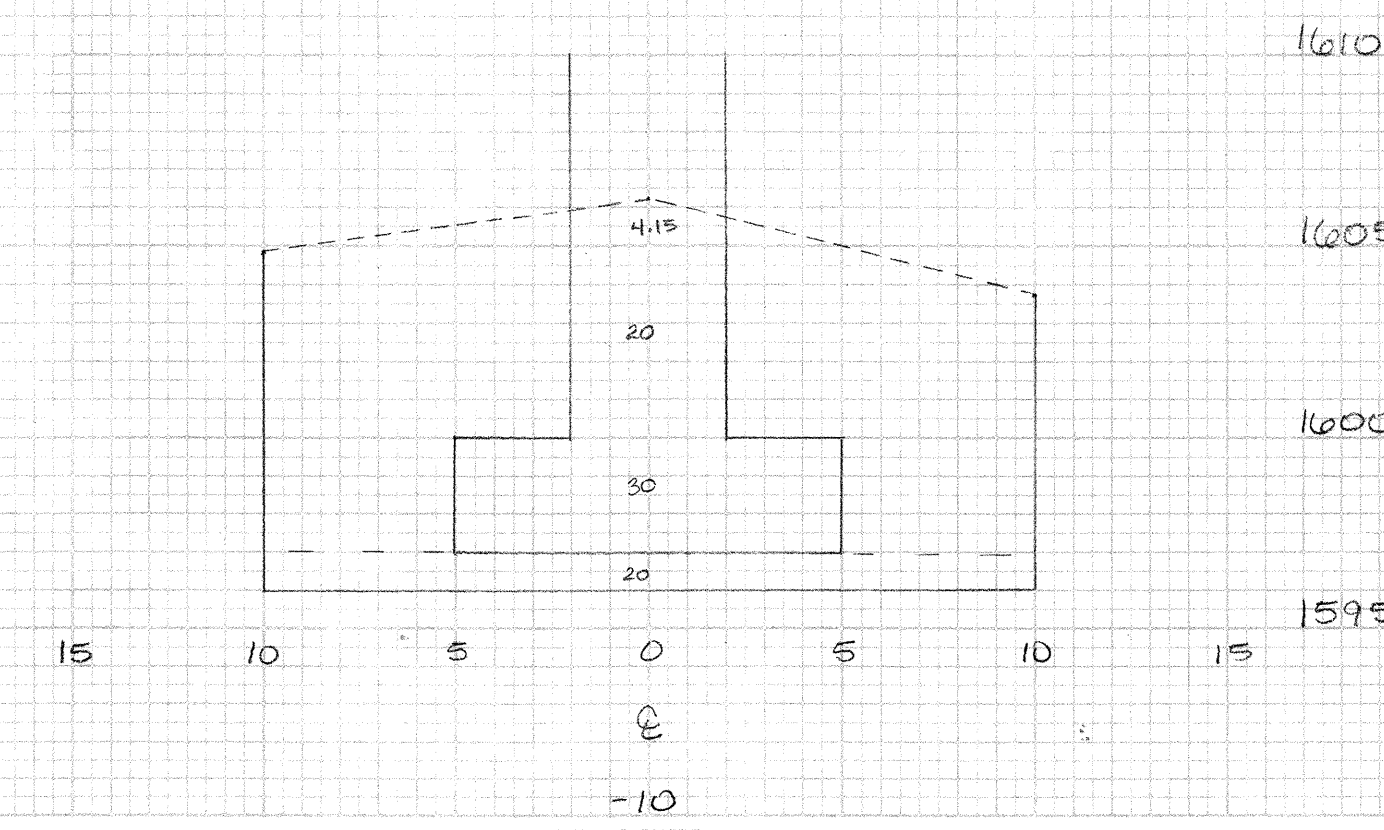

208.30: 76.25 + 71.30 + 6.95 = 154.50 SF
613.13: 154.50 - (20 * 20 + 19.20 * 20) = 105.30 SF

