


$204.30 = 172 \text{ } \checkmark$ $+ 21$
 $204.30 = 425.75 \text{ } \checkmark$ $+ 19.5$
 $204.30 = 425.75 \text{ } \checkmark$ $+ 13$ SAME AS $+ 19.5$

5 0 5 10 15 20 25 30

2-22-05

$+ 20$
 $+ 27.7$ BUT 204.25
 SAME AS $+ 20$

$+ 27.5$ BUT 204.30

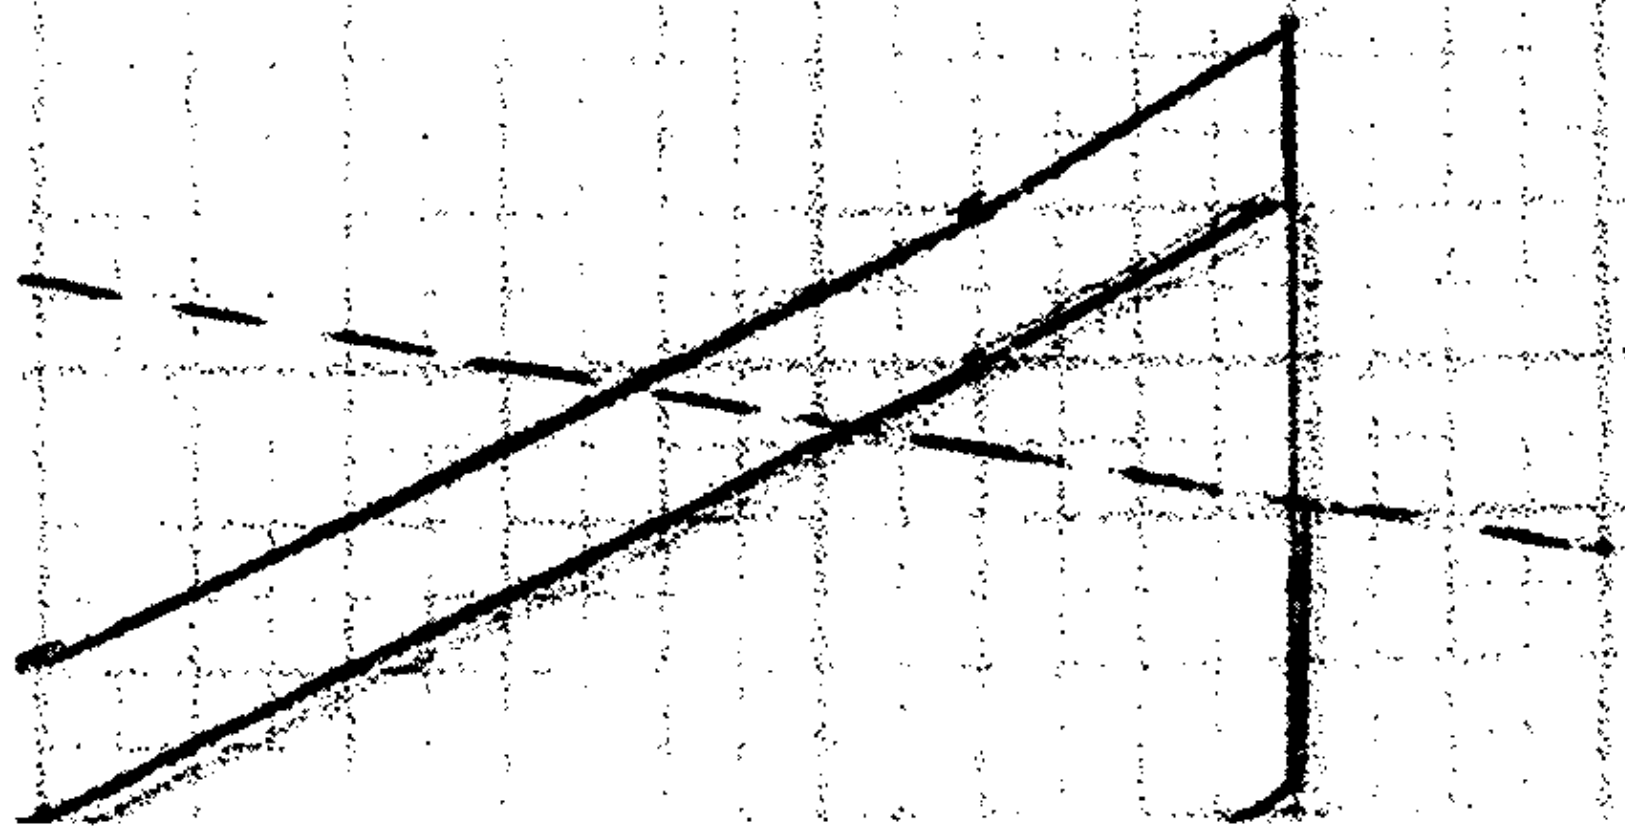

478A - BRZSA ABZ