



-1611.5

204.30 = 591.75 ✓
 204.30 = 591.75 ✓
 204.30 = 204.5 ✓

+25.5
 +23 SAME AS +25.5
 +22

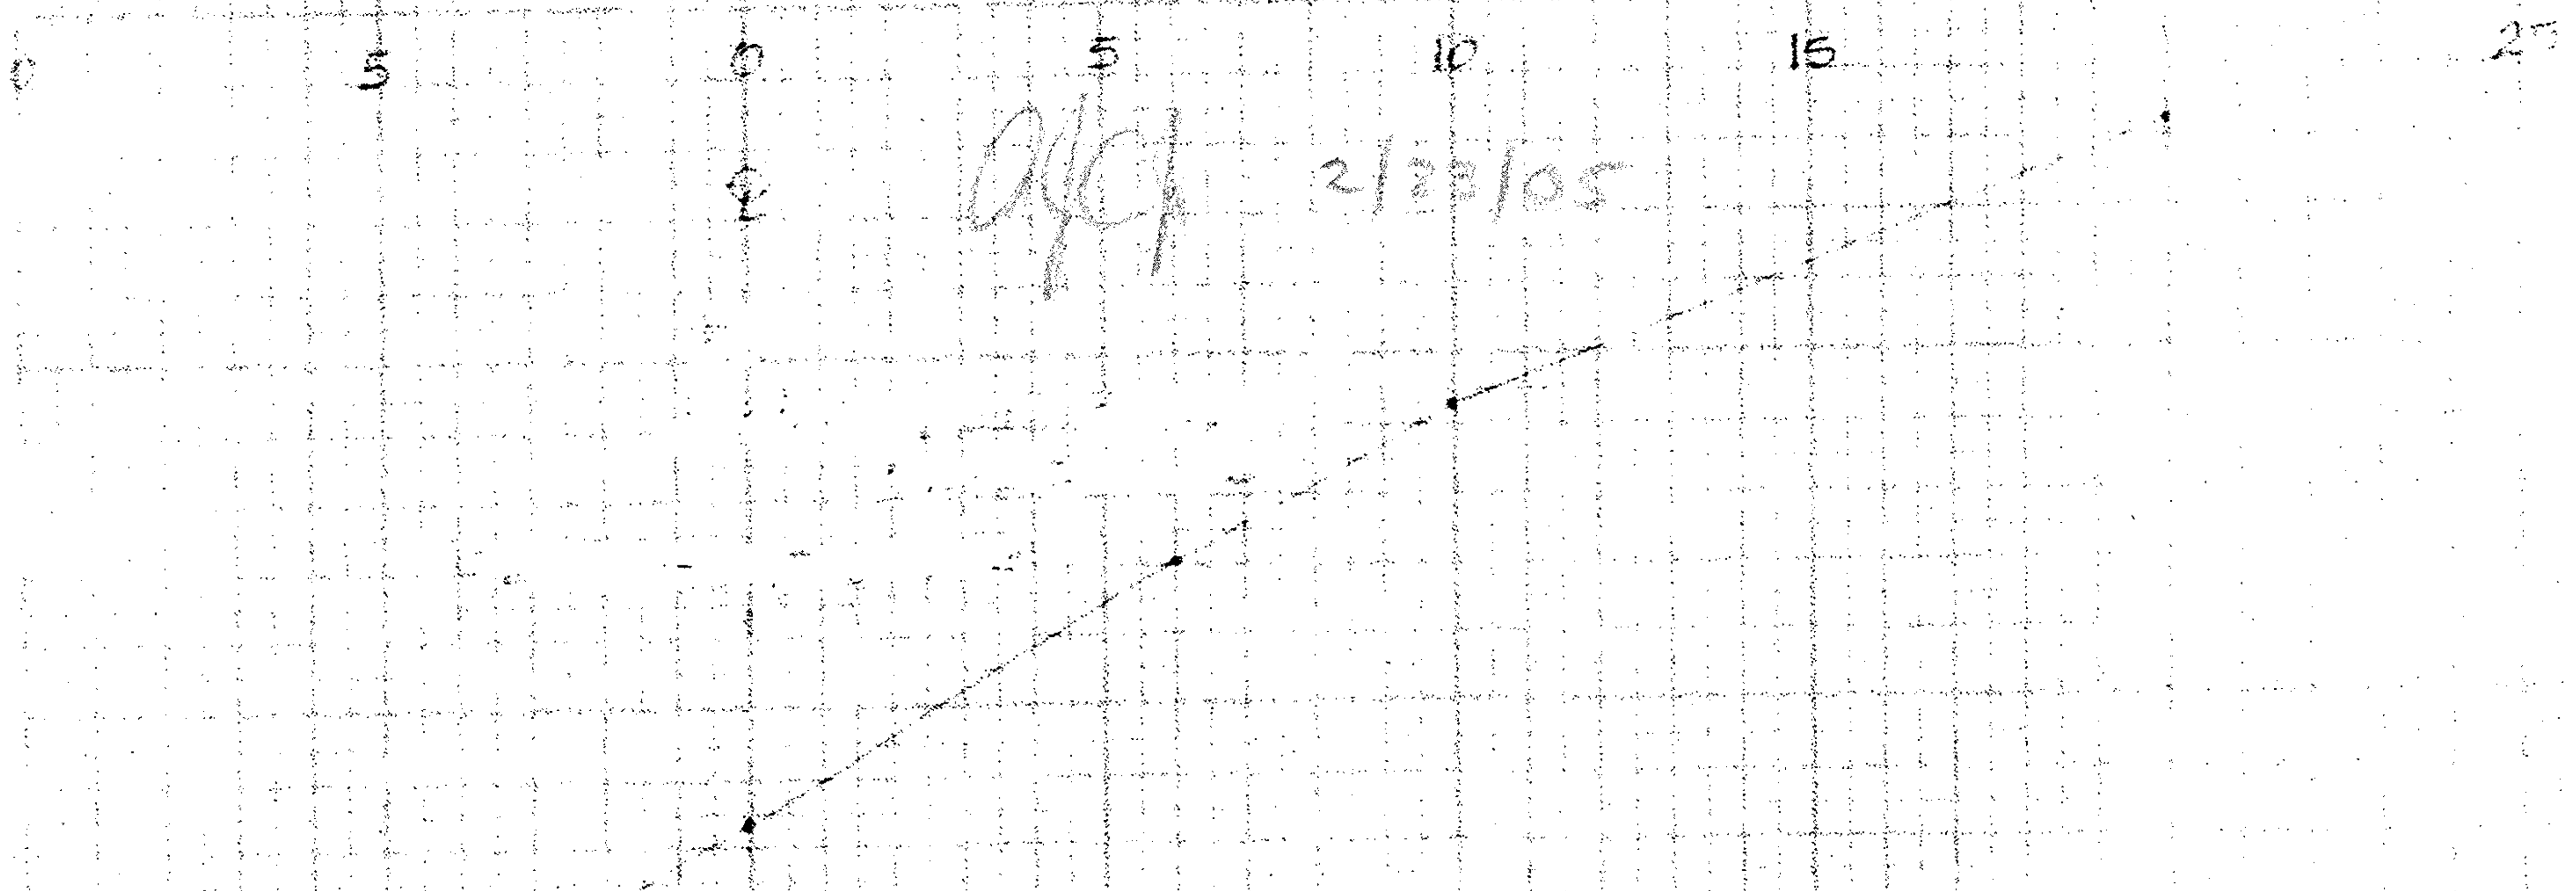

APC 2/23/05

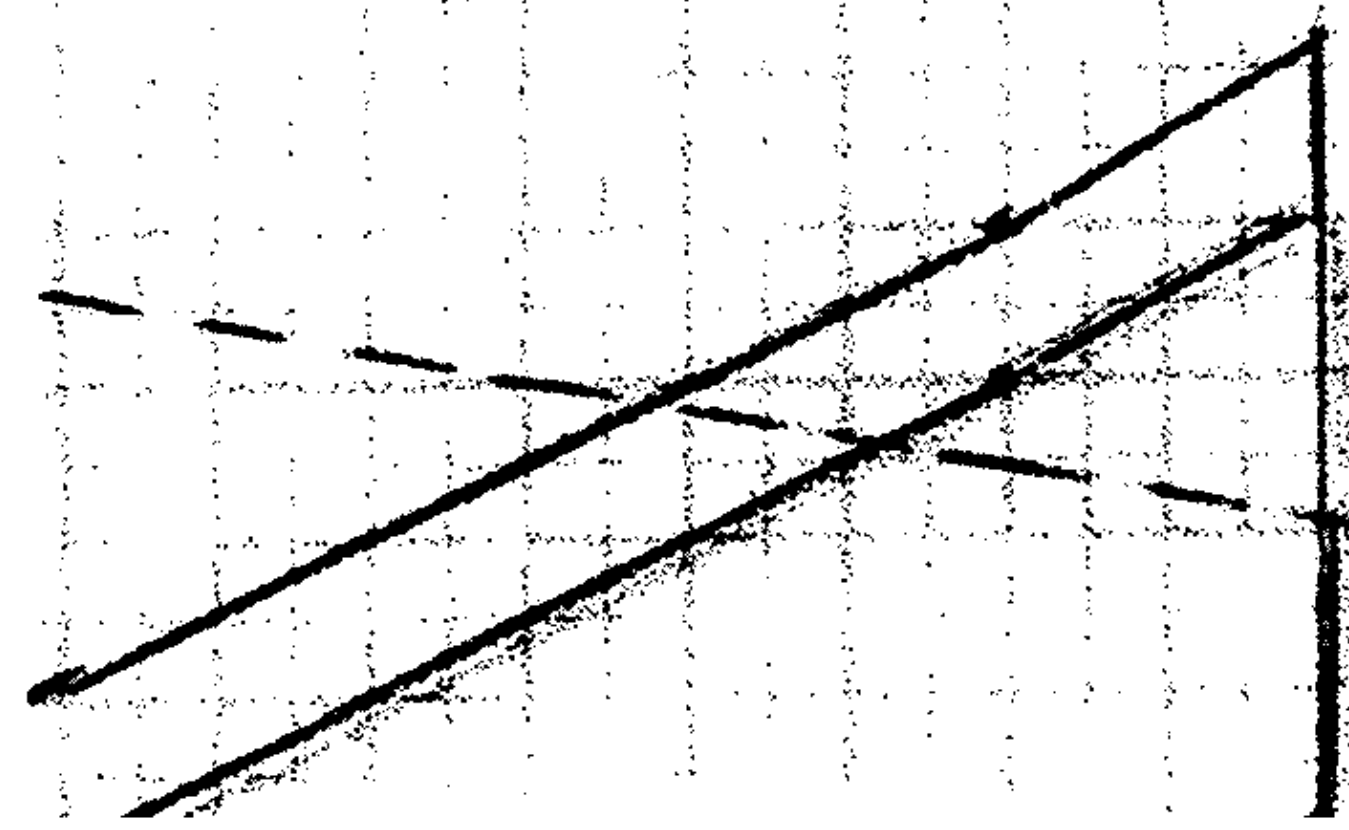

478B BRUSA ABZ