


BR25A
 ABUT #2
 SCALE 1/5

SEARSBURG - WILMINGTON
 NH-F010-1(18)
 XBR25A-7


FINAL SURVEY
 BY: [blank]
 DATE: [blank]
 NO. OF BOOKS: [blank]
 NO. OF SHEETS: [blank]
 AREA: [blank]

8/25-02 JDC
 204.25' 10.08' 74.41' 105.08 53. FT
 204.30' 105.90' 71.225' 172.48 59. FT
 203.27' 0'
 ABC 6/7/04
 649.31 = 22.2 LF ✓

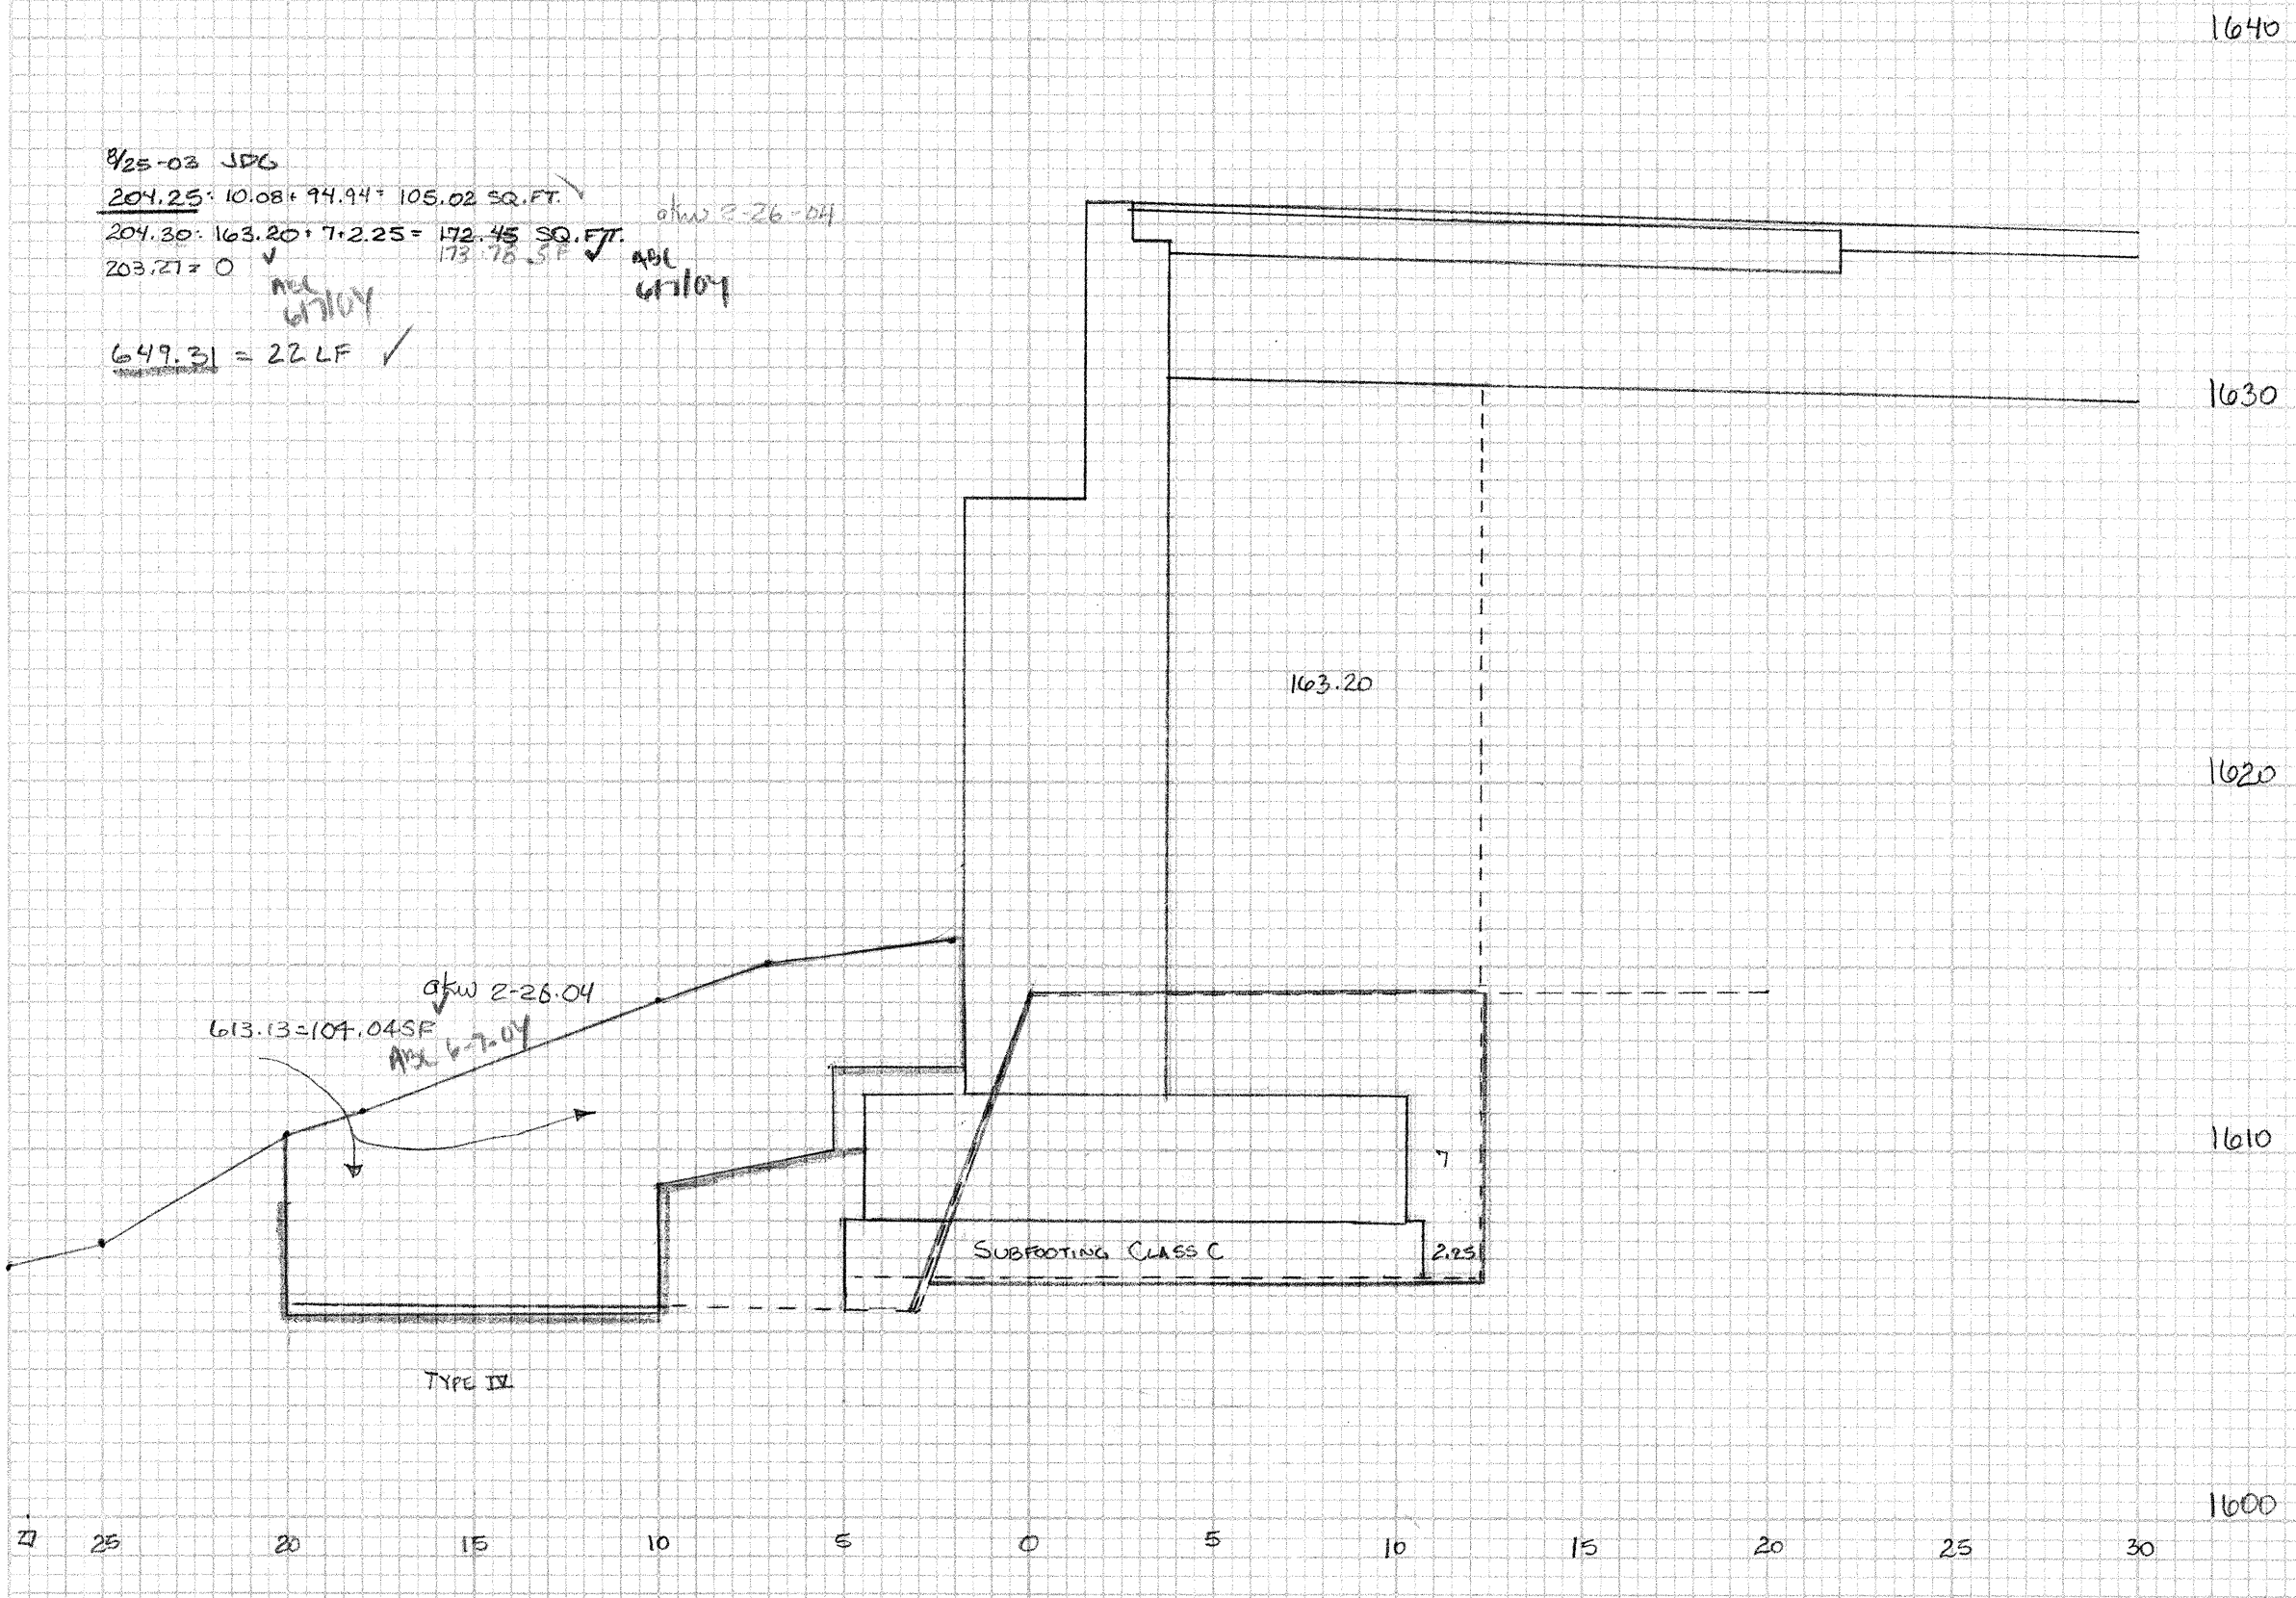

ORIGINAL SURVEY
 BY: [blank]
 DATE: [blank]
 NO. OF BOOKS: [blank]
 NO. OF SHEETS: [blank]
 AREA: [blank]

8/25-02 JDC
 204.25' 12.71' 80' 16' 140.71 50. FT
 204.30' 156.40' 71.225' 2.25' 2.75' 176.90 57. FT
 203.27' 19.21 SF
 163.14' 9.3' = 176.44 SF
 ABC 6/7/04
 649.31 = 22.5 LF ✓
 ABC 2/1/05

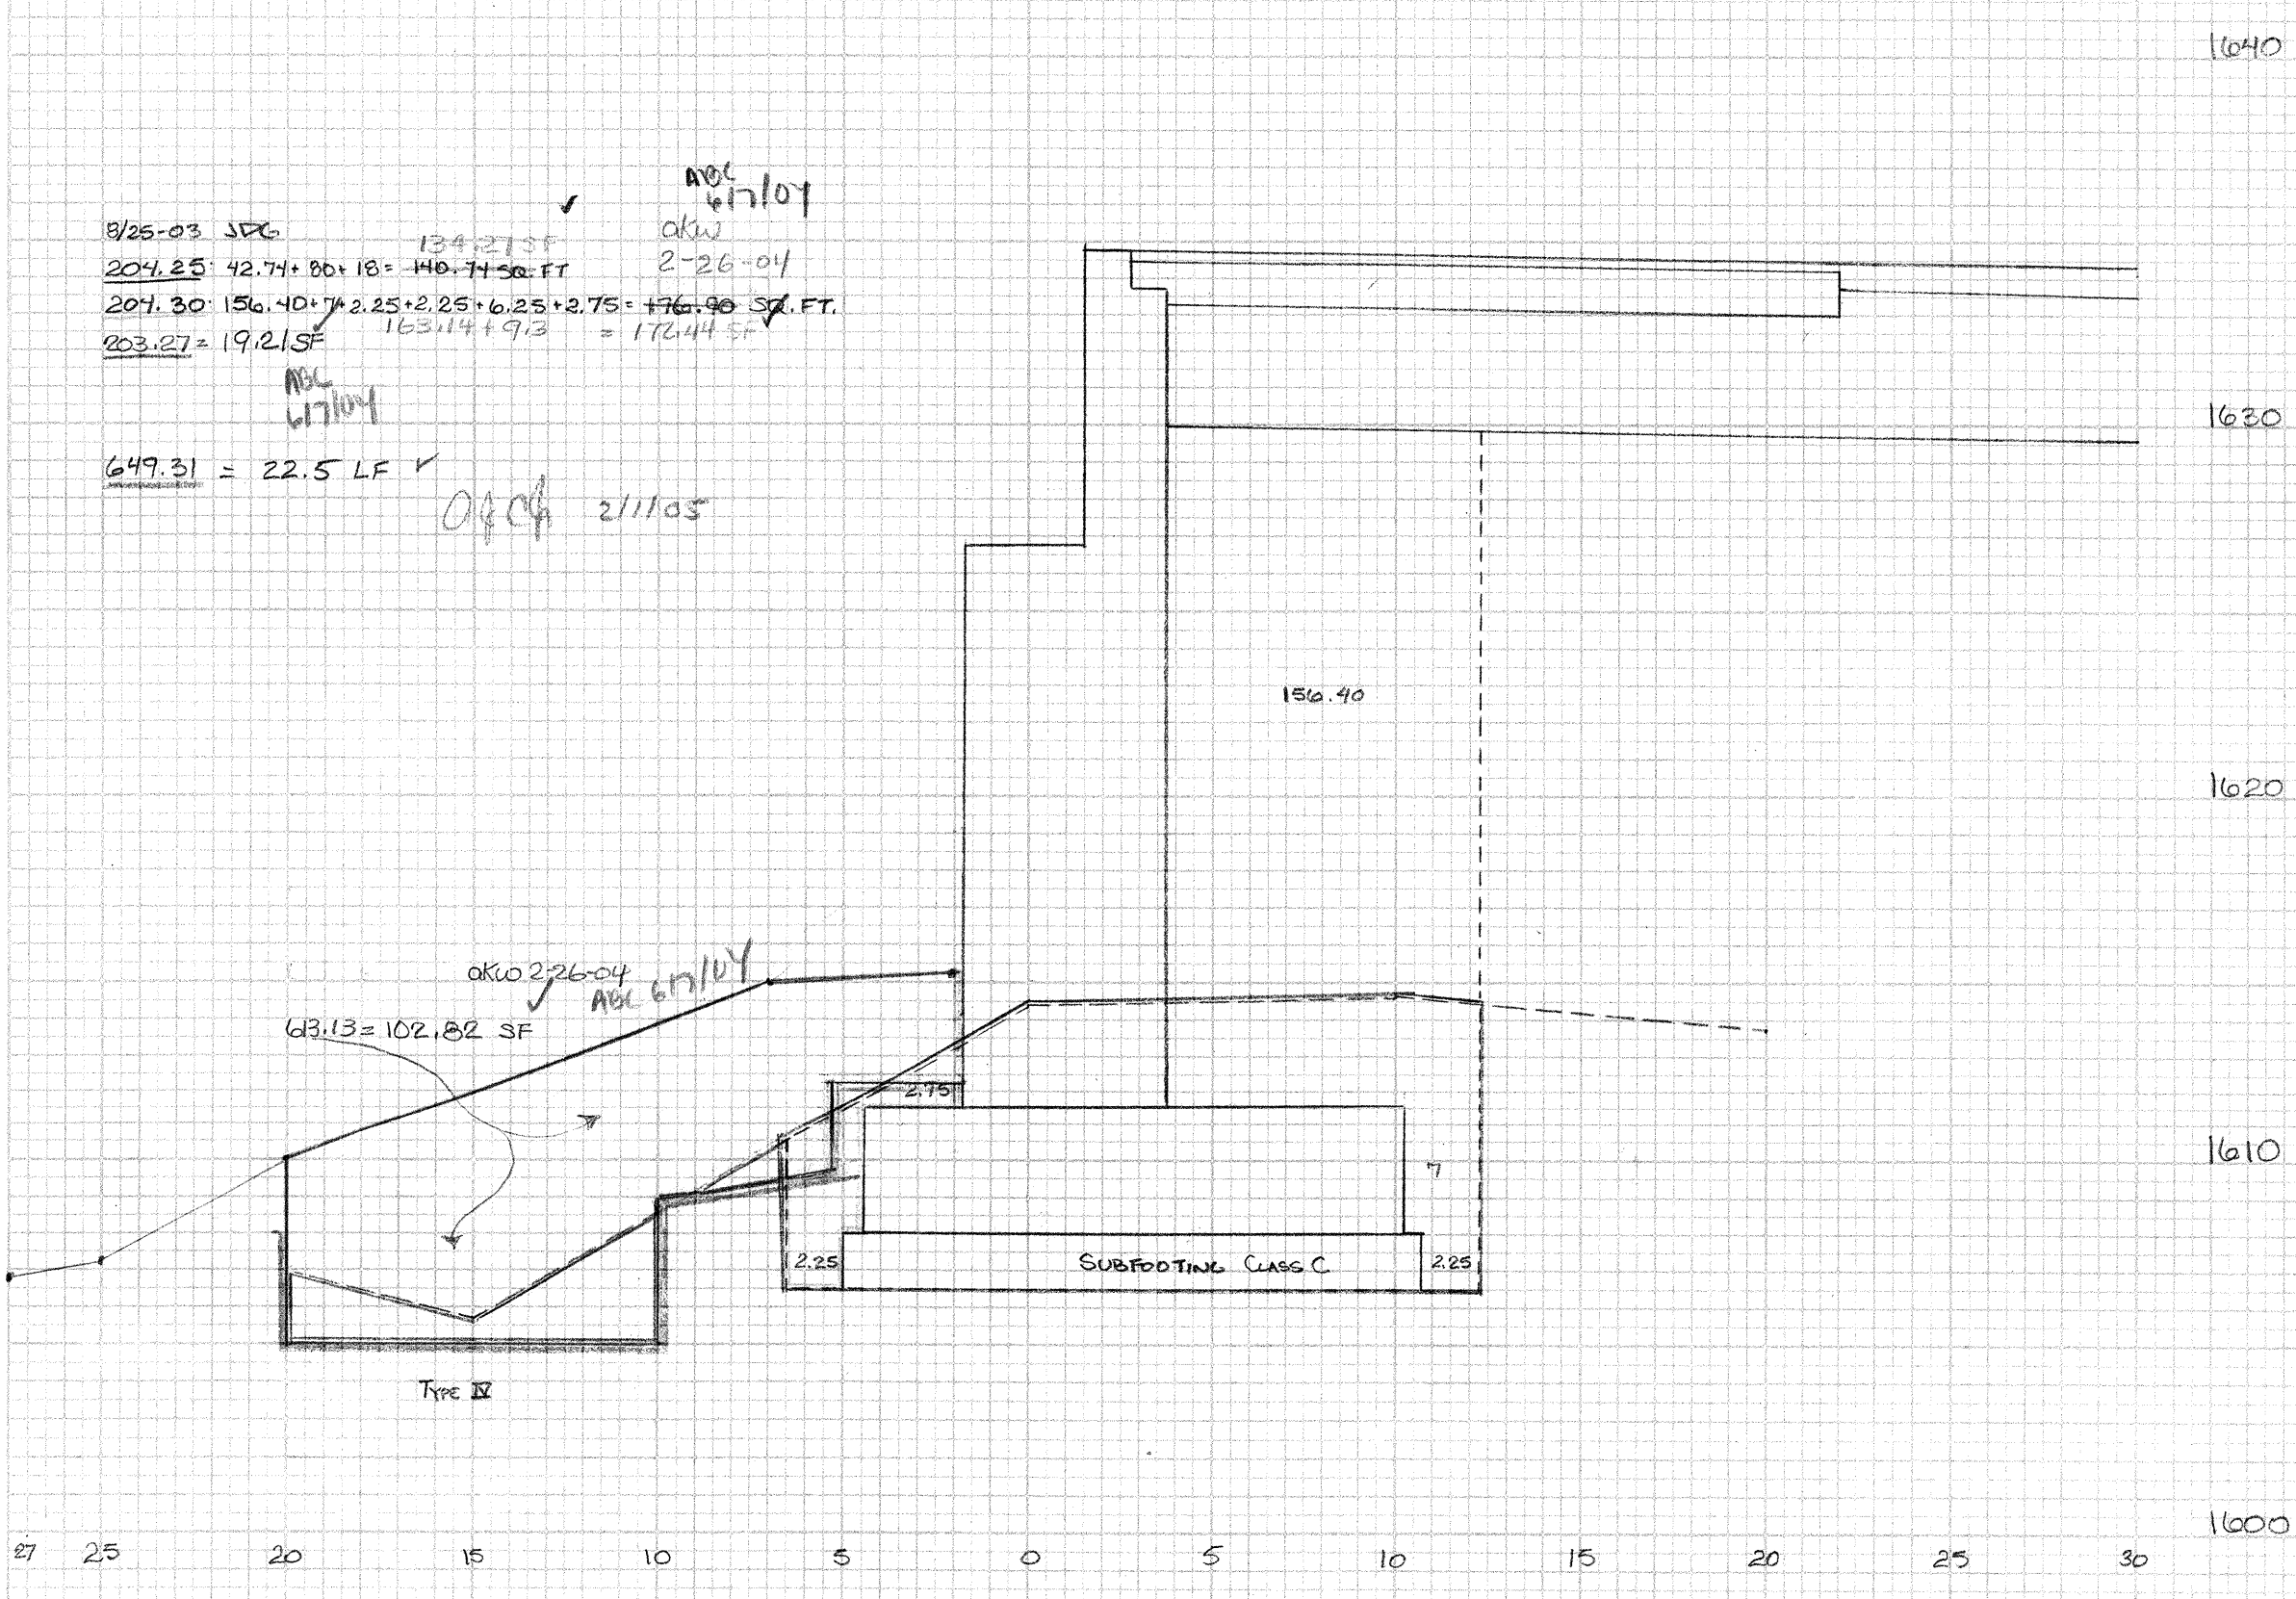

8/25-02 JDC
 204.25' 51.35' 103.50' 28.01' 102.46 50. FT
 204.30' 170' 71.5.90' 2.89' 2.25' 2.25' 190.39 50. FT
 203.27' 67.88 SF
 172.03 SF
 ABC 6/7/04
 649.31 = 21.5 LF ✓
 ABC 2-26-04

