


BR. 25 ABUTMENT 1  
PLAN SKETCH

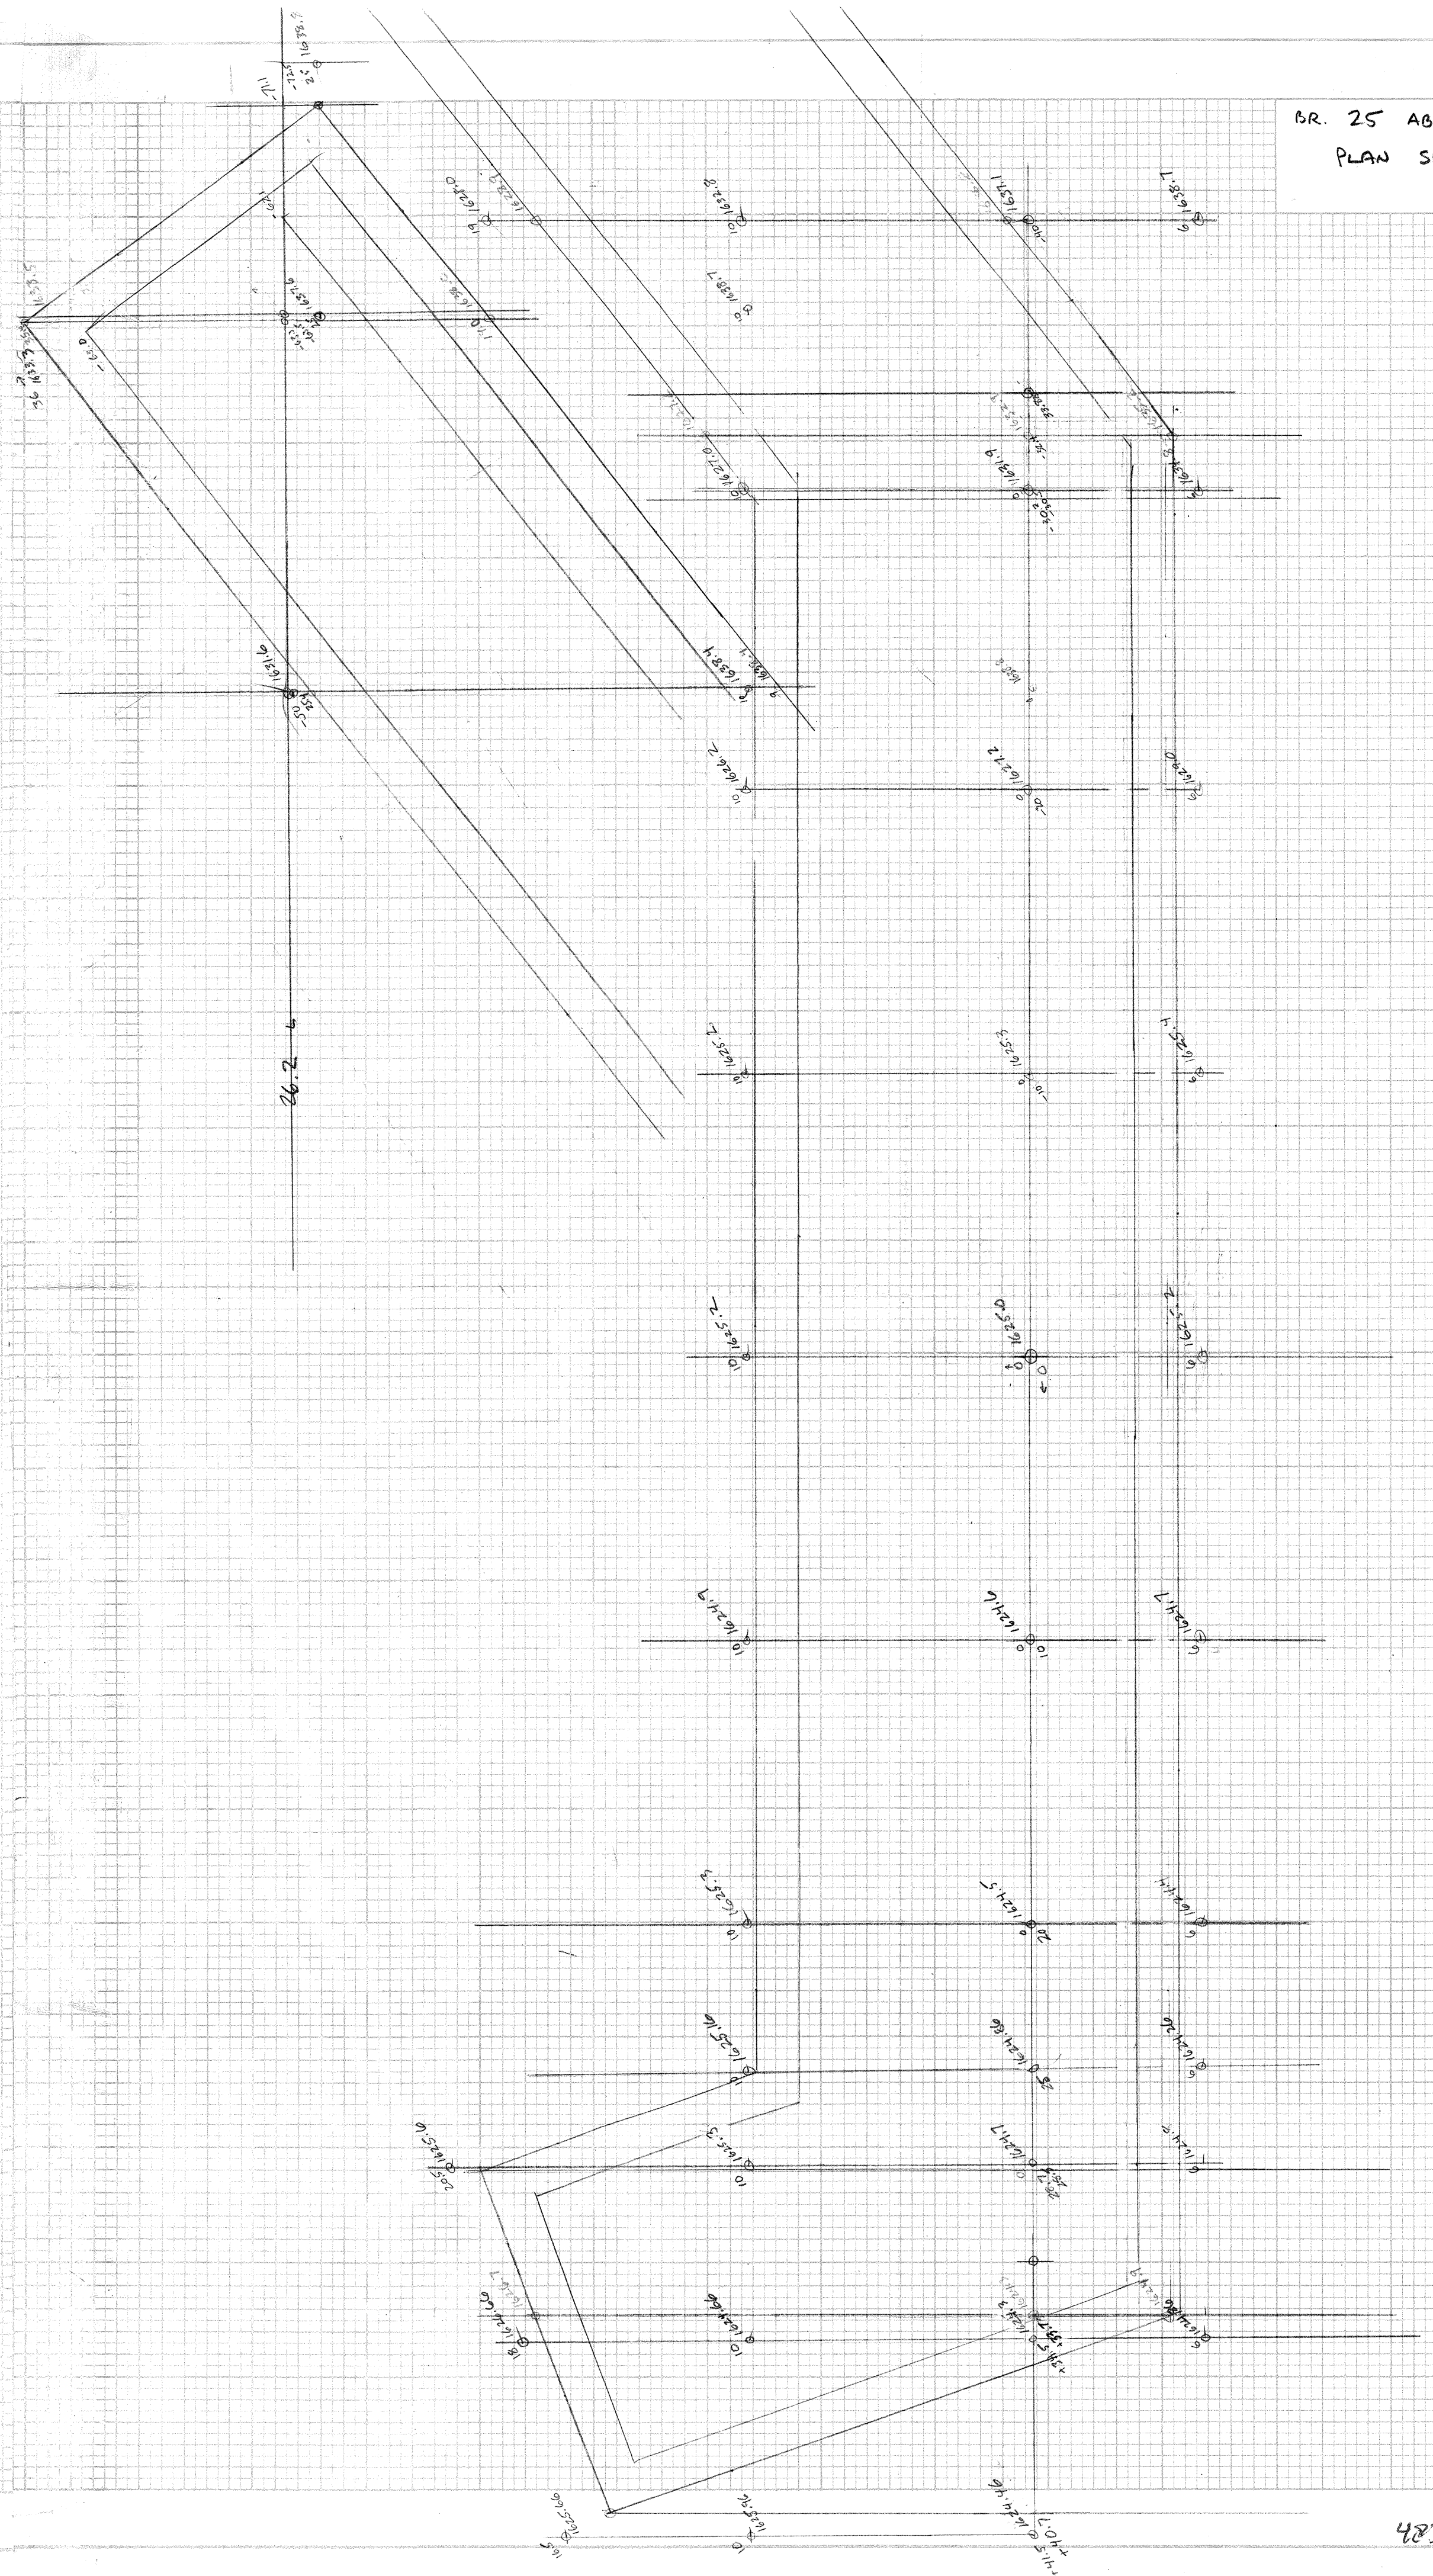

FINAL SURVEY BY DATE  
SURVEYED BY  
CHECKED BY  
NOTED BOOK NO.  
AREAS CHECKED

ORIGINAL SURVEY BY DATE  
SURVEYED BY  
CHECKED BY  
NOTED BOOK NO.  
AREAS CHECKED