
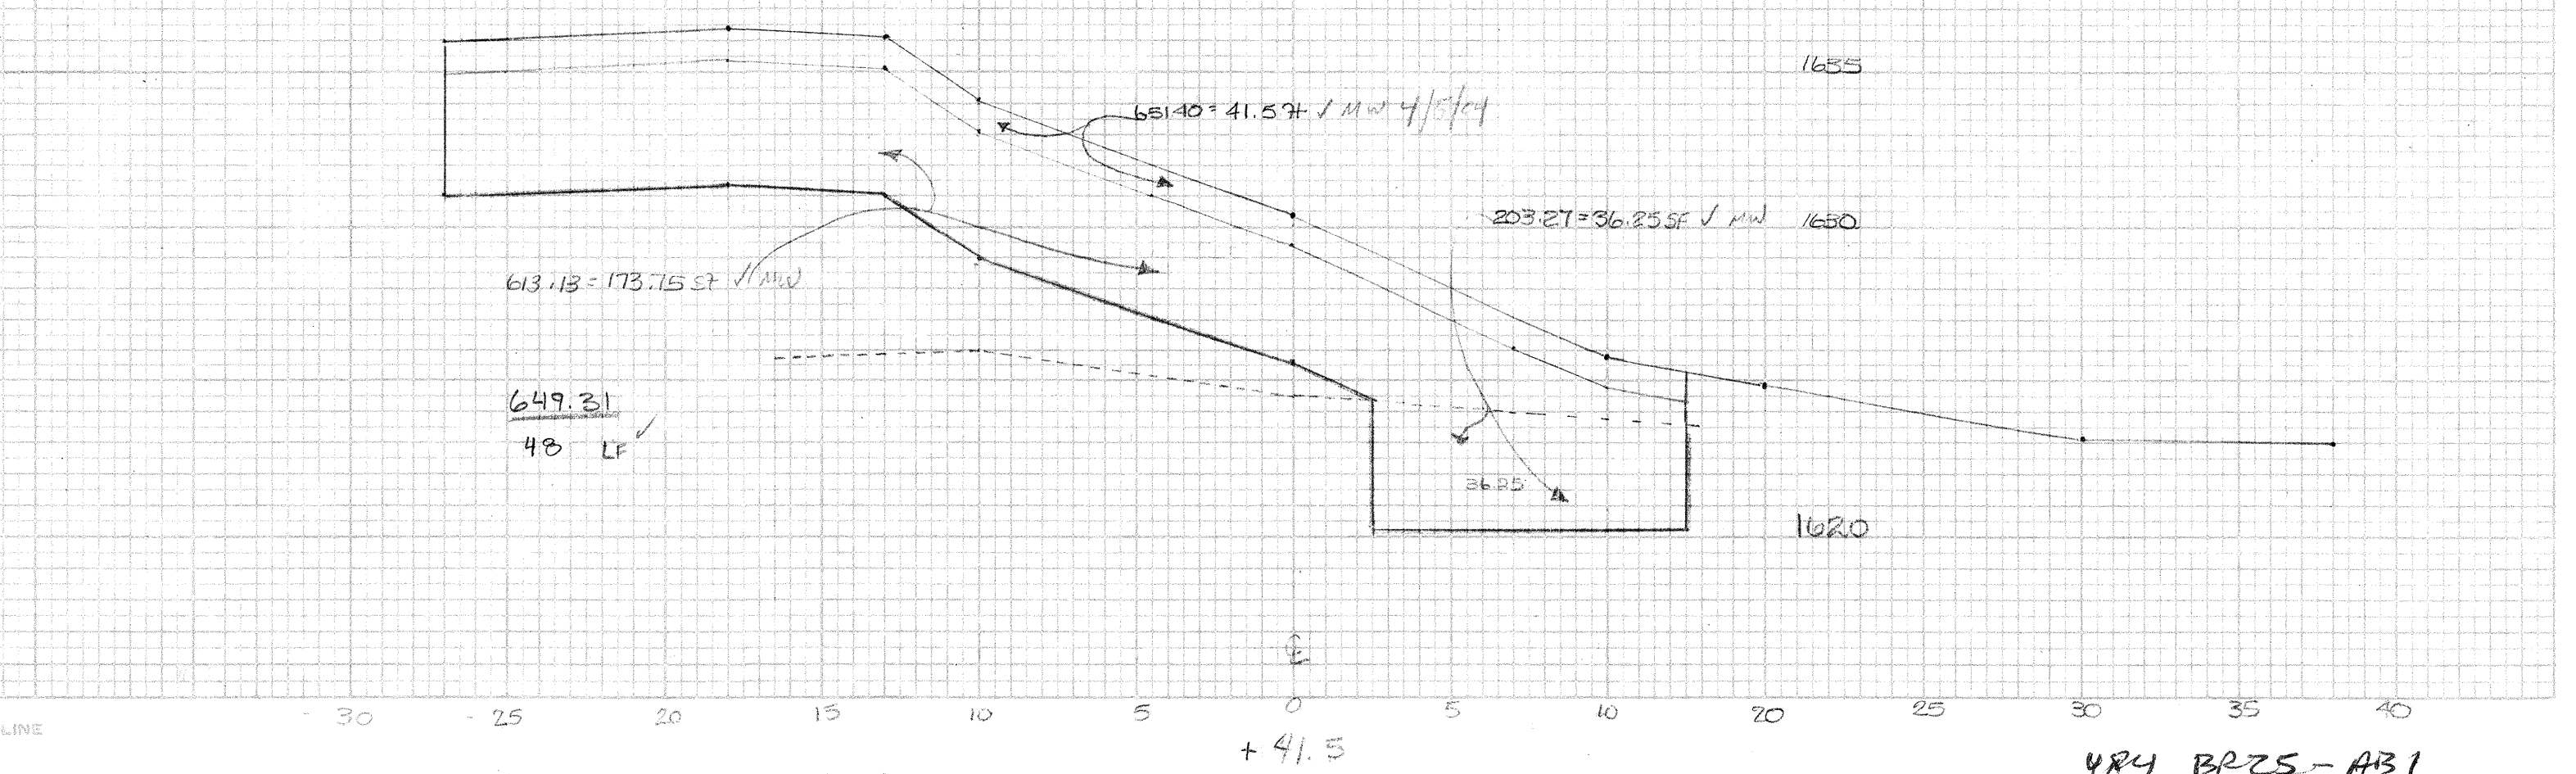
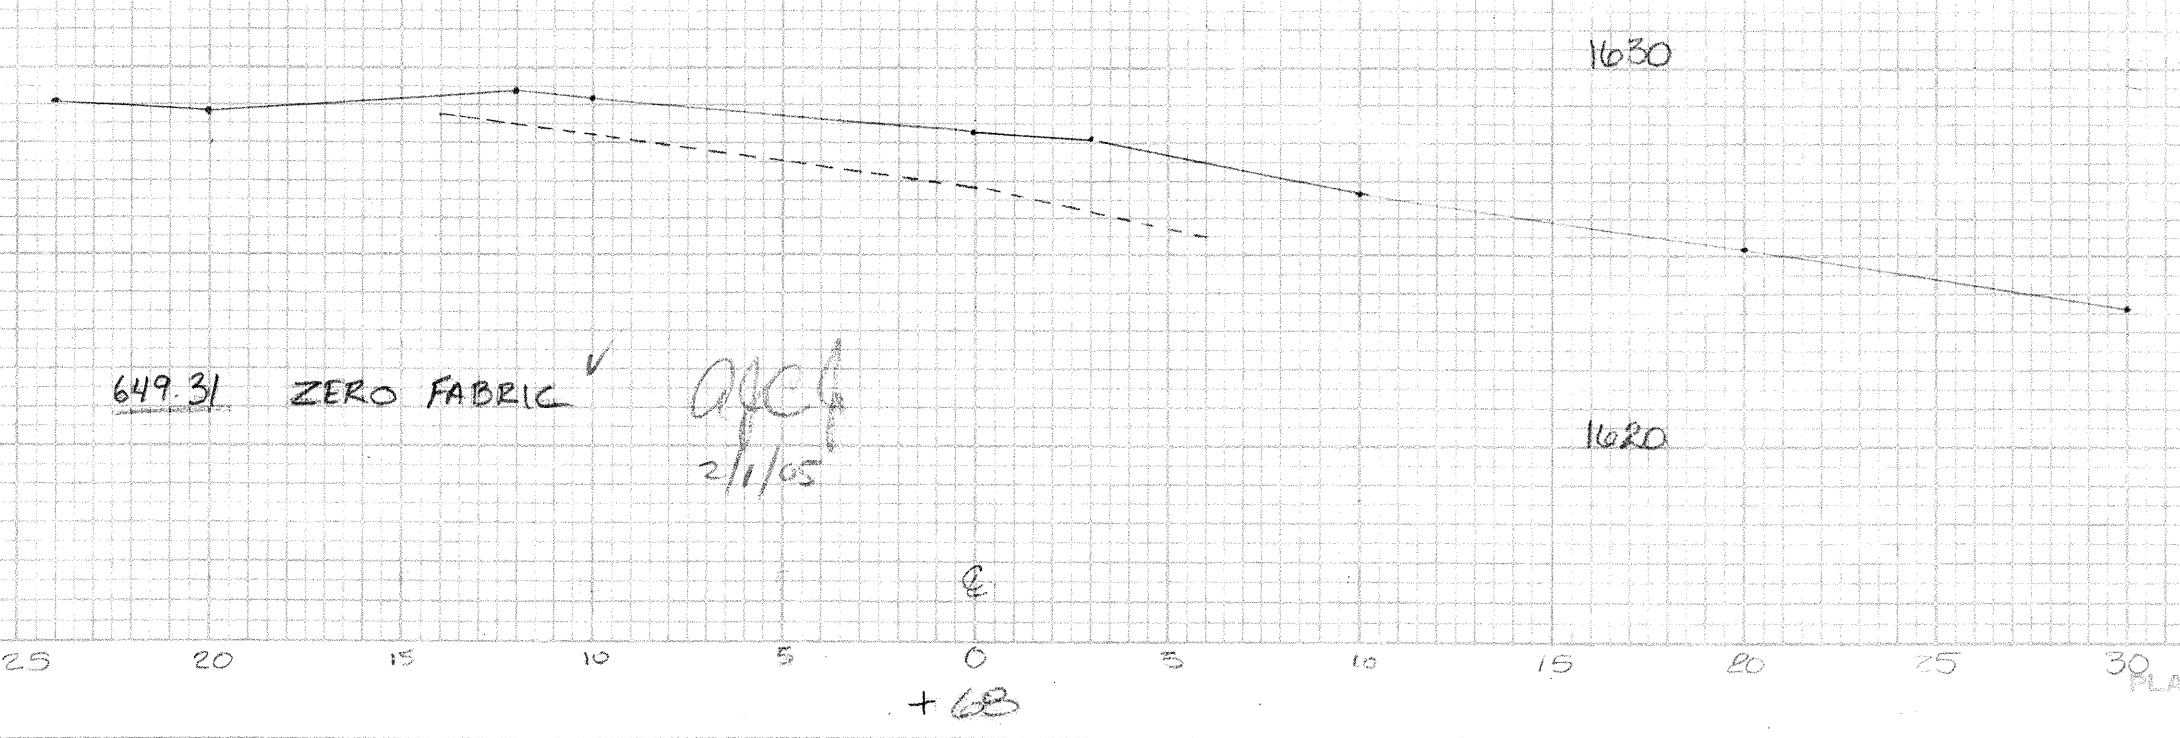
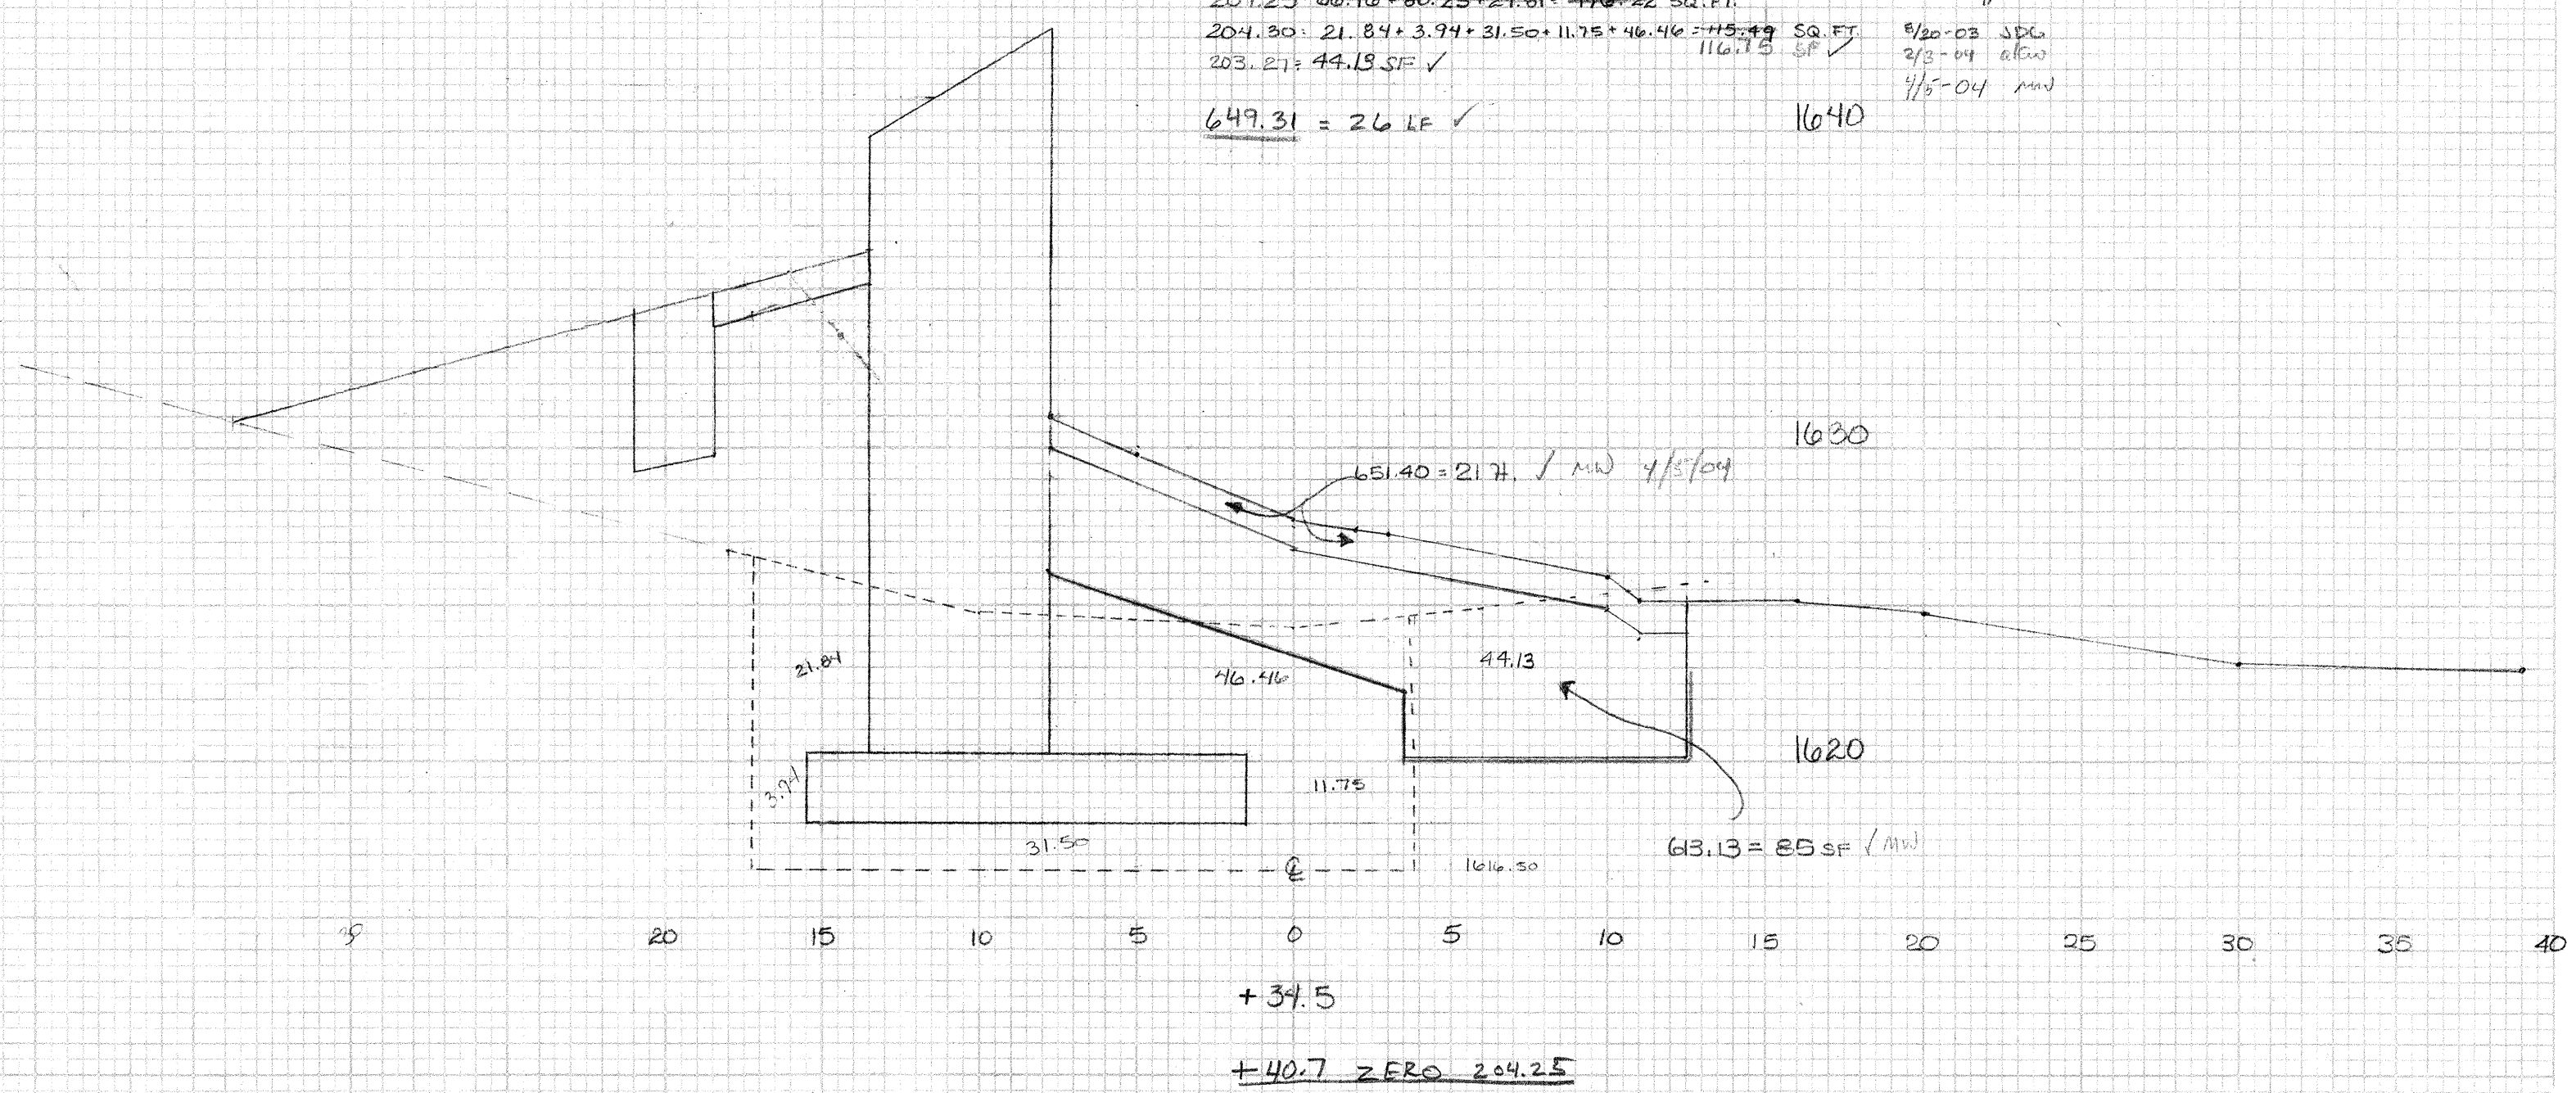
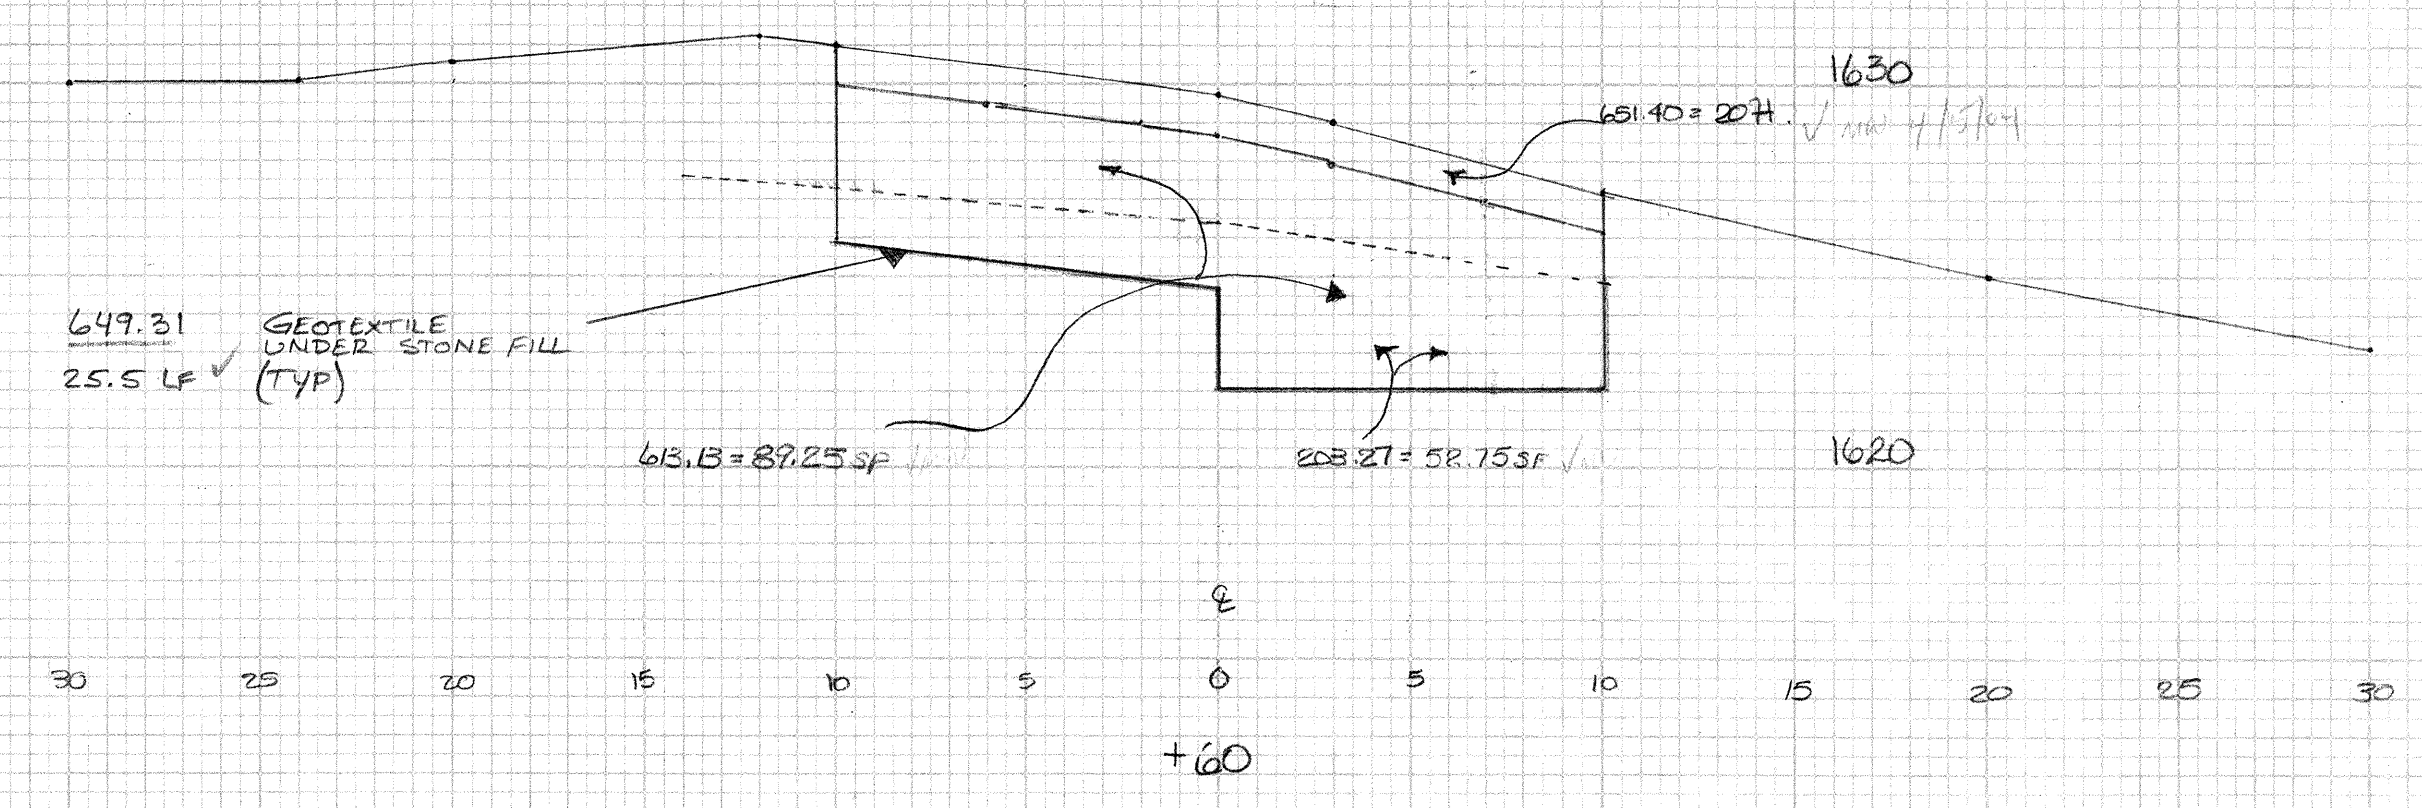
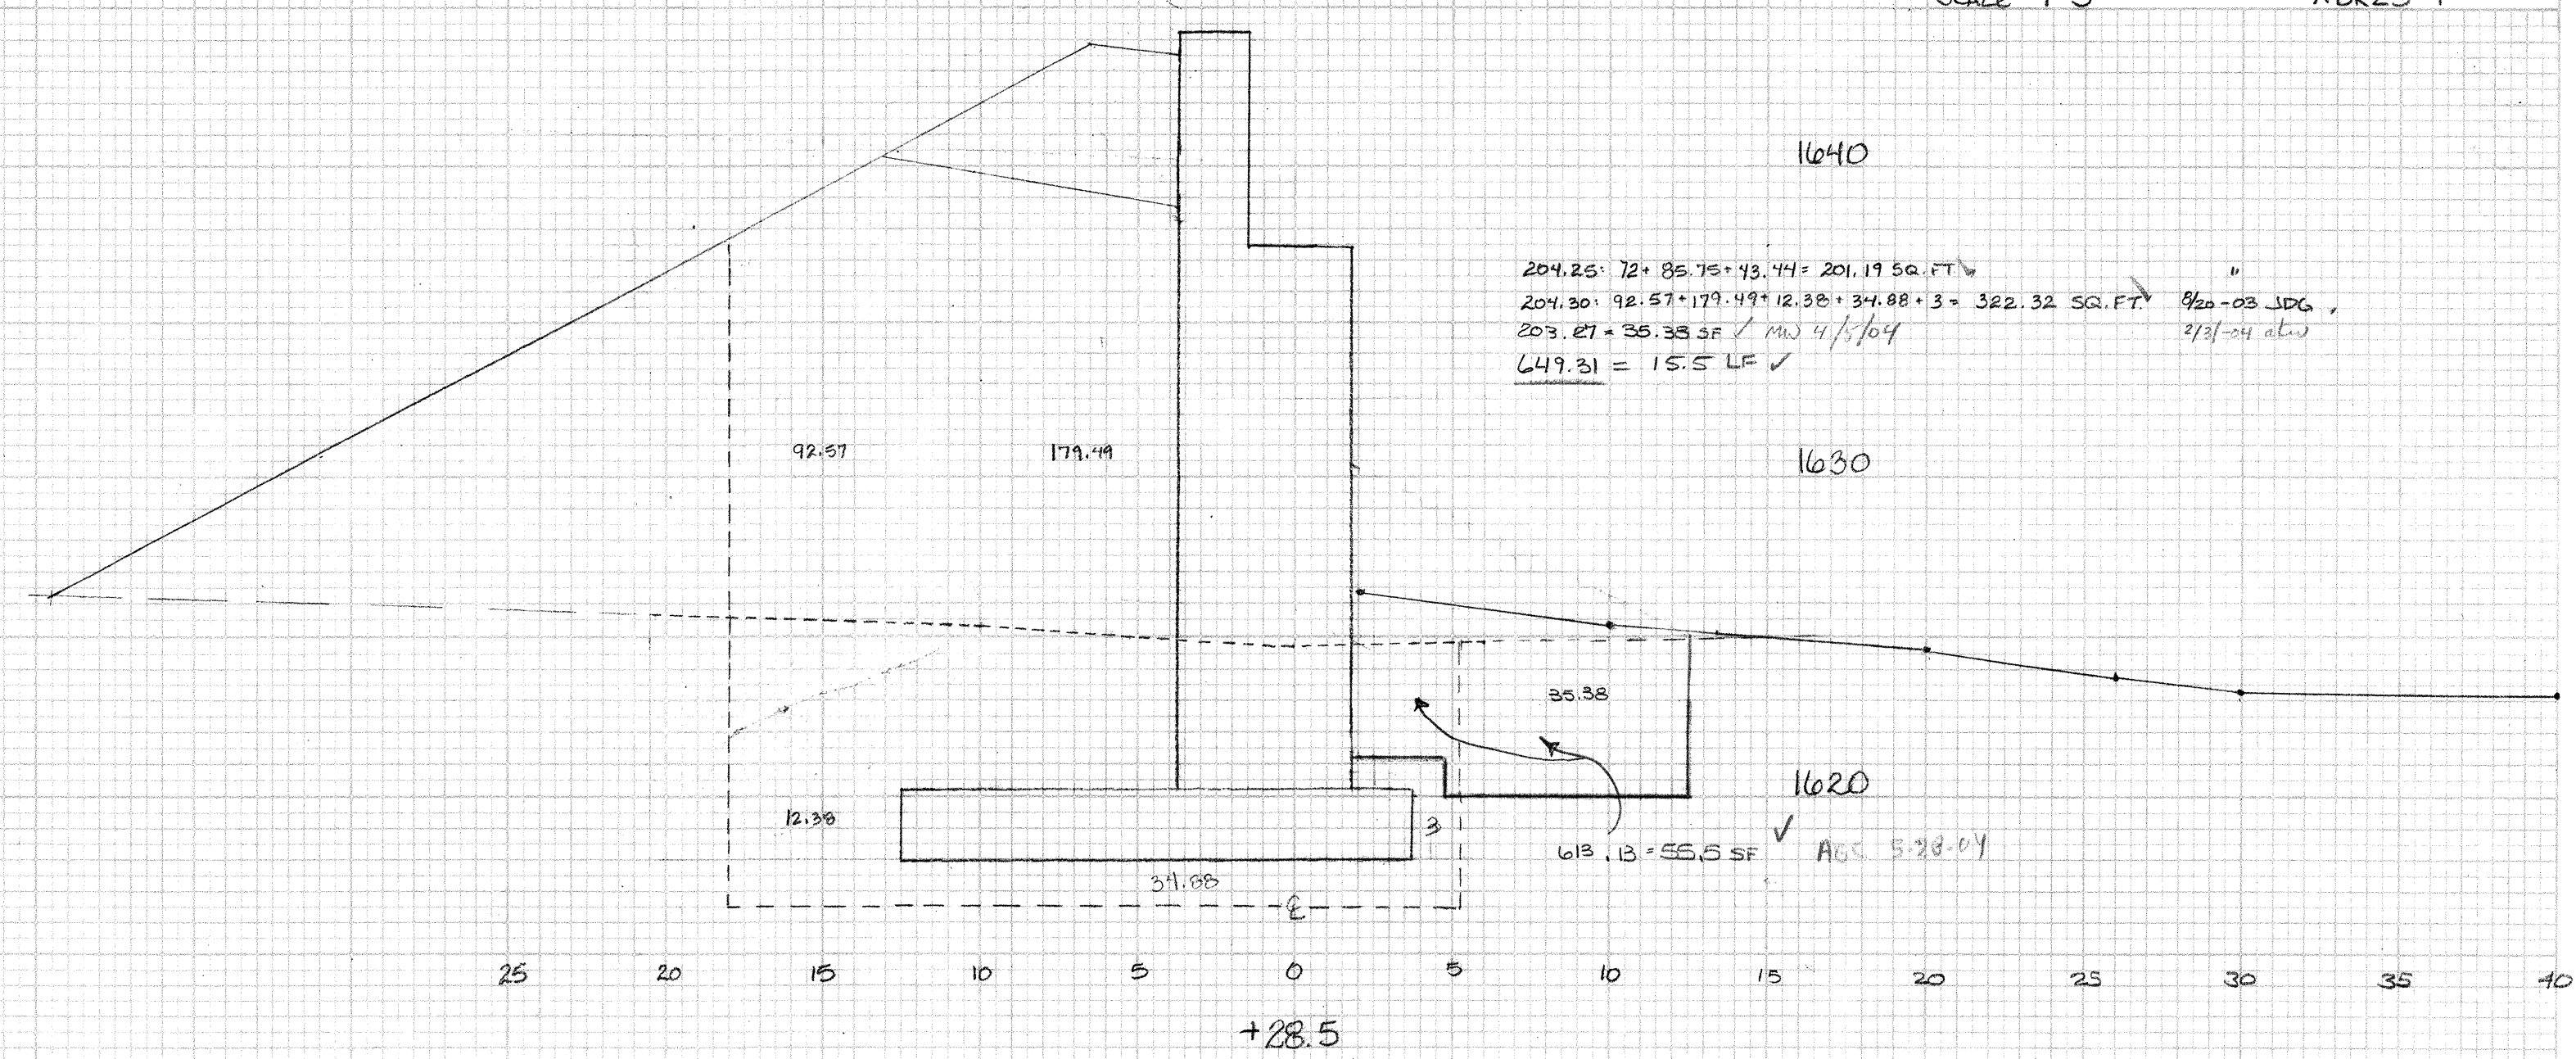


DATE: \_\_\_\_\_ BY: \_\_\_\_\_  
 ORIGINAL SURVEY: \_\_\_\_\_  
 SURVEY: \_\_\_\_\_  
 PHOTO: \_\_\_\_\_  
 TEMPLATE: \_\_\_\_\_  
 NO. OF COPIES: \_\_\_\_\_  
 AREAS CHECKED: \_\_\_\_\_

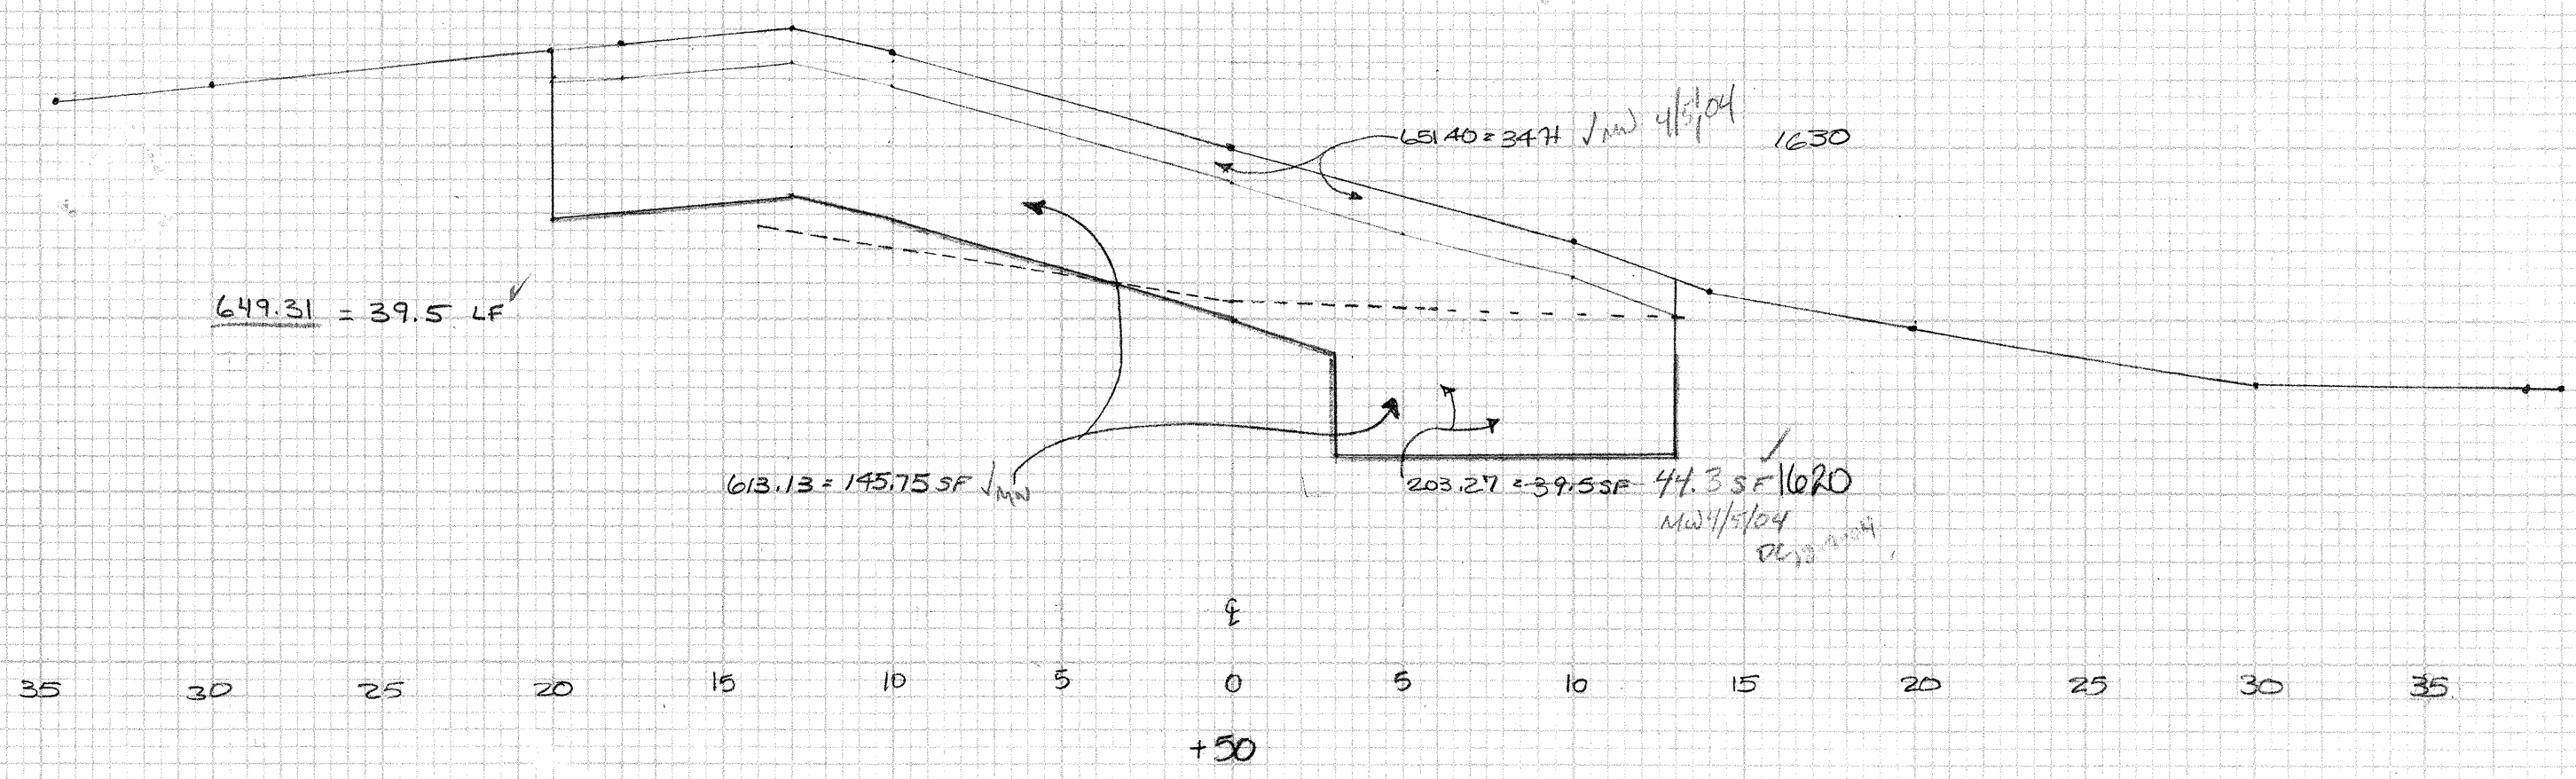

NOTE THAT SOFT QUANTITIES SHOWN IN RED PENCIL FOR ITEM 204.25 AND 204.30 WERE RE-PLANIMETERED & CARRIED FORWARD IN THE BRIDGE CALC. BOOK

AK 5/20/01

AKC 2/1/05