


FINAL SURVEY DATE: 9/22-08  
 SURVEYED BY: JDC  
 PLOTTED BY: JDC  
 NOTE BOOK NO.:  
 AREA CALCULATED:

ORIGINAL SURVEY DATE: 9/22-08  
 SURVEYED BY: JDC  
 PLOTTED BY: JDC  
 NOTE BOOK NO.:  
 AREA CALCULATED:

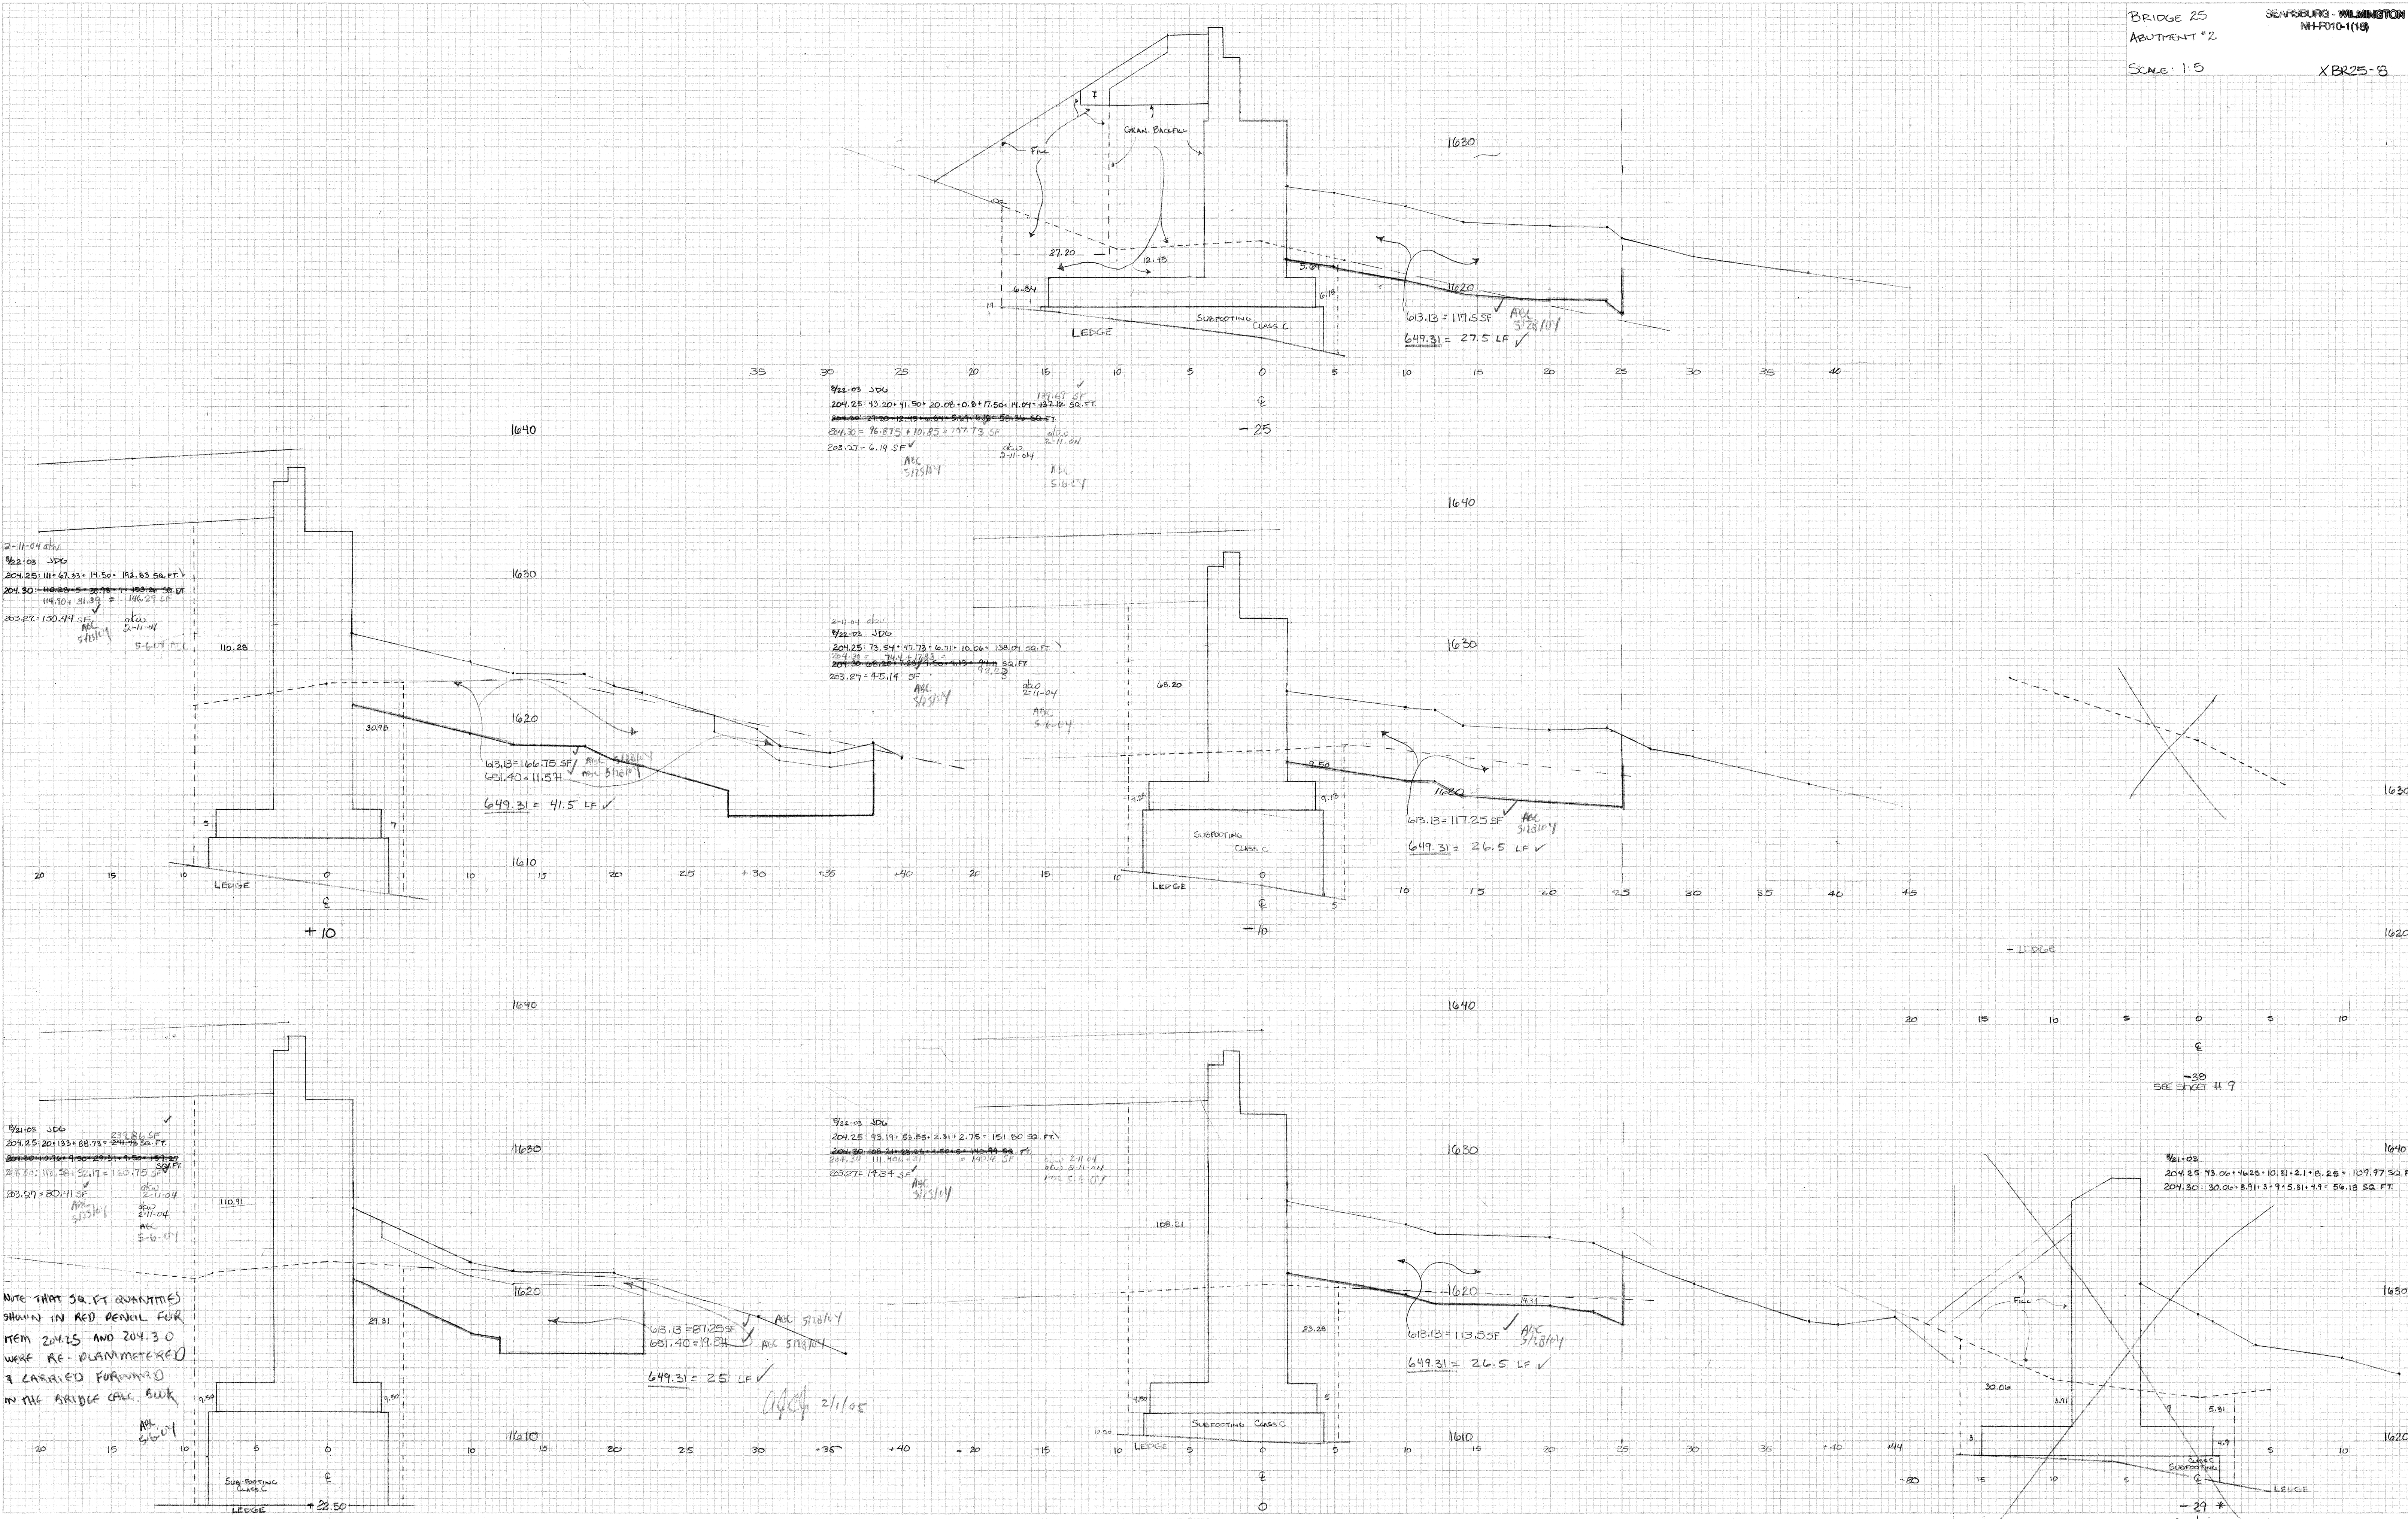

2-11-04  
 9/22-08 JDC  
 204.25: 111.47.33 \* 14.50 = 162.83 SQ. FT.  
 204.30: 110.80.5 \* 20.75 = 228.25 SQ. FT.  
 114.10 \* 21.39 = 242.97 SF  
 203.27: 130.14 SF  
 5-6-07

9/22-08 JDC  
 204.25: 43.20 \* 41.50 \* 20.00 \* 10.8 \* 17.50 \* 14.04 = 137.10 SQ. FT.  
 204.30: 76.815 \* 10.85 = 832.19 SQ. FT.  
 203.27: 6.19 SF  
 2-11-04  
 5/15/07  
 5/16/07

2-11-04  
 9/22-08 JDC  
 204.25: 73.54 \* 47.73 \* 6.71 \* 10.00 \* 158.01 SQ. FT.  
 204.30: 70.4 \* 10.83 = 761.72 SQ. FT.  
 203.27: 45.14 SF  
 2-11-04  
 5/15/07  
 5/16/07

9/22-08 JDC  
 204.25: 49.19 \* 53.85 \* 2.31 \* 2.75 = 151.80 SQ. FT.  
 204.30: 111.70 \* 10.83 = 1209.57 SQ. FT.  
 203.27: 14.34 SF  
 2-11-04  
 5/15/07  
 5/16/07

NOTE THAT SQ. FT. QUANTITIES SHOWN IN RED PENNUL FOR ITEM 204.25 AND 204.30 WERE RE-PLANIMETERED & CARRIED FORWARD IN THE BRIDGE CALL. BLK.