



204.30: 121.13+136.50+6.50+19.50+8.25 = 291.88 SQ. FT. 9/11-03 JDG
208.30: 242+12.75 = 354.75 SQ. FT. ✓
618.13: 16.63 SQ. FT. ✓
4-7-04
649.31 = 0

204.30: 8.25+3.25+37.50+6.50+325.50+203.18 = 584.18 SQ. FT. 9/11-03 JDG
208.30: 675.00 SQ. FT. ✓
618.13: 23.06 SQ. FT. ✓
4-7-04
649.31 = 0

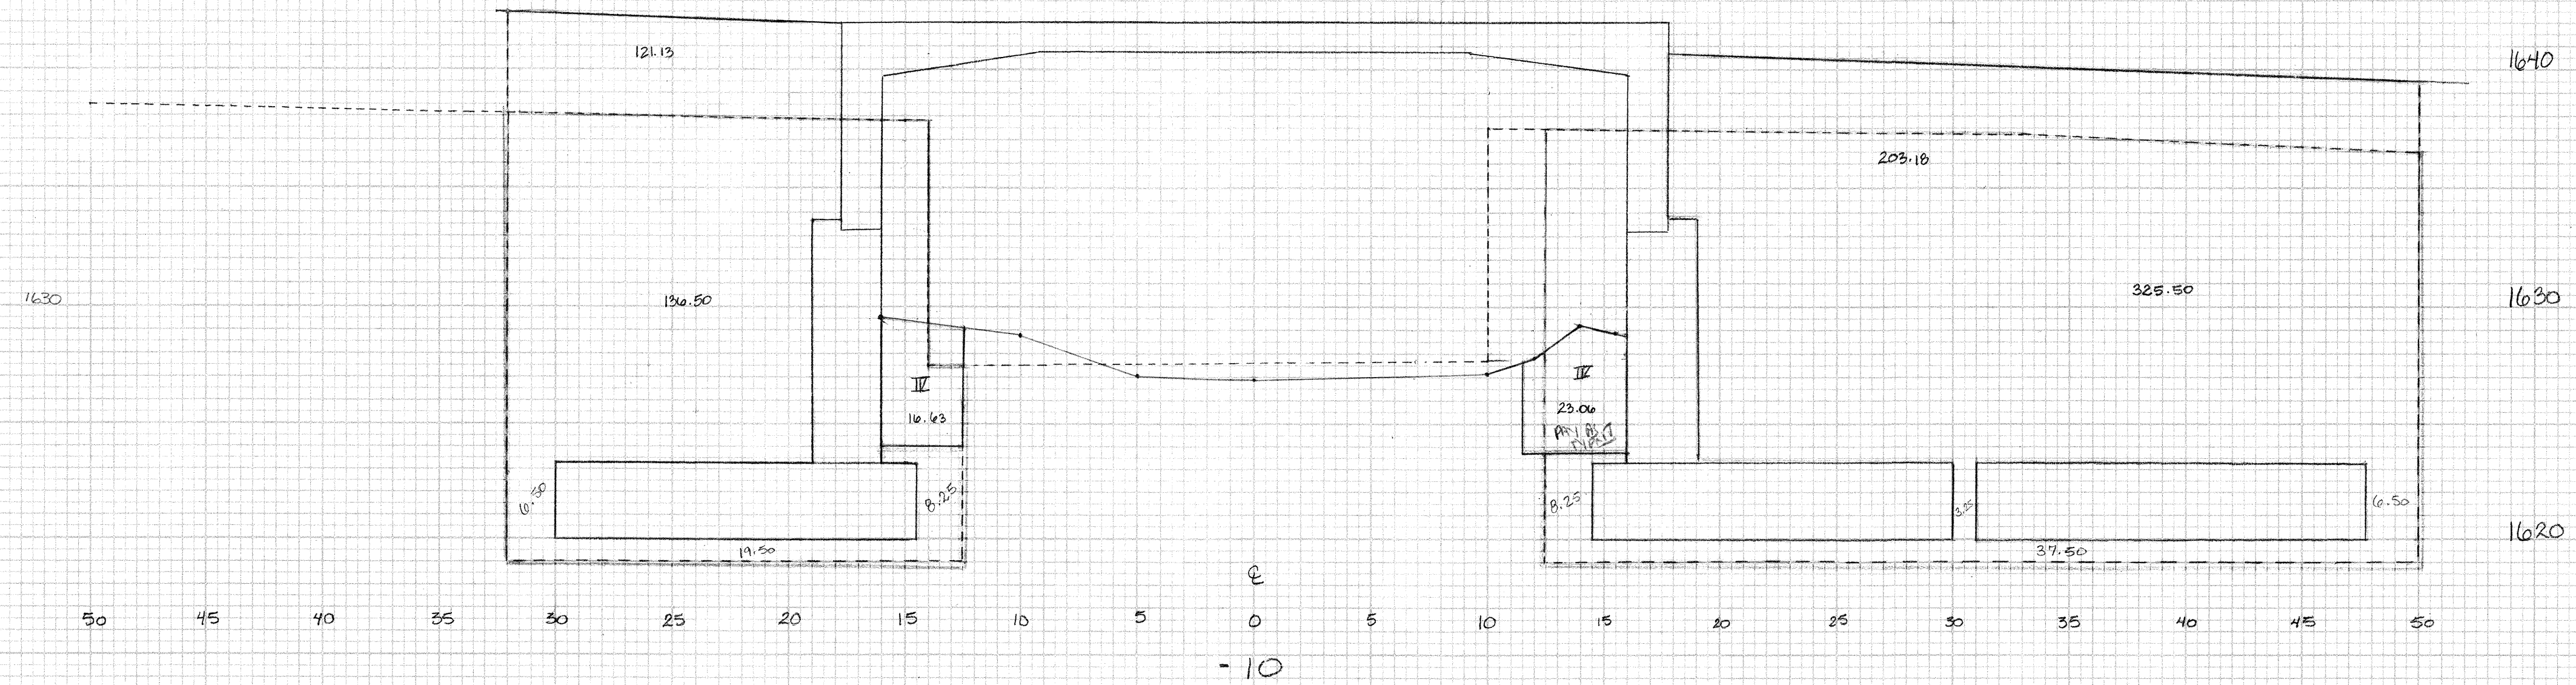


204.30: 123.95+136.50+6.50+19.50+8.25 = 294.75 SQ. FT. 9/11-03 JDG
208.30: 309.60+32.73 = 342.33 SQ. FT. ✓
618.13: 18.61 SQ. FT. ✓
4-7-04
649.31 = 0

204.30: 1.75+6.50+19.50+6.50+134.50+105.75 = 276.20 SQ. FT. 9/11-03 JDG
208.30: 364.65 SQ. FT. ✓
618.13: 25.88 SQ. FT. ✓
4-7-04
649.31 = 0

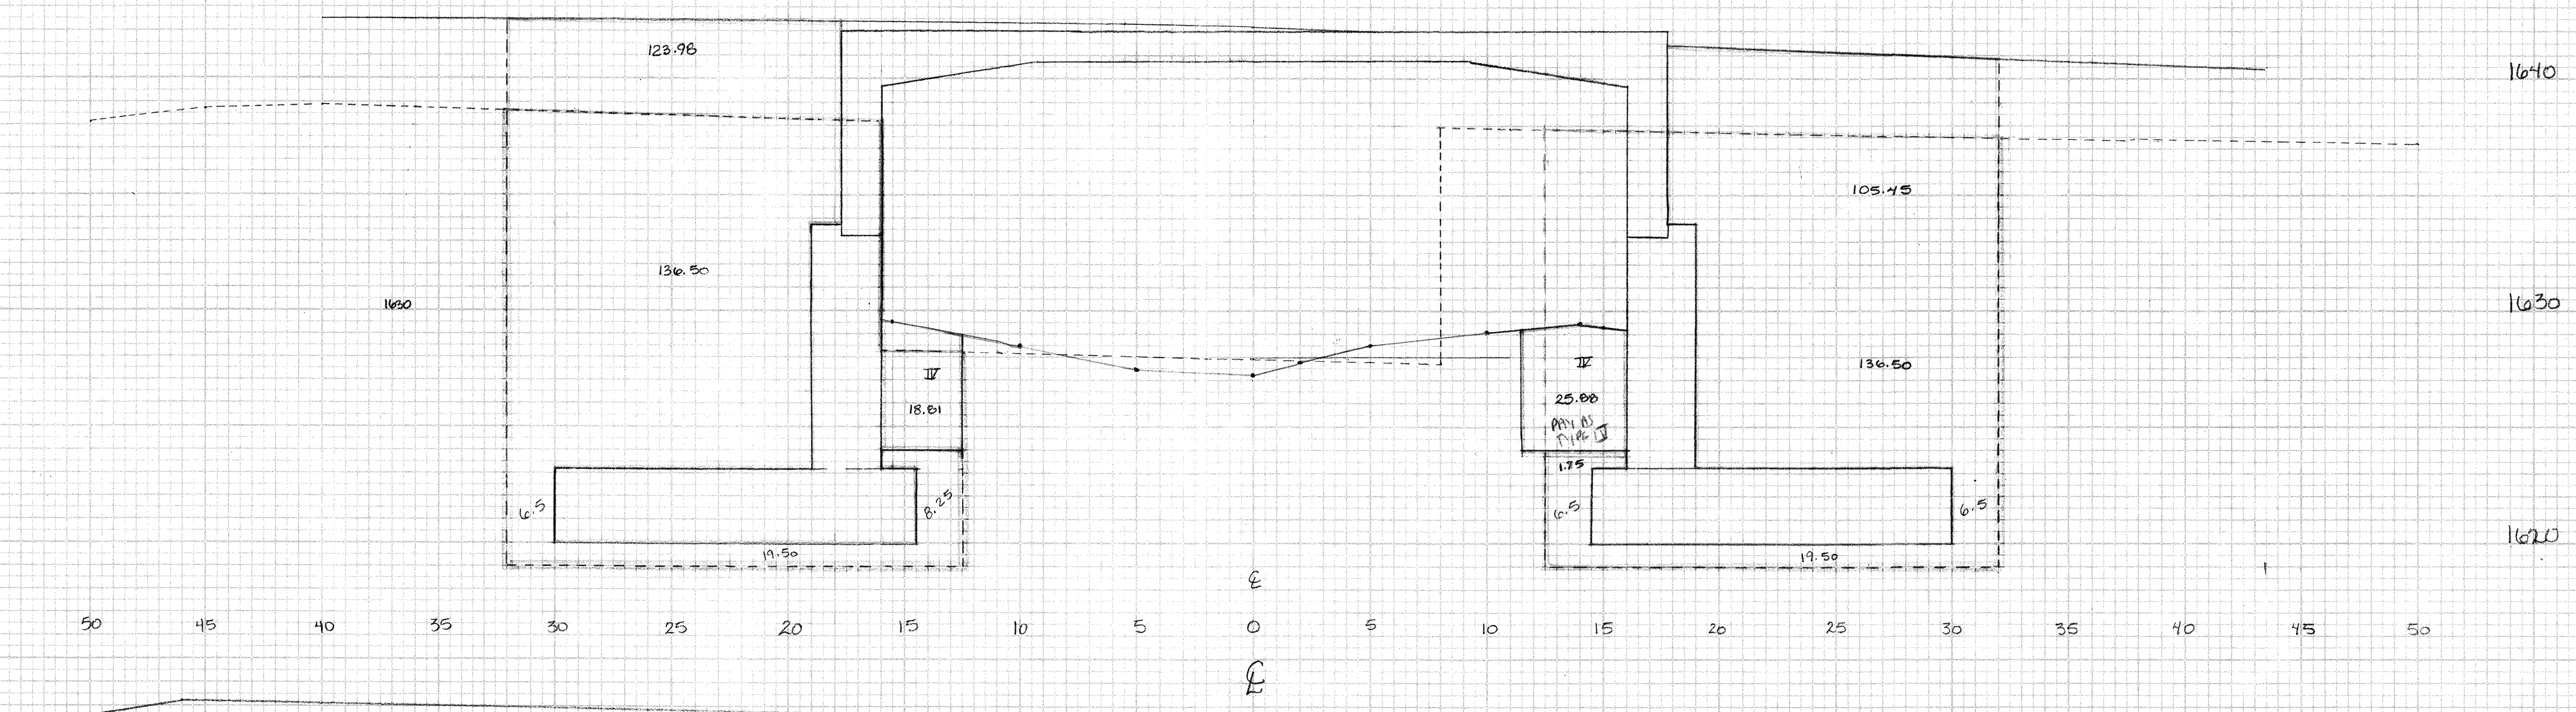

204.30: 140.01+136.50+6.50+19.50+2.63 = 311.64 SQ. FT. 9/11-03 JDG
208.30: 90.66+91.16+75.45 = 257.27 SQ. FT. ✓
618.13: 20.56 SQ. FT. ✓
4-7-04
649.31 = 0

204.30: 8.25+19.50+6.50+186.50+113.29 = 284.04 SQ. FT. 9/11-03 JDG
208.30: 106.84+273.70 = 380.54 SQ. FT. ✓
618.13: 27.60 SQ. FT. ✓
4-7-04
649.31 = 0

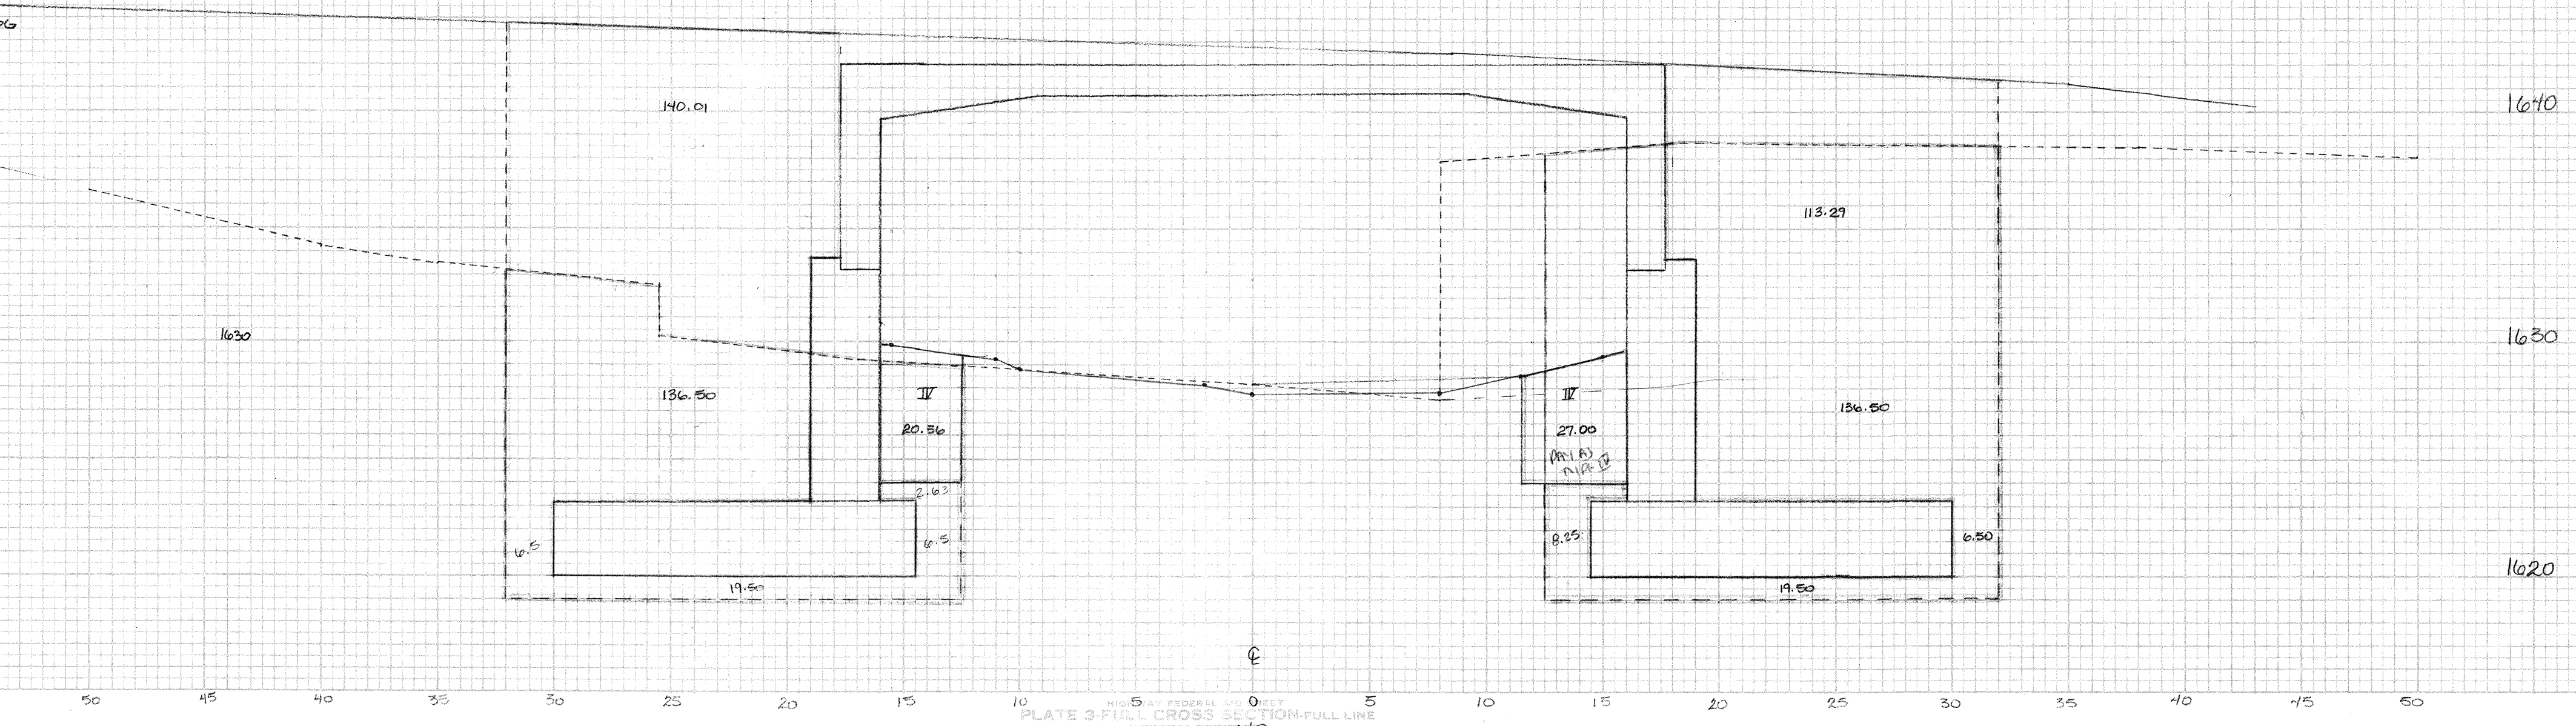

FINAL SURVEY
DATE: _____ BY: _____
PROJECT: _____
SHEET NO.: _____
TOTAL SHEETS: _____
SCALE: _____
DRAWN BY: _____
CHECKED BY: _____
DATE: _____

ORIGINAL SURVEY
DATE: _____ BY: _____
PROJECT: _____
SHEET NO.: _____
TOTAL SHEETS: _____
SCALE: _____
DRAWN BY: _____
CHECKED BY: _____
DATE: _____