
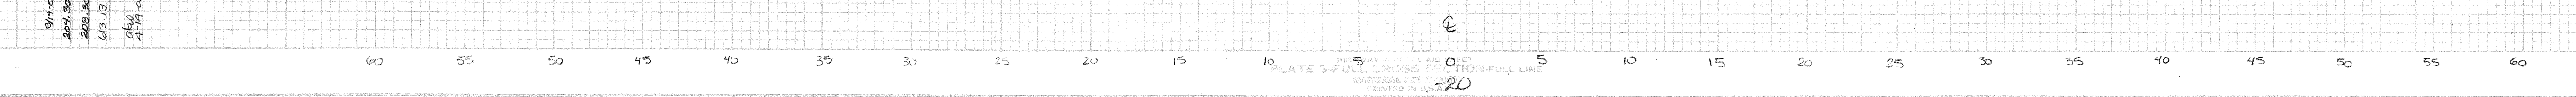
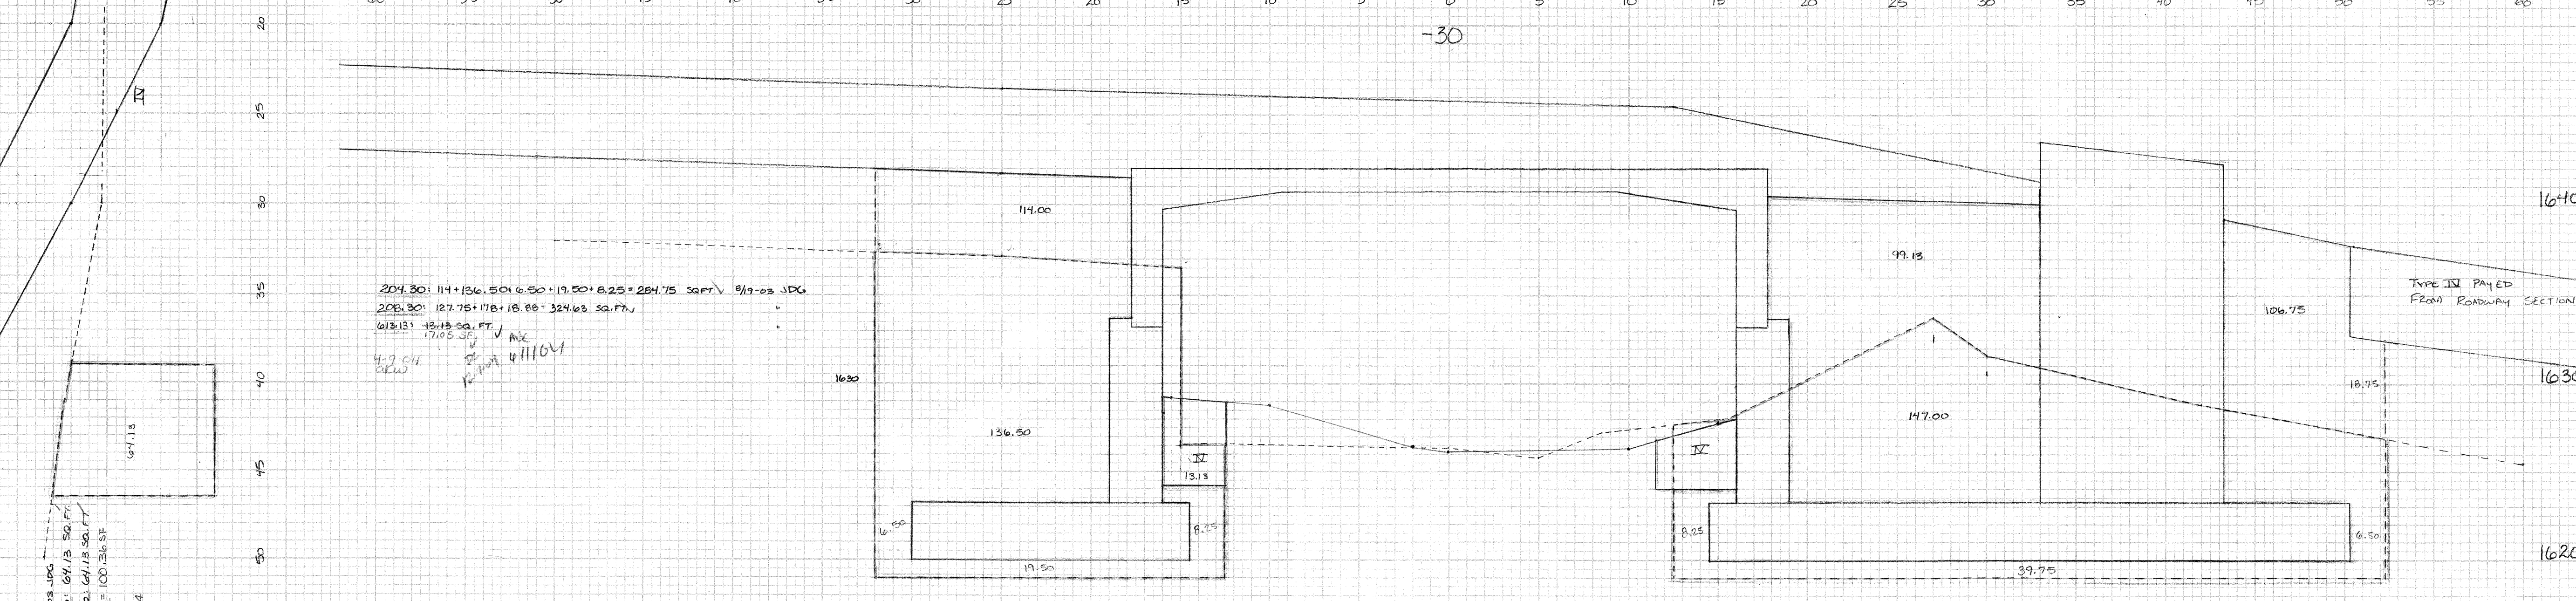
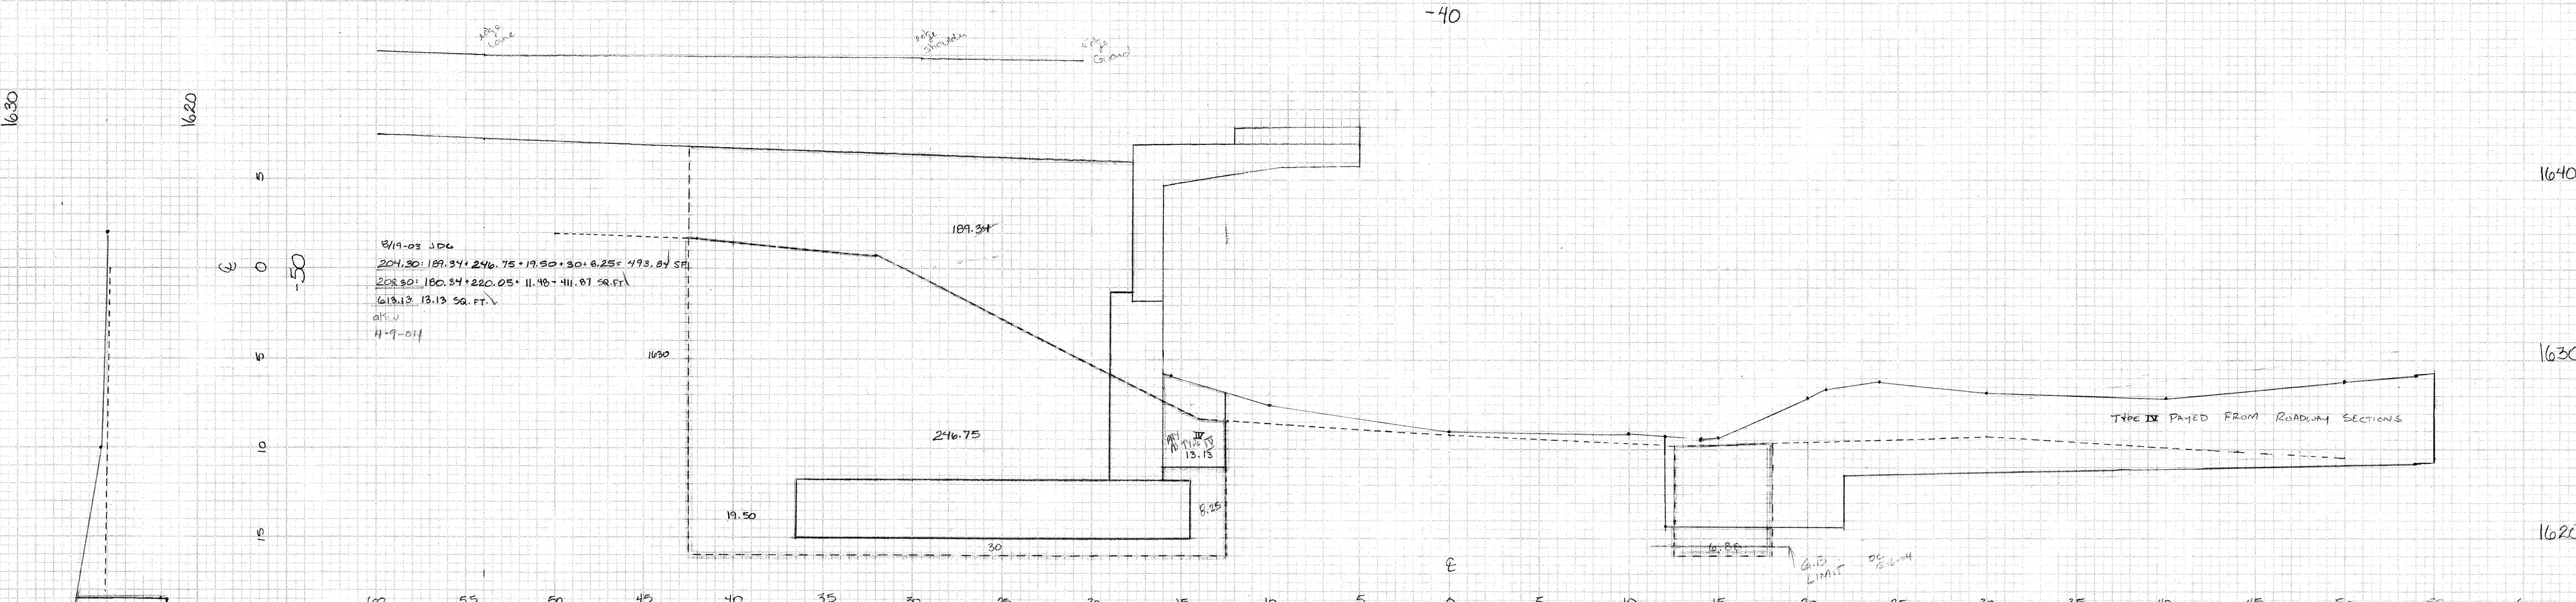


FINAL SURVEY
 DATE: 4/9/04
 BY: [Signature]
 CHECKED: [Signature]
 NO. []

ORIGINAL SURVEY
 DATE: 4/9/04
 BY: [Signature]
 CHECKED: [Signature]
 NO. []

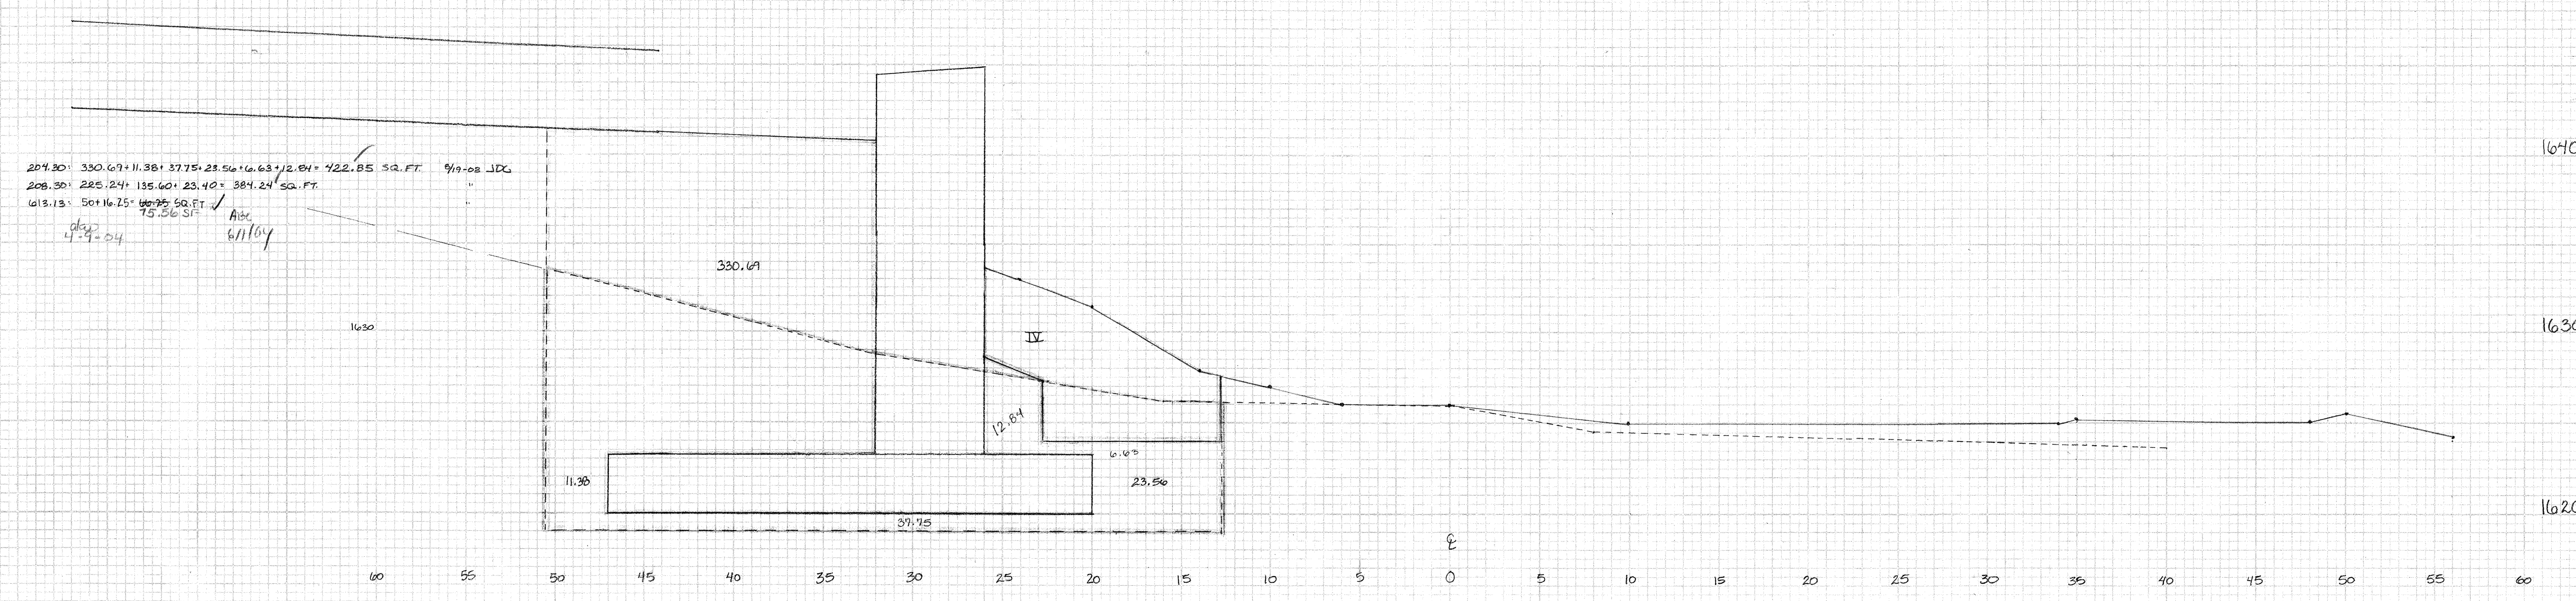

204.30: 330.69 + 11.38 + 37.75 + 23.56 + 6.63 + 12.84 = 422.85 SQ. FT. 8/19-03 JDG
 208.30: 225.24 + 135.60 + 23.40 = 384.24 SQ. FT.
 613.13: 56 + 16.75 = 72.75 SQ. FT. 6/11/04

8/19-03 JDG
 204.30: 189.34 + 246.75 + 19.50 + 30 + 6.25 = 473.84 SQ. FT.
 208.30: 180.54 + 220.05 + 11.46 + 11.87 = 393.92 SQ. FT.
 613.13: 13.13 SQ. FT.
 4/9-04

204.30: 114 + 136.50 + 6.50 + 19.50 + 6.25 = 282.75 SQ. FT. 8/19-03 JDG
 208.30: 127.75 + 176 + 16.88 = 320.63 SQ. FT.
 613.13: 13.13 SQ. FT. 4/11/04

BB 12-6-04
 5.5
 12.84
 11.38
 204.30: 208.30 SQ. FT.
 208.30: 36.38 SQ. FT.
 613.13: 14.34 SQ. FT.
 4/9-04

8/19-03 JDG
 204.30: 8.25 + 39.75 + 6.50 + 18.75 + 106.75 = 170.00
 99.13 = 426.13 SQ. FT. 8/19-03 JDG
 208.30: 26.40 + 136.50 + 41.03 + 228.06 = 432.05 SQ. FT.
 613.13: 14.74 SQ. FT.
 4/9-04

106.75
 18.75
 147.00
 99.13
 170.00
 432.05
 14.74
 4/9-04