


ABN INFO		BILL OF MATERIAL				JOB NO.	DRAWING NO.	REV.
PAGE	LINE	MARK	QTY	MATERIAL	LENGTH FT INCHES	REMARKS	WT	PROCUREMENT NOTES
		17CF1	1	CROSSFRAME				609
8	N	2	a17	WT 5x19.5	7 5/8	(M270-50HT2) (H2-3)		
8	P	2	b17	L 5x5x1/2	5 4	(M270-50HT2) (H2-3)		
8	R	1	c16	PL 1/2x12 1/2	1 1	(M270-50HT2) (H2-3)		
8	R	1	d16	PL 1/2x12 1/2	1 1	(M270-50HT2) (H2-3)		
8	S	1	f16	PL 1/2x15 1/2	1 3	(M270-50HT2) (H2-3)		
8	S	1	g16	PL 1/2x15 1/2	1 3	(M270-50HT2) (H2-3)		
8	Q	1	h16	PL 1/2x12	1 8	(M270-50HT2) (H2-3)		
		17CF2	1	CROSSFRAME				609
8	N	2	a17	WT 5x19.5	7 5/8	(M270-50HT2) (H2-3)		
8	P	2	b17	L 5x5x1/2	5 4	(M270-50HT2) (H2-3)		
8	R	1	c16	PL 1/2x12 1/2	1 1	(M270-50HT2) (H2-3)		
8	R	1	d16	PL 1/2x12 1/2	1 1	(M270-50HT2) (H2-3)		
8	S	1	f16	PL 1/2x15 1/2	1 3	(M270-50HT2) (H2-3)		
8	S	1	g16	PL 1/2x15 1/2	1 3	(M270-50HT2) (H2-3)		
8	Q	1	h16	PL 1/2x12	1 8	(M270-50HT2) (H2-3)		

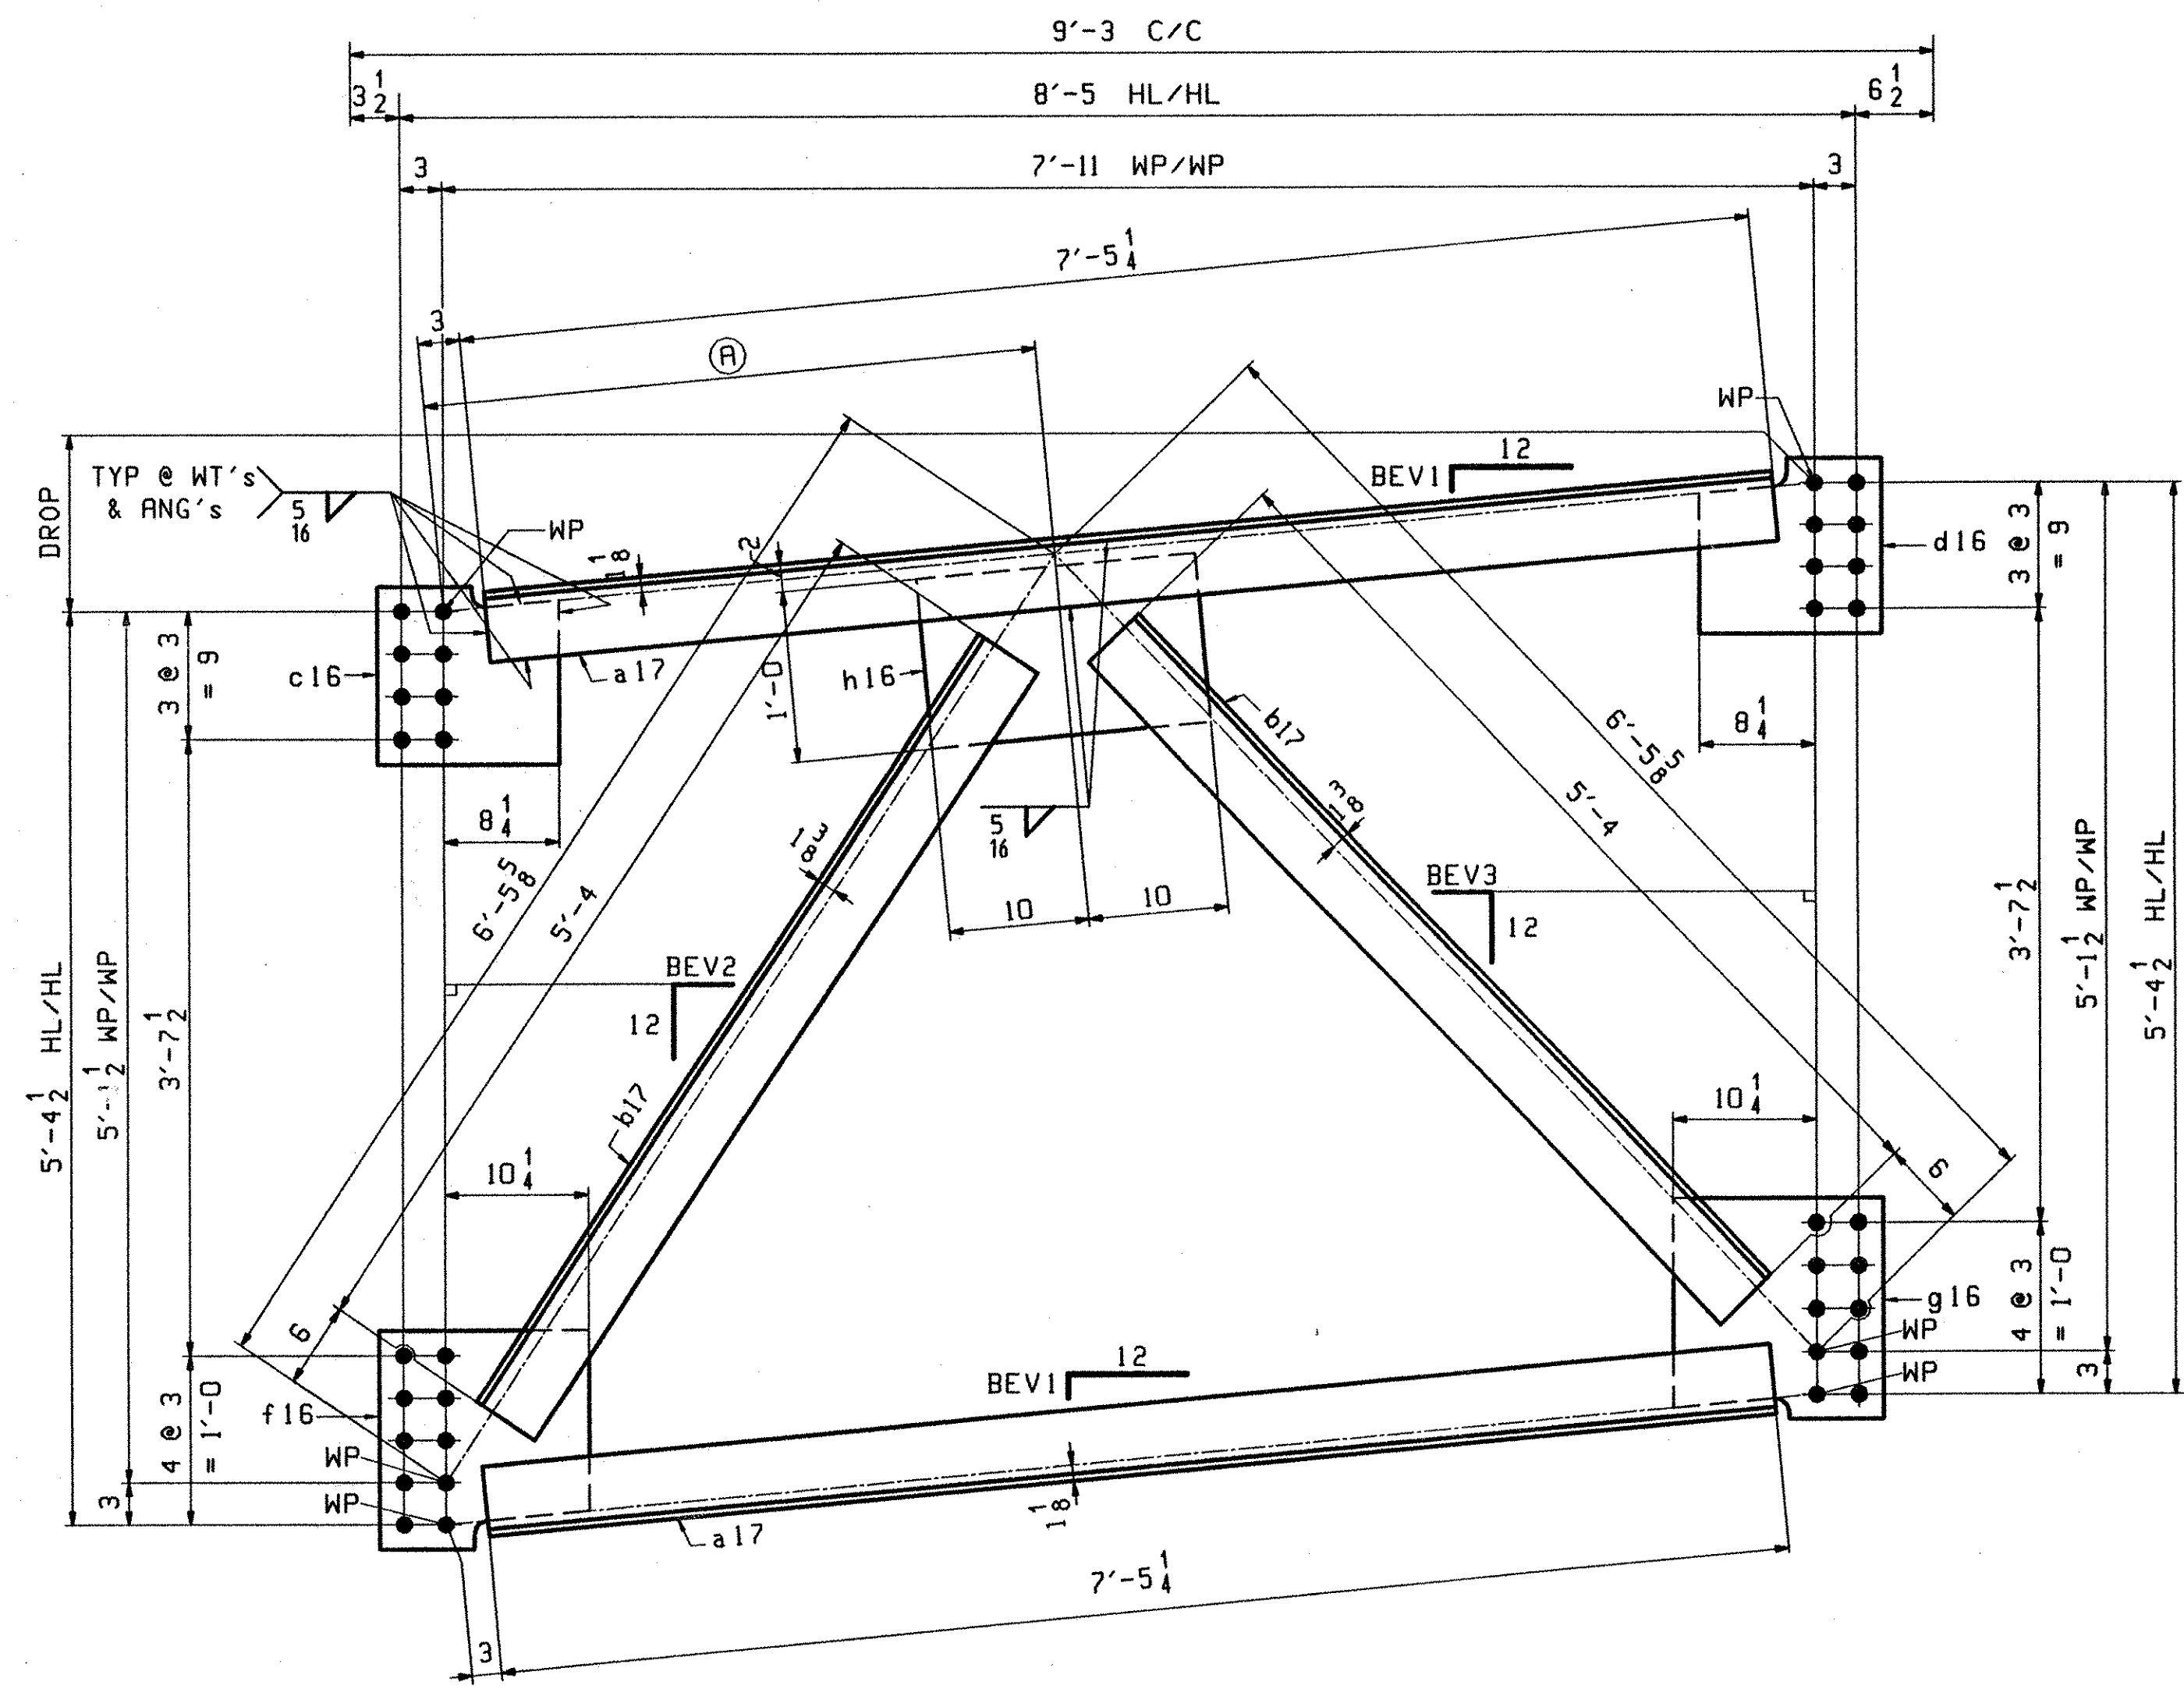

**INTERMEDIATE CROSSFRAME TYPE C3**  
LOOKING BACK-STATION

MARK	REQ'D	DROP	(A)	BEV1	BEV2	BEV3	PAINT
17CF1	1	8 5/8	3'-6 1/8	1 1/16	7 11/16	11 1/4	NO
17CF2	1	9 3/16	3'-5 13/16	1 3/16	7 5/8	11 3/8	NO

OUT FOR APPROVAL	9.9.02										
ISSUED TO SHOP											
FIELD & OFFICE											
REV. REMARKS	DATE	DWN	CHK	APP	Q.A.	NO.	DIA.	LGT	TYPE	WASHER	
MATERIAL:	ELECTRODES:		HOLES:		SHOP BOLTS:						
M270-50W			15-16 φ (UN)								
SURFACE PREP. & PAINT: -STEEL WITHIN 10'-0 ENDS OF GIRDERS SHALL BE PAINTED (SEE GNI) -ALL OTHER STEEL SHALL BE BLAST CLEANED AND LEFT UNPAINTED.											
DESCRIPTION: CROSSFRAMES										DRAWN BY	DATE
JOB: VT RTE 9 OVER THE DEERFIELD RIVER										VWJ	08/15
BRIDGE NO. 25A										CHKD BY	
SEARSBURG, VERMONT										DO	08/28
CONTRACTOR: J.A. McDONALD										APPROV BY	
										SUPERVISOR	M. J. GATLI
PROJ NO. PROJ. NHF 010-1(18)										Q.A.	
CUSTOMER: VERMONT AGENCY OF TRANSPORTATION											
<b>CASCO BAY STEEL STRUCTURES, INC.</b>										JOB NO.	DRG. NO.
75 SPRING HILL ROAD SACO, MAINE 04072										166	17
PHONE (207) 282-7360 FAX. (207) 282-1179										REV.	△

RECEIVED  
 OK'D BY: DV OK'D BY:  
 SEP 09 2002  
 RESUBMIT APPROVED  
 BY: RRW DATE 9-27-02

FOR GENERAL NOTES SEE GNI.