


ABH INFO		BILL OF MATERIAL				JOB NO.	DRAWING NO.	REV.	
PAGE	LINE	MARK	QTY	MARK	MATERIAL	LENGTH FT INCHES	REMARKS	WT	PROCUREMENT NOTES
		GIC	1		GIRDER				19846
4	N	I wa	1		PL 1/2 x 45	52 1 1/4	(M270-50HT2) (H2-3)		
3	Q	I wb	1		PL 1/2 x 45	49 1 1/16	(M270-50HT2) (H2-3)		
1	J	I ta	1		PL 1/2 x 16	28 0 1/16	(M270-50HT2) (H2-3)		
1	U	I tb	1		PL 7/8 x 16	73 3 1/8	(M270-50HT2) (H2-3)		
1	J	I ba	1		PL 1/2 x 16	28 0 1/16	(M270-50HT2) (H2-3)		
1	Q	I bb	1		PL 7/8 x 16	73 2 7/8	(M270-50HT2) (H2-3)		
5	C	6 xik	1		PL 1/2 x 7	3 8	(M270-50HT2) (H2-3)		
5	B	1 xlh	1		PL 3/4 x 7	3 8	(M270-50HT2) (H2-3)		
5	B	2 xlg	1		PL 3/4 x 7	3 8	(M270-50HT2) (H2-3)		
5	B	1 xlf	1		PL 3/4 x 7	3 8	(M270-50HT2) (H2-3)		
5	K	1 xlaa	1		PL 1/4 x 3 1/2	0 11			
5	K	1 xlab	1		PL 1/4 x 2 7/8	0 11			

ONE - GIRDER - GIC (DEV)

1. FOR GIRDER STANDARD DETAILS SEE DWG. XI.
2. FOR CAMBER DIAGRAM SEE DWG. C3.
3. FOR FLANGE DIAGRAM SEE DWG. F3.
4. FOR GENERAL NOTES SEE SHT. GNI.

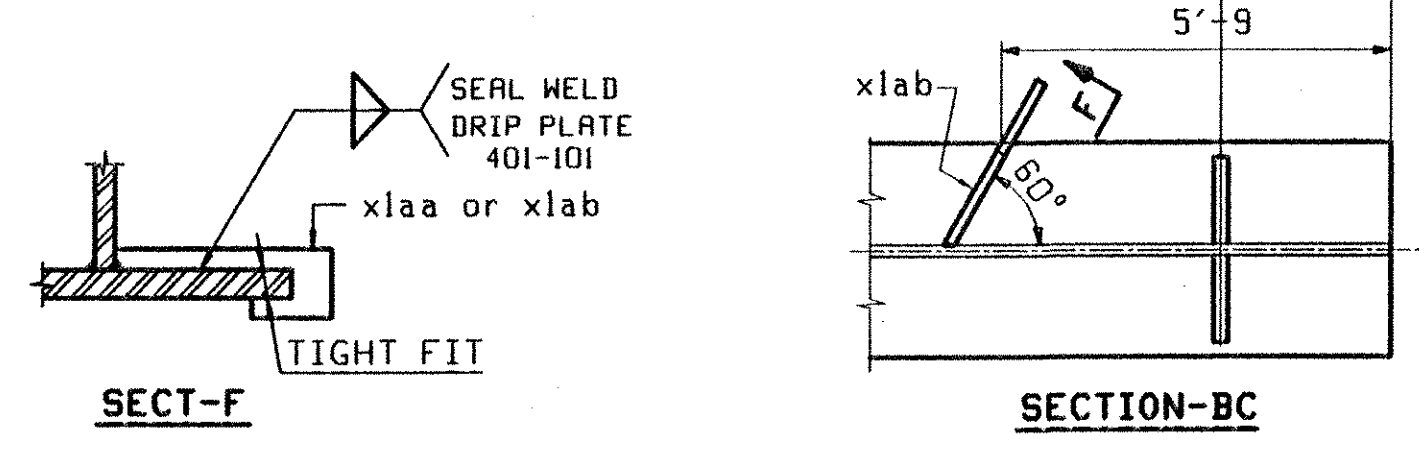

RECEIVED
 OK'D BY: *[Signature]* OK'D BY: _____
 SEP 16 2002
 RESUBMIT APPROVED: *[Signature]*
 BY: *[Signature]* DATE: 9-3-02

OUT FOR APPROVAL	9/3/02								
OUT FOR APPROVAL									
ISSUED TO SHOP									
FIELD & OFFICE									

REV.	REMARKS	DATE	DWN	CHK	APP	O.A.	NO.	DIA.	LGT	TYPE	WASHER
	MATERIAL: M270-50W										
	ELECTRODES:										
	HOLES: 15 1/16" φ										
	SHOP BOLTS:										

SURFACE PREP. & PAINT:
 -STEEL WITHIN 10'-0 ENDS OF GIRDERS SHALL BE PAINTED (SEE GNI)
 -ALL OTHER STEEL SHALL BE BLAST CLEANED AND LEFT UNPAINTED.

DESCRIPTION:	GIRDER - GIC	DRAWN BY	DATE
JOB:	VT. ROUTE 9 OVER DEERFIELD RIVER	ATD	08/30
	BRIDGE 25B	CHKD BY	DO
	SEARSBURG, VERMONT	DO	09/05
	CONTRACTOR: J.A. McDONALD	APPROV BY	
		SUPERVISOR	W. J. GATTI

PROJ NO.	NHF-010-1(18)	O.A.	
CUSTOMER:	VERMONT AGENCY OF TRANSPORTATION		
CASCO BAY STEEL STRUCTURES, INC.		JOB NO.	DRG. NO.
75 SPRING HILL ROAD SACO, MAINE 04072		167	13
PHONE (207) 282-7360 FAX. (207) 282-1179			REV. <i>[Signature]</i>

