



REV 38150

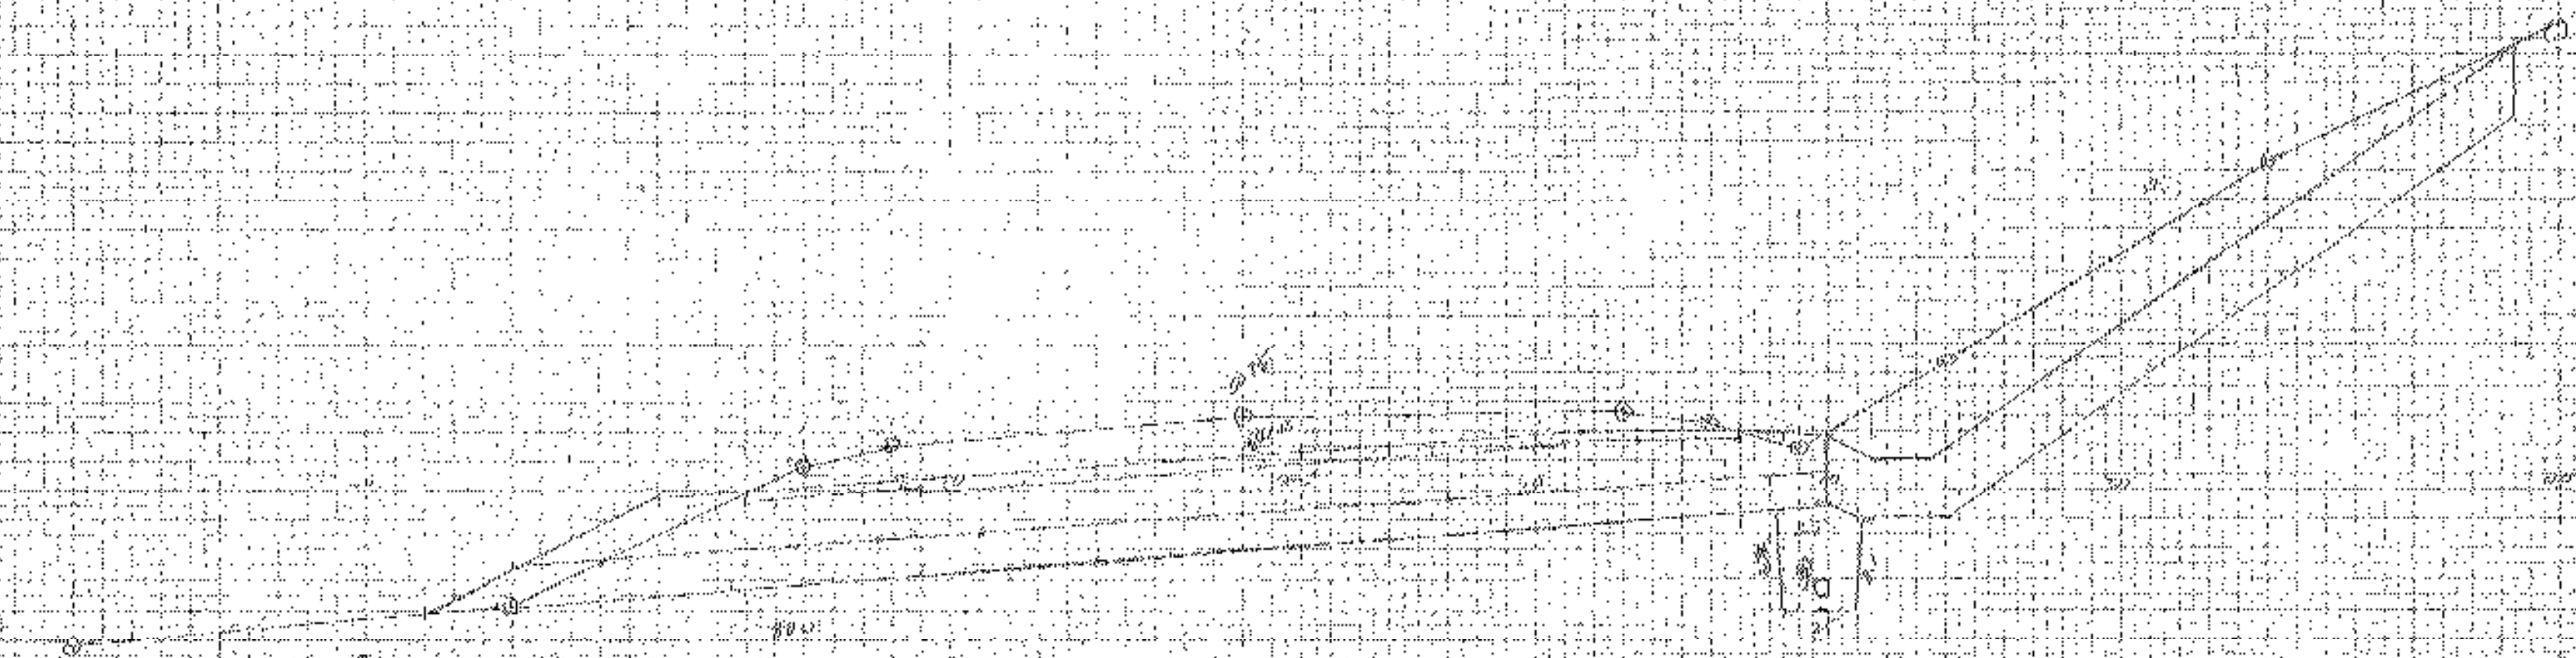


From Data R. 017
 20315 Contour 20000
 20331 Contour 20000
 20325 Contour 20000

REV 37750

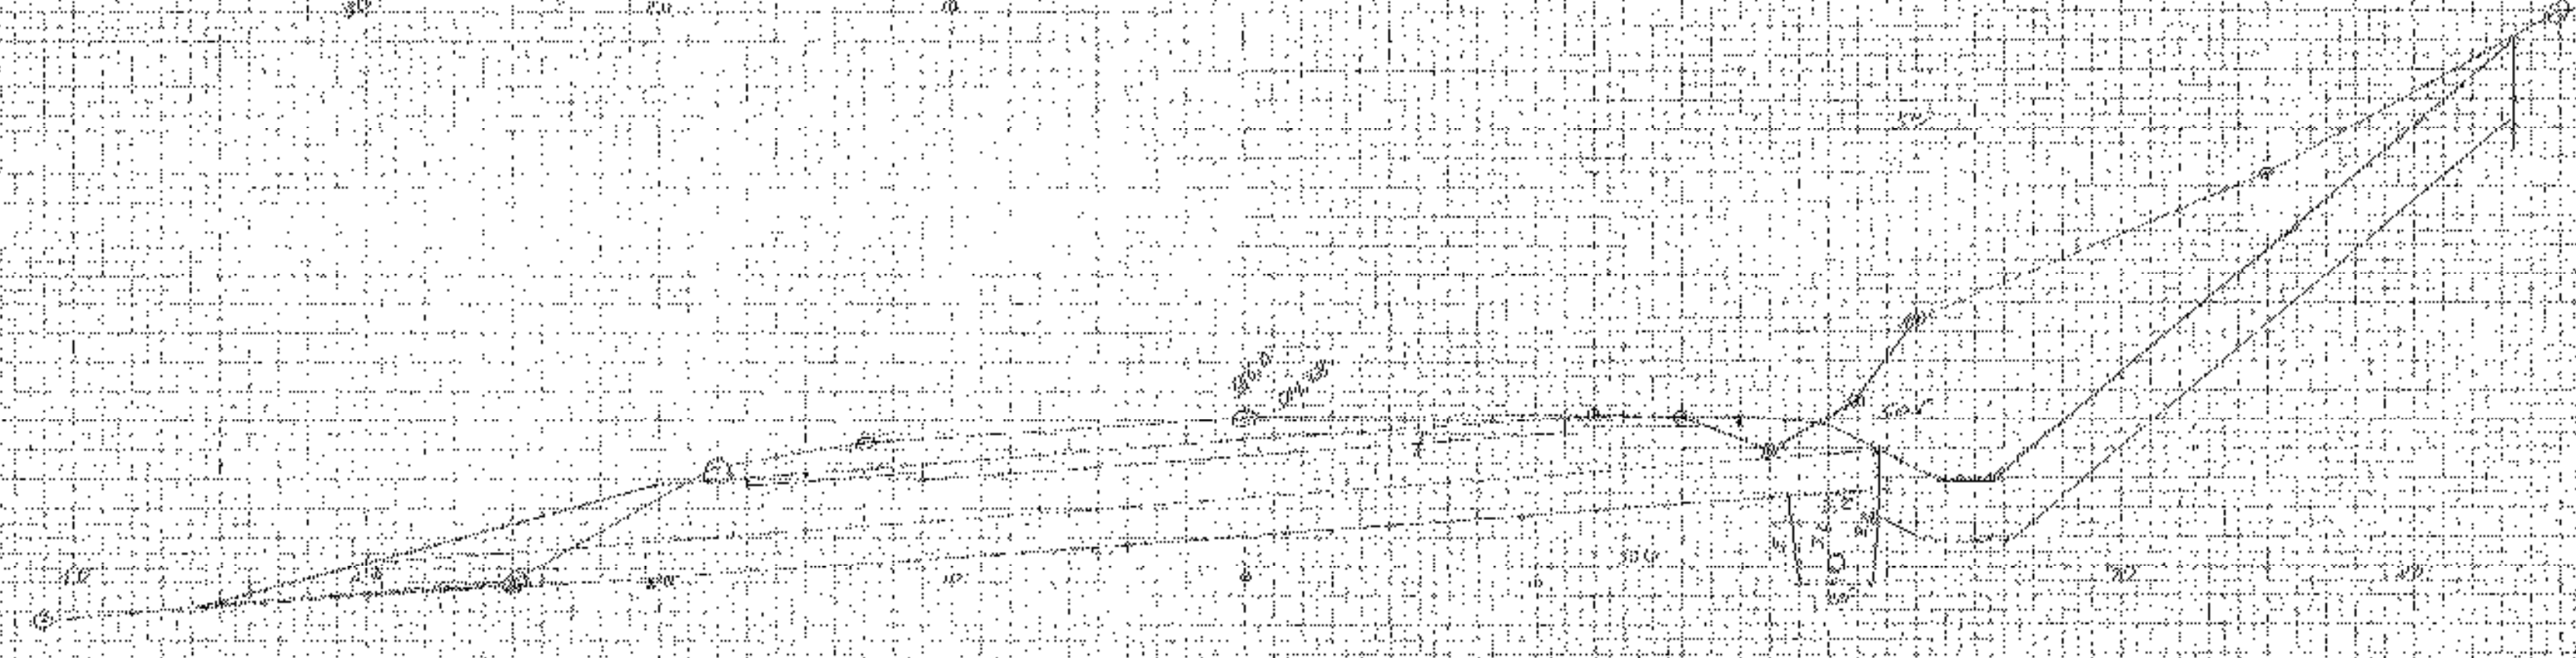


From Data R. 017
 20315 Contour 20000
 20331 Contour 20000
 20325 Contour 20000

REV 37450

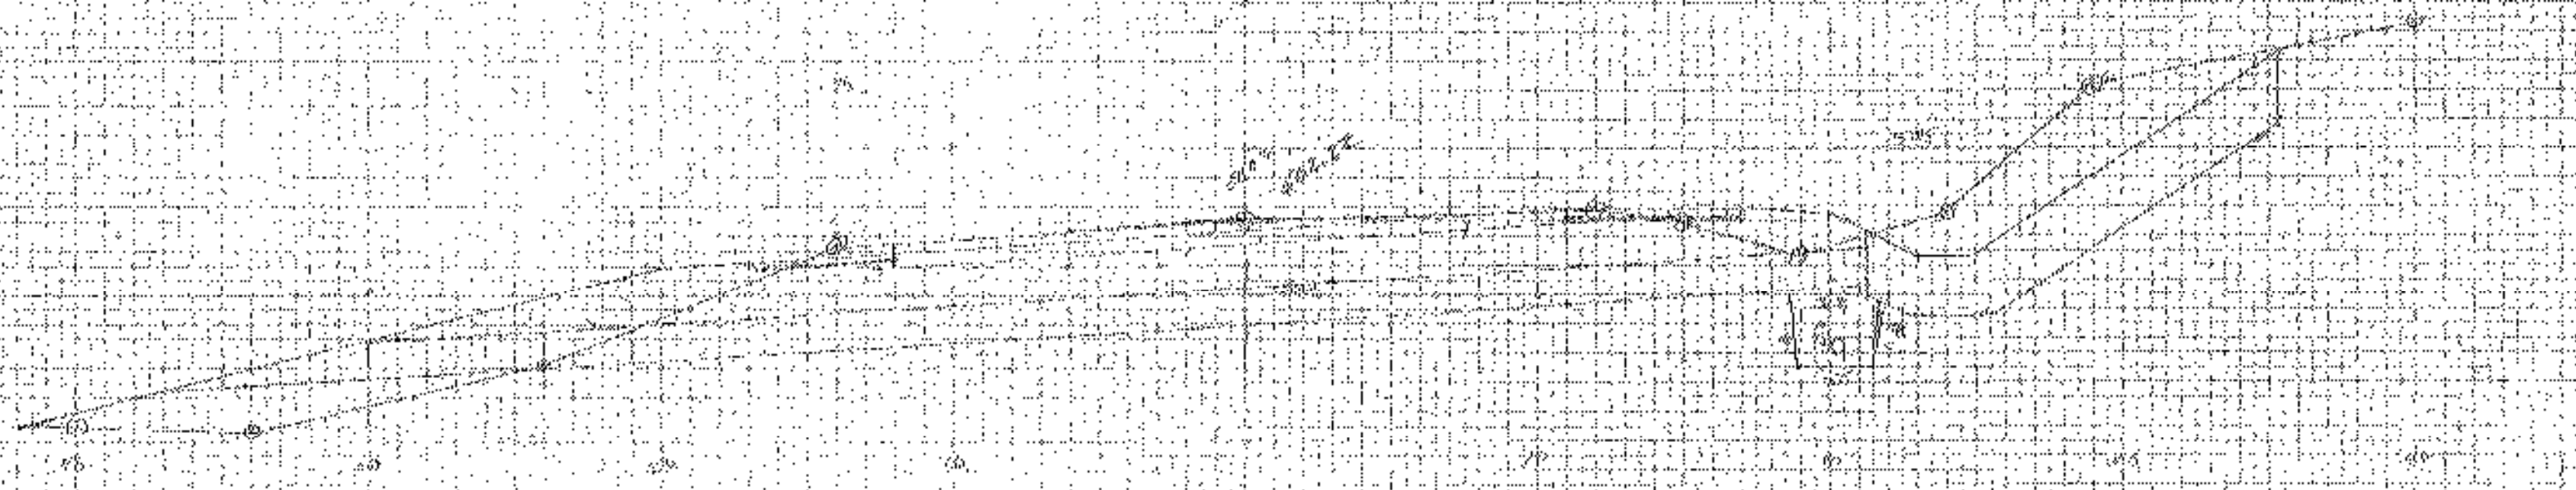

From Data R. 017
 20315 Contour 20000
 20331 Contour 20000
 20325 Contour 20000

REV 36750

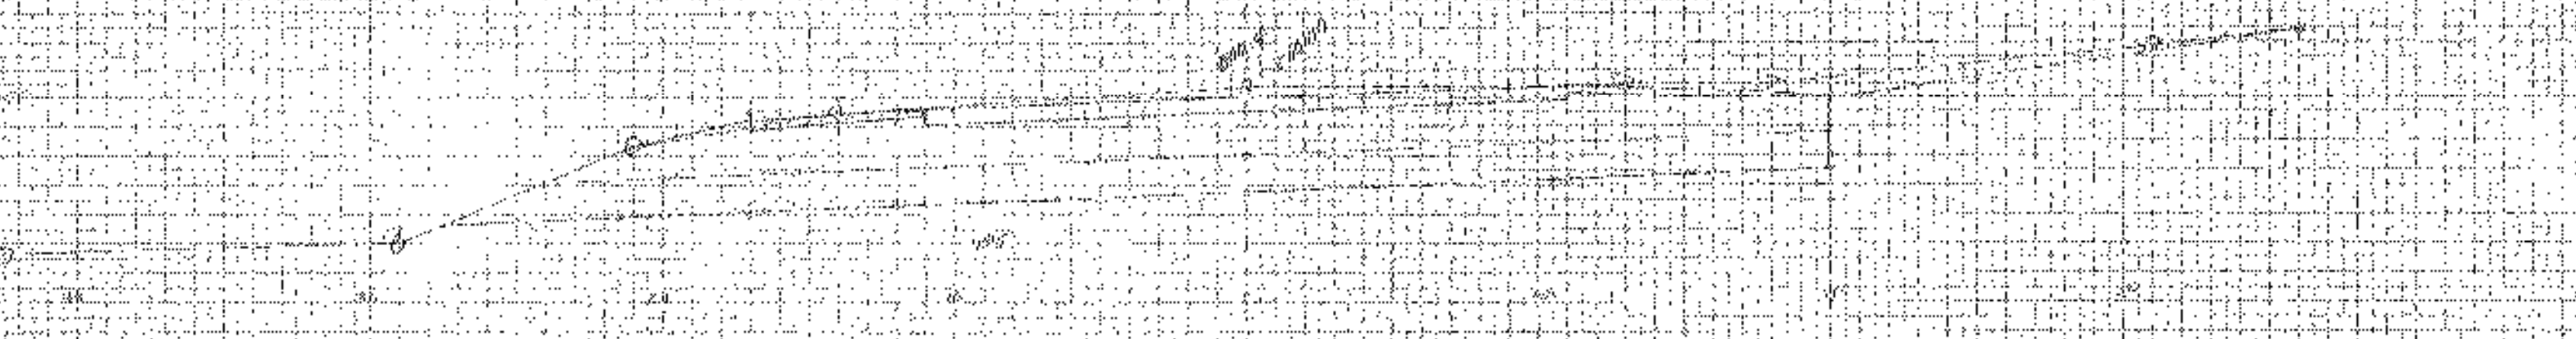

From Data R. 017
 20315 Contour 20000
 20331 Contour 20000
 20325 Contour 20000

From Data R. 017

R. W.