



REV. 74+00

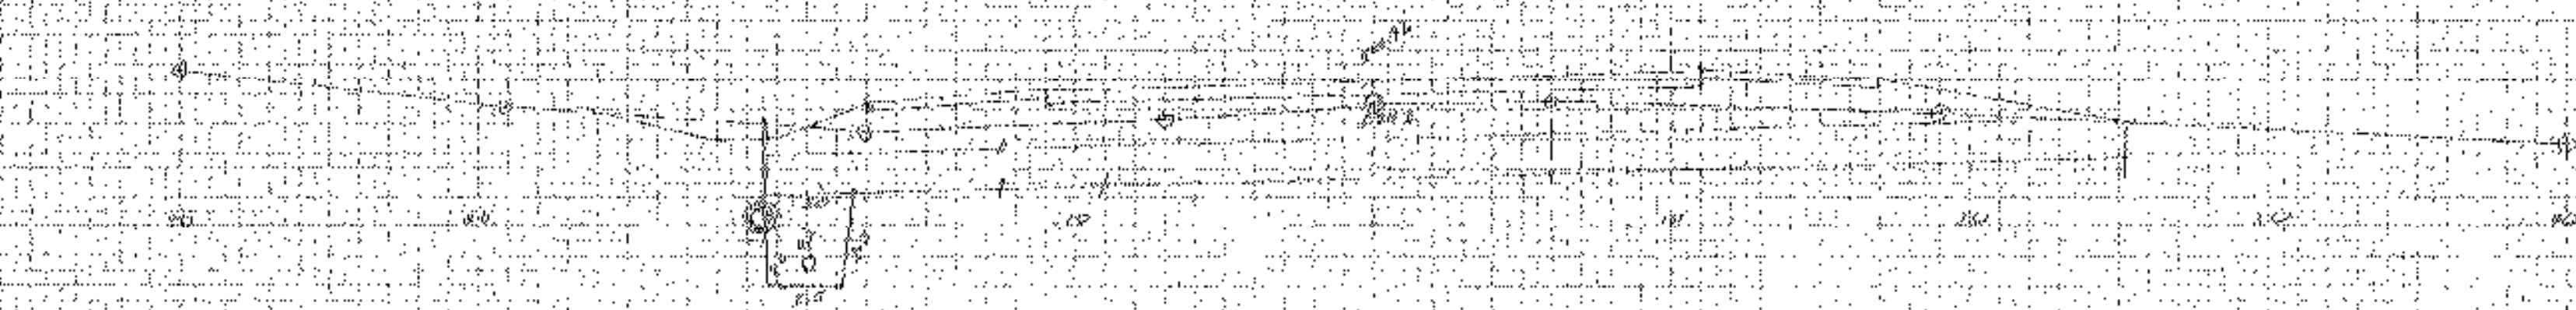


From	To	R. Elev.
20+10	20+20	45.25
20+20	20+30	47.25
20+30	20+40	48.25

REV. 75+50

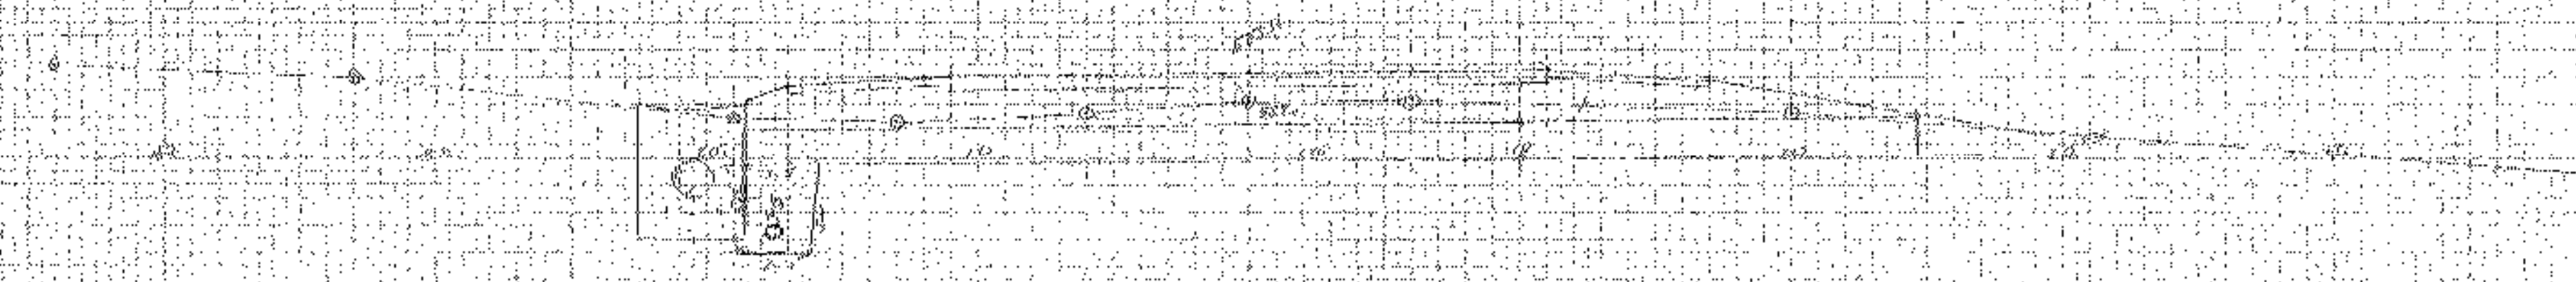


From	To	R. Elev.
20+35	20+45	48.25
20+45	20+55	49.25
20+55	20+65	50.25

REV. 75+00

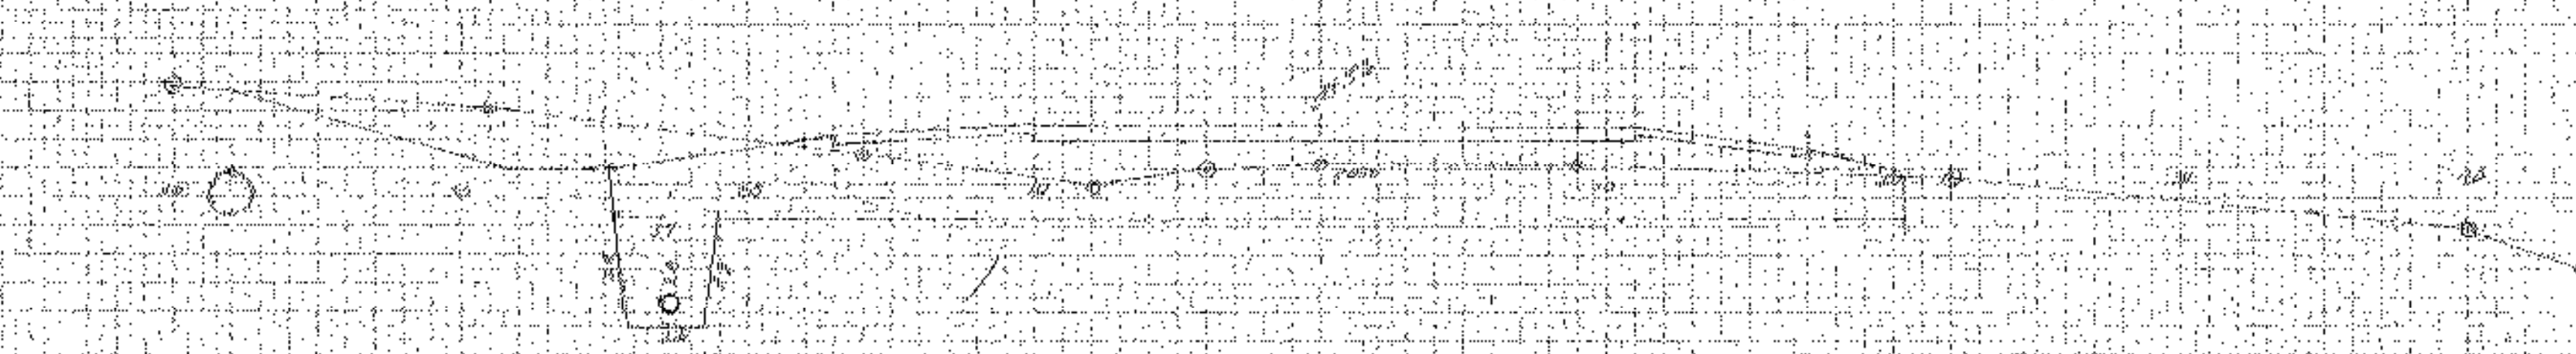

From	To	R. Elev.
20+40	20+50	48.25
20+50	20+60	49.25
20+60	20+70	50.25

REV. 77+50

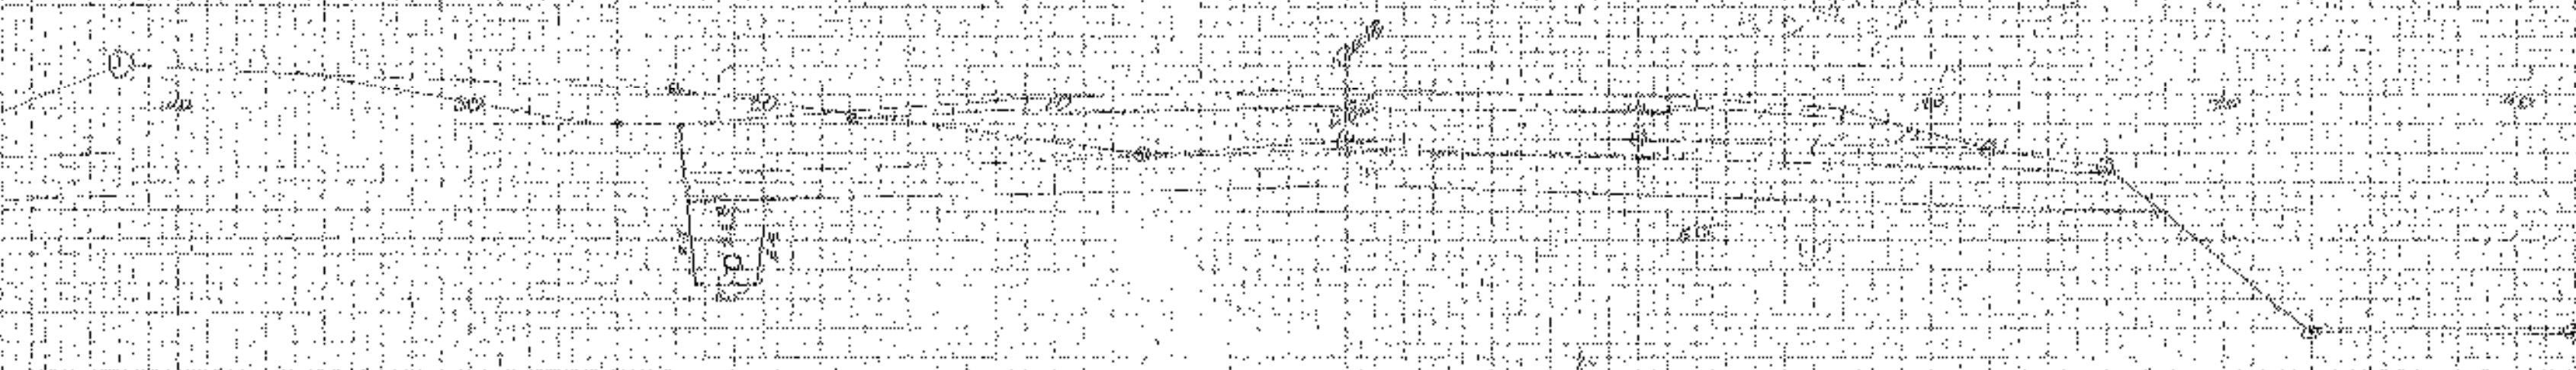

From	To	R. Elev.
20+35	20+45	48.25
20+45	20+55	49.25
20+55	20+65	50.25

Handwritten notes and signatures in the bottom right corner, including a signature that appears to be 'M. J. [unclear]' and some illegible text.