


REV 78100




ITEM Desc. P.Bits
 20.25 Comp. Exc.
 20.20 Sand Removal
 20.15 Backfill (Comp)

REV 77150

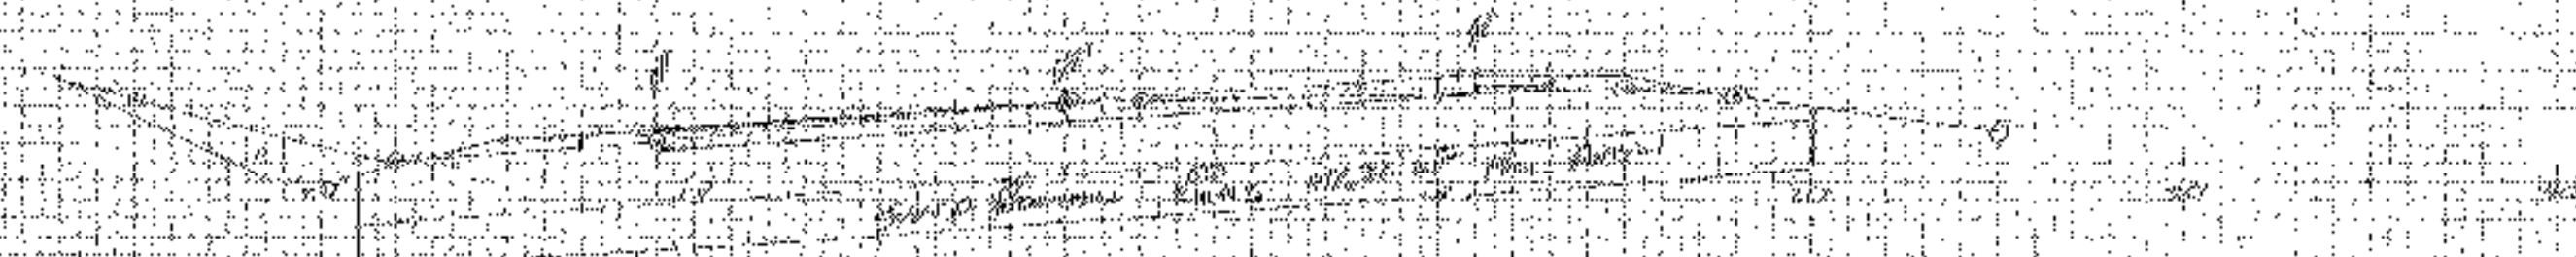


ITEM Desc. P.Bits
 20.30 Comp. Exc.
 20.25 Sand Removal
 20.20 Backfill (Comp)

REV 77100

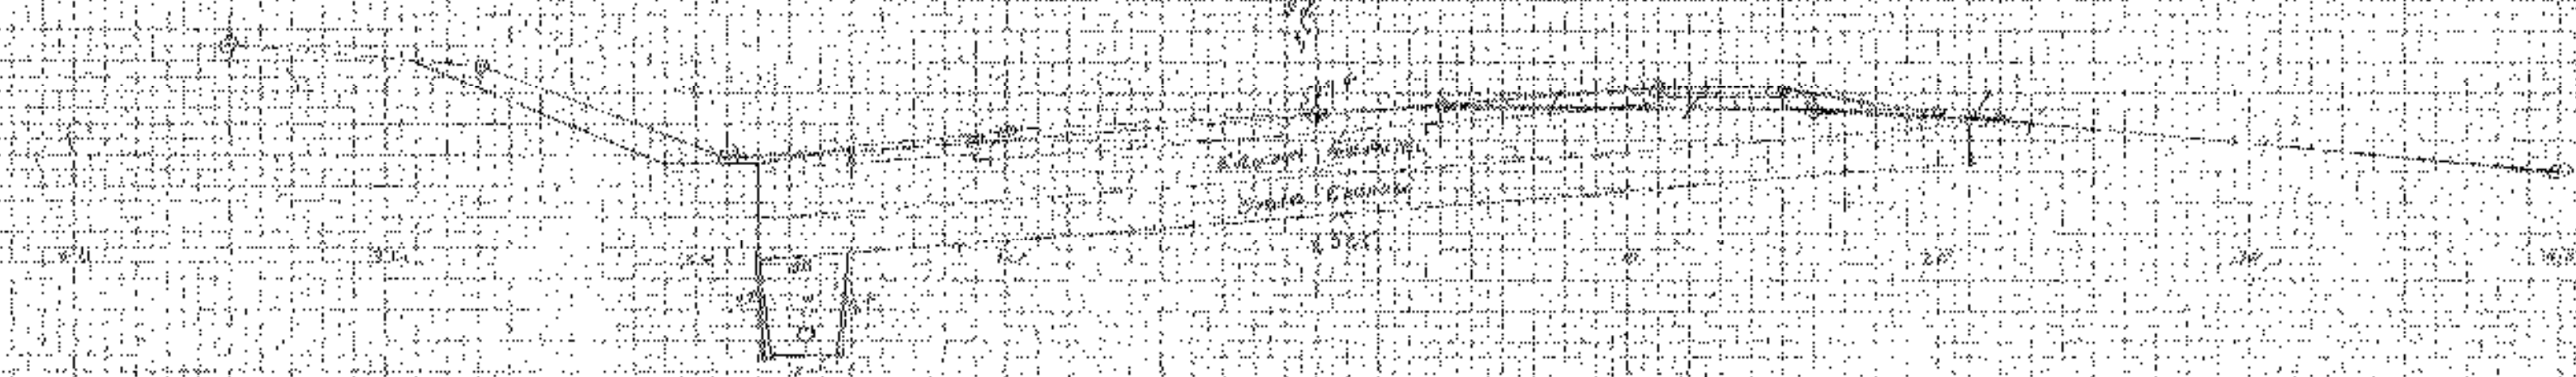

ITEM Desc. P.Bits
 20.35 Comp. Exc.
 20.30 Sand Removal
 20.25 Backfill (Comp)

REV 76150

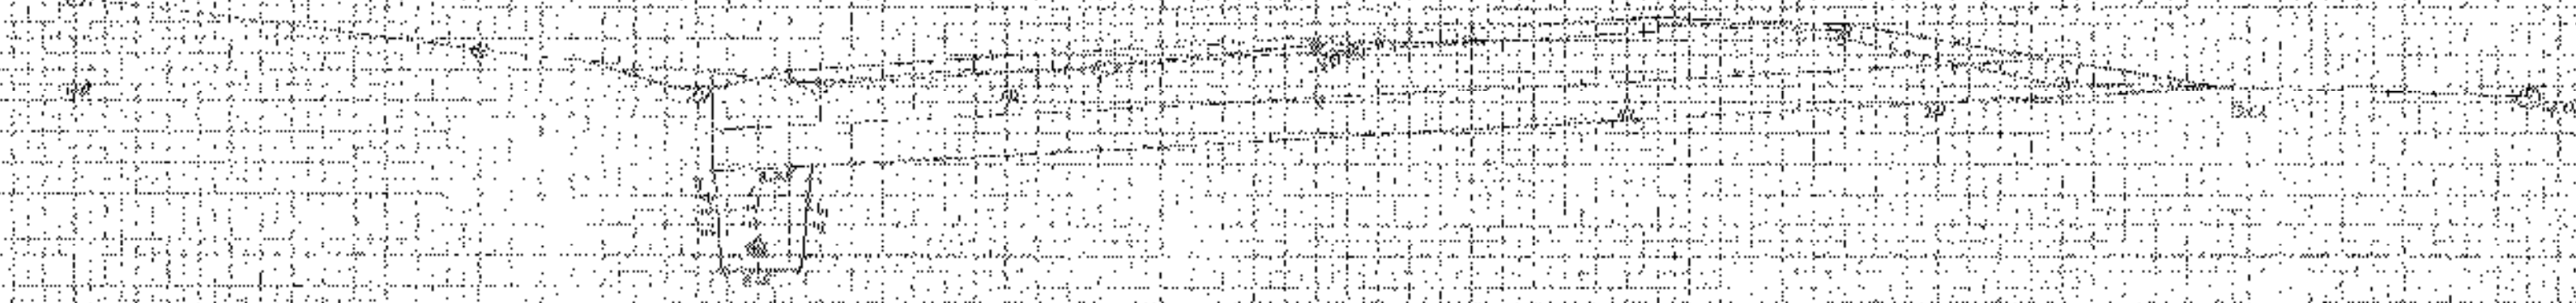

ITEM Desc. P.Bits
 20.40 Comp. Exc.
 20.35 Sand Removal
 20.30 Backfill (Comp)

20.25 Sand Removal
 20.20 Backfill (Comp)