

**END R.O.W. PROJECT**  
**REV. STA. 211+22 80' RT.**

MATCH A TH 2 CURVE # 2 DATA MATCH A

$\Delta = 21^{\circ}49'45''$  LT.  
 $D = 10'$   
 $R = 572.958'$   
 $T = 110.486'$   
 $L = 215.292'$   
 $E = 10.55'$

TH 2 37+88  
 214' LT.

DRILLING AND BL  
 SOLID ROCK SU.  
 TH 2 31+75 ~ 33

GRUBBING MATERIAL  
 2 34+00 LT. ~ 37+25 LT.

ODIFIED ECCENTRIC  
 IER TERRMINAL(MELT)  
 33+25 ~ 33+62.5 LT.  
 36+87.5 ~ 37+25 LT.

EXCAVATION OF SURFACES  
 AND PAVEMENTS  
 ((AREA TO BE TOPSOILED, SEEDED  
 AND MULCHED))  
 OLD TH 2 : SURV. 31+50 ~ 33+75 LT.

CONSTRUCT DRIVE  
 TH 2 34+88 RT. (GRAVEL)  
 TH 2 36+50 RT. (GRAVEL)



DRIVE GATE FOR WOVEN WIRE FENCE  
 TH 2 34+88 RT. (16' WIDE)  
 (2 - 8' GATES W/ OPENING IN MIDDLE)

REMOVAL AND DISPOSAL OF  
 GUARD RAIL  
 TH 2 31+50 ~ 32+54 LT.  
 TH 2 33+00 ~ 37+07 LT.

REMOVAL OF EXISTING FENCE  
 TH 2 31+50 ~ 35+00 RT.

STEEL BEAM GUARD RAIL  
 TH 2 33+62.5 ~ 36+87.5 LT.

**FOR R.O.W.  
 USE ONLY**

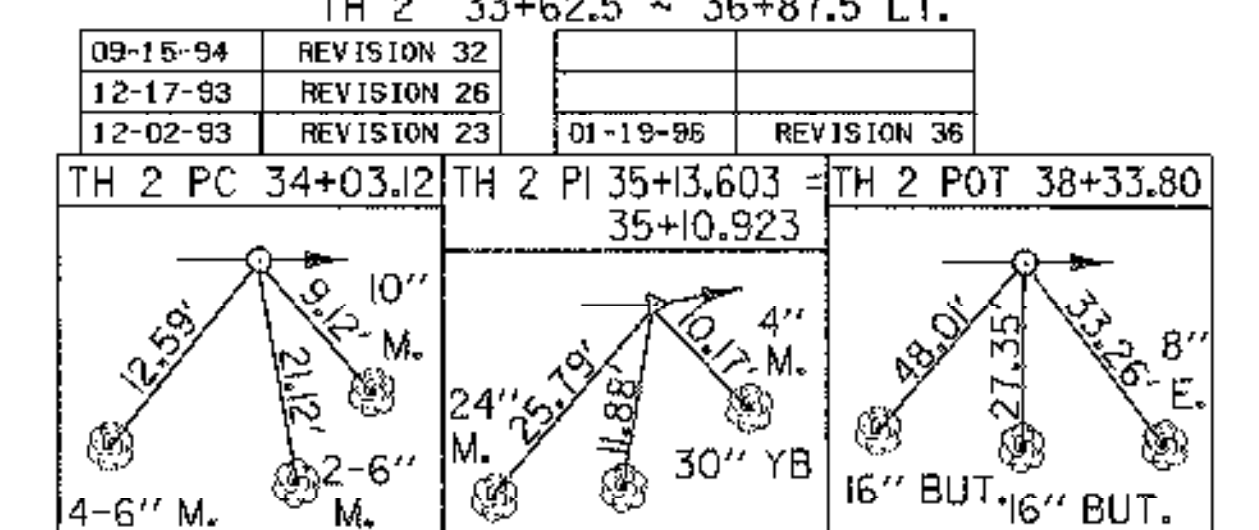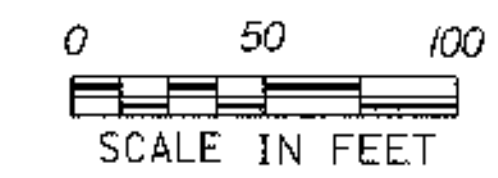


FOR DRAINAGE NOTES SEE  
 ROW SHEET 18 OF 20 SHEETS

END RELINQUISHMENT NO. II  
 STA. T.H. 2 37+68 2' RT.

DATUM  
 VERTICAL NGVD 1929  
 HORIZONTAL N/A

○ DENOTES REMOVAL OF TREE OR STUMP

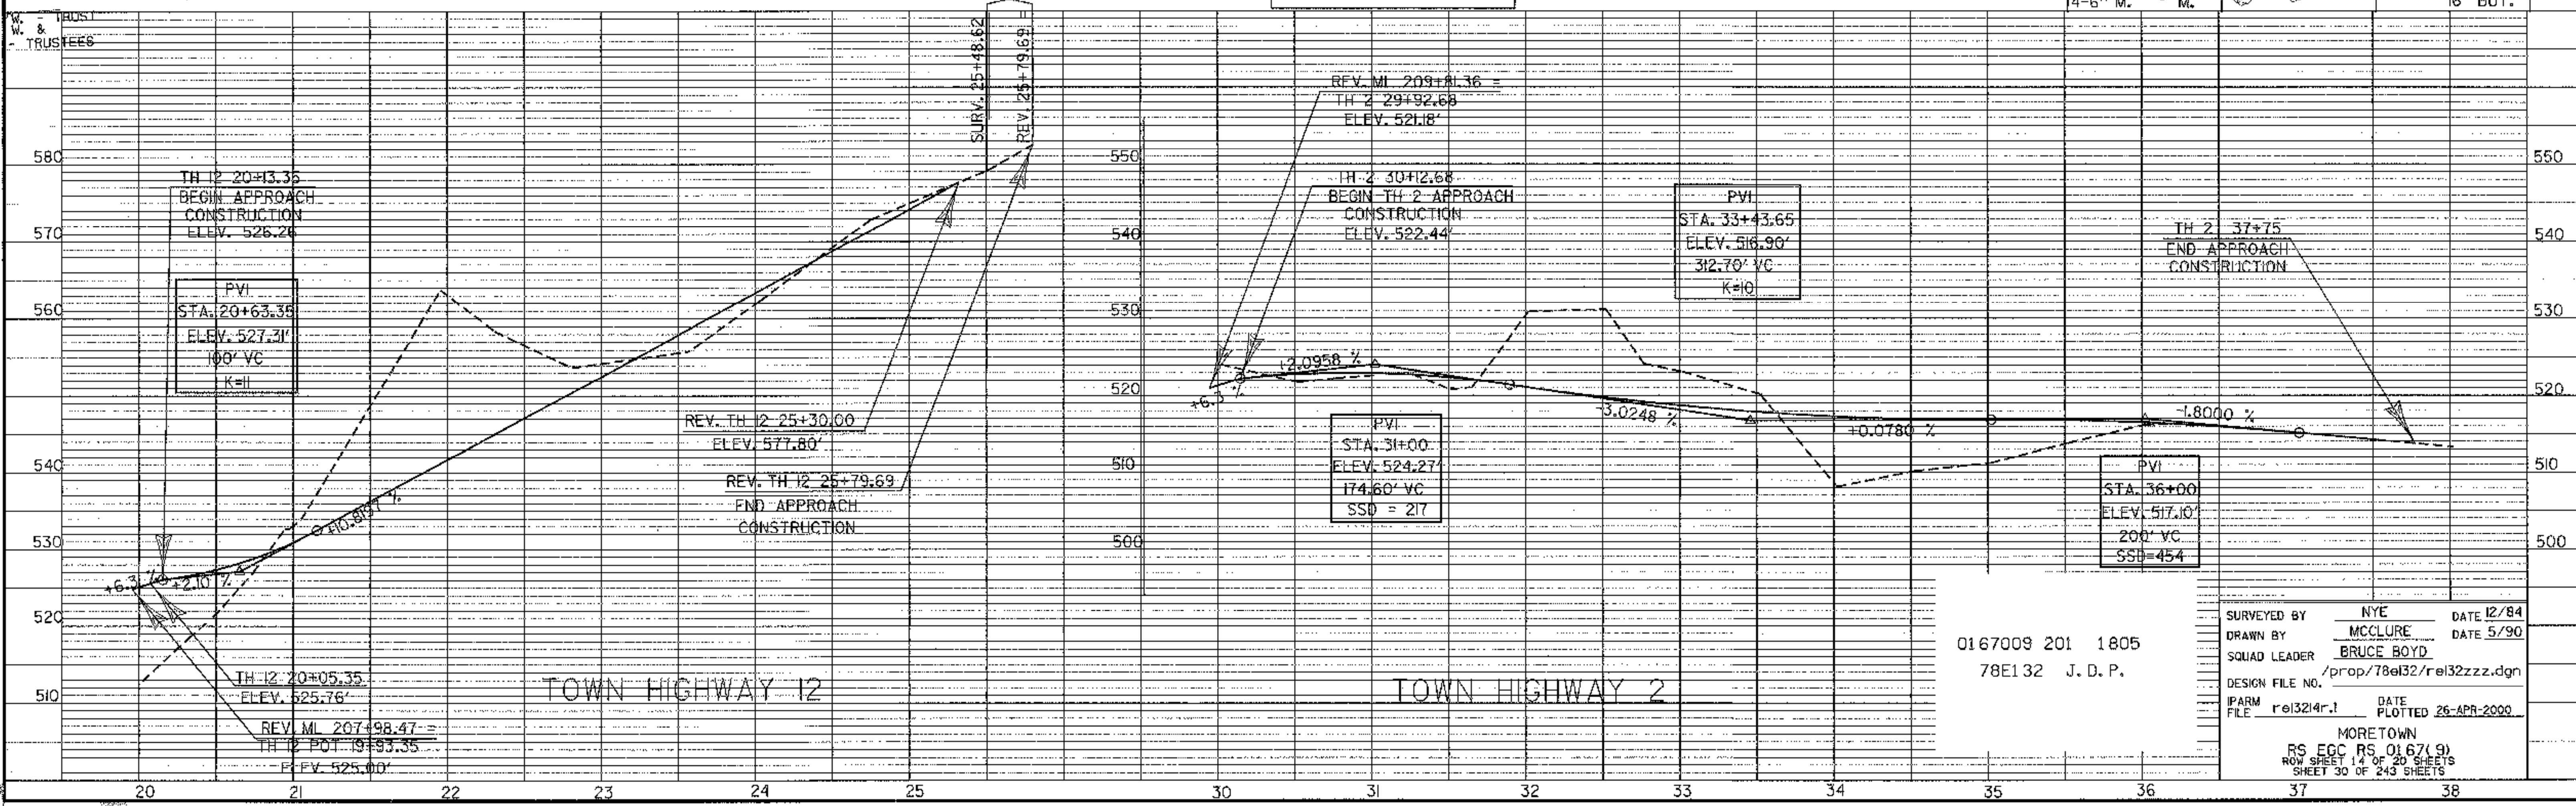

0167009 201 1805  
 78E132 J. D. P.

SURVEYED BY NYE DATE 12/84  
 DRAWN BY MCCLURE DATE 5/90  
 SQUAD LEADER BRUCE BOYD  
 DESIGN FILE NO. /prop/78e132/rel32zzz.dgn  
 IPARM FILE rel324r.1 DATE PLOTTED 26-APR-2000

MORETOWN  
 RS EGC RS 0167(9)  
 ROW SHEET 14 OF 20 SHEETS  
 SHEET 30 OF 243 SHEETS