
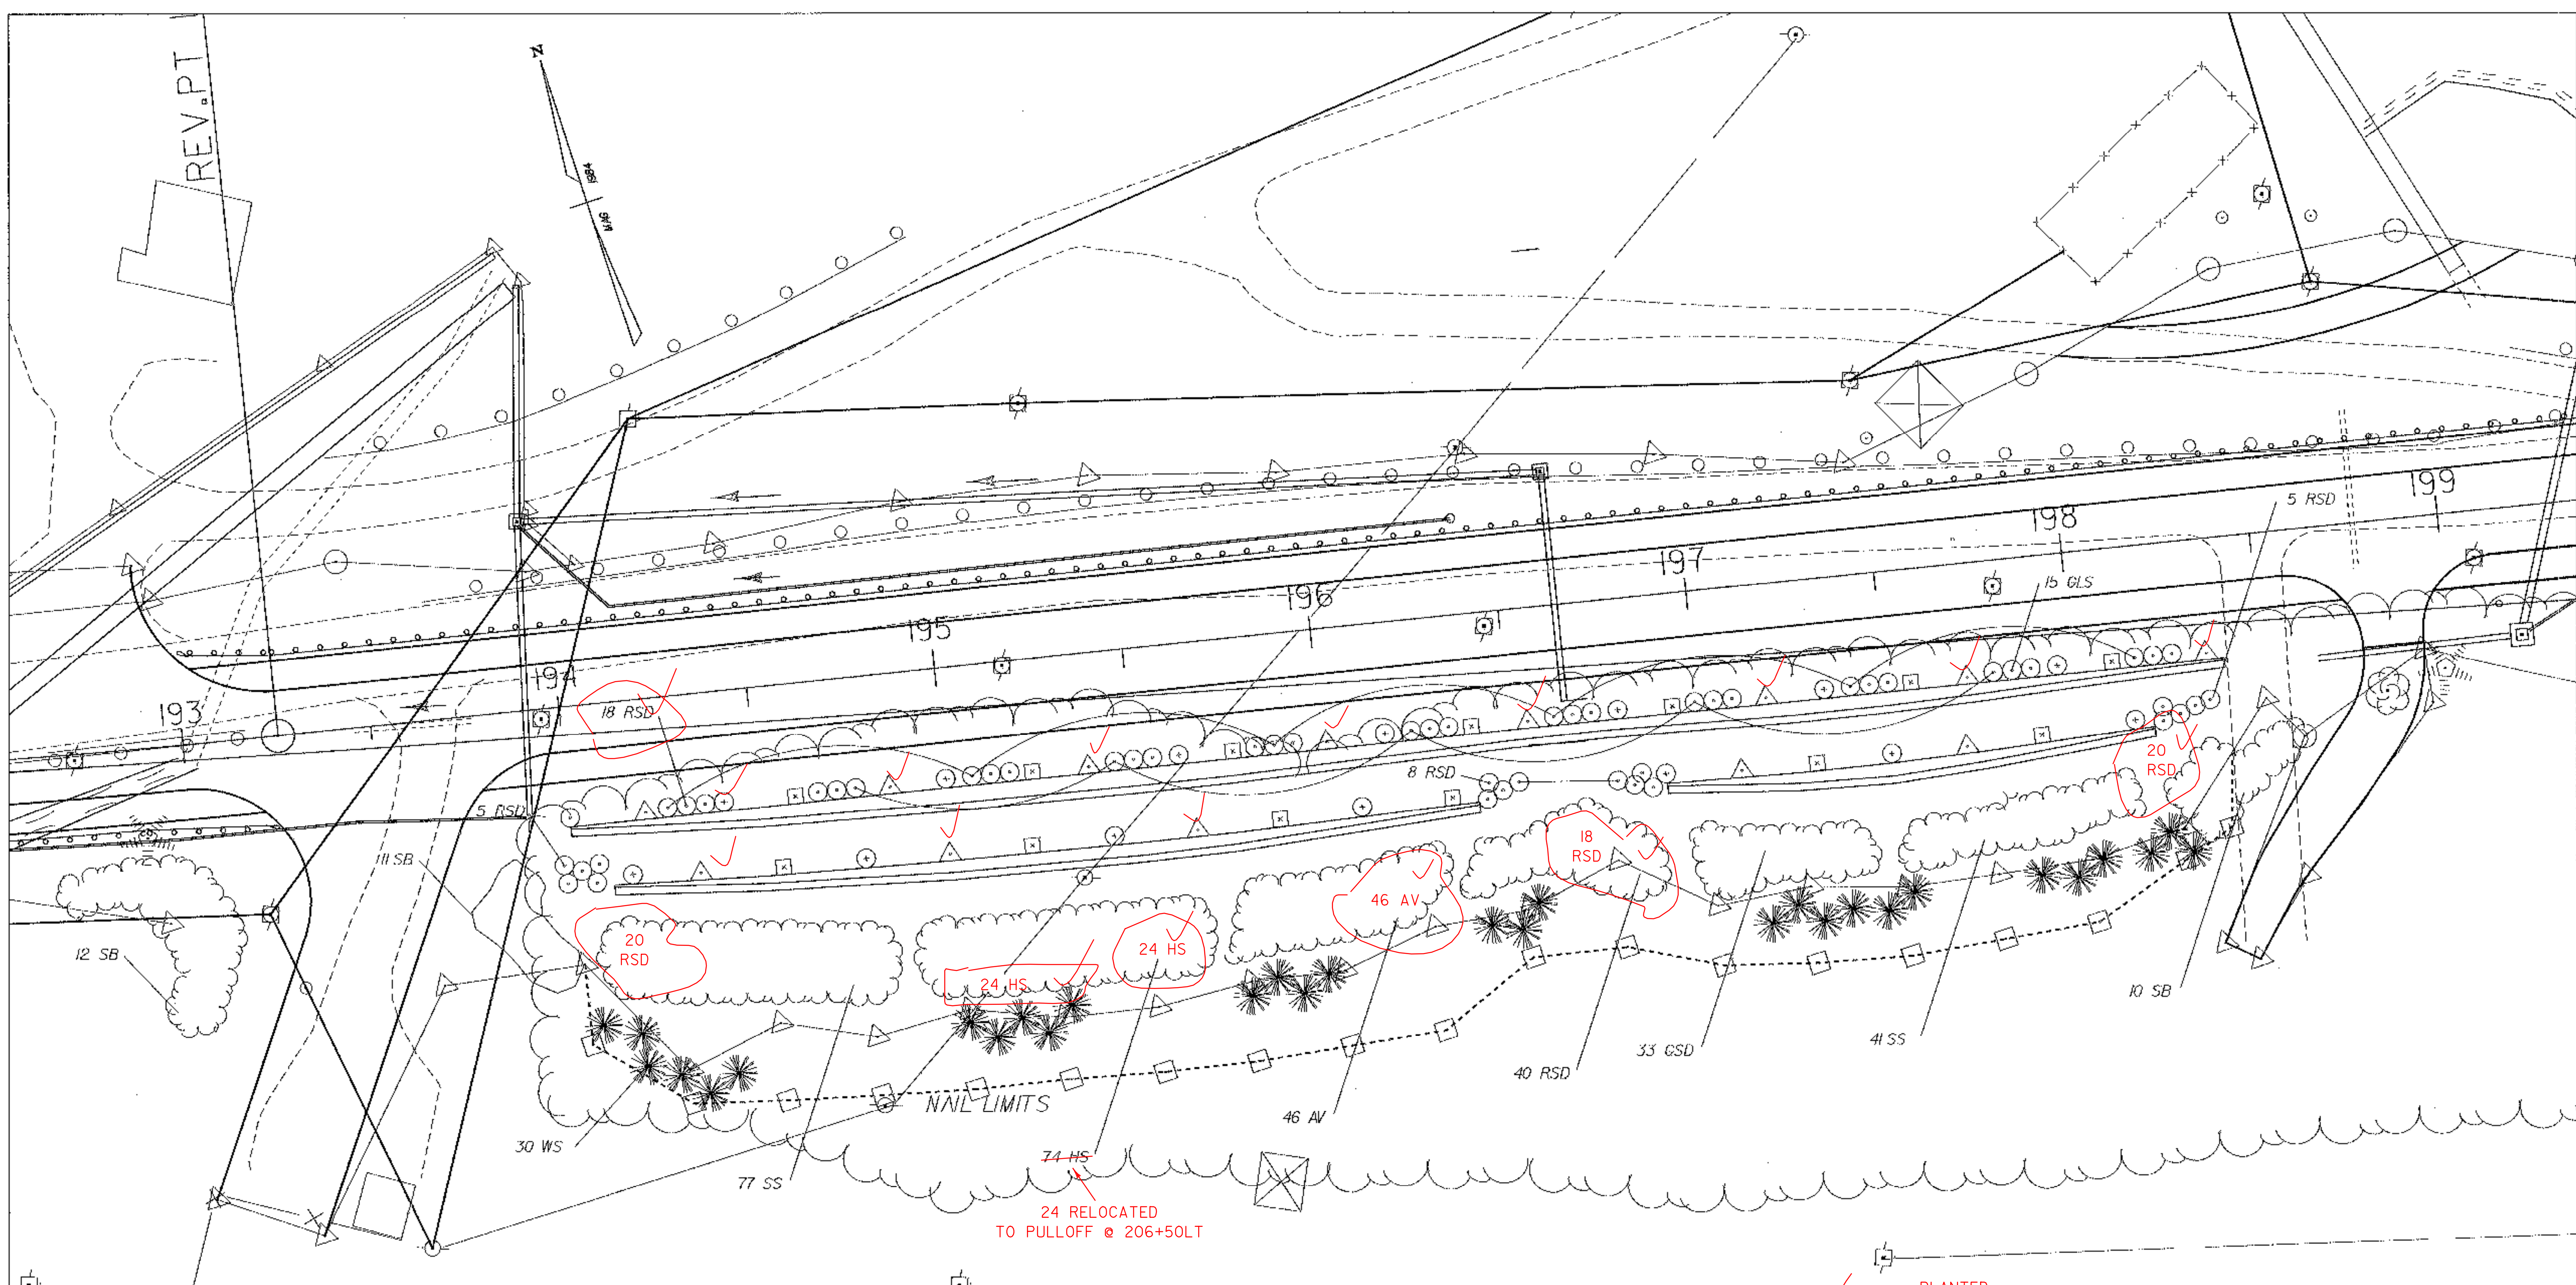



REV. PT

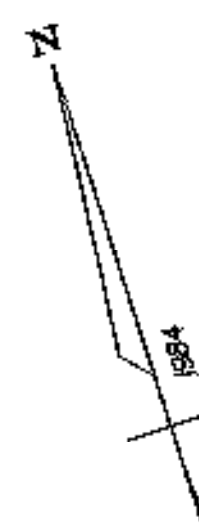

LEGEND

- NEW IREL
- NEW SHRUB PLANTING AREA
- NEW SHRUB
- NEW BITTERSWEET VINE
- NEW WOODBINE/VIRGINIA CREEPER VINE
- NEW VALIENT GRAPE VINE OR SUMMER GRAPE VINE

✓ = PLANTED
STW 5-28-02

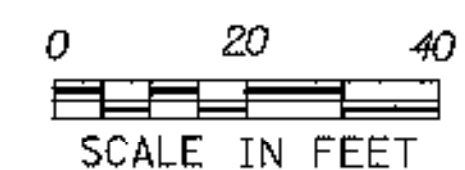

LANDSCAPE PLAN			
SURVEYED BY	K. RYAN	DATE	2/00
DRAWN BY	DELLA SANTA	DATE	2/00
SQUAD LEADER	DELLA SANTA		
DESIGN FILE NO.	/S00B/84E058/DE058.DGN		
PARM FILE	DE132L2-3	DATE	17-FEB-2000
PROJ. NAME	MORETOWN		
PROJ. NO.	RSEGC-RS 0167(9)		
SHEET	70	OF	243 SHEETS

DATUM
 VERTICAL NGVD 1929
 HORIZONTAL N/A