


31+00 ~ 32+54 LT
 Removal and Disposal
 of Guard Rail

30+75 LT
 BEGIN EXCAVATION OF
 SURFACES AND PAVEMENTS
 (AREA TO BE TOPSOILED,
 SEEDED AND MULCHED)

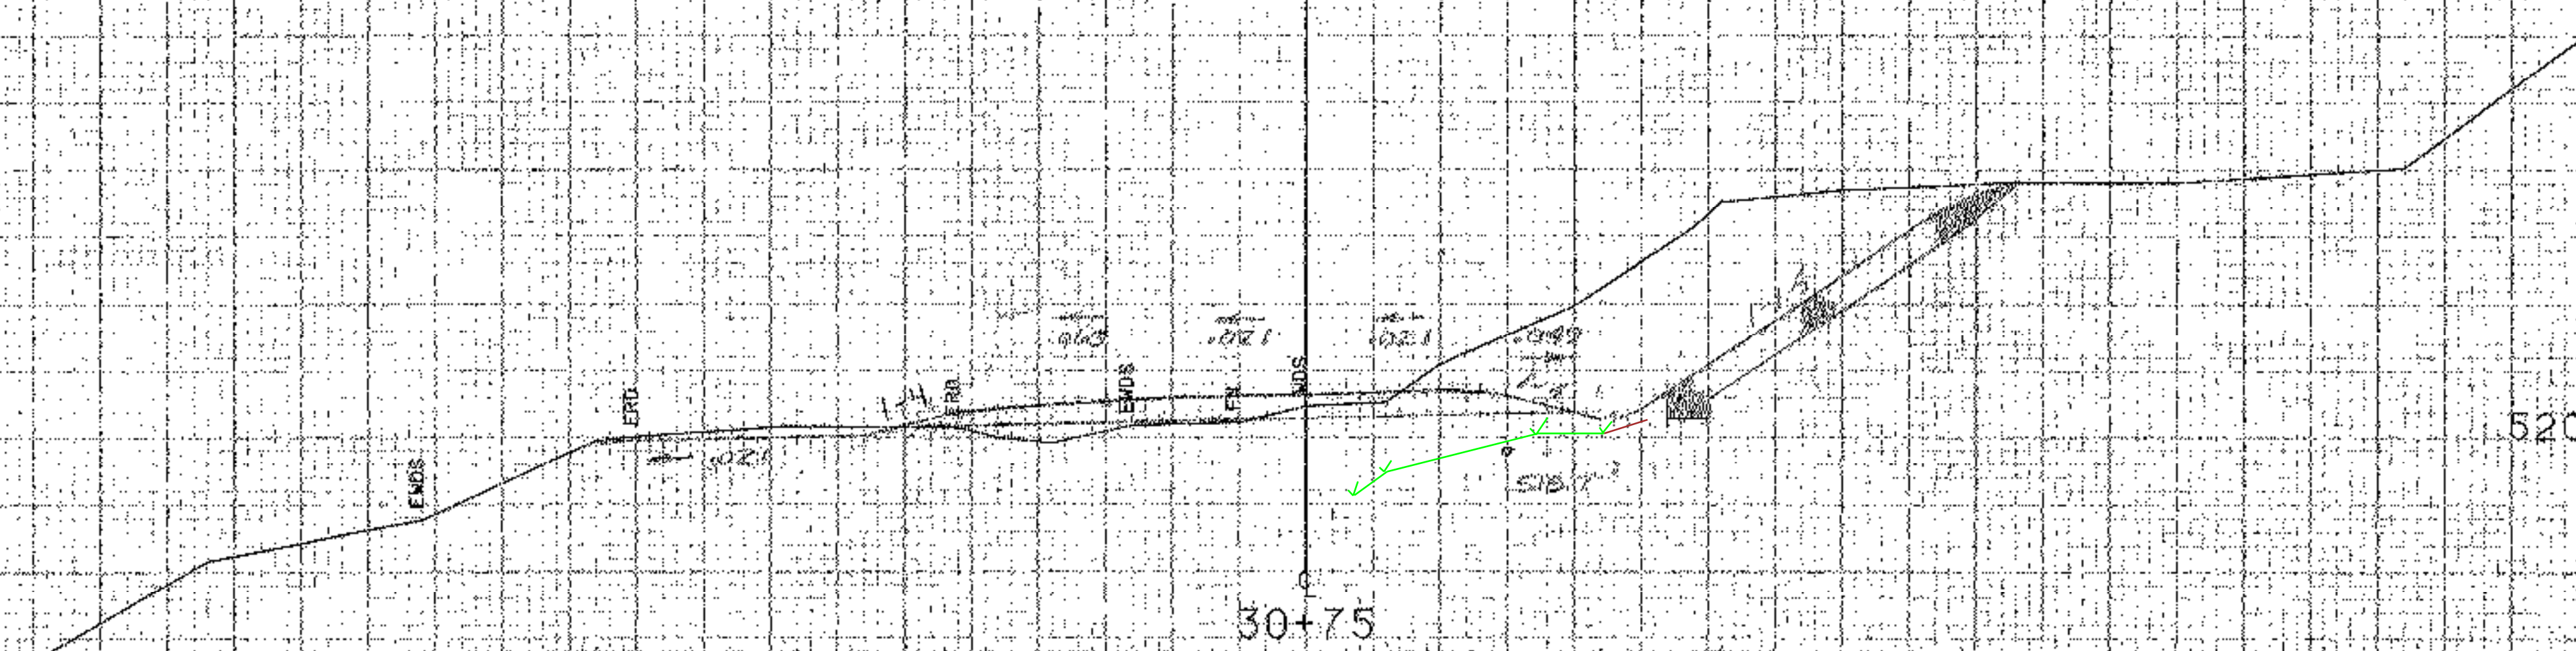

FROM STA.	30+75	TO STA.	31+00
PROJECT NAME	MORERTOWN		TH2
NO.	RS0167191	DATE	PLOTTED 06/09/86
SURVEYED BY	NYE		JAN 1985
SHEET	1/2	OF	23 SHEETS

SCALE 1" = 10 FEET