


NOTE : DASHED SIGNS AND POSTS ARE EXISTING

NOTES:  
-EXISTING SIGN INVENTORY AS OF 10/11/95.

**LEGEND FOR SIGNS**

N = NEW SIGNS  
R = REMOVE SIGNS  
S = SALVAGE SIGNS

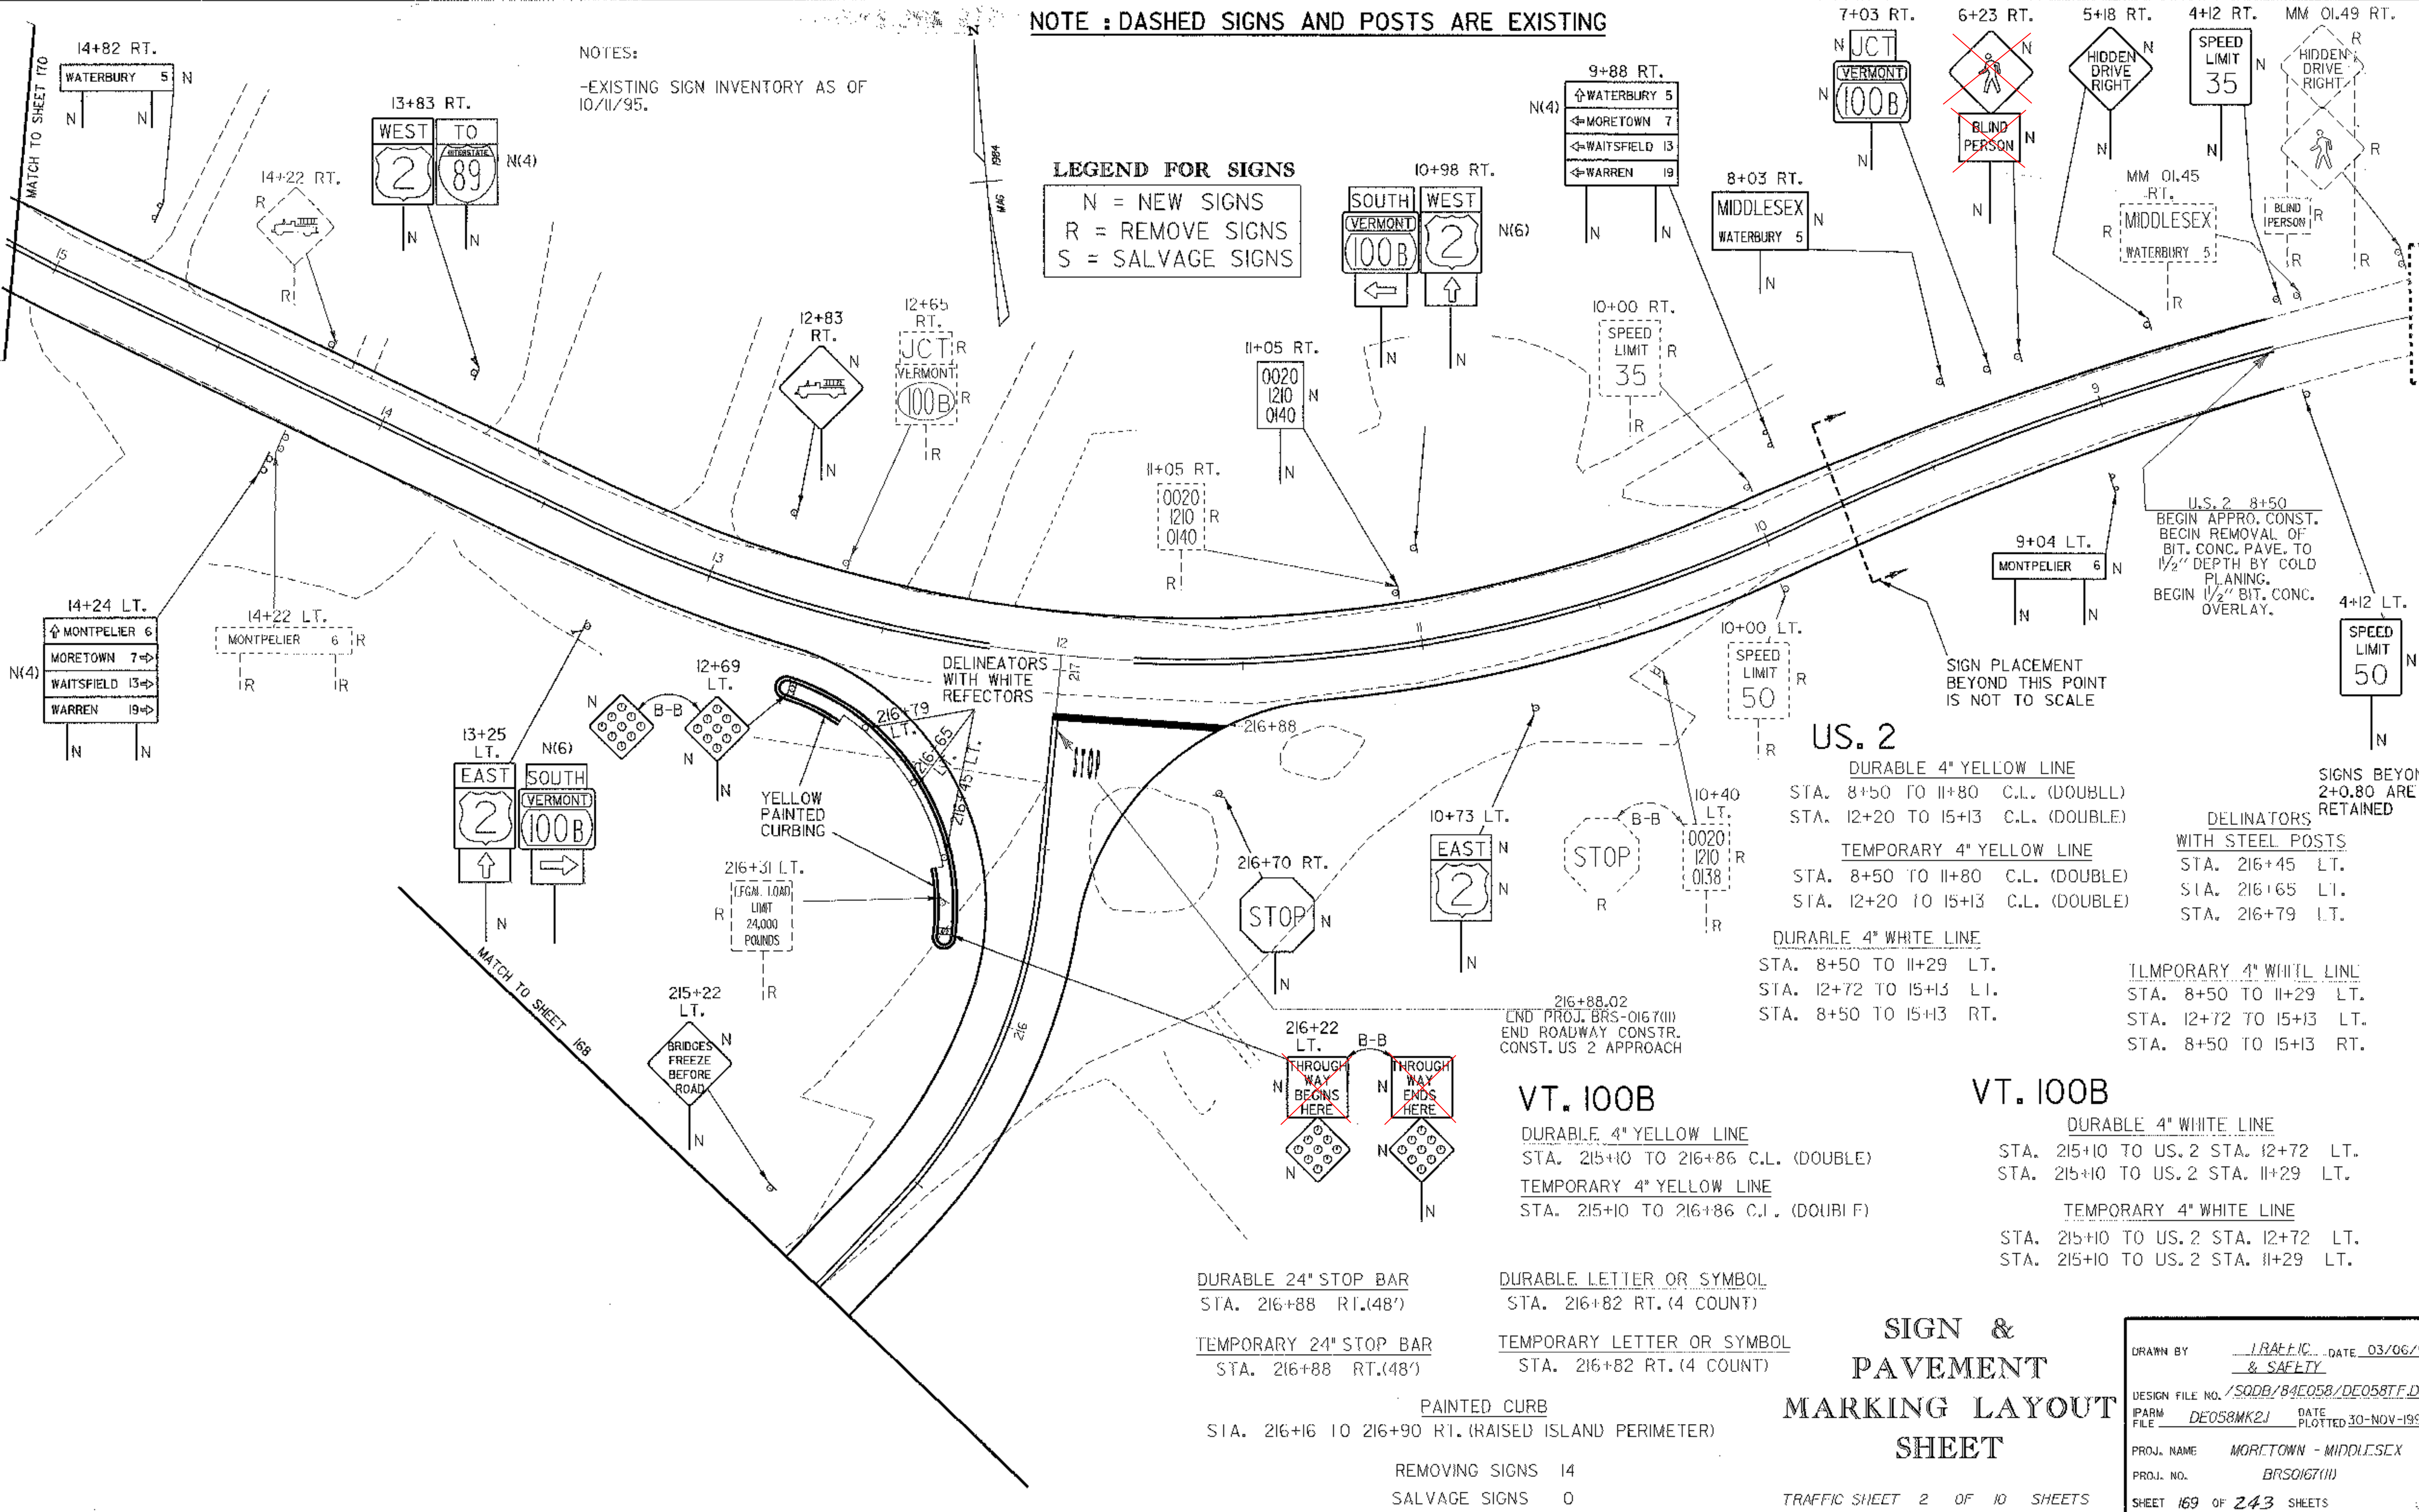

**US. 2**

DURABLE 4" YELLOW LINE  
STA. 8+50 TO 11+80 C.L. (DOUBL)  
STA. 12+20 TO 15+13 C.L. (DOUBLE)

TEMPORARY 4" YELLOW LINE  
STA. 8+50 TO 11+80 C.L. (DOUBLE)  
STA. 12+20 TO 15+13 C.L. (DOUBLE)

DURABLE 4" WHITE LINE  
STA. 8+50 TO 11+29 LT.  
STA. 12+72 TO 15+13 LT.  
STA. 8+50 TO 15+13 RT.

DELINATORS WITH STEEL POSTS  
STA. 216+45 LT.  
STA. 216+65 LT.  
STA. 216+79 LT.

TEMPORARY 4" WHITE LINE  
STA. 8+50 TO 11+29 LT.  
STA. 12+72 TO 15+13 LT.  
STA. 8+50 TO 15+13 RT.

**VT. 100B**

DURABLE 4" YELLOW LINE  
STA. 215+10 TO 216+86 C.L. (DOUBLE)

TEMPORARY 4" YELLOW LINE  
STA. 215+10 TO 216+86 C.L. (DOUBLE)

**VT. 100B**

DURABLE 4" WHITE LINE  
STA. 215+10 TO US. 2 STA. 12+72 LT.  
STA. 215+10 TO US. 2 STA. 11+29 LT.

TEMPORARY 4" WHITE LINE  
STA. 215+10 TO US. 2 STA. 12+72 LT.  
STA. 215+10 TO US. 2 STA. 11+29 LT.

DURABLE 24" STOP BAR  
STA. 216+88 RT.(48')

TEMPORARY 24" STOP BAR  
STA. 216+88 RT.(48')

PAINTED CURB  
STA. 216+16 TO 216+90 RT.(RAISED ISLAND PERIMETER)

REMOVING SIGNS 14  
SALVAGE SIGNS 0

**SIGN & PAVEMENT MARKING LAYOUT SHEET**

TRAFFIC SHEET 2 OF 10 SHEETS

DRAWN BY TRAFFIC DATE 03/06/95  
& SAFETY

DESIGN FILE NO. 1/SQDB/84E058/DE058TF.DGN  
IPARM FILE DE058MK2J DATE PLOTTED 30-NOV-1999

PROJ. NAME MORETOWN - MIDDLESEX  
PROJ. NO. BR50167(11)  
SHEET 169 OF 243 SHEETS