


SURV. CURVE #4	REV. CURVE #4
$\Delta = 67^{\circ}13'03''\text{LT}$	$\Delta = 71^{\circ}28'02''$
D = 9'	D = 8'30'
R = 636.62	R = 674.07
T = 423.11	T = 484.97
L = 746.86	L = 840.79
E = 127.78	E = 156.33
FULL BANK = 0.063 FT / FT	

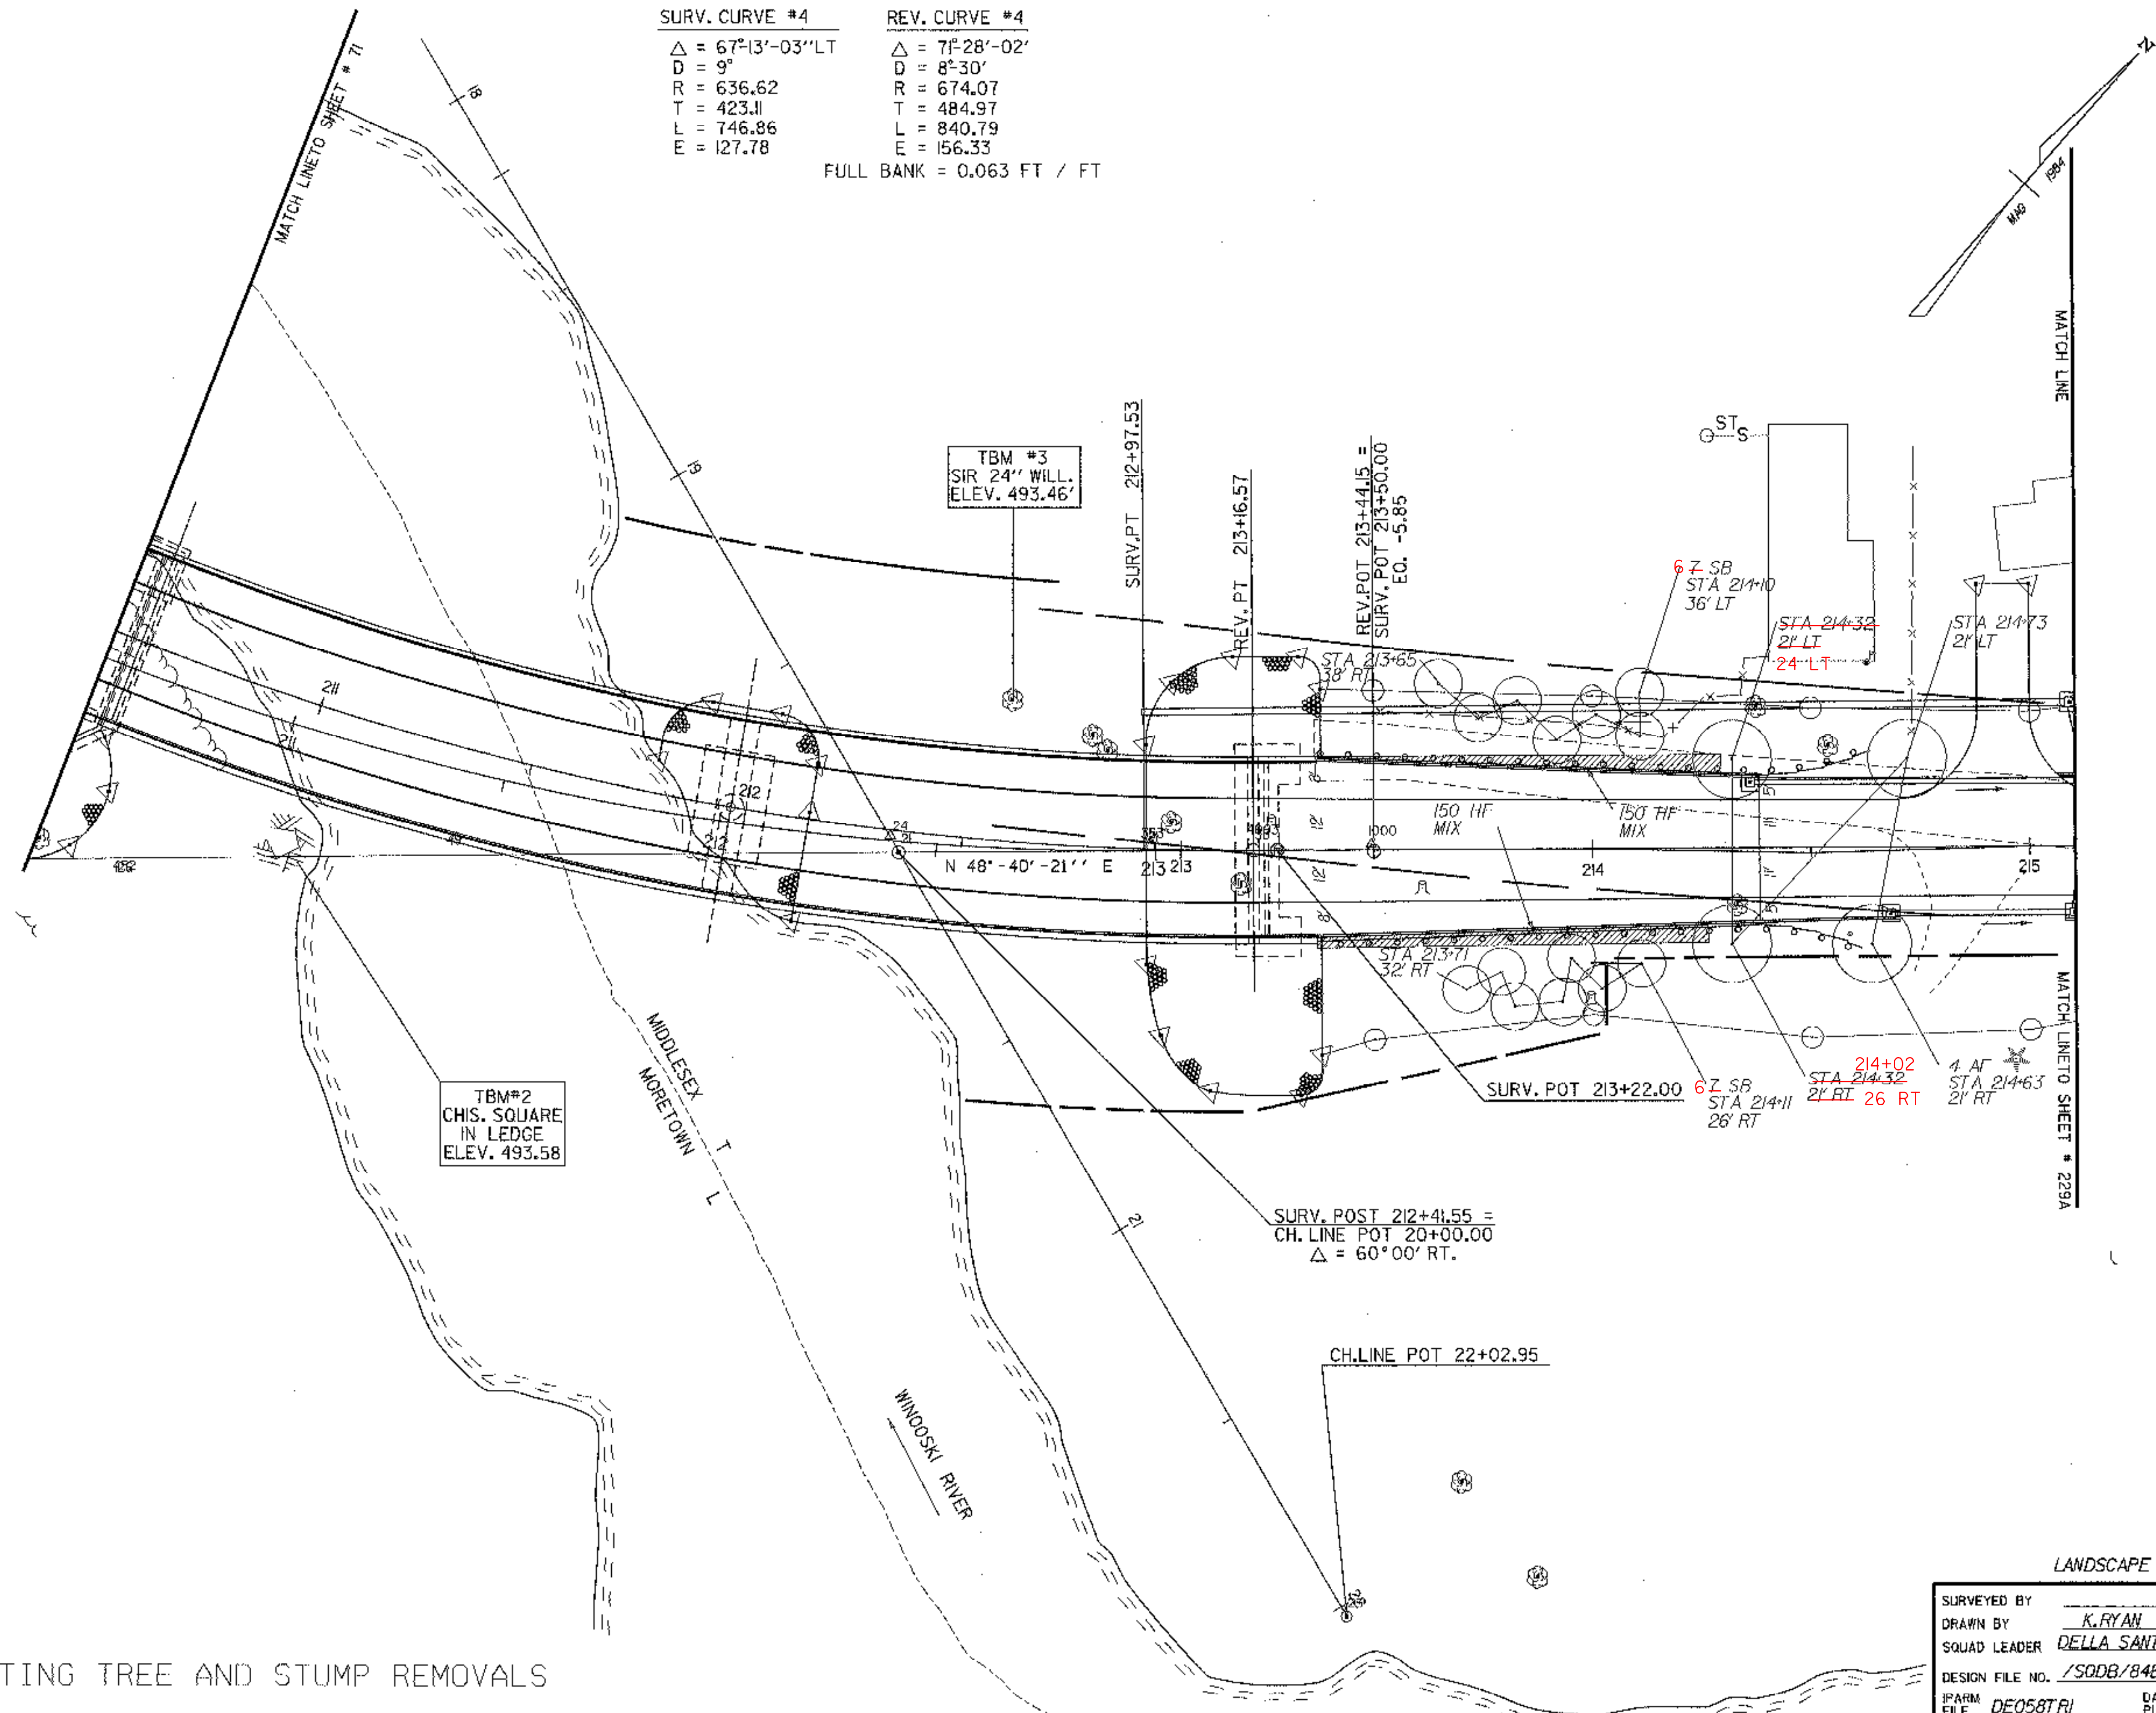

LEGEND

- NEW TREE
- NEW SHRUB
- PERENNIAL PLANTING AREA

NOTE: SEE LAYOUT SHEETS FOR EXISTING TREE AND STUMP REMOVALS

DATUM	
VERTICAL	NGVD 1929
HORIZONTAL	N/A



LANDSCAPE PLAN	
SURVEYED BY	DATE
DRAWN BY <u>K. RYAN</u>	DATE <u>2/00</u>
SQUAD LEADER <u>DELLA SANTA</u>	
DESIGN FILE NO. <u>/SODB/84E058/DE058.DGN</u>	
IFARM FILE <u>DE058TRI</u>	DATE PLOTTED <u>17-FEB-2000</u>
PROJ. NAME <u>MORETOWN - MIDDLESEX</u>	
PROJ. NO. <u>BR50167(11)</u>	
SHEET 229 OF 243 SHEETS	