
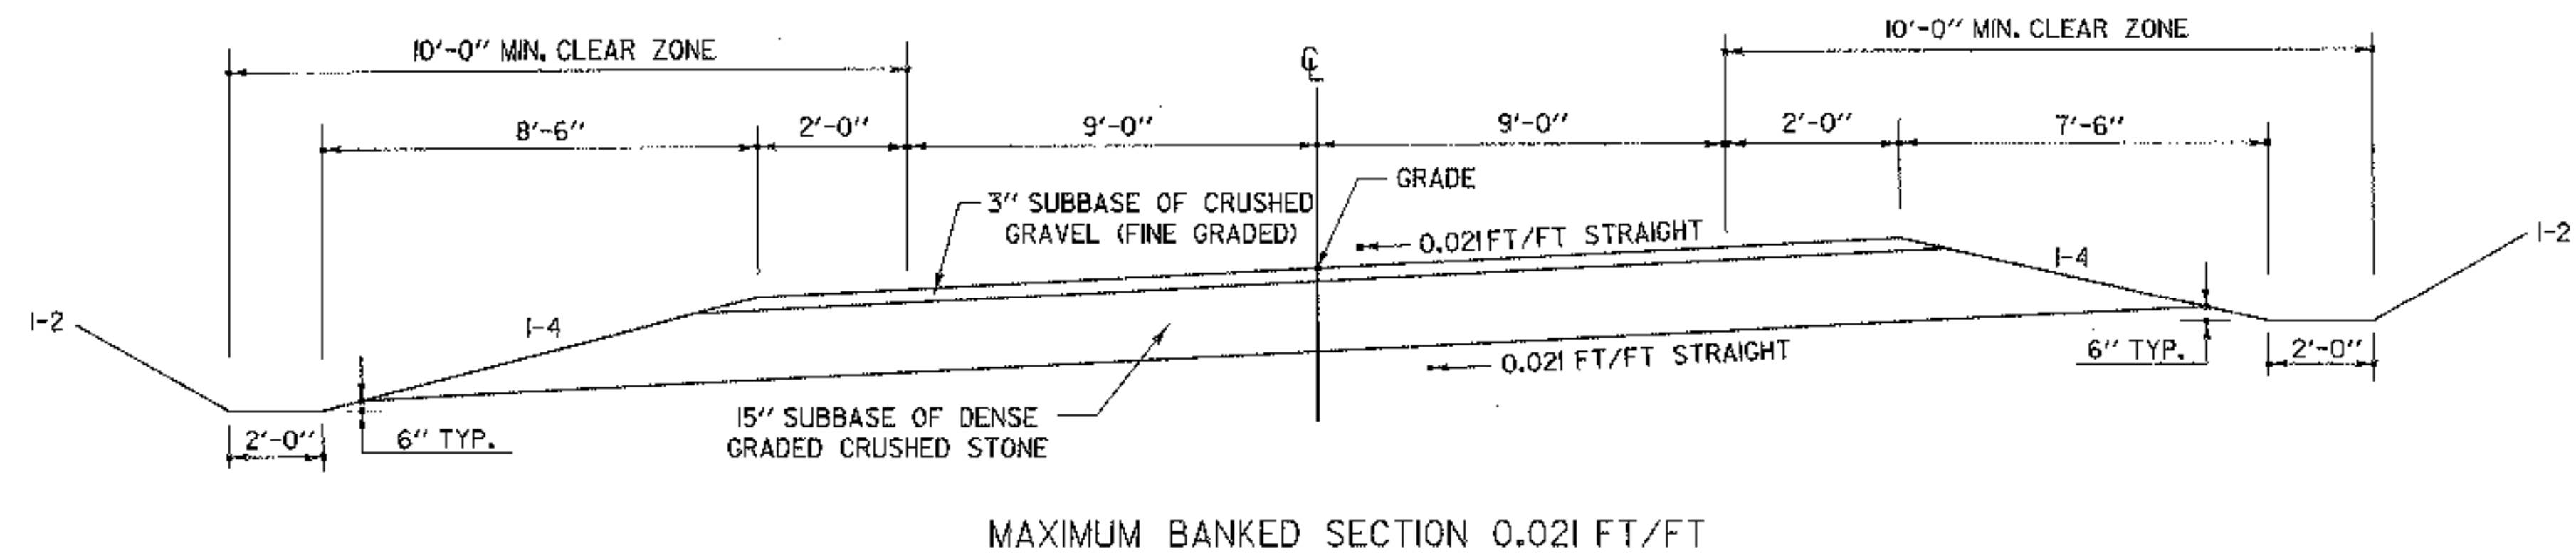
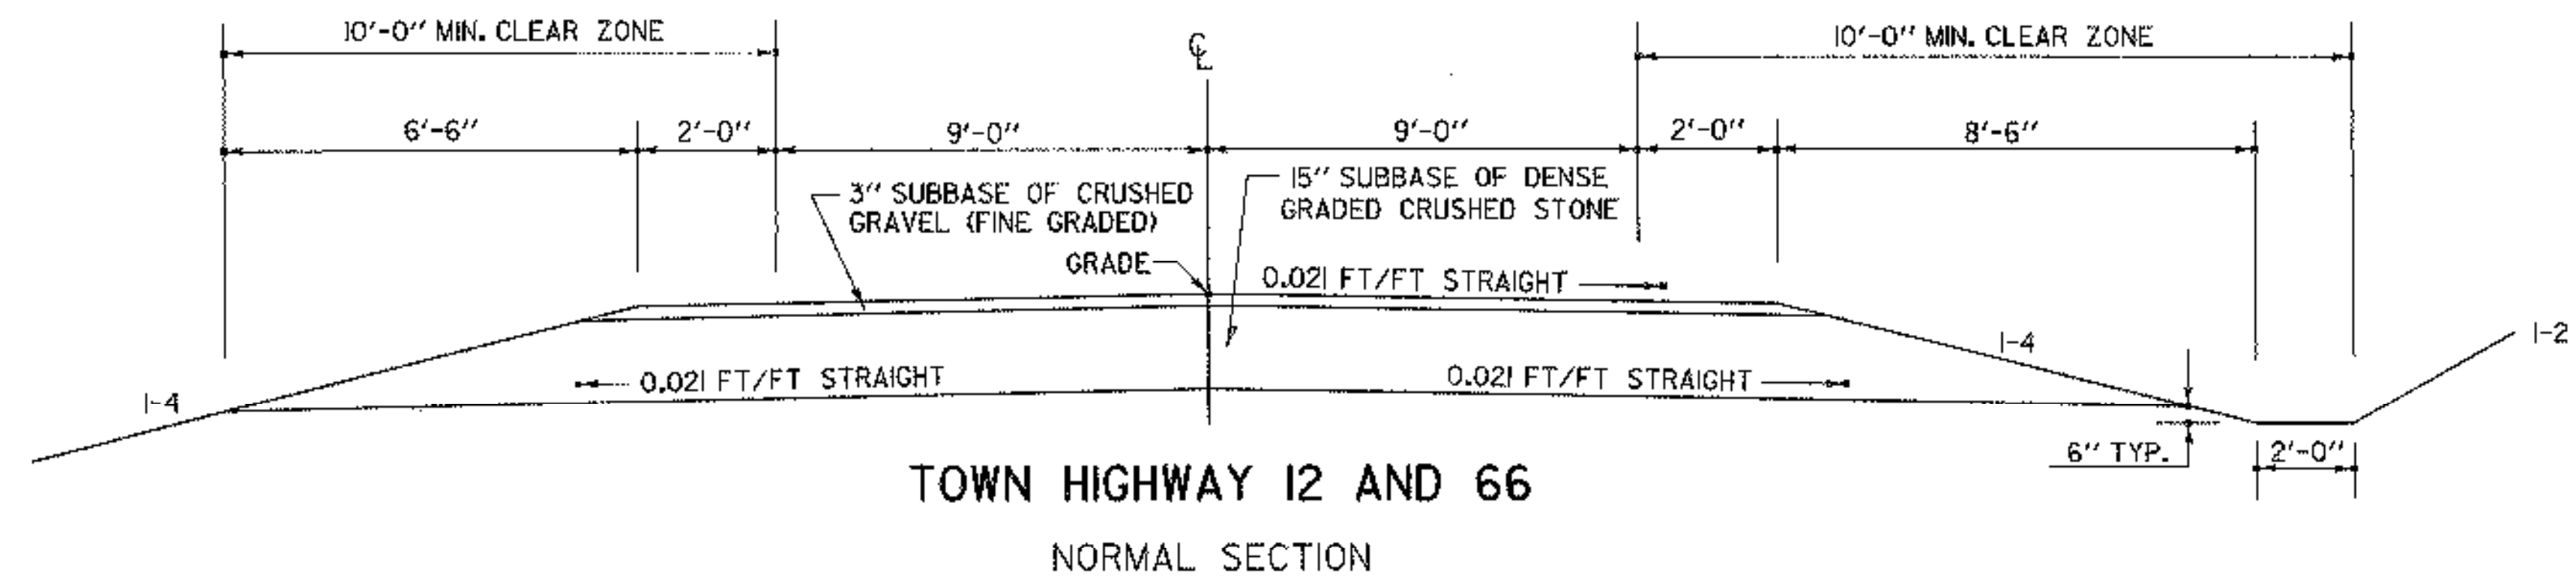
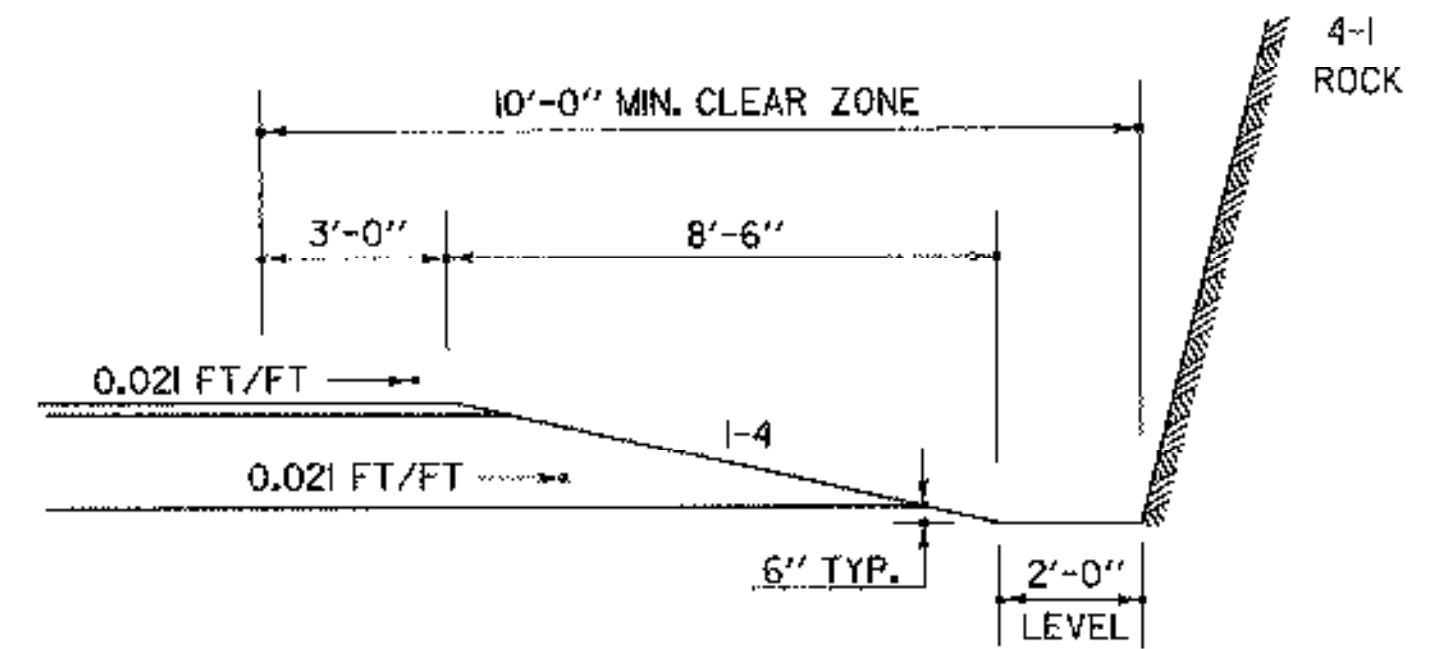


TOWN HIGHWAY TYPICAL SECTIONS

TYPE 3
2" BITUMINOUS CONCRETE PAVEMENT

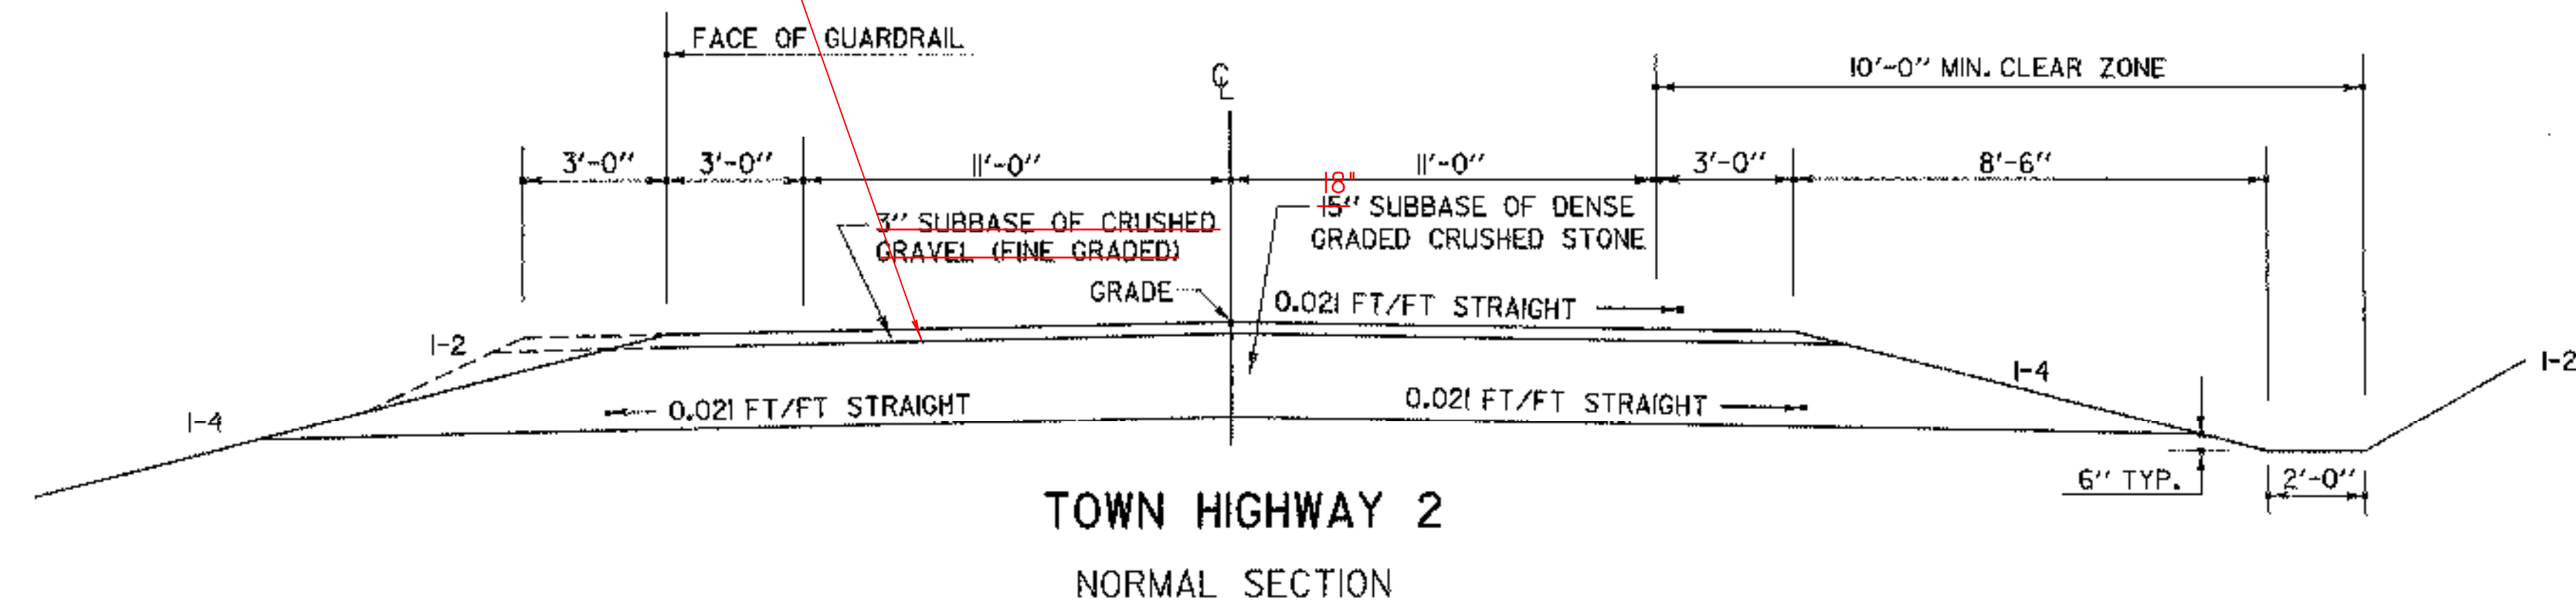

FOR GENERAL NOTES:
SEE SHEET 9

DATUM	
VERTICAL	
HORIZONTAL	

NOT TO SCALE

SURVEYED BY	NYE	DATE	3/85
DRAWN BY	SQUADB	DATE	11/93 RE
SQUAD LEADER	DELLA SANTA		
DESIGN FILE NO.	/SQDB/84E058/DE058FRM.DGN		
FILE	DEI32TY2	DATE	04-NOV-1999
PROJ. NAME	MORETOWN		
PROJ. NO.	RSEGC-RS 0167(9)		
SHEET	11	OF	243 SHEETS