


DATUM  
 VERTICAL NGVD 1929  
 HORIZONTAL N/A

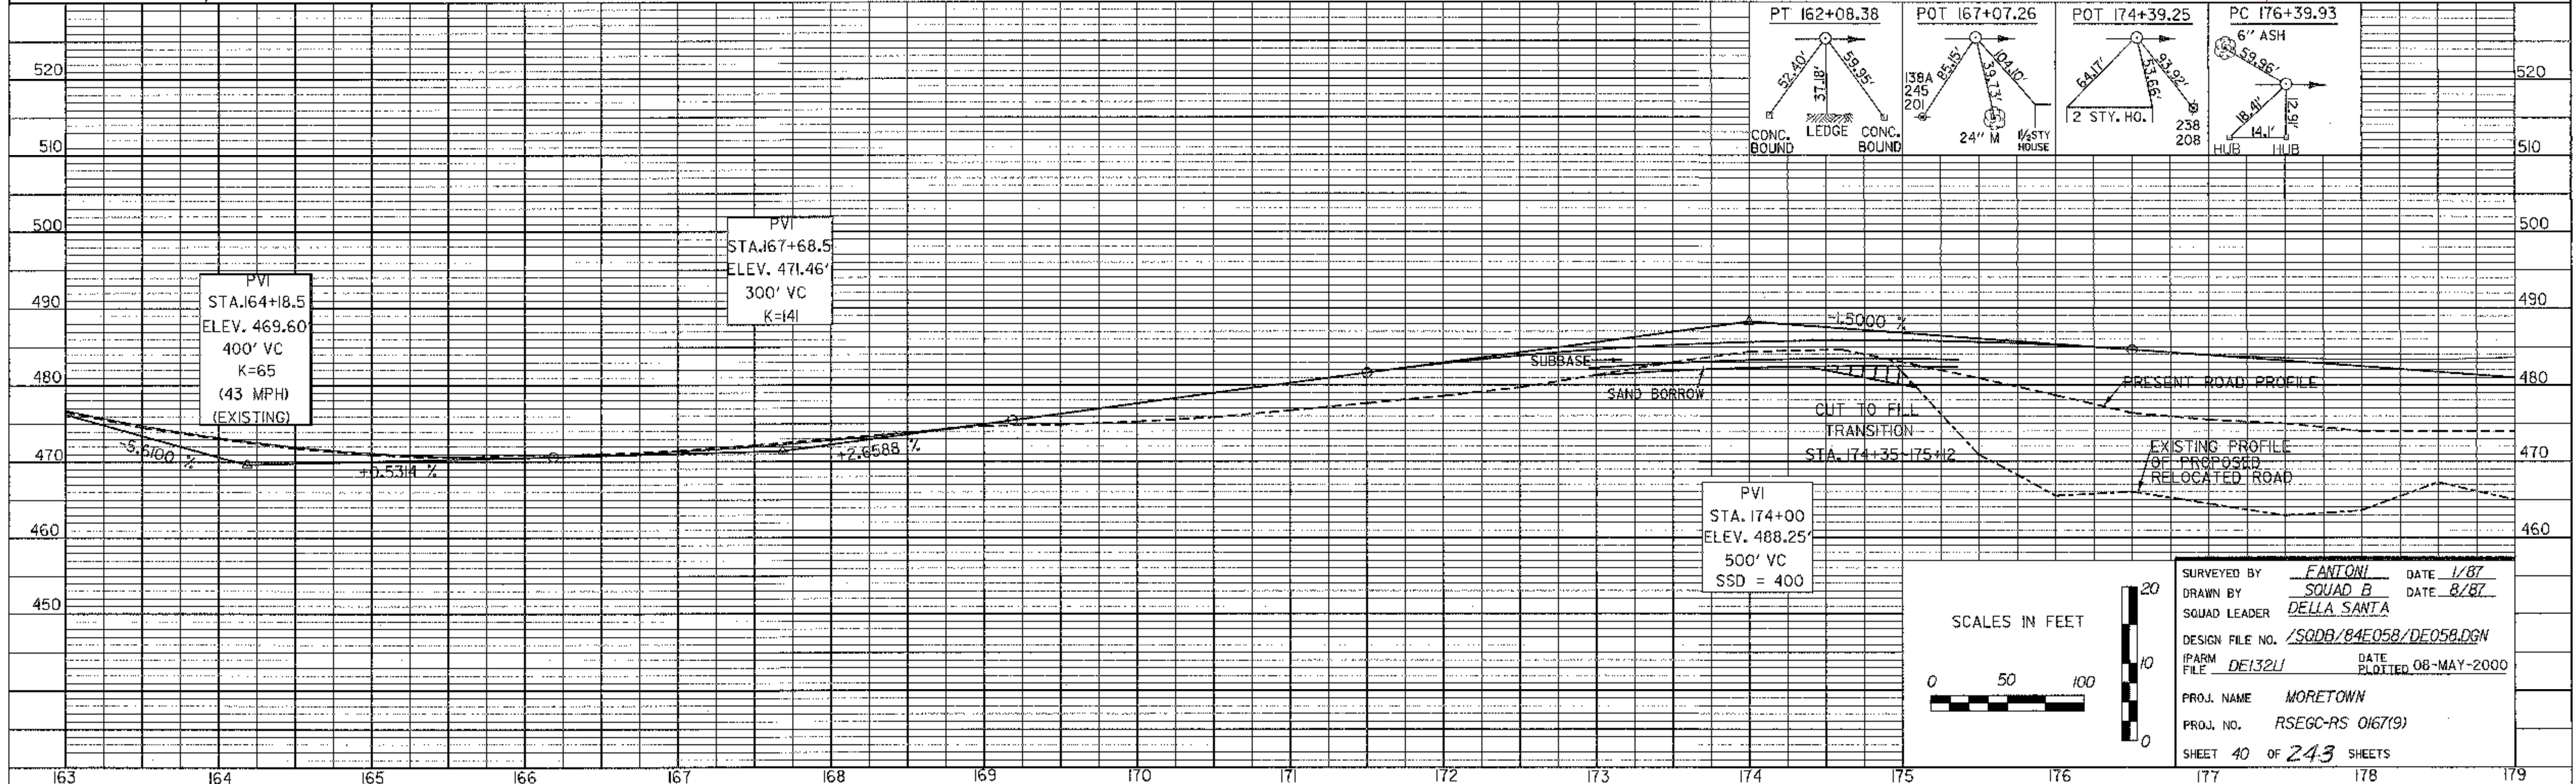

SURVEYED BY FANTONI DATE 1/87  
 DRAWN BY SQUAD B DATE 8/87  
 SQUAD LEADER DELLA SANTA  
 DESIGN FILE NO. 1/SQDB/84EQ58/DE058.DGN  
 (FARM FILE DE132LI DATE PLOTTED 08-MAY-2000)  
 PROJ. NAME MORETOWN  
 PROJ. NO. RSEGC-RS 0167(19)  
 SHEET 40 OF 243 SHEETS