

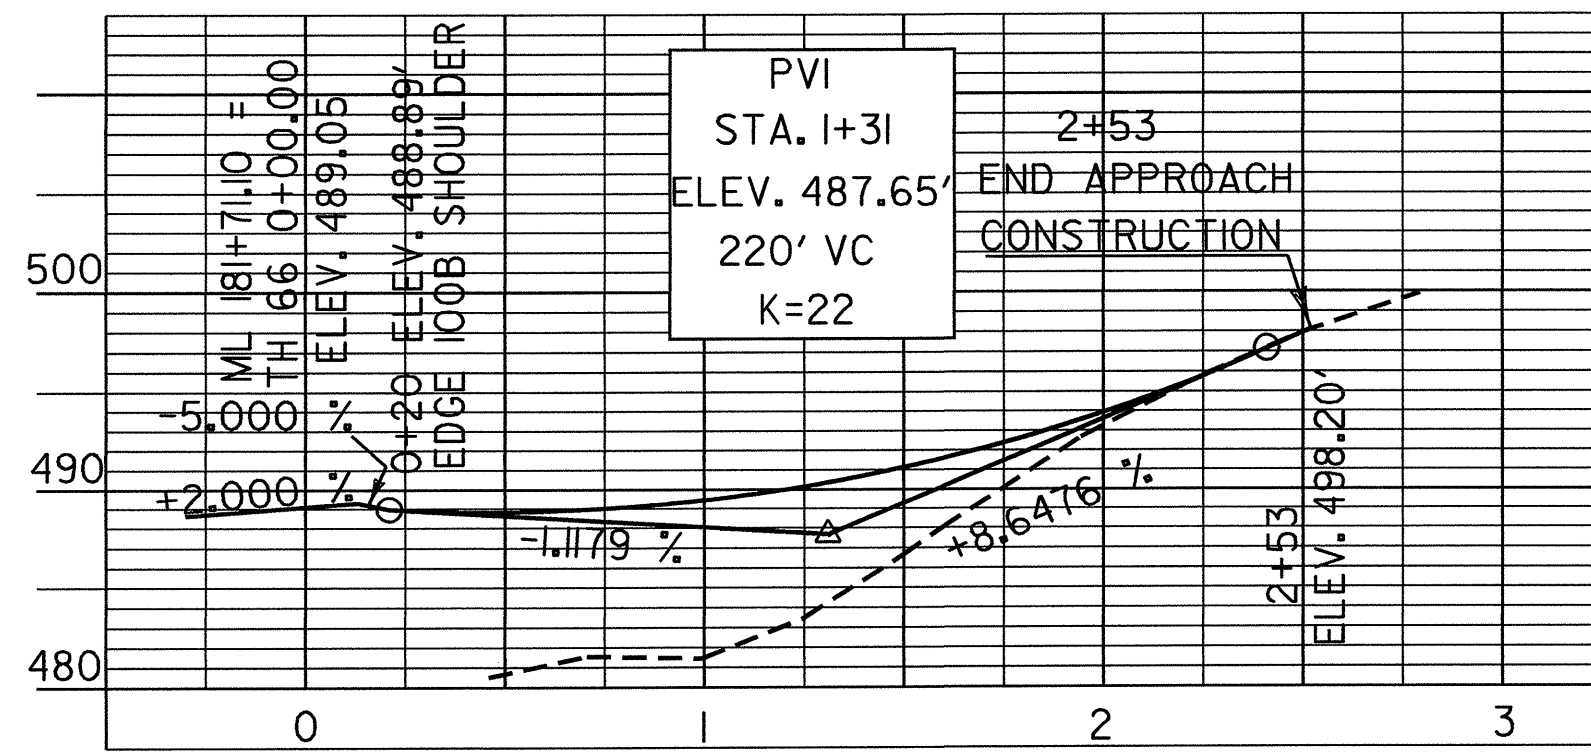
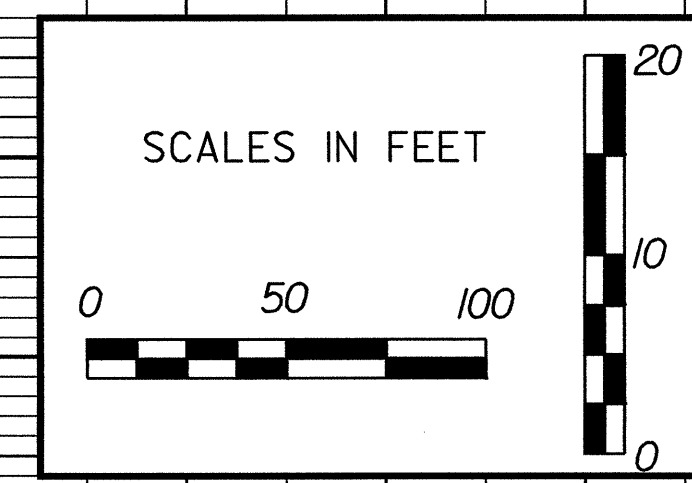


TOWN HIGHWAY 66

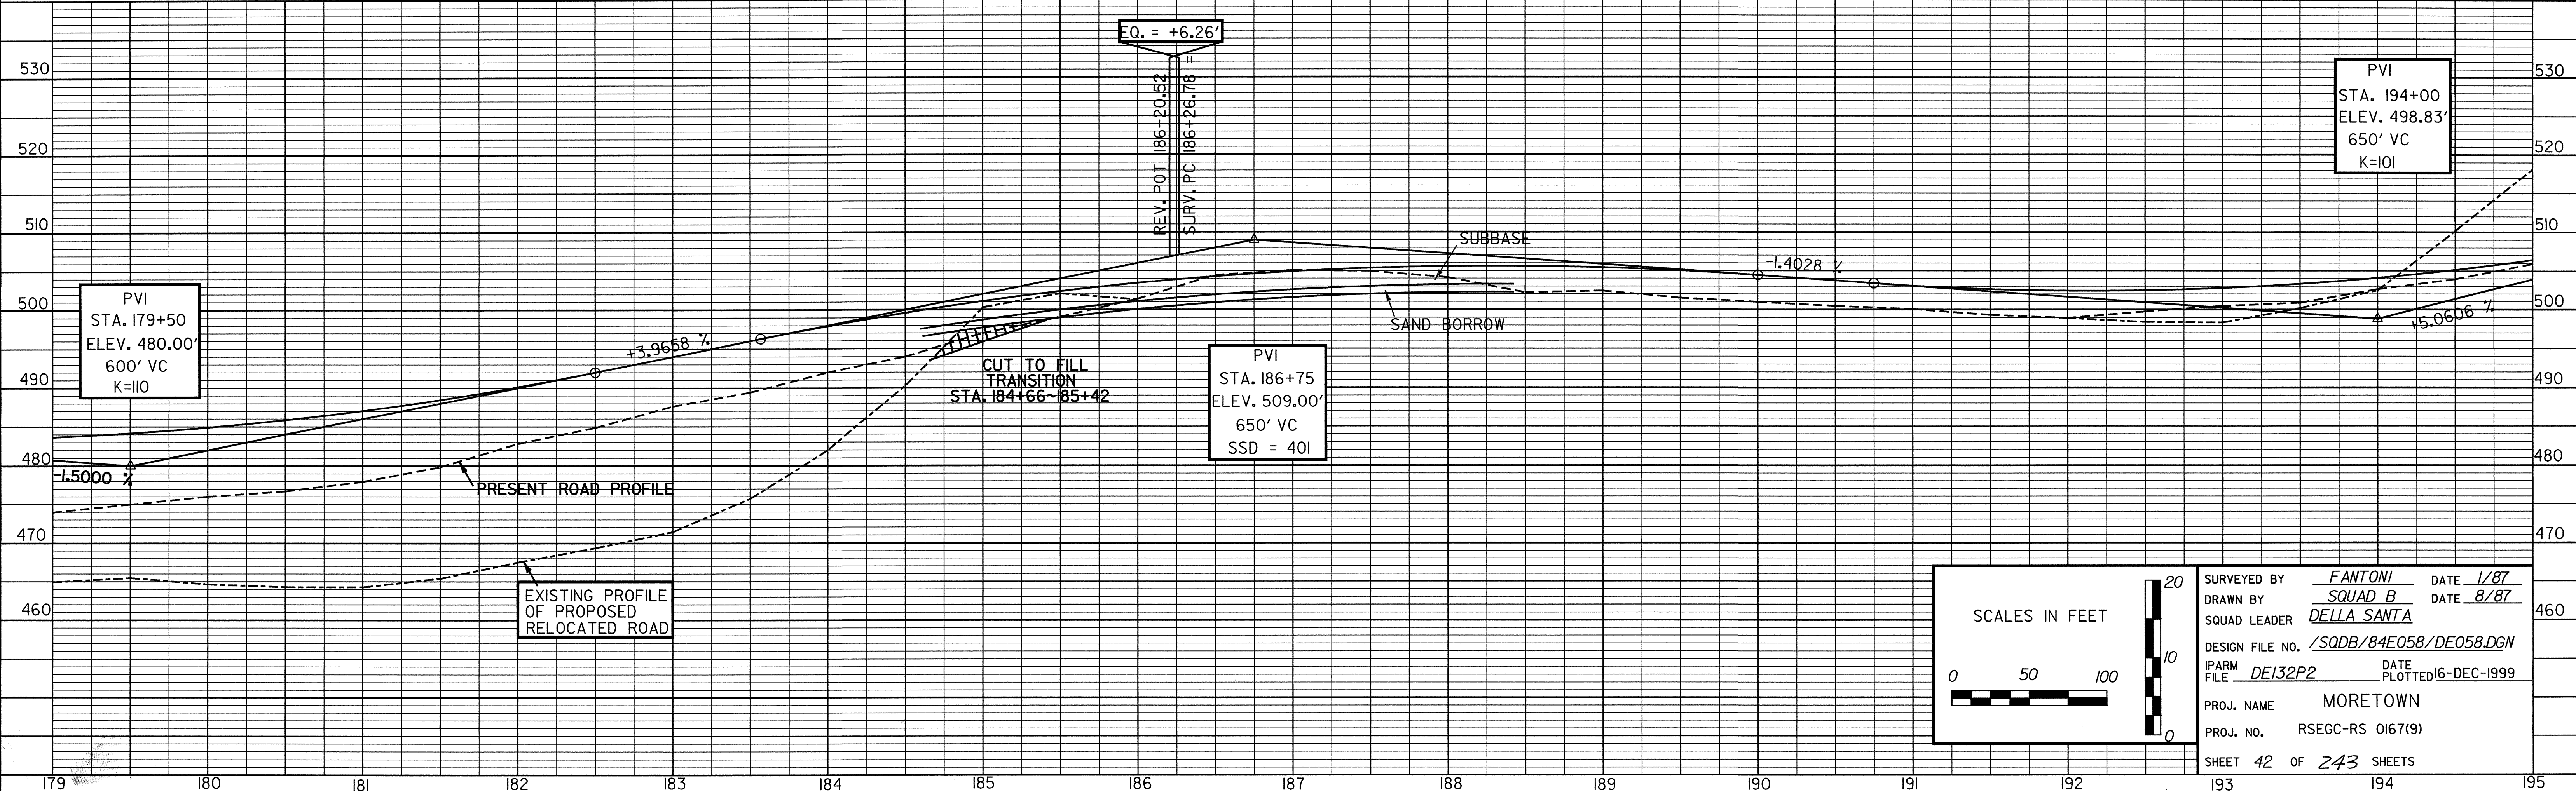

DATUM
 VERTICAL NGVD 1929
 HORIZONTAL N/A

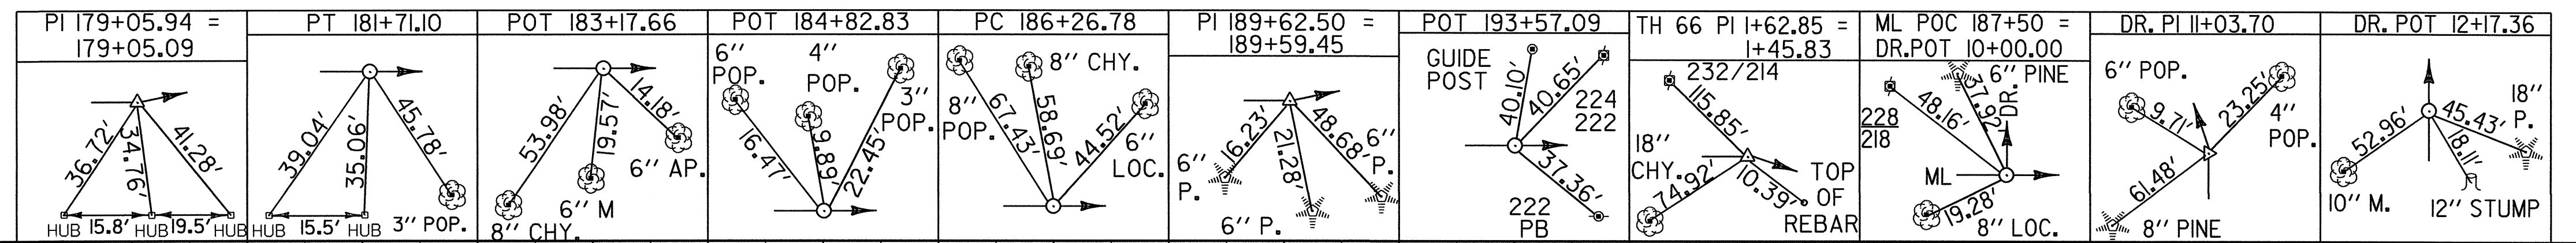

SURVEYED BY FANTONI DATE 1/87
 DRAWN BY SQUAD B DATE 8/87
 SQUAD LEADER DELLA SANTA
 DESIGN FILE NO. /SQDB/84E058/DE058.DGN
 IPARM FILE DE132P2 DATE PLOTTED 16-DEC-1999
 PROJ. NAME MORETOWN
 PROJ. NO. RSEGC-RS 0167(9)
 SHEET 42 OF 243 SHEETS