

TH 2 CURVE # 2 DATA

Δ = 21°49'-45" LT.
D = 10°
R = 572.958'
T = 110.486'
L = 218.292'
E = 10.55'

END TH 2 APPROACH
CONSTRUCTION

TH 2 POT 38+33.80

DRILLING AND BLASTING OF
SOLID ROCK SUBGRADE
TH 2 31+75 ~ 33+25 59

GRUBBING MATERIAL
TH 2 34+00 LT. ~ 37+25 LT.

MODIFIED ECCENTRIC
LOADER TERRMINAL(MELT)
TH 2 33+25 ~ 33+62.5 LT.
TH 2 36+87.5 ~ 37+25 LT.

EXCAVATION OF SURFACES
AND PAVEMENTS
(AREA TO BE TOPSOILED, SEEDED
AND MULCHED)
~~OLD TH 2 - SURV. 31+50 ~ 33+75 LT.~~

CONSTRUCT DRIVE
TH 2 34+88 RT. (GRAVEL)
TH 2 36+50 RT. (GRAVEL)


DRIVE GATE FOR WOVEN WIRE FENCE
TH 2 34+88 RT. (16' WIDE)
(2 - 8' GATES W/ OPENING IN MIDDLE)

REMOVAL AND DISPOSAL OF
GUARD RAIL
TH 2 31+50 ~ 32+54 LT.
TH 2 33+00 ~ 37+07 LT.

REMOVAL OF EXISTING FENCE
~~TH 2 31+50 ~ 35+00 RT.~~


STEEL BEAM GUARD RAIL
TH 2 33+62.5 ~ 36+87.5 LT.

0 50 100
SCALE IN FEET

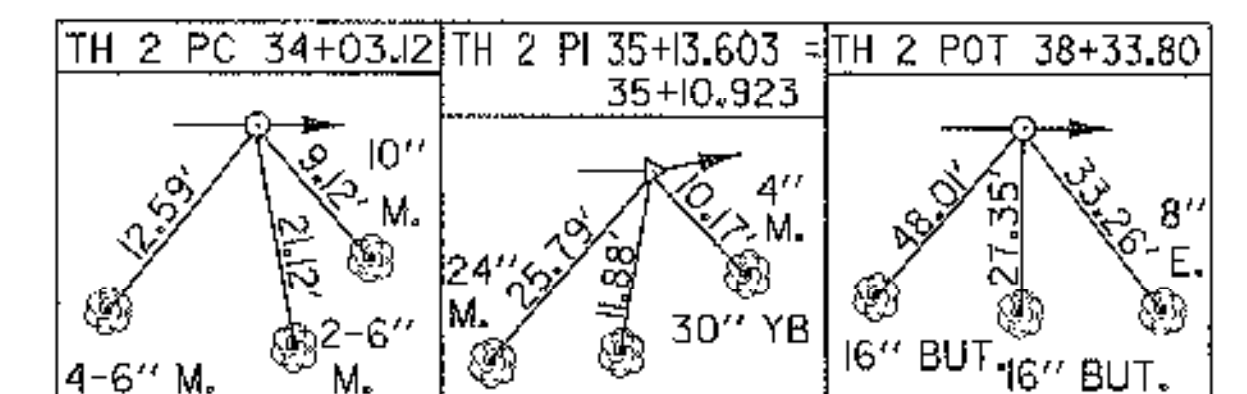

DATUM
VERTICAL NGVD 1929
HORIZONTAL N/A

○ DENOTES REMOVAL OF TREE OR STUMP

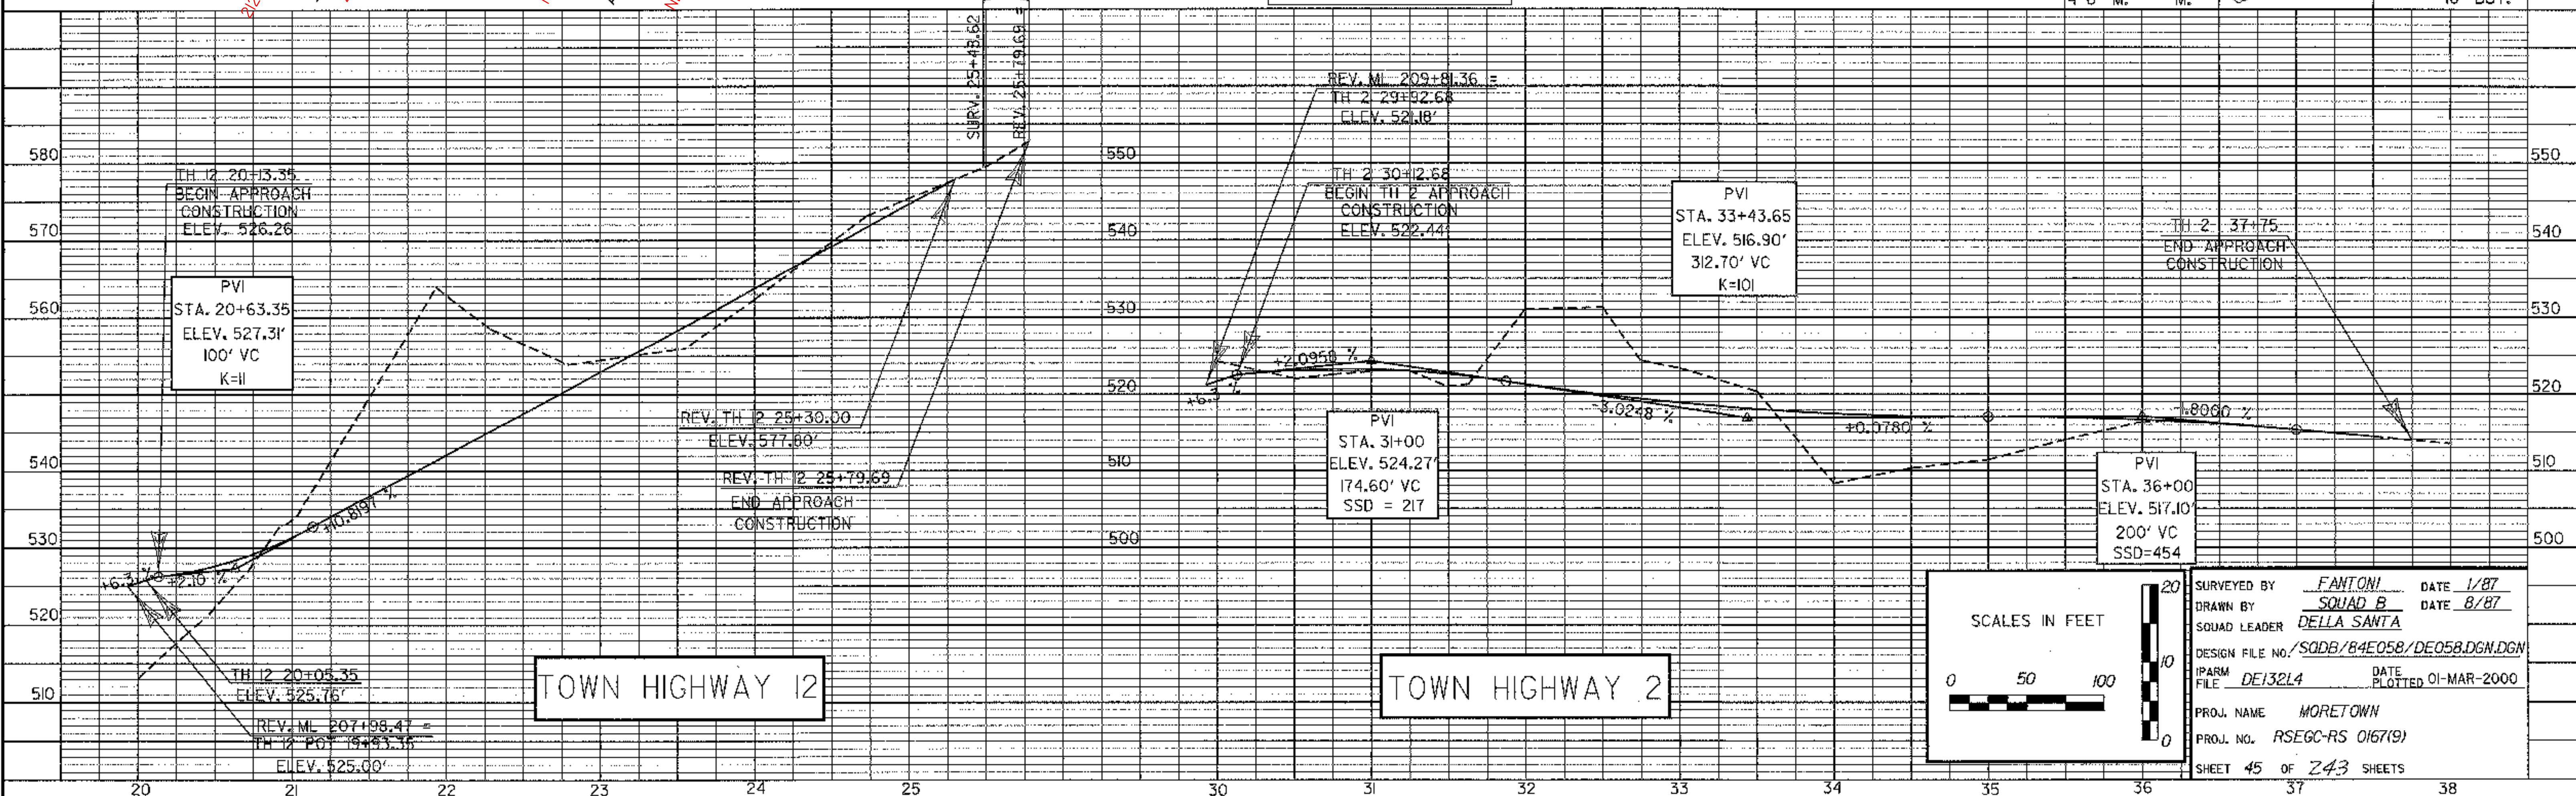

0 50 100
SCALE IN FEET

SURVEYED BY FANTONI DATE 1/87
DRAWN BY SQUAD B DATE 8/87
SQUAD LEADER DELLA SANTA
DESIGN FILE NO. SADB/84E058/DE058.DGN.DGN
IPARM FILE DE13214 DATE PLOTTED 01-MAR-2000
PROJ. NAME MORETOWN
PROJ. NO. RSEGC-RS 016719
SHEET 45 OF 243 SHEETS