
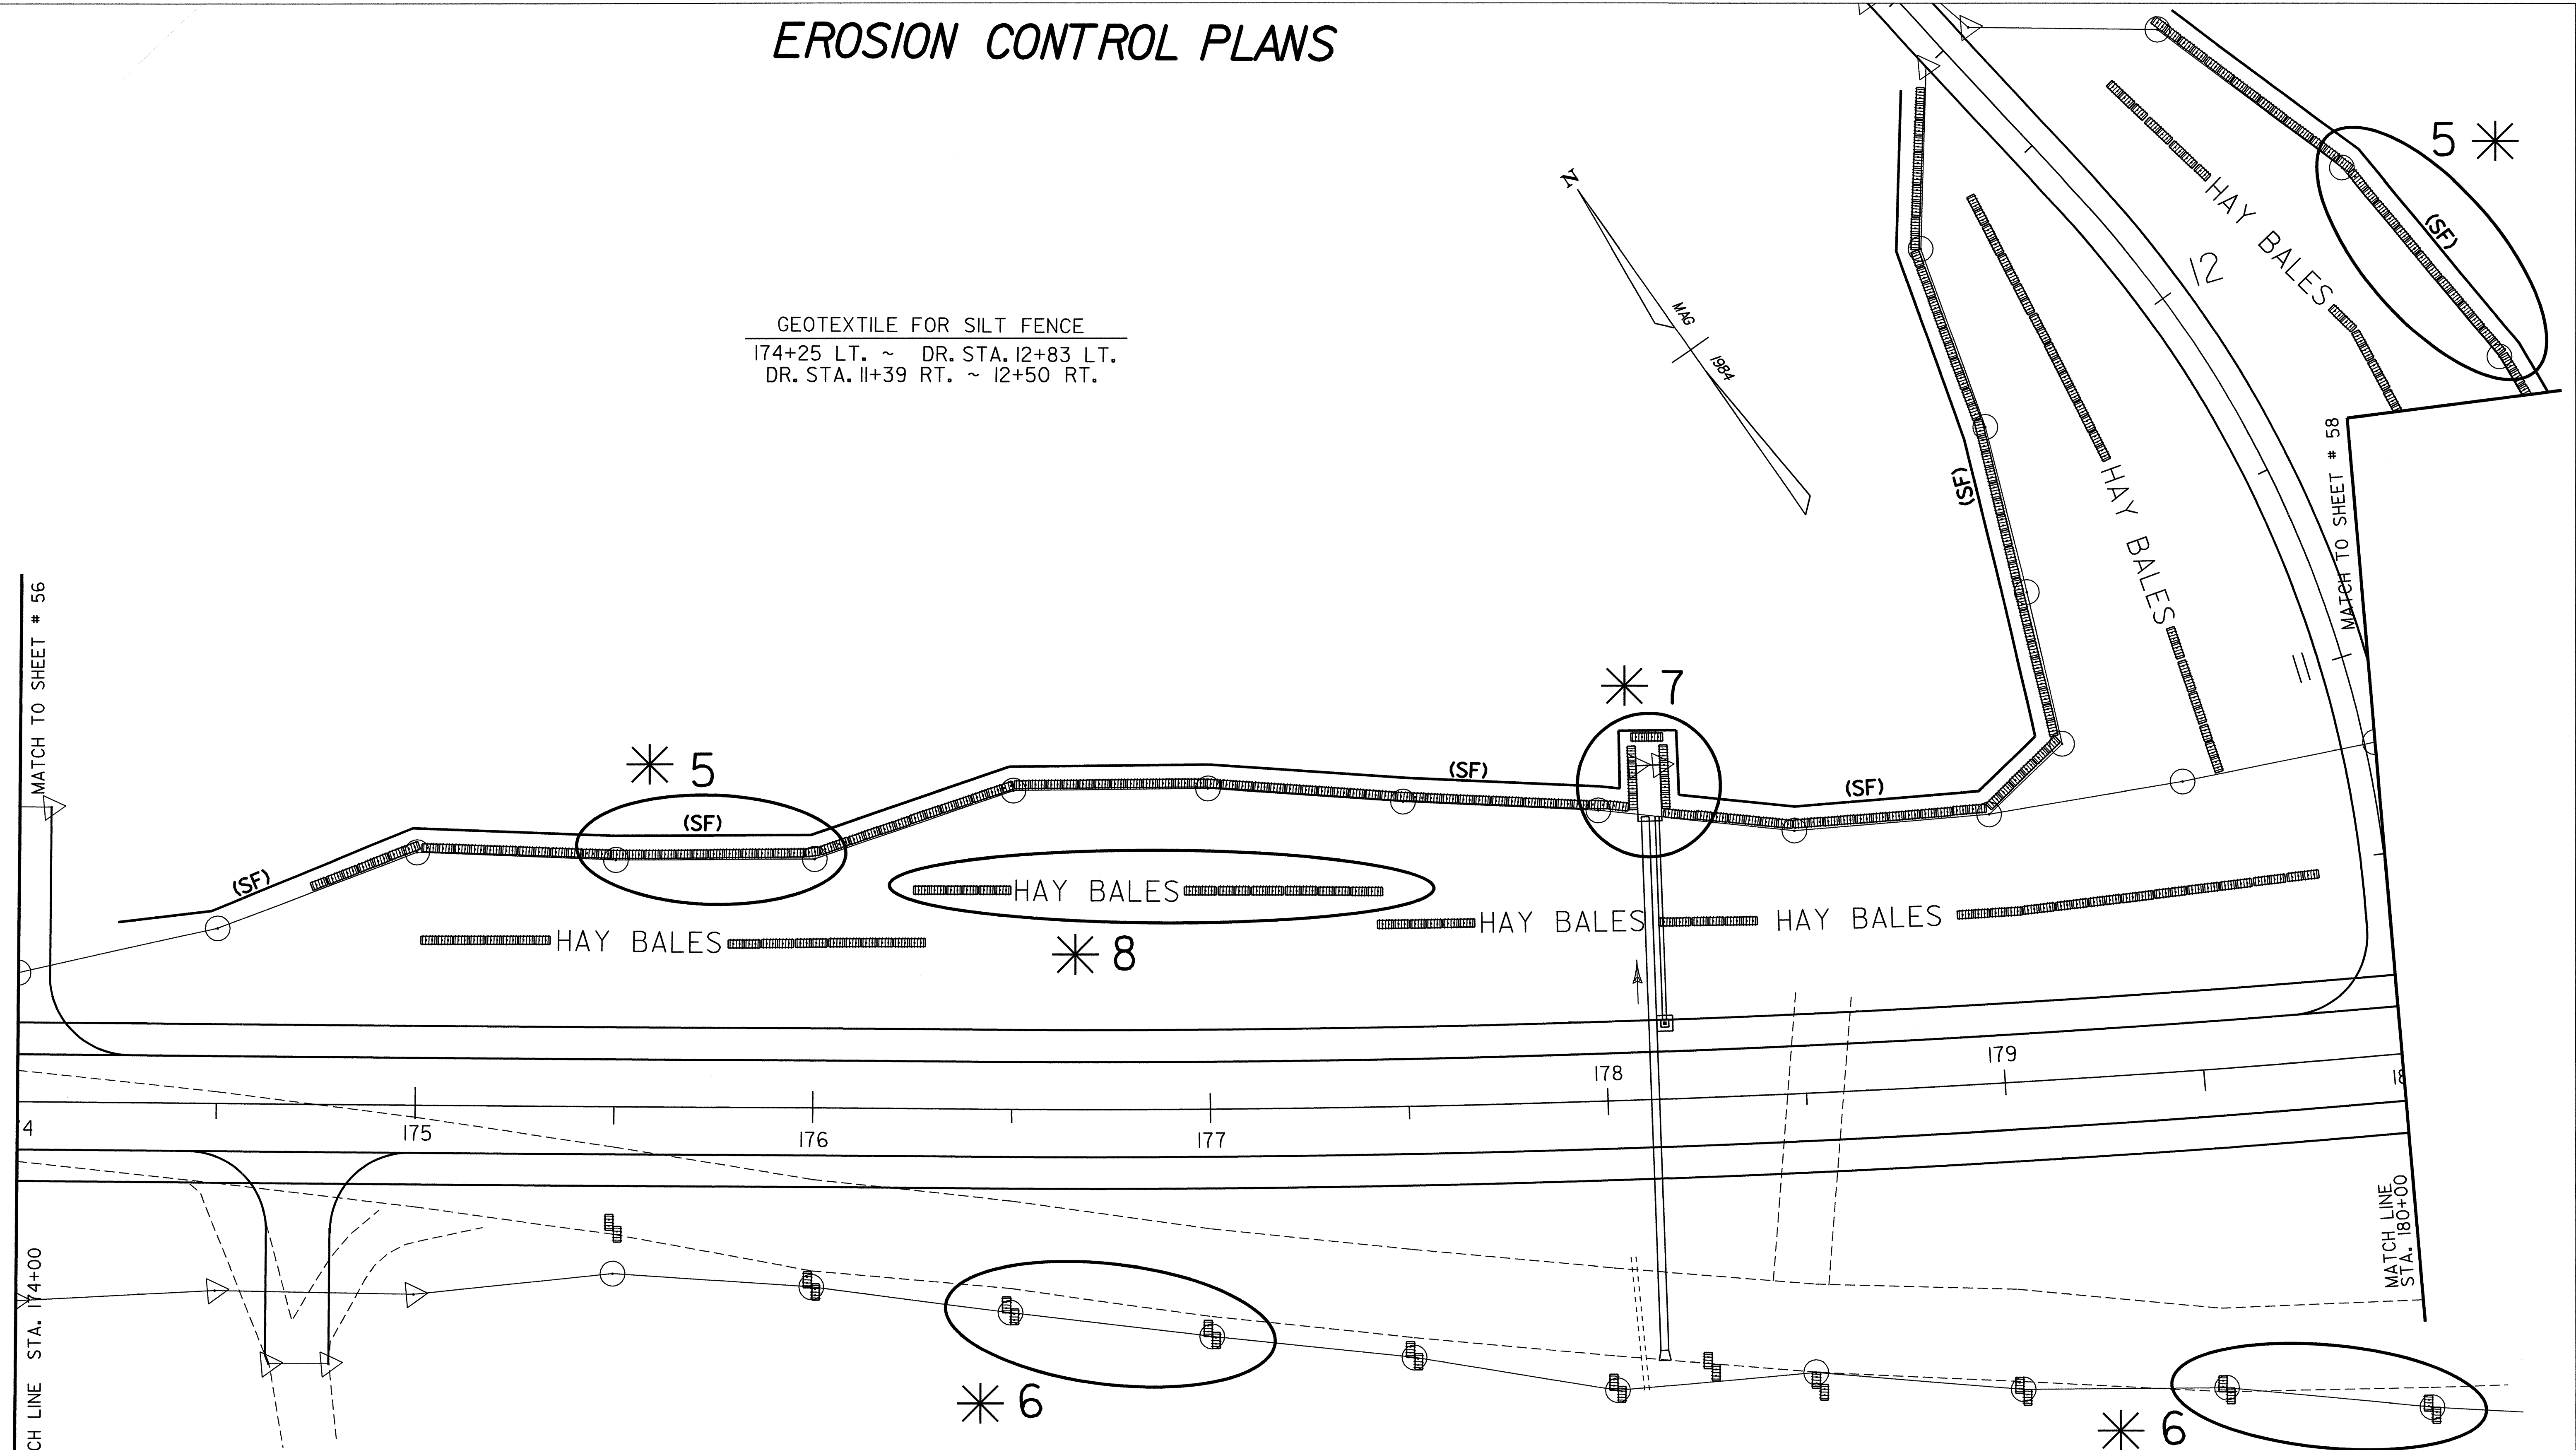


EROSION CONTROL PLANS

GEOTEXTILE FOR SILT FENCE
 174+25 LT. ~ DR. STA. 12+83 LT.
 DR. STA. 11+39 RT. ~ 12+50 RT.

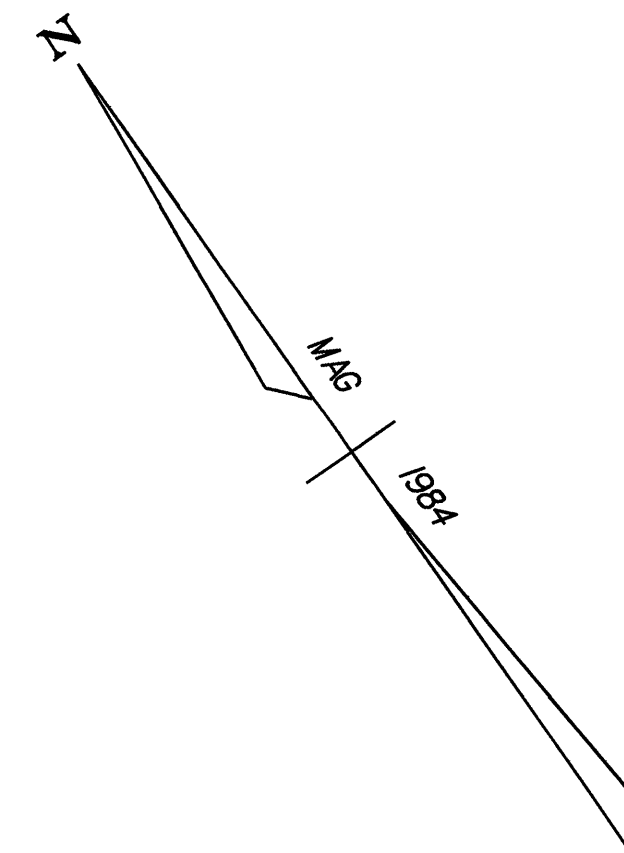


✱ SEE EROSION CONTROL PLANS TYPICAL SHEET

(SF) DENOTES GEOTEXTILE FOR SILT FENCE

THIS SHEET IS FOR EROSION CONTROL USE ONLY

DATUM
 VERTICAL NGVD 1929
 HORIZONTAL N/A

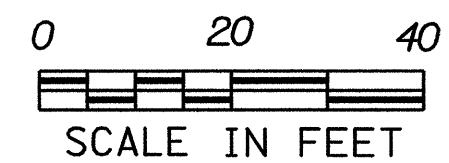

SURVEYED BY	FANTONI	DATE	1/87
DRAWN BY	SQUAD B	DATE	8/87
SQUAD LEADER	DELLA SANTA		
DESIGN FILE NO.	/SQDB/84E058/DE058ERO.DGN		
IPARM FILE	DE132ER3	DATE PLOTTED	05-NOV-1999
PROJ. NAME	MORETOWN		
PROJ. NO.	RSEGC-RS 0167(9)		
SHEET	57 OF 243 SHEETS		