


NO.	DATE	BY	REVISION

NO.	DATE	BY	REVISION

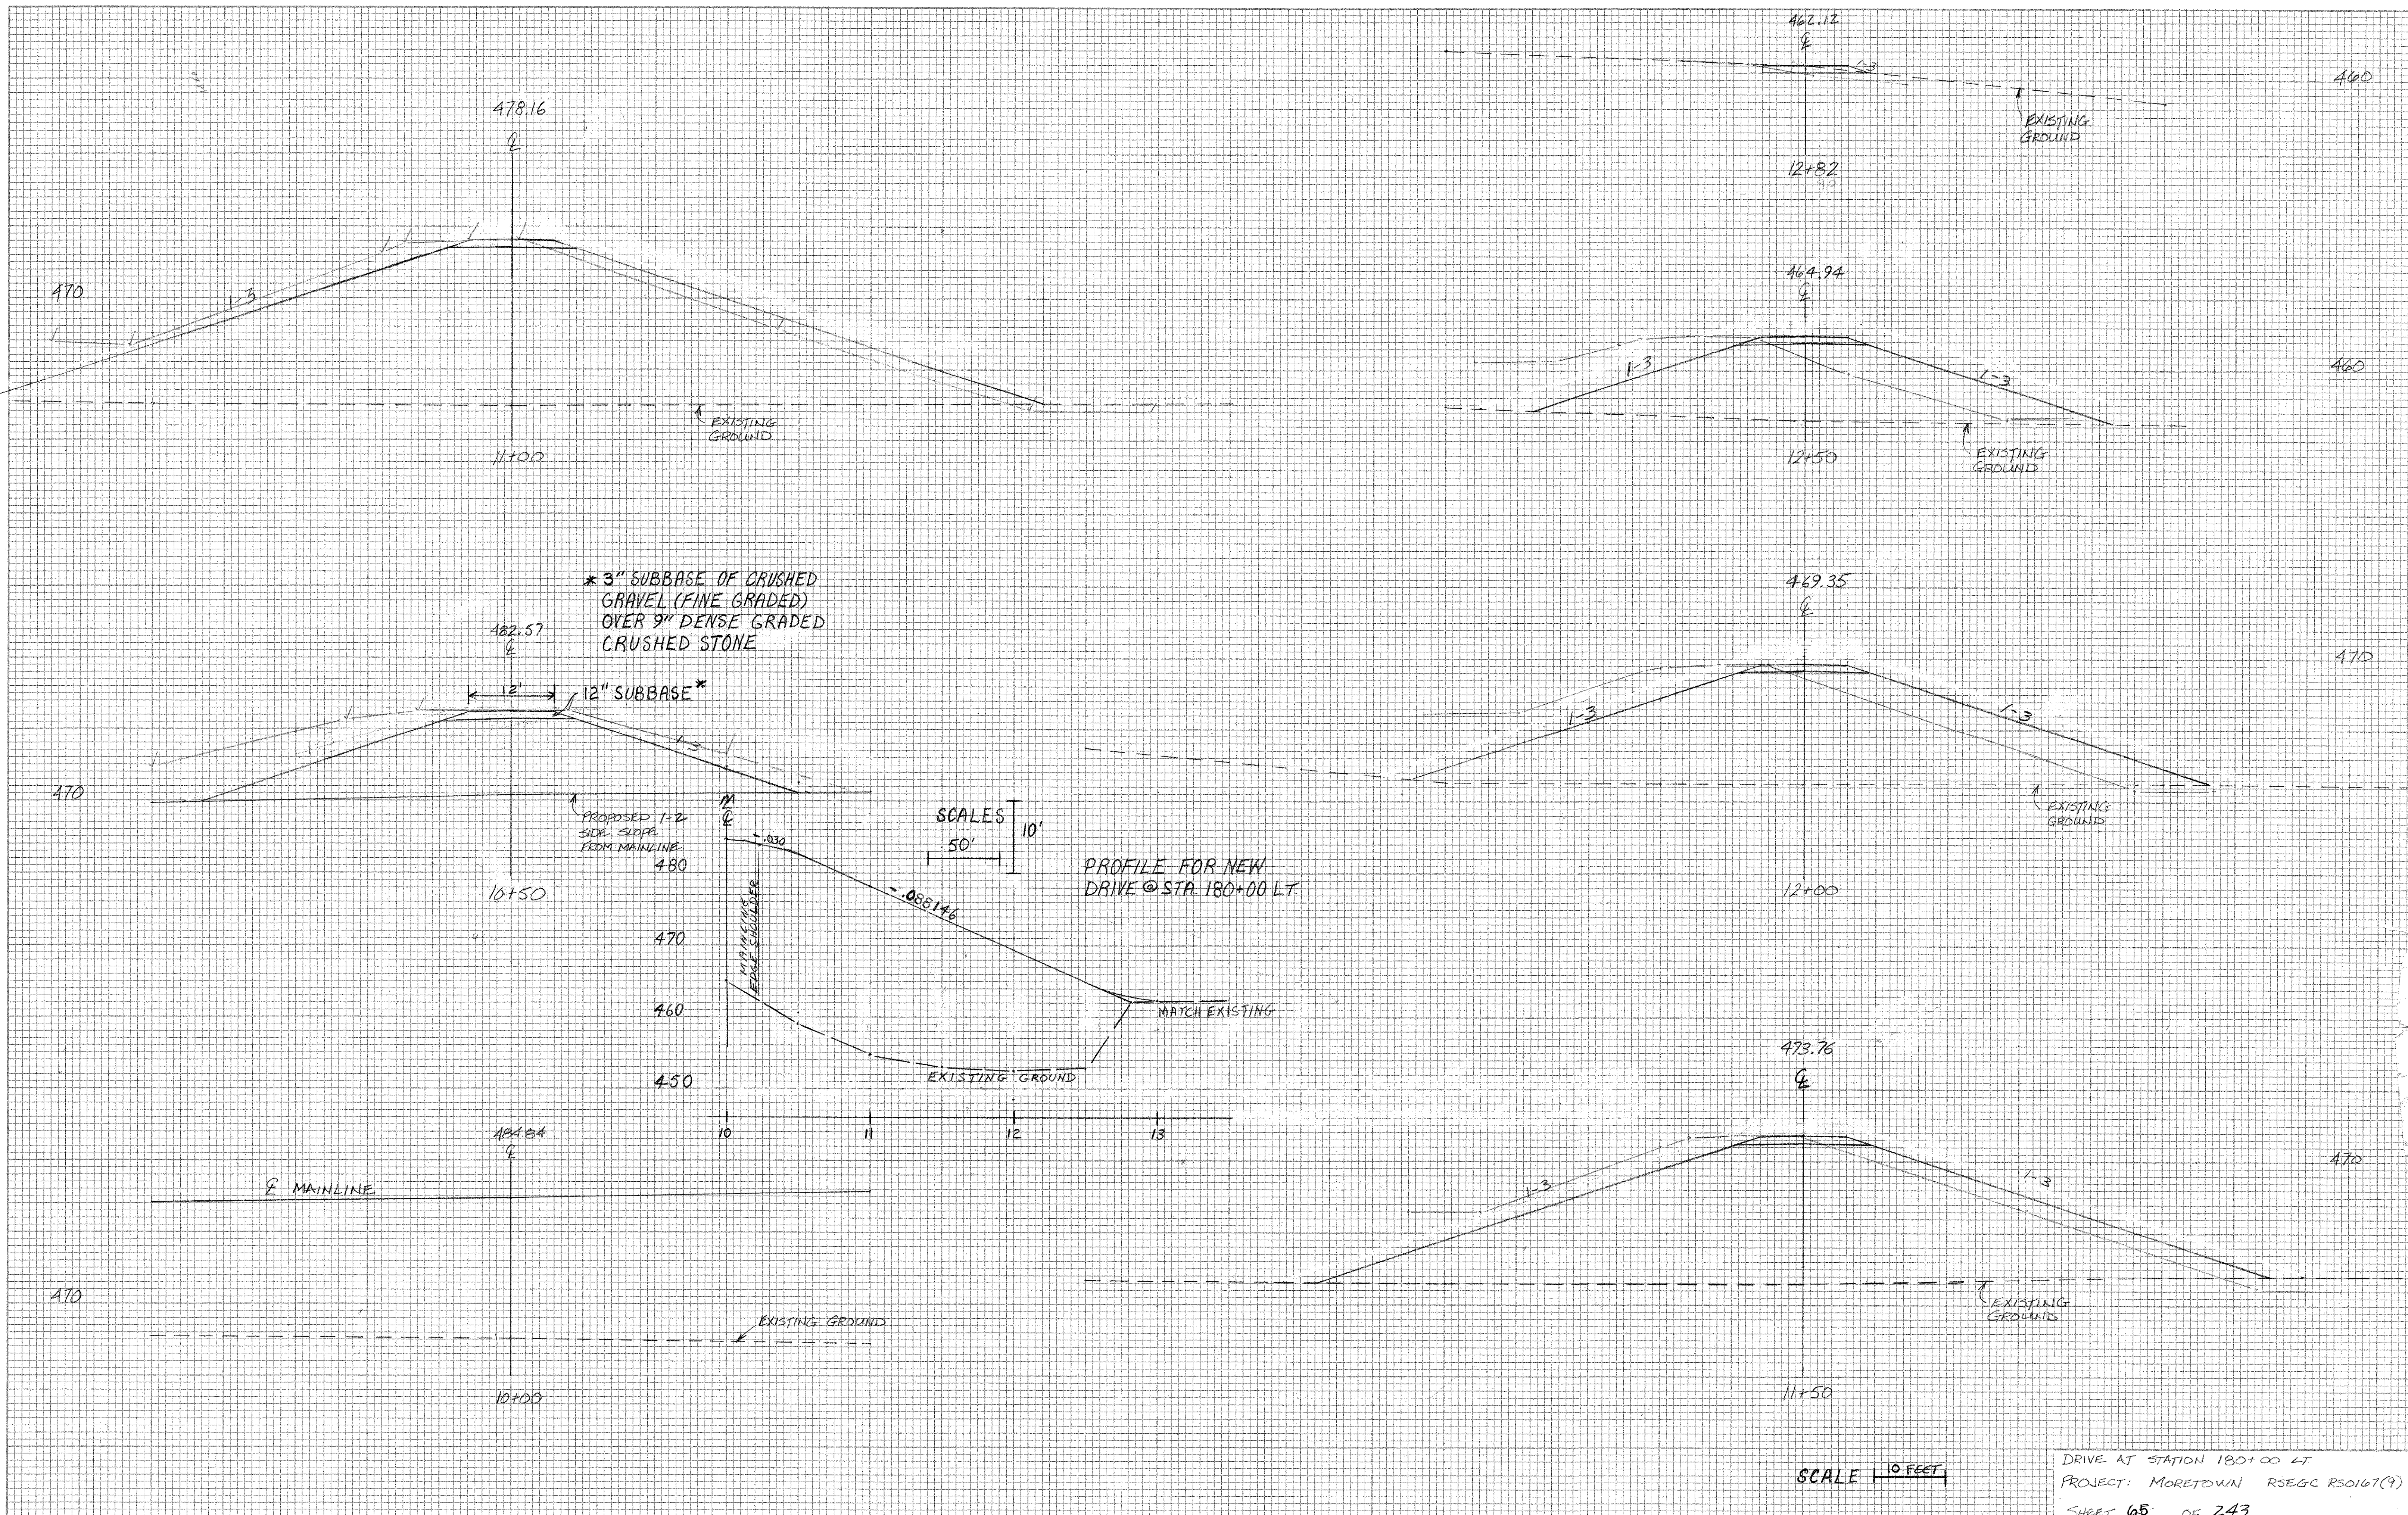

DRIVE AT STATION 180+00 LT  
 PROJECT: MORETOWN RSEGC R50167(9)  
 SHEET 65 OF 243