


SURV. 193+00 = REV. 192+96.94
 Skew Section 51° 12' LT.

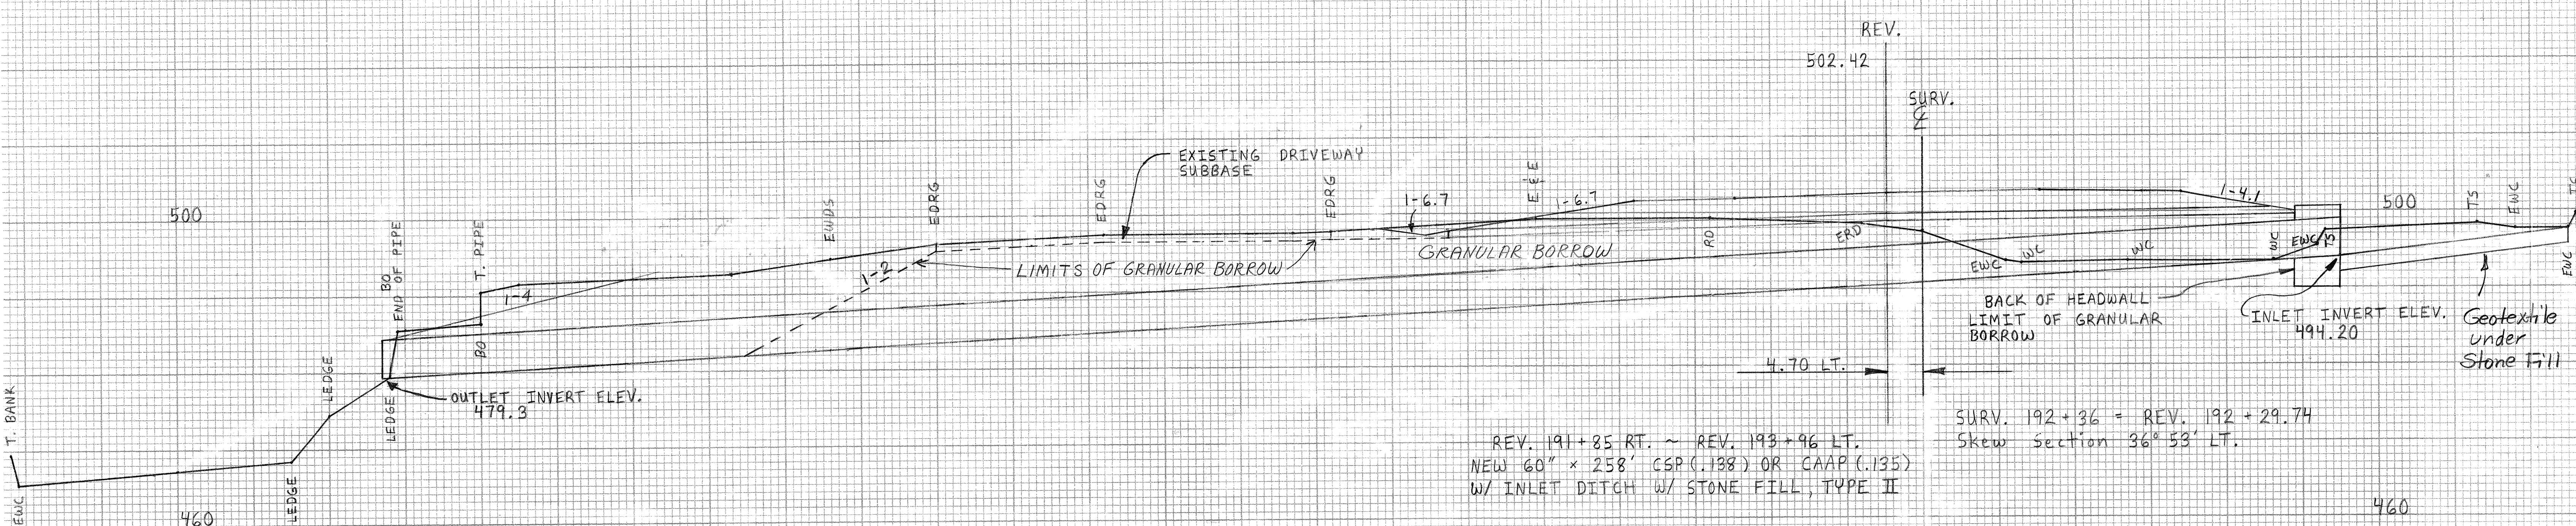

REV. 191+85 RT. ~ REV. 193+96 LT.
 NEW 60" x 258' CSP (.138) OR CAAP (.135)
 W/ INLET DITCH W/ STONE FILL, TYPE II

SURV. 192+36 = REV. 192+29.74
 Skew Section 36° 53' LT.

10'
 SCALE

PROJECT NAME:
 MORETOWN - MIDDLESEX
 RSEGC - RS 0167(9)
 SHEET 66 OF 243