


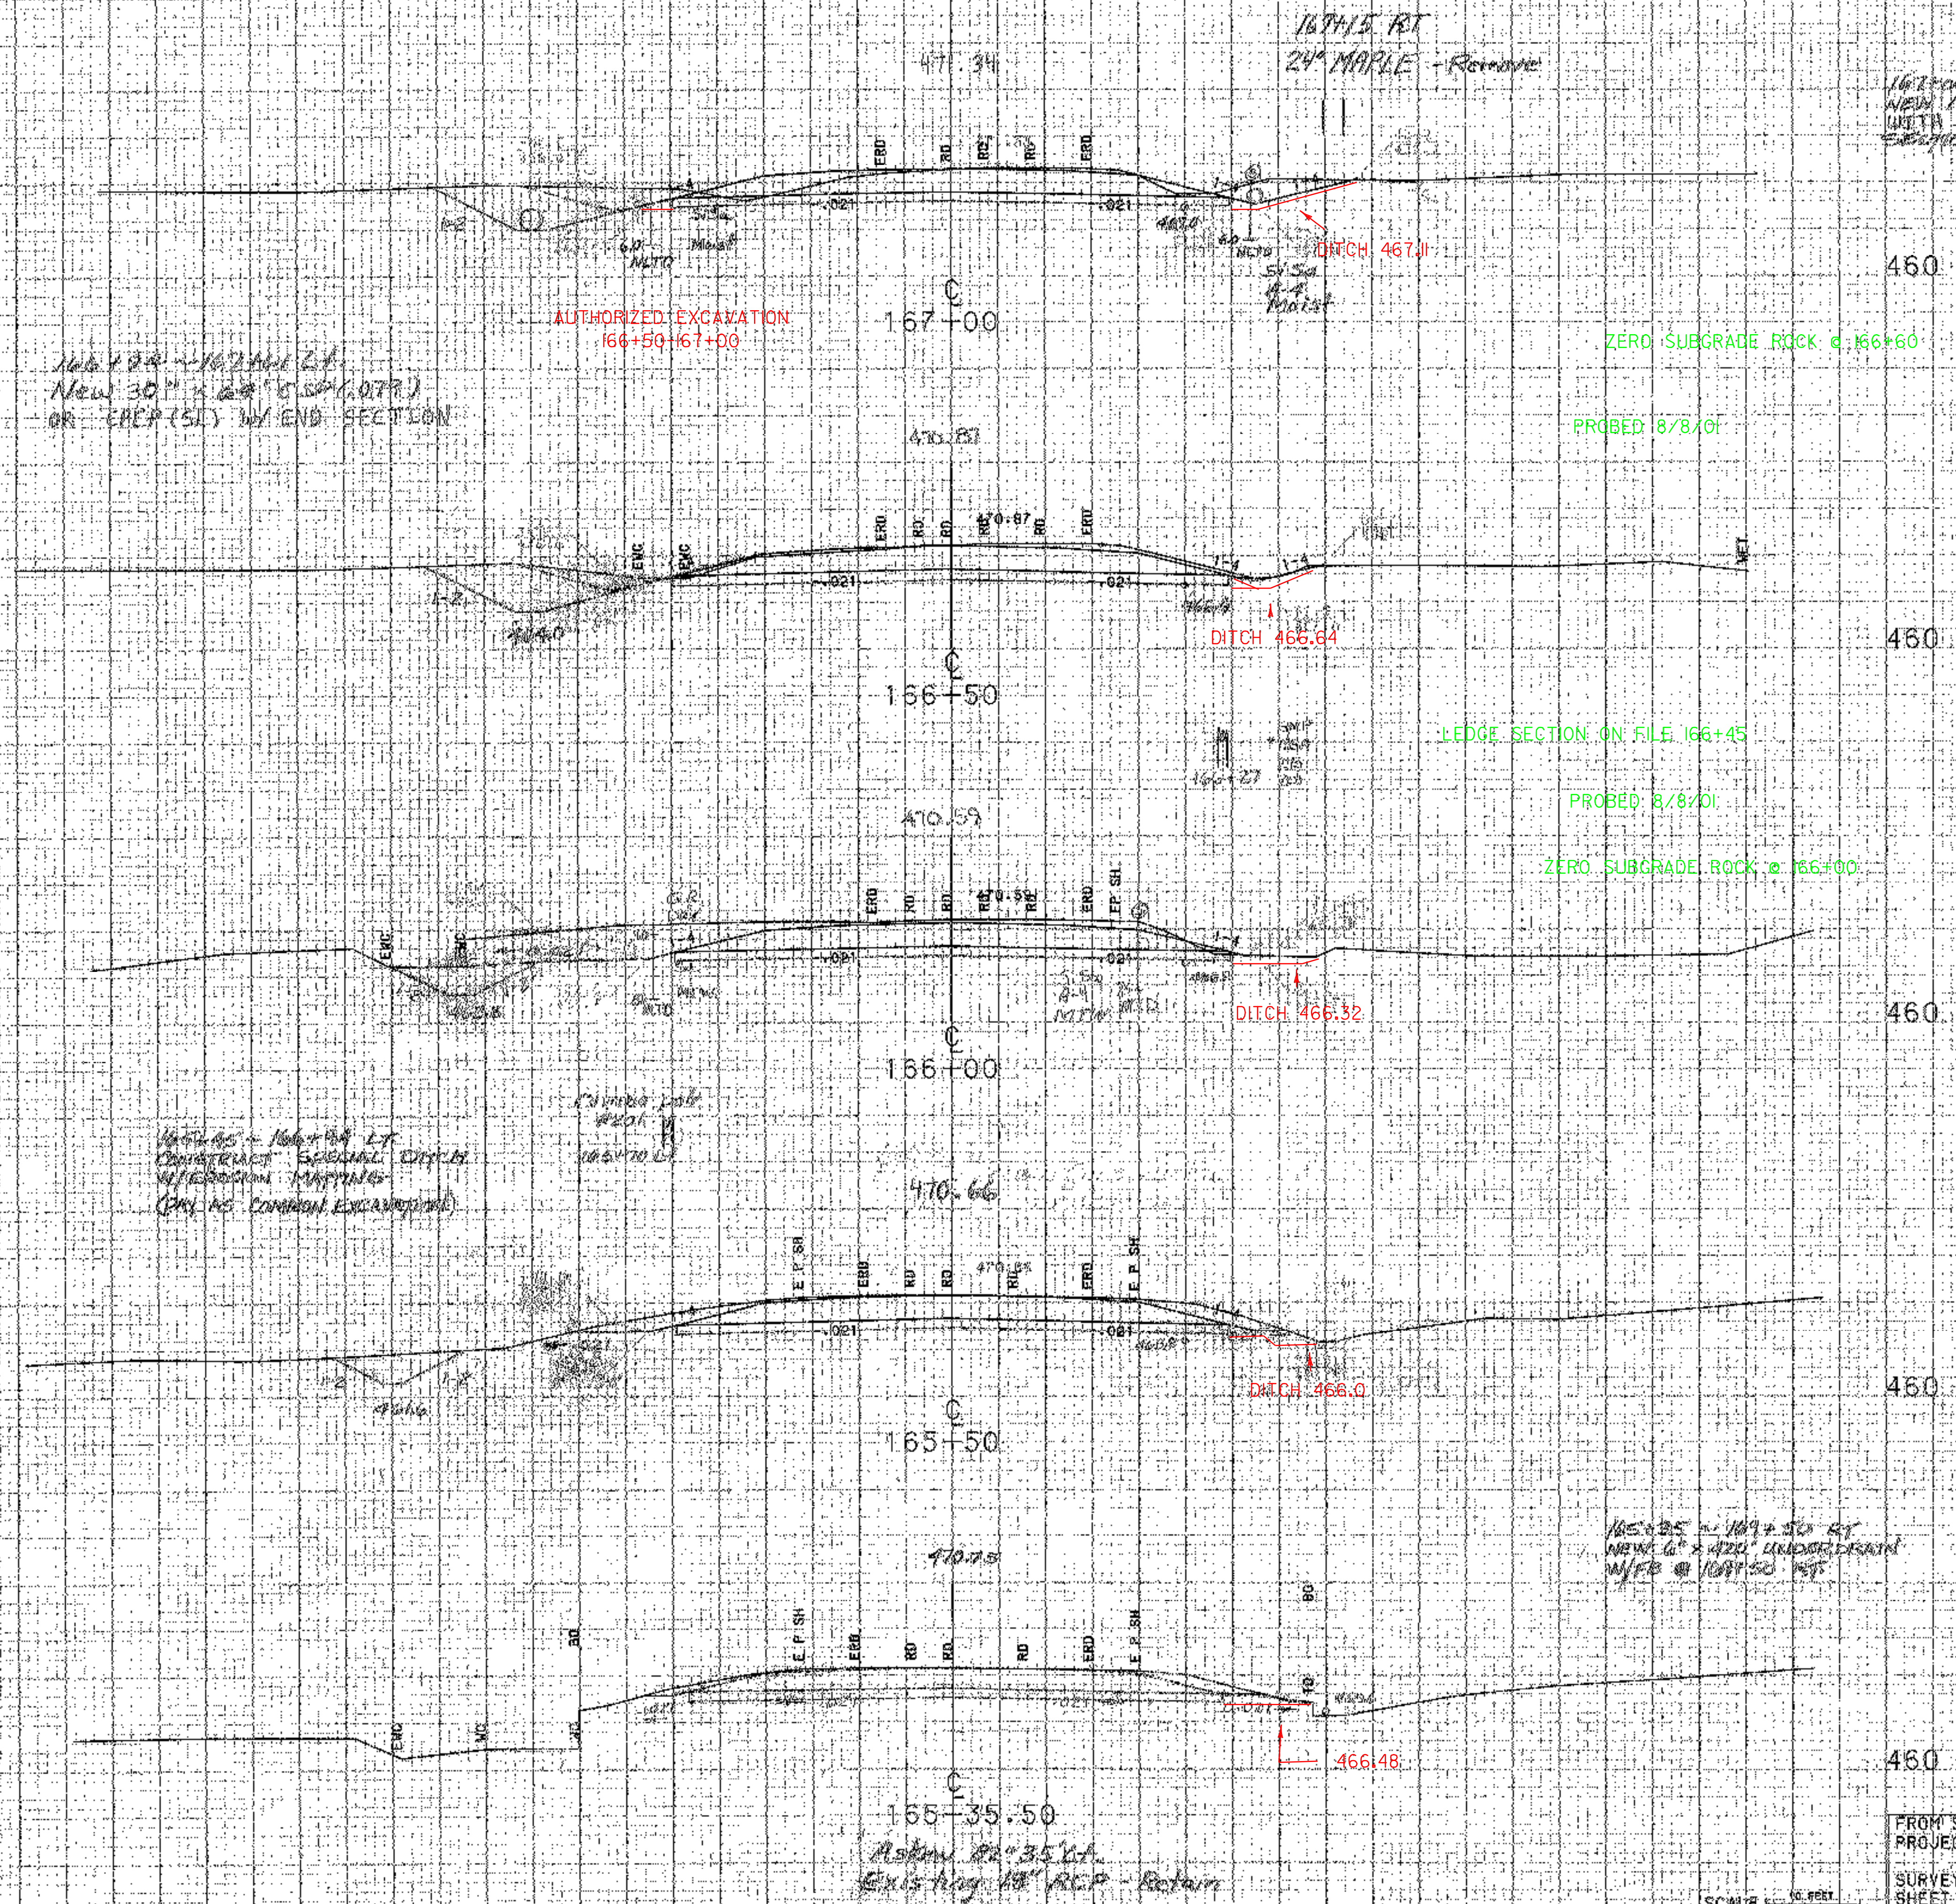

166+00 ~ 167+00 L.T.
New 30" x 24" C.S.P. (QTR.)
OR EREX (SI) W/ END SECTION

AUTHORIZED EXCAVATION
166+50-167+00

167+15 RT
24" MARLE - Remove

167+00 ~ 168+95 RT
NEW 18" x 18" C.S.P. (QTR.) (QTR.) (QTR.)
WITH END SECTION @ INLET

ZERO SUBGRADE ROCK @ 166+60

PROBED 8/8/01

LEDGE SECTION ON FILE 166+45

PROBED 8/8/01

ZERO SUBGRADE ROCK @ 166+00

166+00 ~ 167+00 L.T.
CONTRACT SPECIAL DITCH
W/ END SECTION
(QTR.) (QTR.) (QTR.)

166+00 ~ 167+00 L.T.
CONTRACT SPECIAL DITCH
W/ END SECTION
(QTR.) (QTR.) (QTR.)

165+35 ~ 167+00 L.T.
NEW 30" x 24" C.S.P. (QTR.)
W/ END SECTION @ 167+00

165+35.50
Remove 24" MARLE - Remove
Existing 18" R.C.P. - Remove

FROM STA. 165+35.50	TO STA. 167+00
PROJECT NAME	MORETOWN
NO. 70 R/S 0167101	
SURVEYED BY	MOREAU
SHEET 75 OF 73 SHEETS	
PLOTTED 04/15/87	01/86 - 0039

SCALE 1" = 10' HORIZ.