


470.82

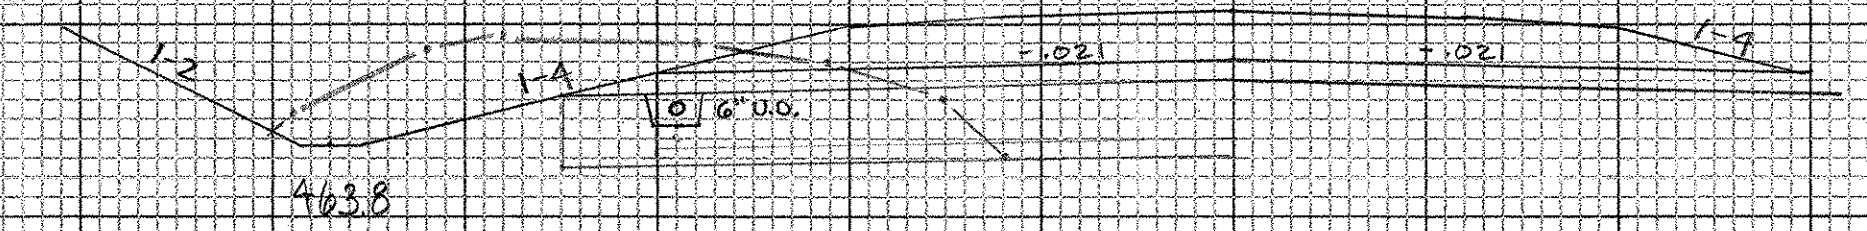

463.8

166+43
VT 100B

Solid Rock 65.75'

205.20 SUPREME DRILLING & BLASTING (LOCATION OF SOLID ROCK VERIFIED BY SIGN 8-8-01)

STATION	DIST.	WIDTH	AREA
166+00	43	0	51.9
166+43	23	23	21.7
166+60	17	17	76.6 sq

CROSS SECTION SHEET

PROJECT NAME: _____
 PROJECT NUMBER: 166+43
 FILE NAME: LEGE SECTION PLOT DATE: 05-JUN-2000 09
 PROJECT LEADER: _____ DRAWN BY: _____
 DESIGNED BY: _____ CHECKED BY: _____
 const: g:/common/cadd/e-xsection.dgn SHEET 75A OF _____