


Comb. NET + GMP  
 +234  
 212

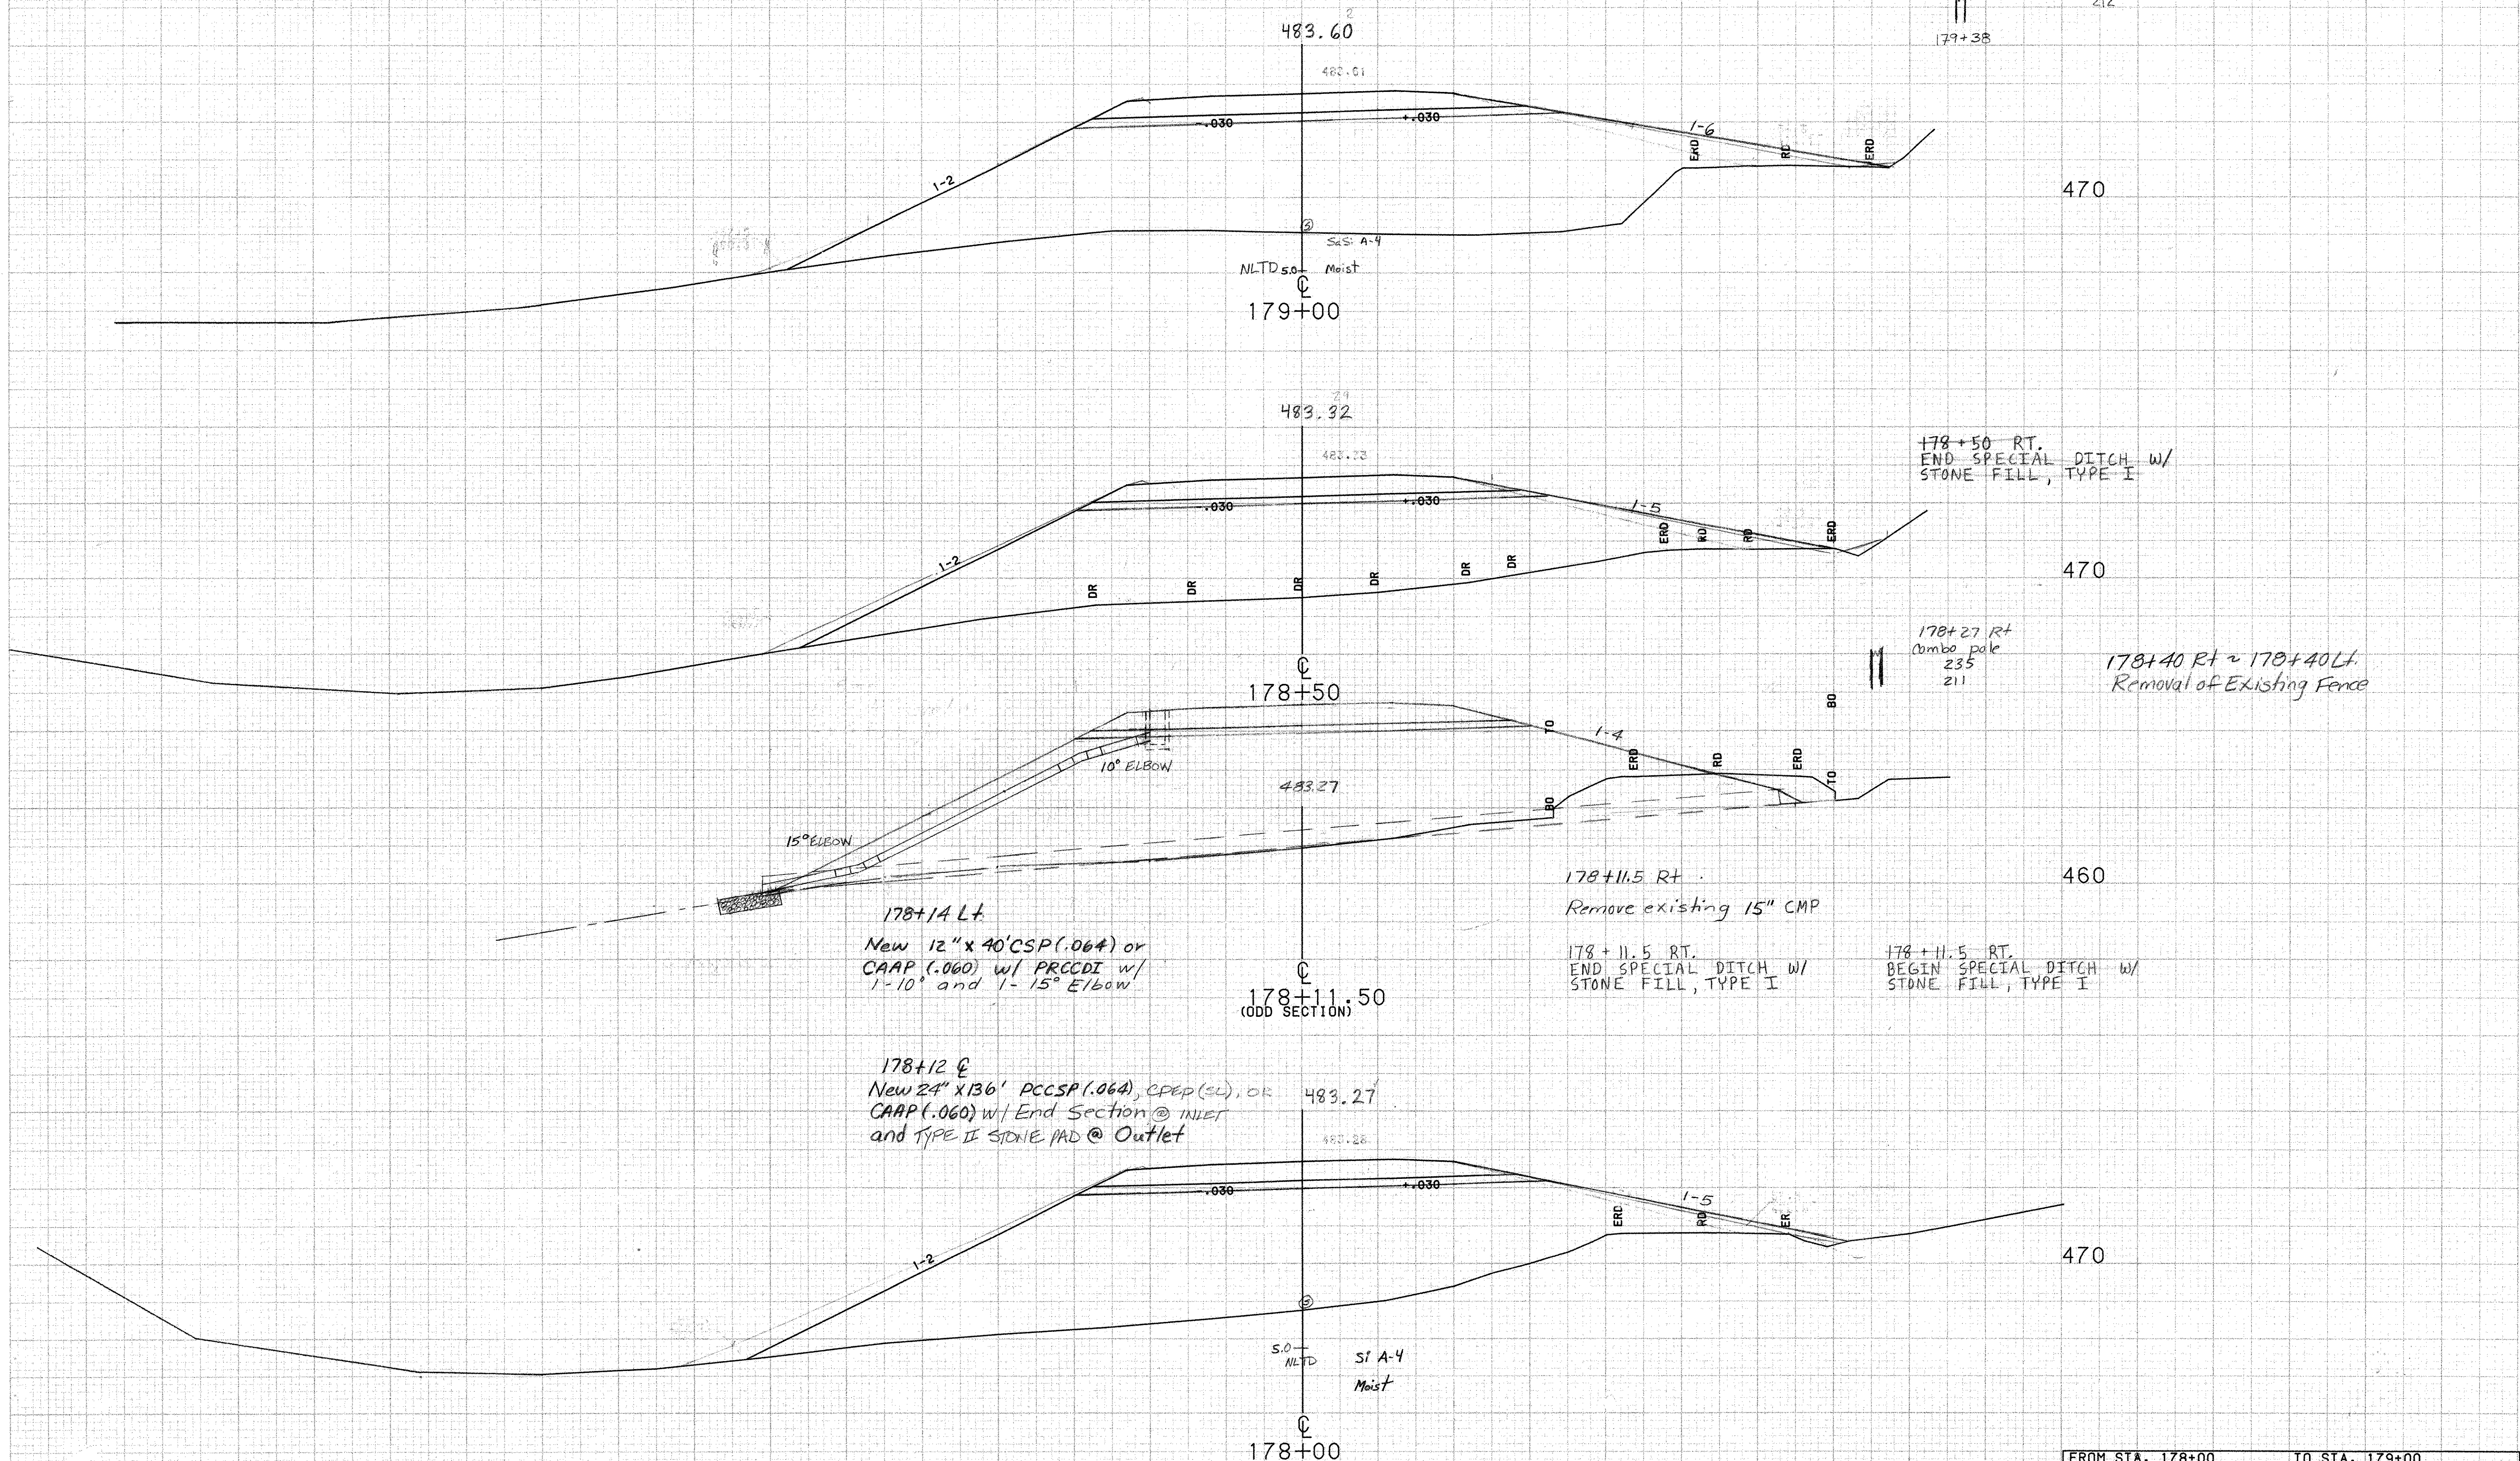

178+14 Lt  
 New 12" x 40' CSP (.064) or  
 CAAP (.060) w/ PRCCI w/  
 1-10° and 1-15° Elbow

178+12 C  
 New 24" x 136' PCCSP (.064), CP&P (SL), OR  
 CAAP (.060) w/ End Section @ INLET  
 and TYPE II STONE PAD @ Outlet

178+11.5 Rt  
 Remove existing 15" CMP

178+11.5 RT.  
 END SPECIAL DITCH W/  
 STONE FILL, TYPE I

178+11.5 RT.  
 BEGIN SPECIAL DITCH W/  
 STONE FILL, TYPE I

SCALE 1" = 10 FEET

FROM STA. 178+00	TO STA. 179+00
PROJECT NAME MORETOWN	NO. RS E6CRS0167 (9)
SURVEYED BY MOREAU	PLOTTED 04/15/87
SHEET 22 OF 243 SHEETS	01/86 0039