


502.57

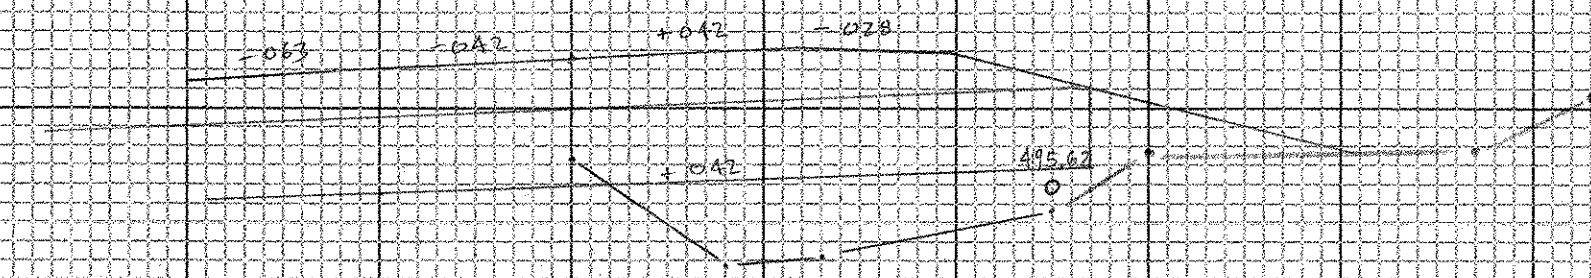

192.75

DRILLING & BLASTING SUBGRADE

# CROSS SECTION SHEET

PROJECT NAME: \_\_\_\_\_  
PROJECT NUMBER: \_\_\_\_\_  
FILE NAME: M 192.75 PLOT DATE: 05-JUN-2000 09  
PROJECT LEADER: \_\_\_\_\_ DRAWN BY: STW  
DESIGNED BY: \_\_\_\_\_ CHECKED BY: \_\_\_\_\_  
const: g:/common/cadd/e-xsection.dgn SHEET 92A OF \_\_\_\_\_