


198+67 Lt.
Combo pole
227
2

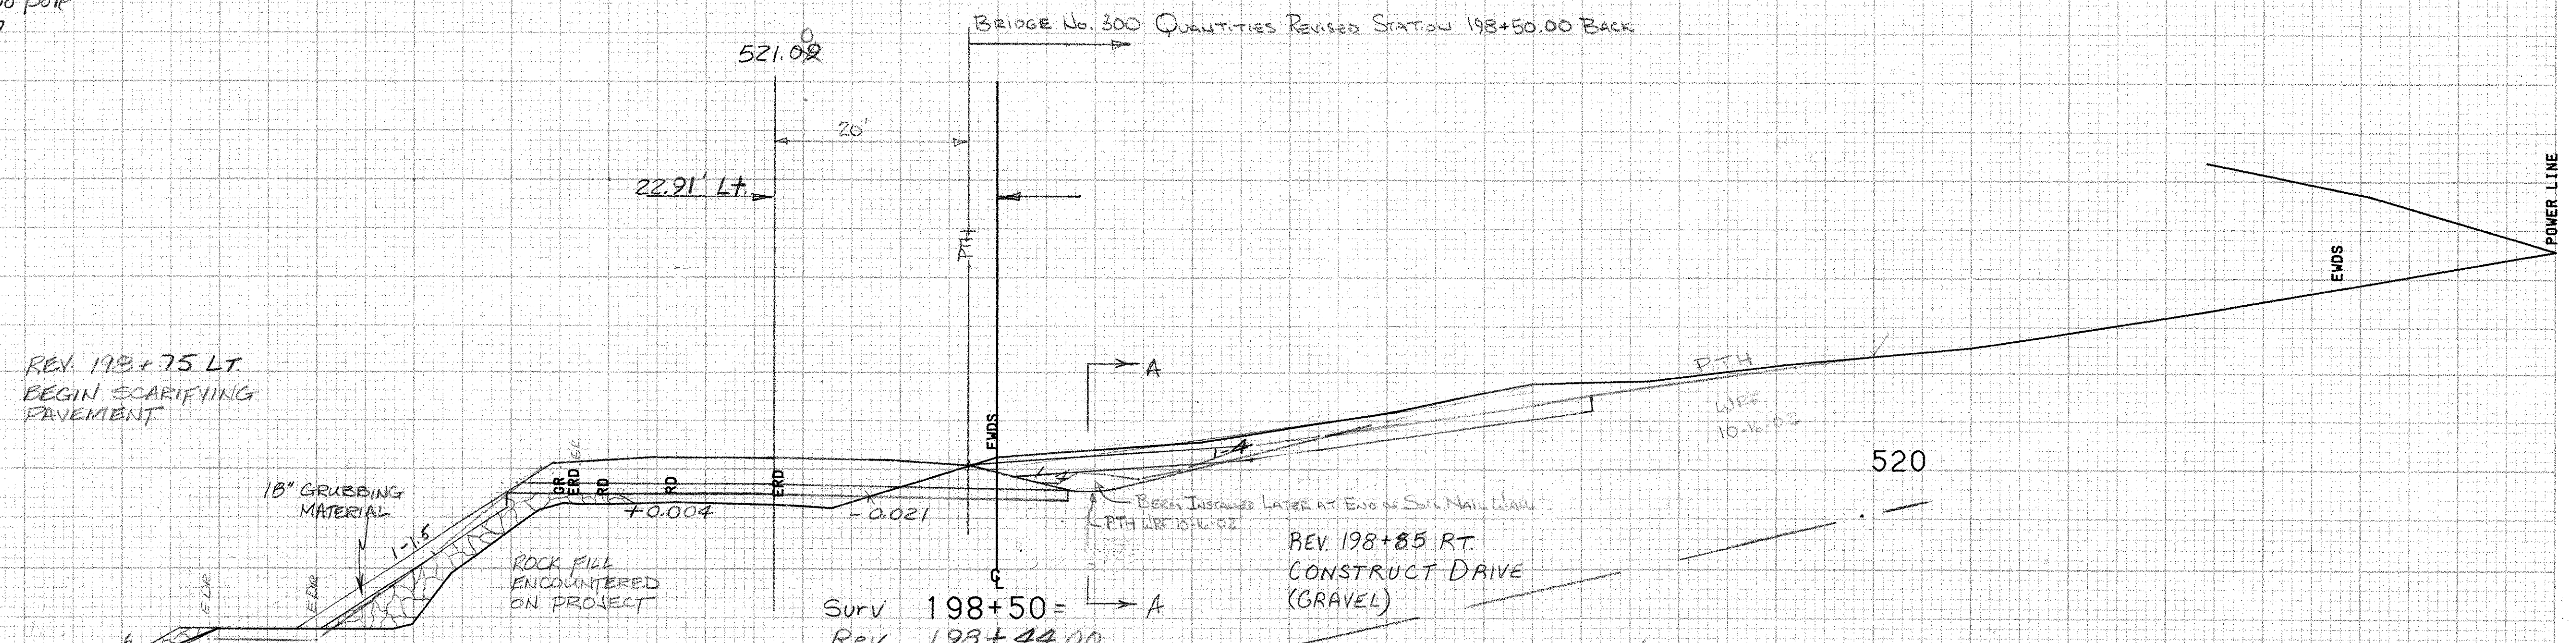

REV. 198+75 LT.
BEGIN SCARIFYING
PAVEMENT

18" GRUBBING
MATERIAL

ROCK FILL
ENCOUNTERED
ON PROJECT

SEE STANDARD
E-5 FOR DETAILS

Surv 198+50=
Rev 198+44.00

REV. 198+85 RT.
CONSTRUCT DRIVE
(GRAVEL)

198+50 Rt.
Gate For Woven Wire Fence (16' wide)
(2-8' Gates w/ opening in middle)

FROM STA. 198+50	TO STA. 198+50
PROJECT NAME MORETOWN-MIDDLESEX	NO. RS 500
SURVEYED BY MOREAU	RS0167 (9)
SHEET 100 OF 243 SHEETS	PLOTTED 02/29/88
	01/86 0105

SCALE 1" = 10 FEET