


Surv 200+22 =
Rev 200+16.51

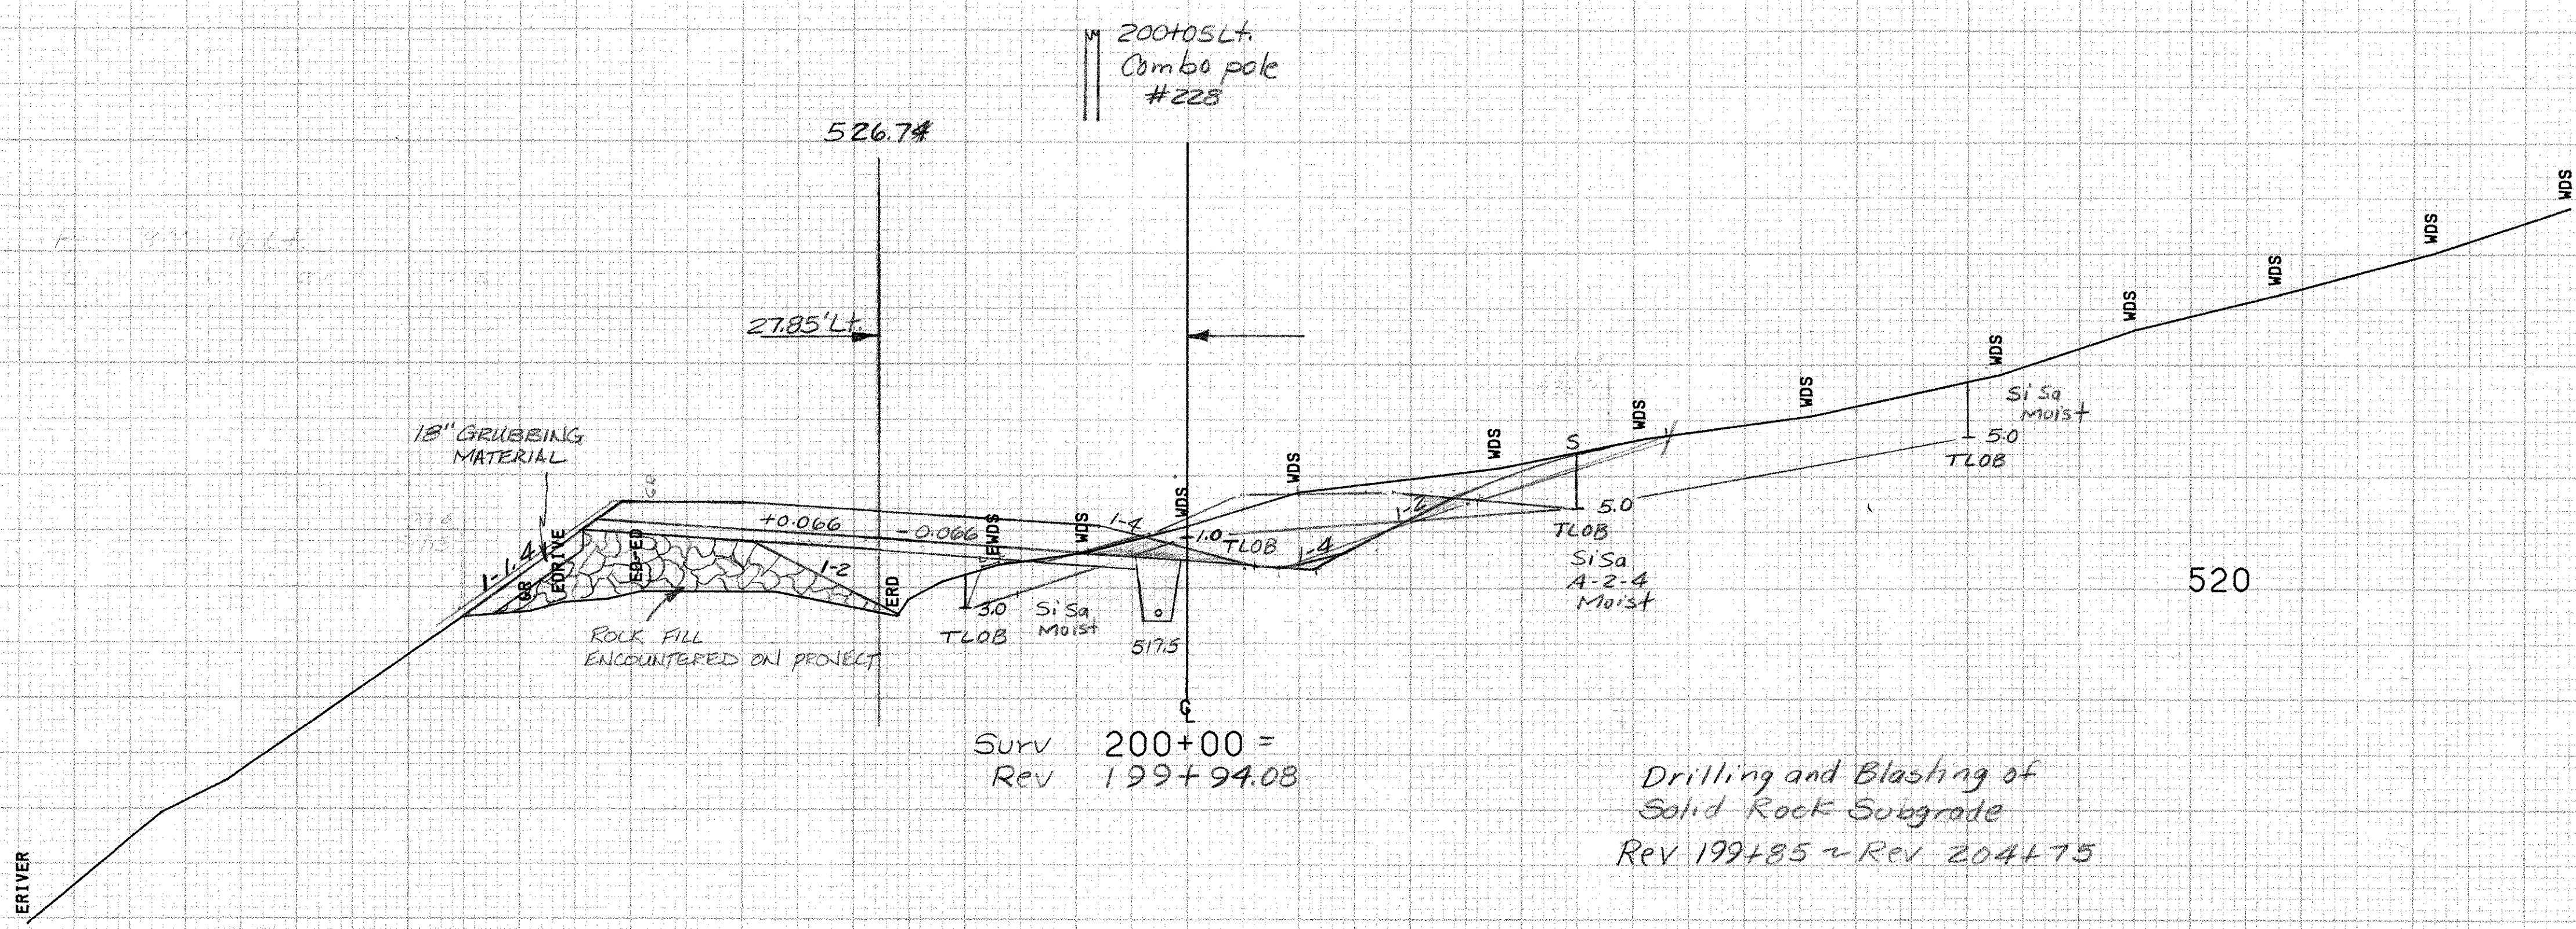

Surv 200+00 =
Rev 199+94.08

Drilling and Blasting of
Solid Rock Subgrade
REV 199+85 ~ REV 204+75

FROM STA. 200+00 TO STA. 200+22
PROJECT NAME MORETOWN-MIDDLESEX
NO. RS E.C. RS0167 (9) PLOTTED 02/29/88
SURVEYED BY NYE 01/85 0105
SHEET 102 OF 243 SHEETS

SCALE 1" = 10 FEET