


520

Drilling and Blasting of
Solid Rock Subgrade
Rev 205+25 ~ Rev 207+25

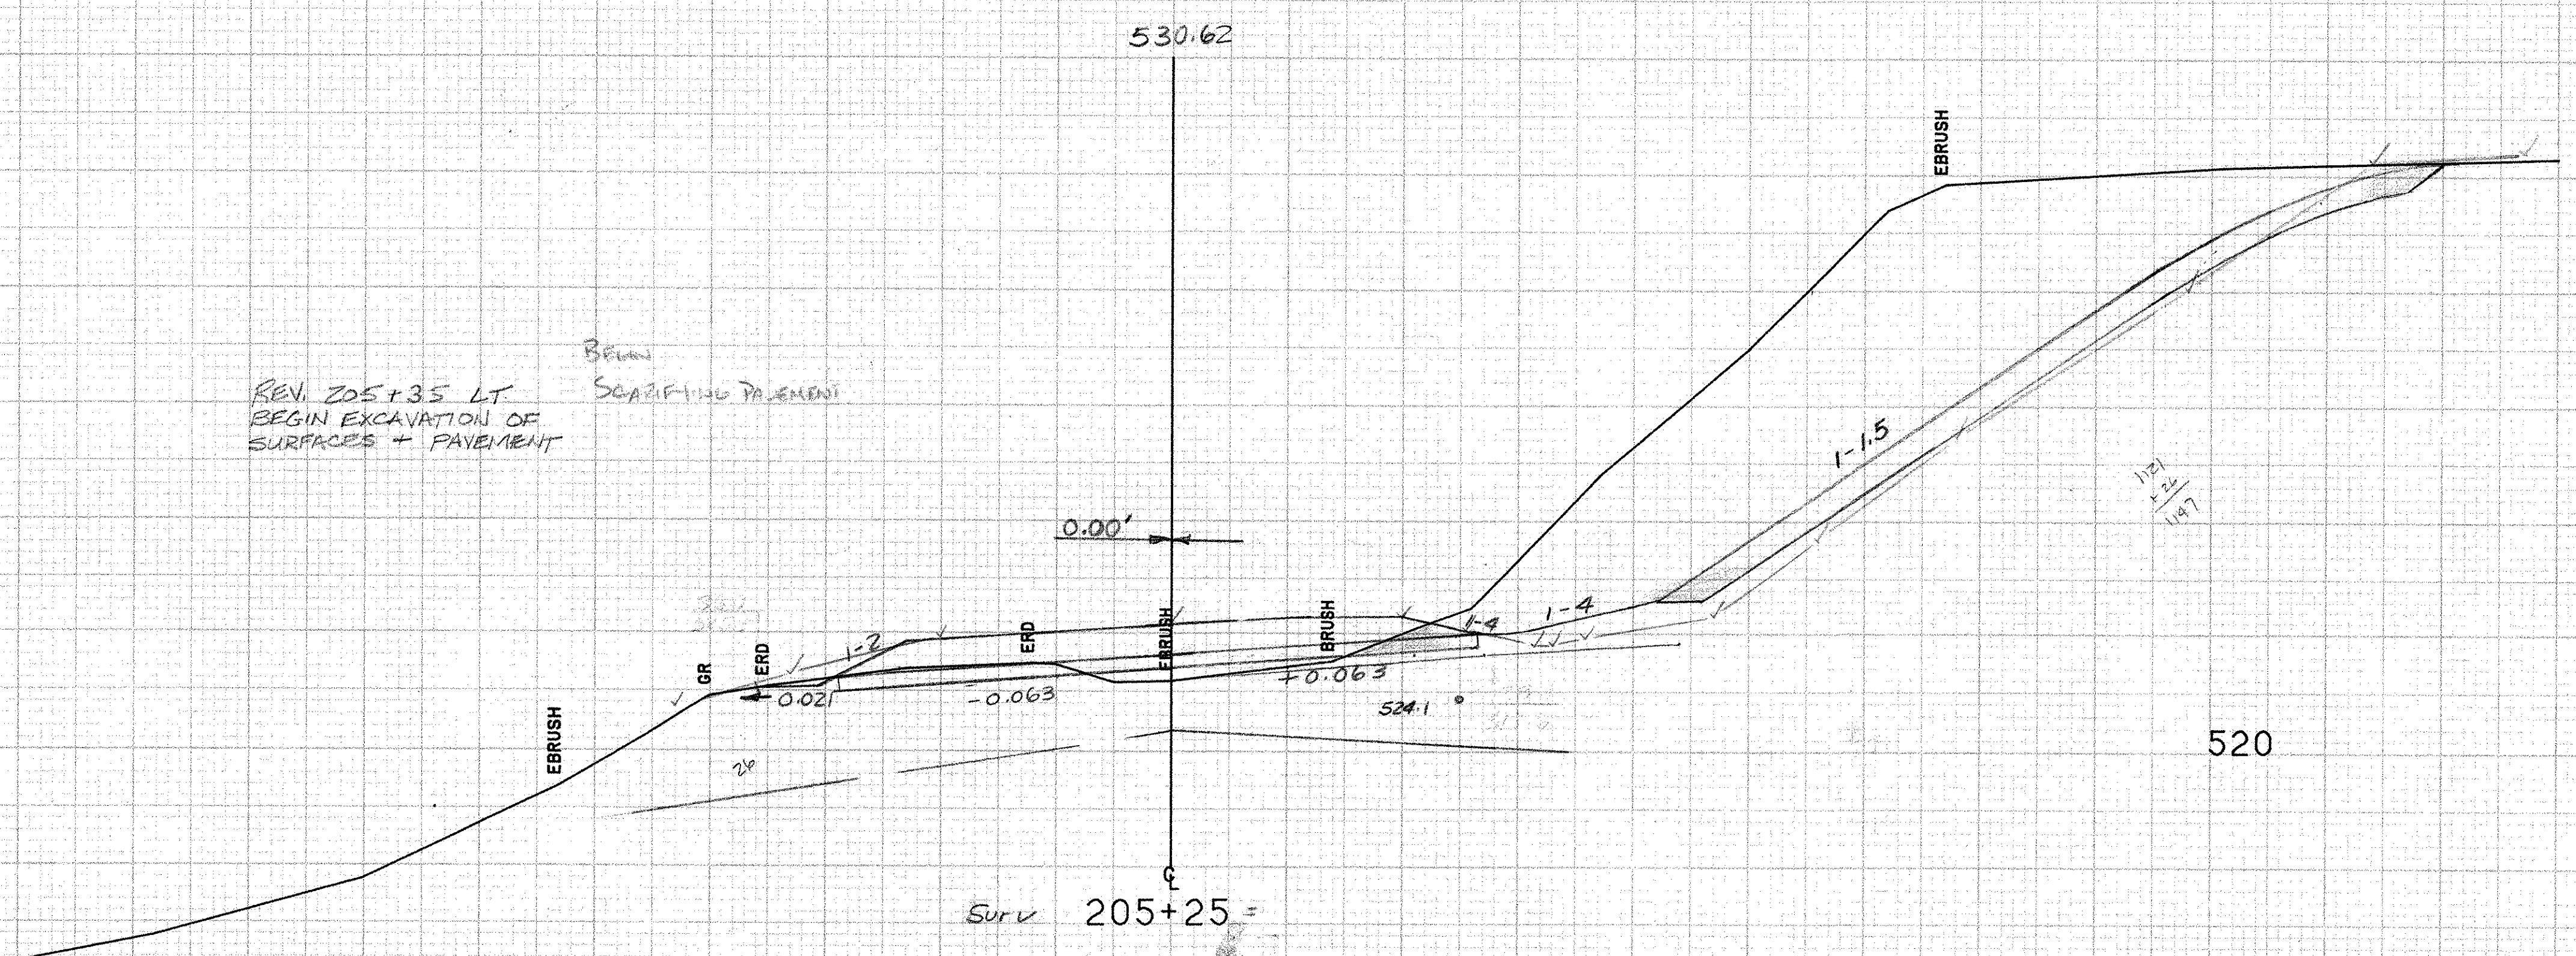

520

FROM STA.	205+25	TO STA.	205+48.50
PROJECT NAME	MORETOWN-MIDDLESEX		PLOTTED 02/29/88
NO.	RS 66	CRS	0167 (9)
SURVEYED BY	NYE		01/85 0105
SHEET	110	OF	243 SHEETS

SCALE 1" = 10 FEET