


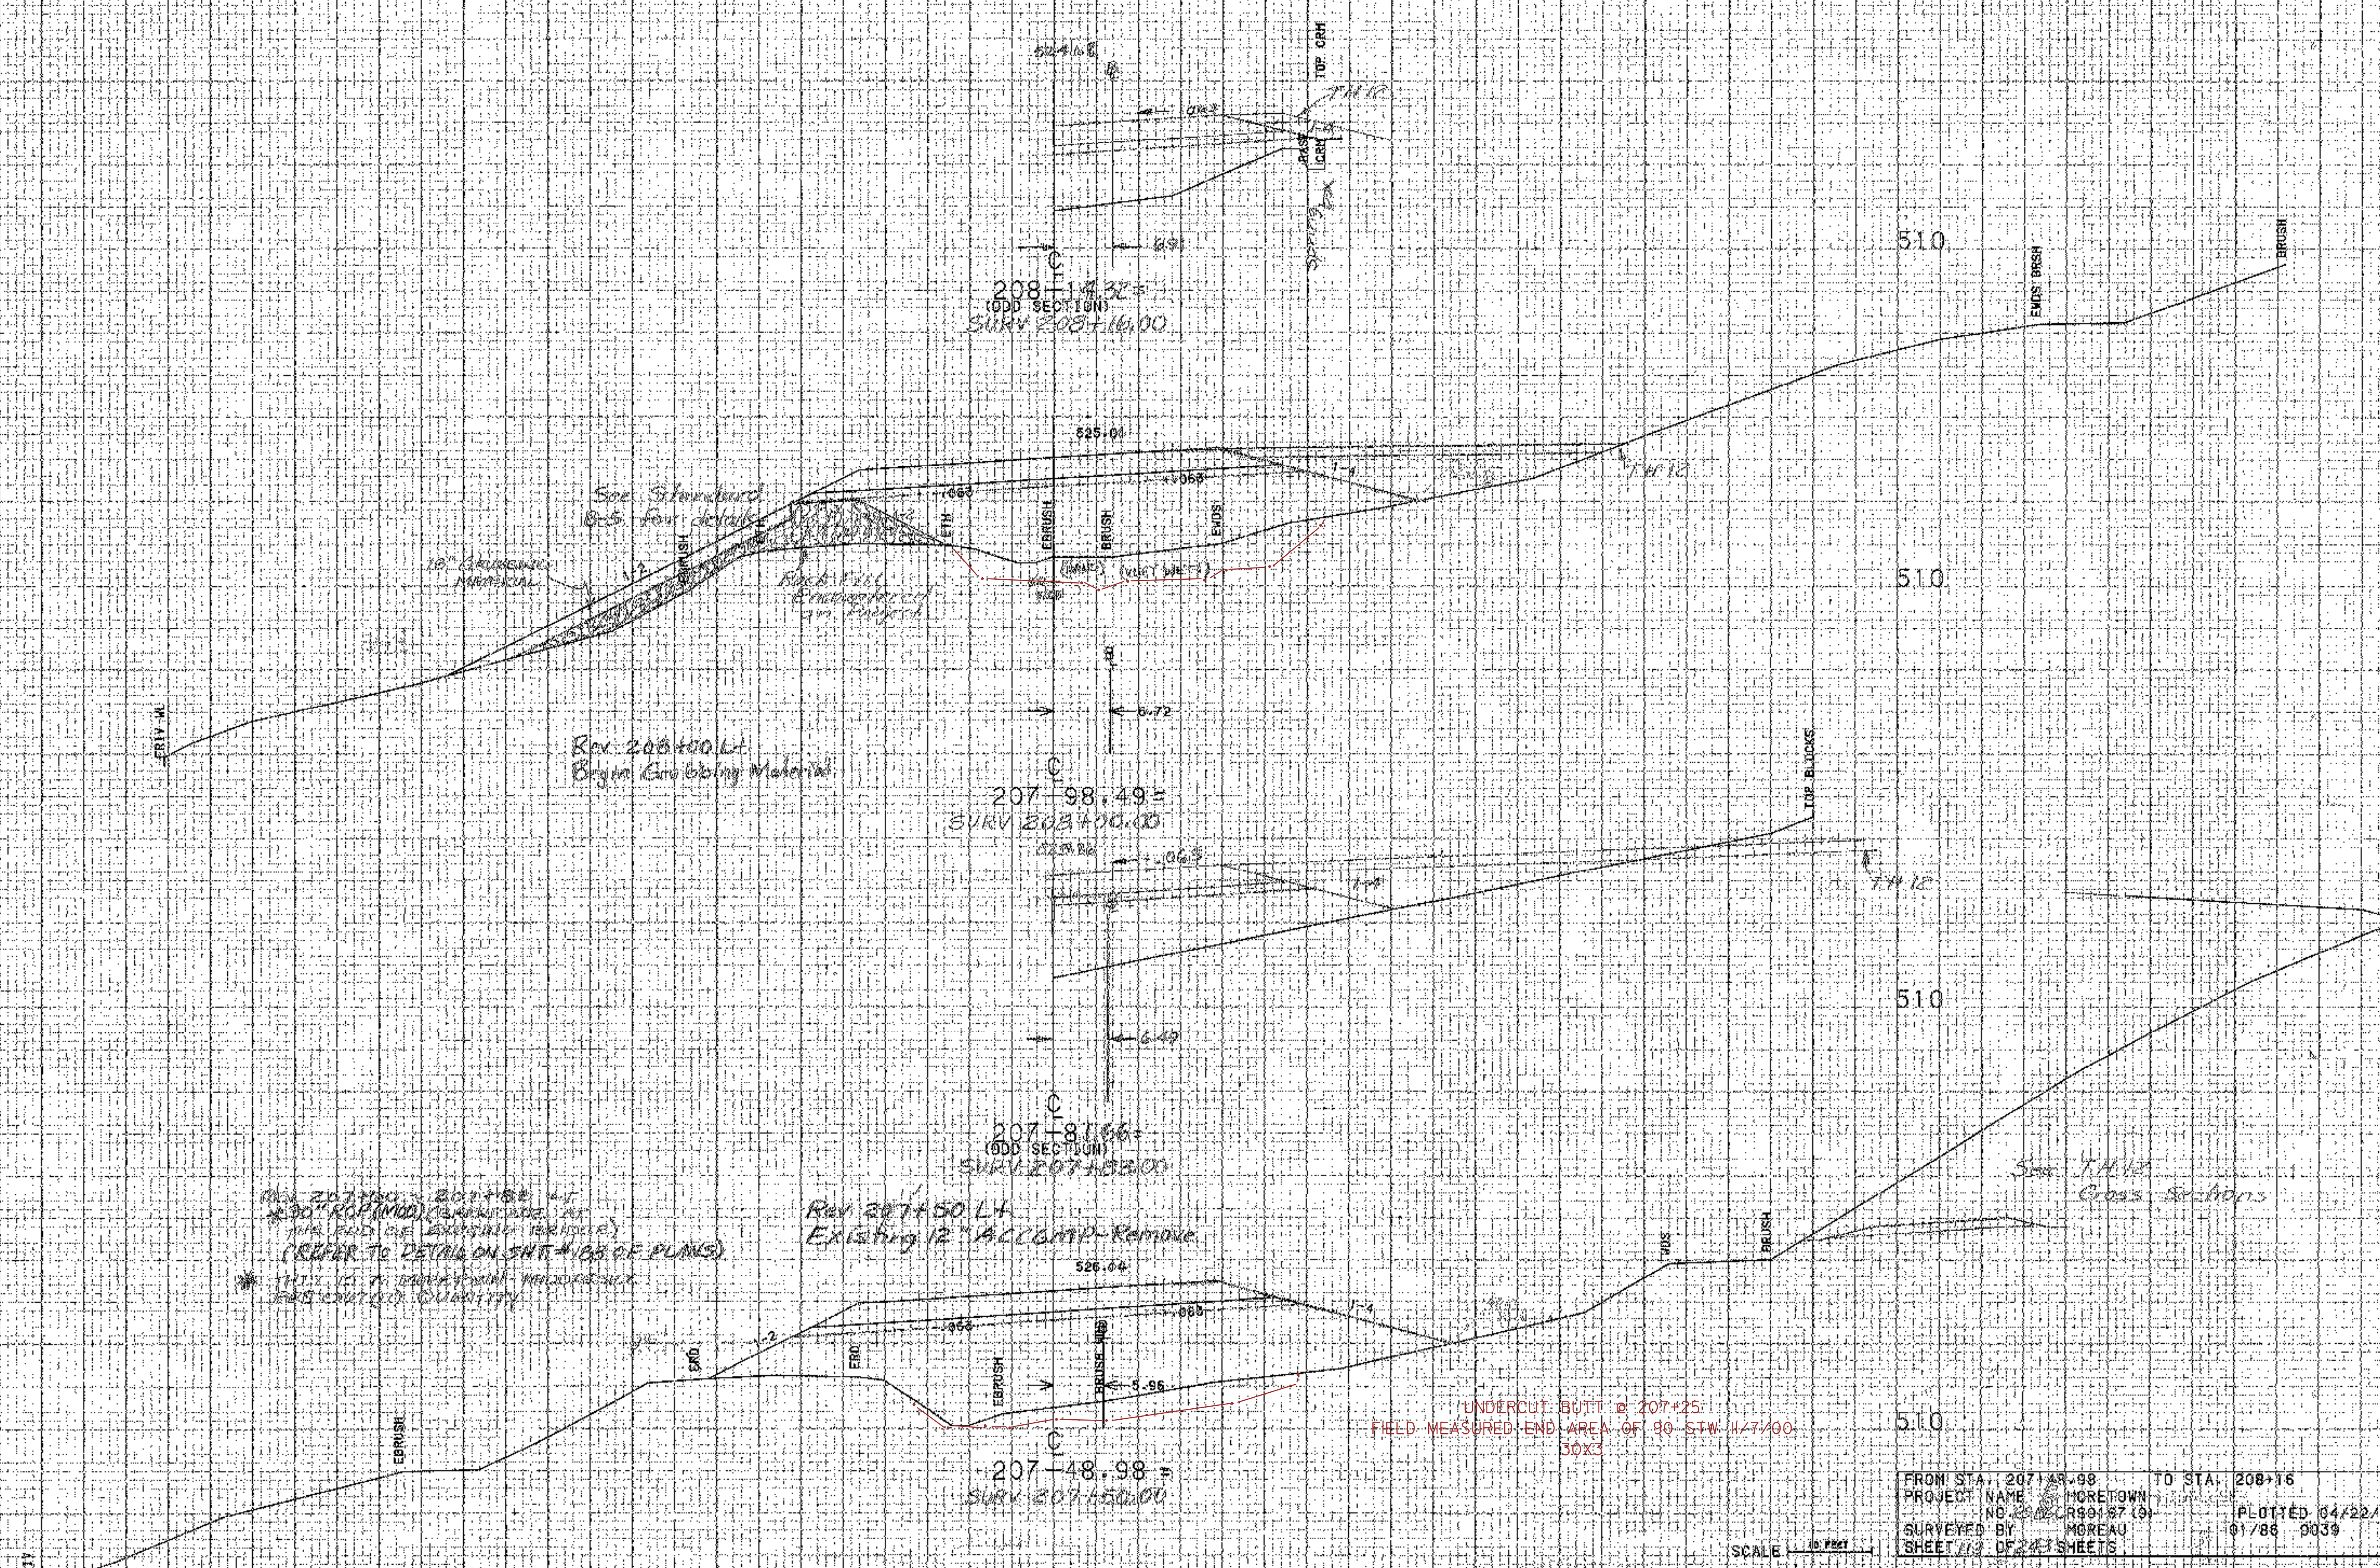

Rev 207+50 - 207+80 LH
*30" ROP (MOD) (LAWYER'S OFFICE)
THIS END (SEE EXISTING TIE IN)
(REFER TO DETAIL ON SHEET # 63 OF PLANS)
* 10' CRUSHED MATERIAL
* 50% STONE/BRUSH
* 10' CRUSHED MATERIAL

Rev 207+50 LH
Existing 12" ACCORD-Remove

UNDERCUT BUTT @ 207+25
FIELD MEASURED END AREA OF 90 STW 11/7/90
30x3

FROM STA. 207+48.98	TO STA. 208+16
PROJECT NAME MORETOWN	
NO. 2902 CR90187 (3)	PLOTTED 04/22/87
SURVEYED BY MOREAU	01/88 9039
SHEET 12 OF 24 SHEETS	

SCALE 1" = 10' HORIZ