

Rev 210+28 Rt
Begin Aluminum Approach Rail (Mod #1) (25')


TH 2 30+73 Lt ~ Rev 210+28 Rt.
Aluminum Approach Rail (Mod #2) (75')

Rev. 210+04.07 ~ Rev 210+54.07
Granular Borrow
(TO BE PAID FOR UNDER PROJECT
MORERTOWN-MIDDLESEX BR50167(11))

REV. 210+00 LT
NEW 18' x 14' PCCSP (.064), CPBP
CAAP (.060)

Rev 210+06 Lt.
End Aluminum Approach Rail (Mod #1) (25')
Begin Bridge Rail

Rev 210+06 Lt.
End Treated Timber Curb

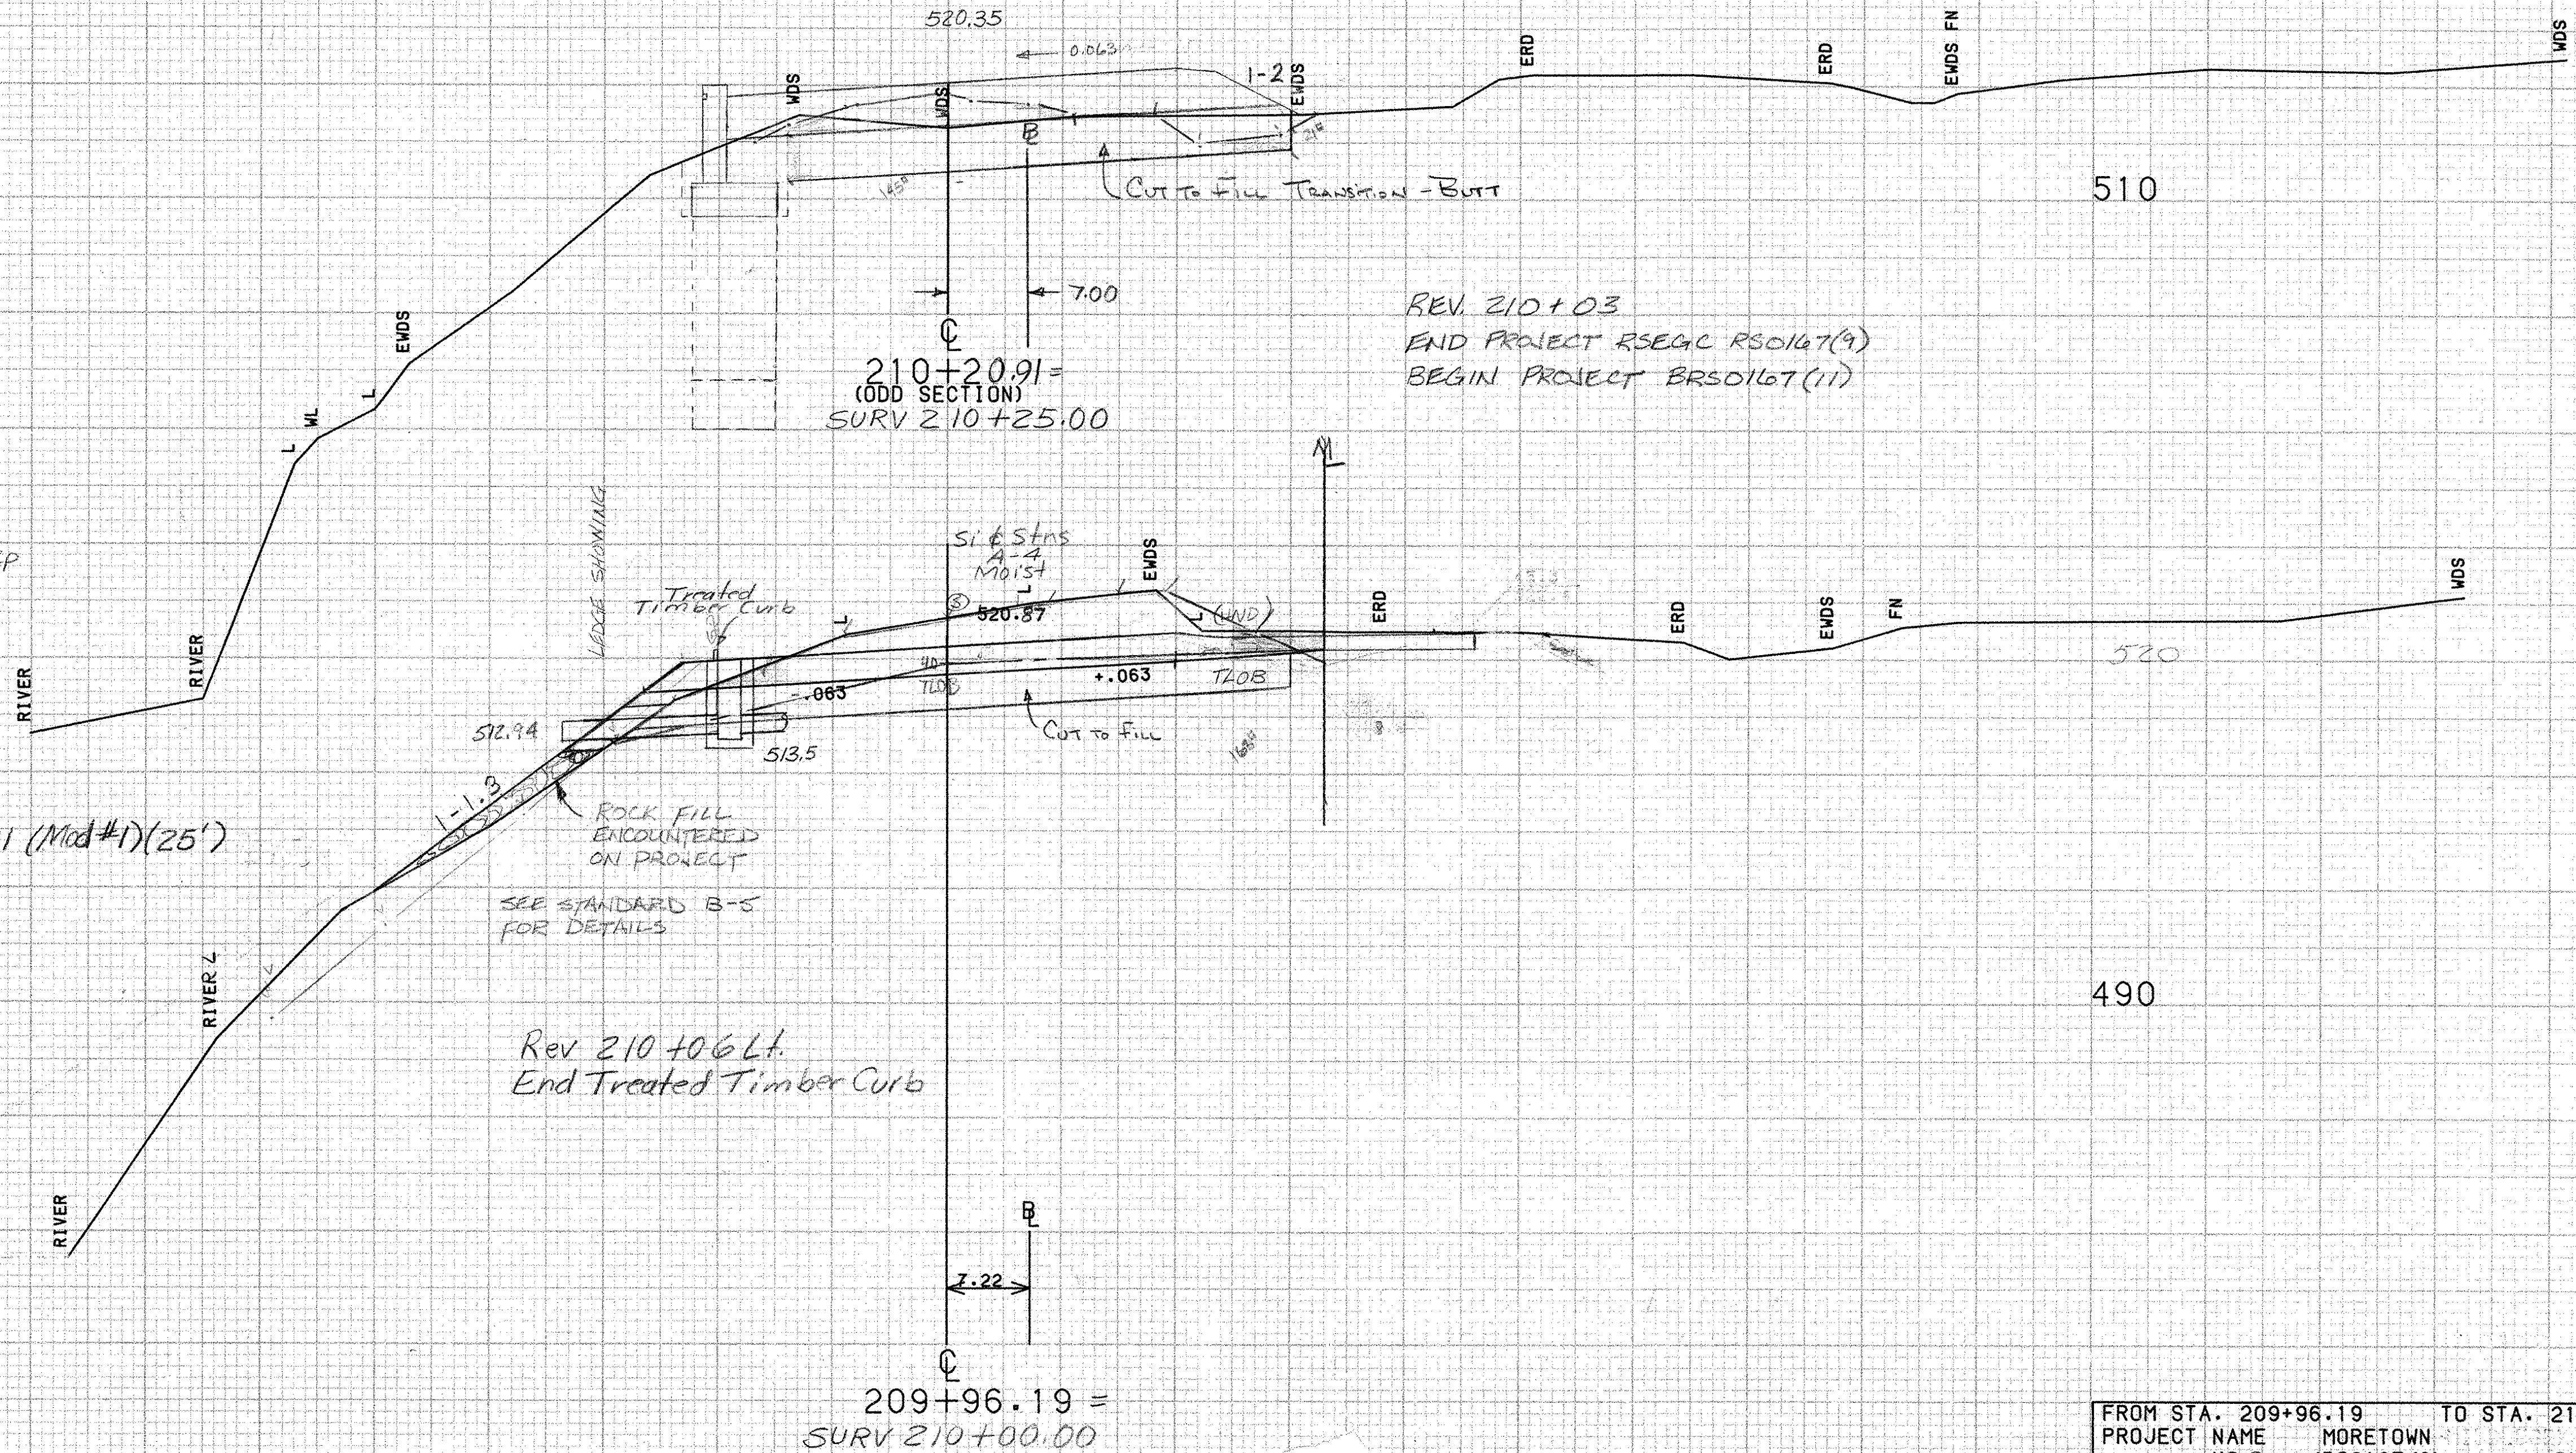

510

REV. 210+03
END PROJECT R5EGC R50167(9)
BEGIN PROJECT BR50167(11)

520

490

SCALE 10 FEET

| | |
|-------------------------|------------------|
| FROM STA. 209+96.19 | TO STA. 210+25 |
| PROJECT NAME MORETOWN | |
| NO. R5EGC (R50167) (9) | PLOTTED 04/22/87 |
| SURVEYED BY MOREAU | 01/86 0039 |
| SHEET 116 OF 213 SHEETS | |