


3400 ~ 32+54 LT  
Removal and Disposal  
of Guard Rail

30+75 LT  
BEGIN EXCAVATION OF  
SURFACES AND PAVEMENTS  
(AREA TO BE TOPSOILED,  
SEEDED, AND MULCHED)

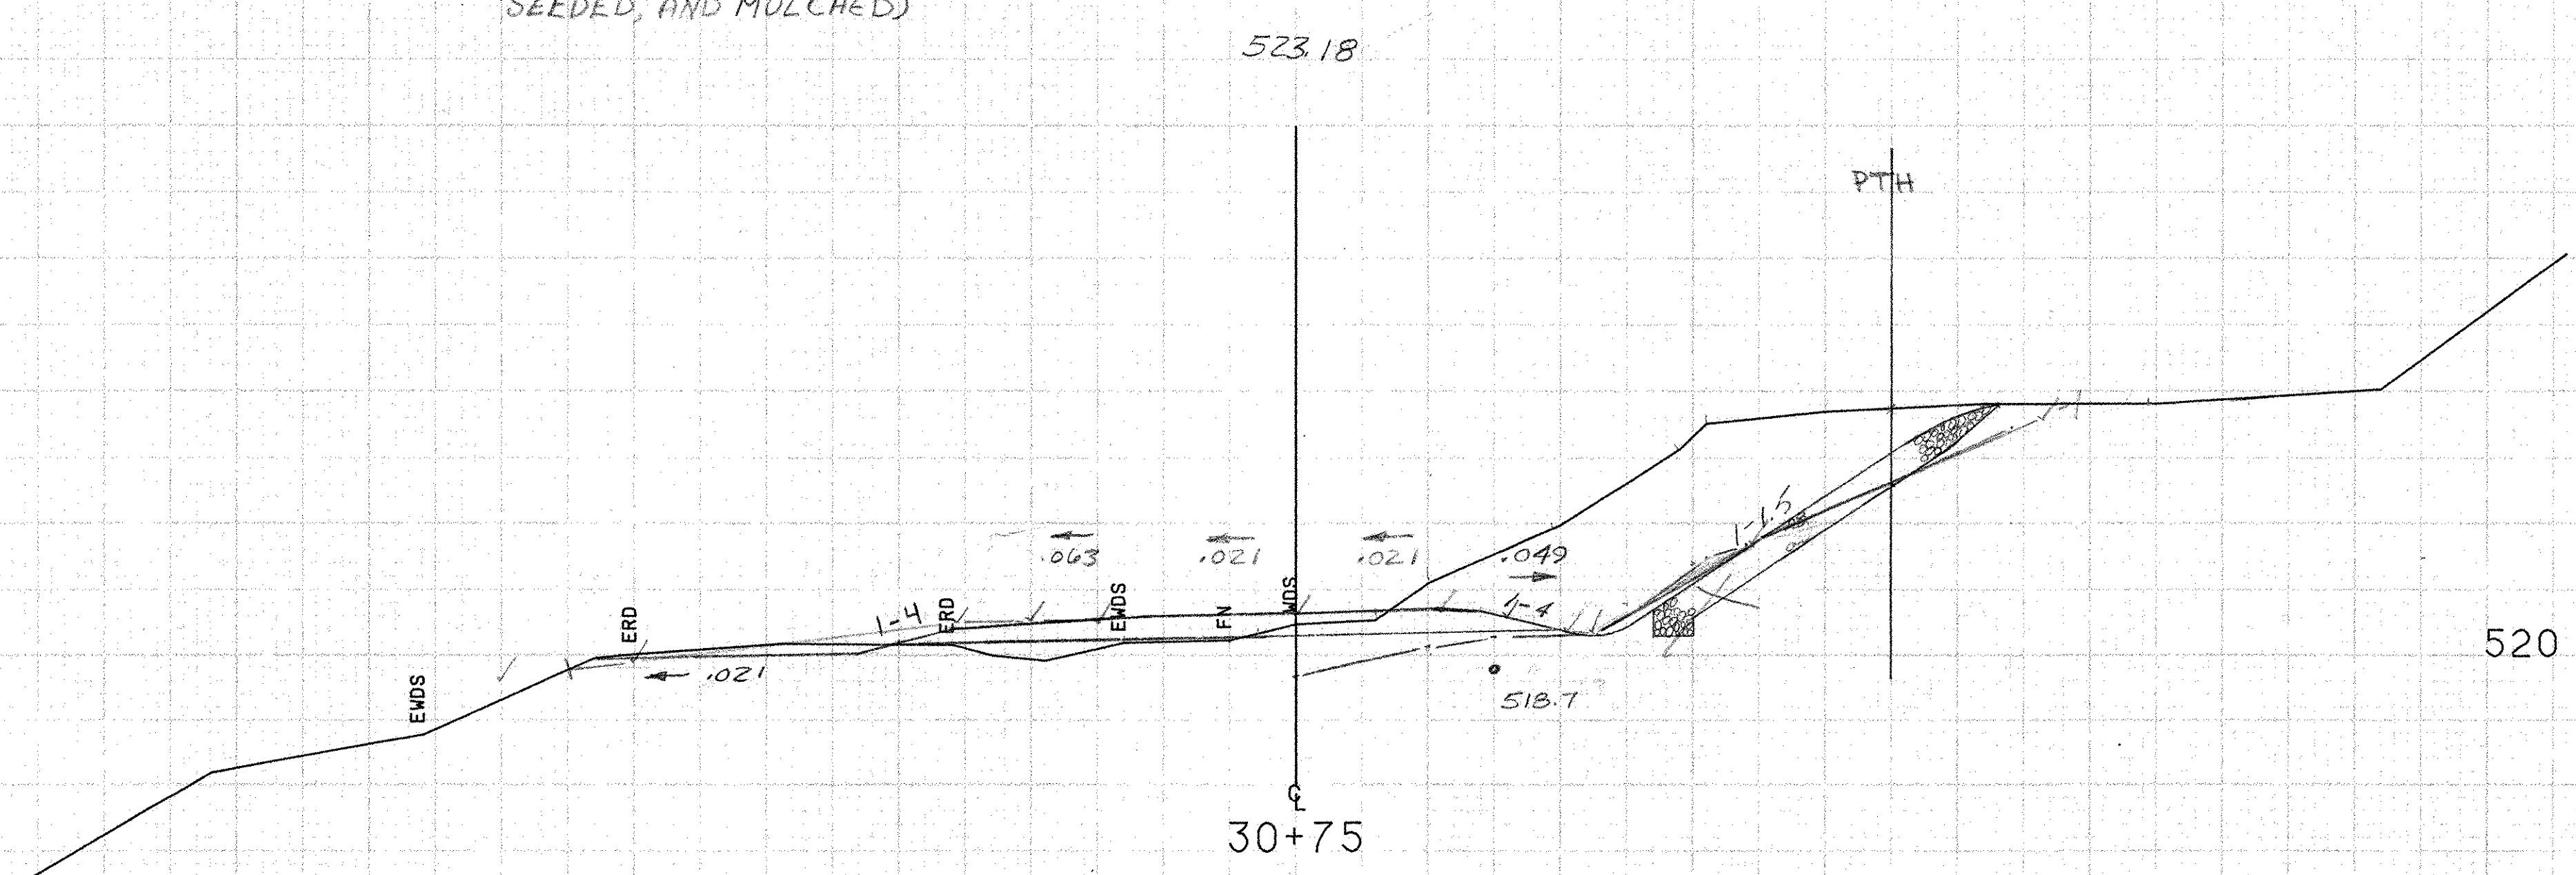

FROM STA.	30+75	TO STA.	31+00
PROJECT NAME	MORETOWN-TWOBBLE EX TH2		
NO.	RS EG CRS0167 (9)	DATE	PLOTTED 06/09/86
SURVEYED BY	NYE	DATE	JAN 1985
SHEET	119	OF	243 SHEETS

SCALE 1" = 10 FEET