


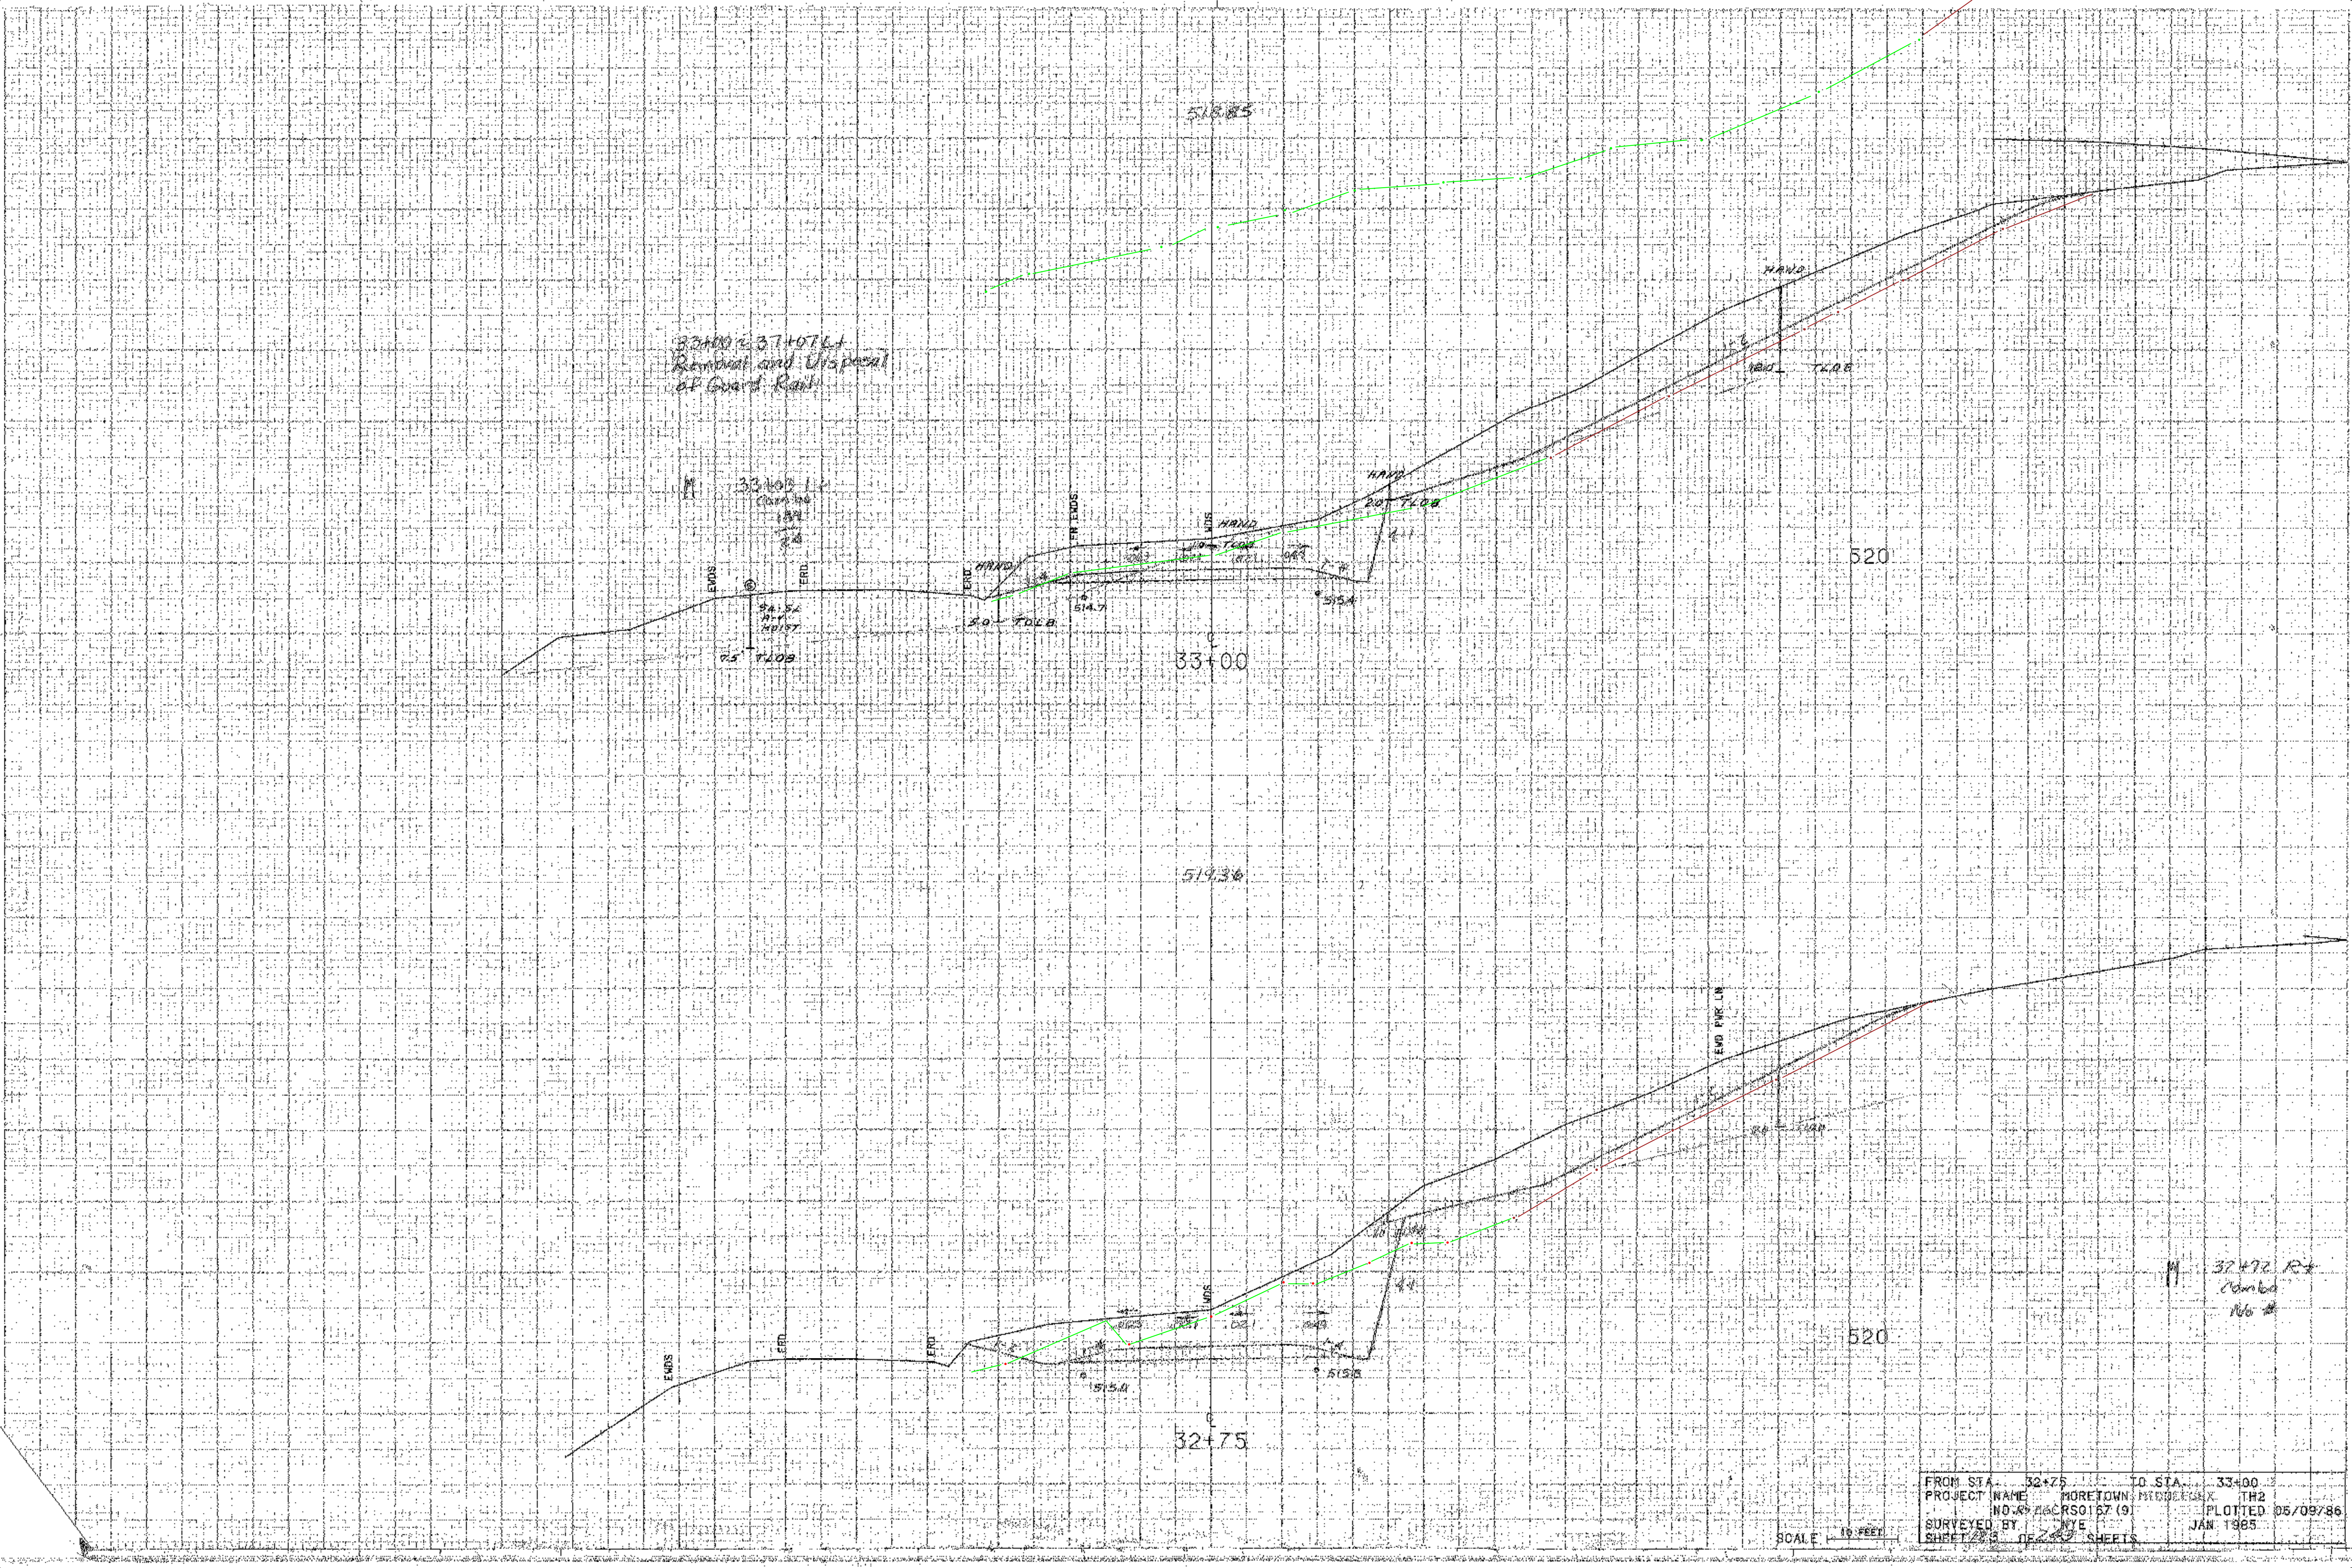

32+00 to 37+00
Removal and Disposal
of Guard Rail

32+00 L
Clearance
18' 4"
2' 6"

END
7.5' TOLB
54.5' H.P.
H.P. 157

END
3.0' TOLB
514.7'

END
HAND
10' TOLB
515.4'

END
HAND
20' TOLB
515.4'

HAND
12' TOLB
520'

END PUR

32+72 R+
Camber
No #

FROM STA. 32+75 TO STA. 33+00
PROJECT NAME: MORETOWN PROJECT
NO. 26 CRS0167 (9) TH2
SURVEYED BY: NYE PLOTTED 05/09/86
SHEET 23 OF 252 SHEETS JAN 1985

SCALE 1" = 10 FEET