



33+00 ~ 33+07 LT  
Removal and Disposal  
of Guard Rail

M 33+03 LT  
Combo  
189  
24

5a. 5c  
A-V  
MOIST  
7.5' TLOB

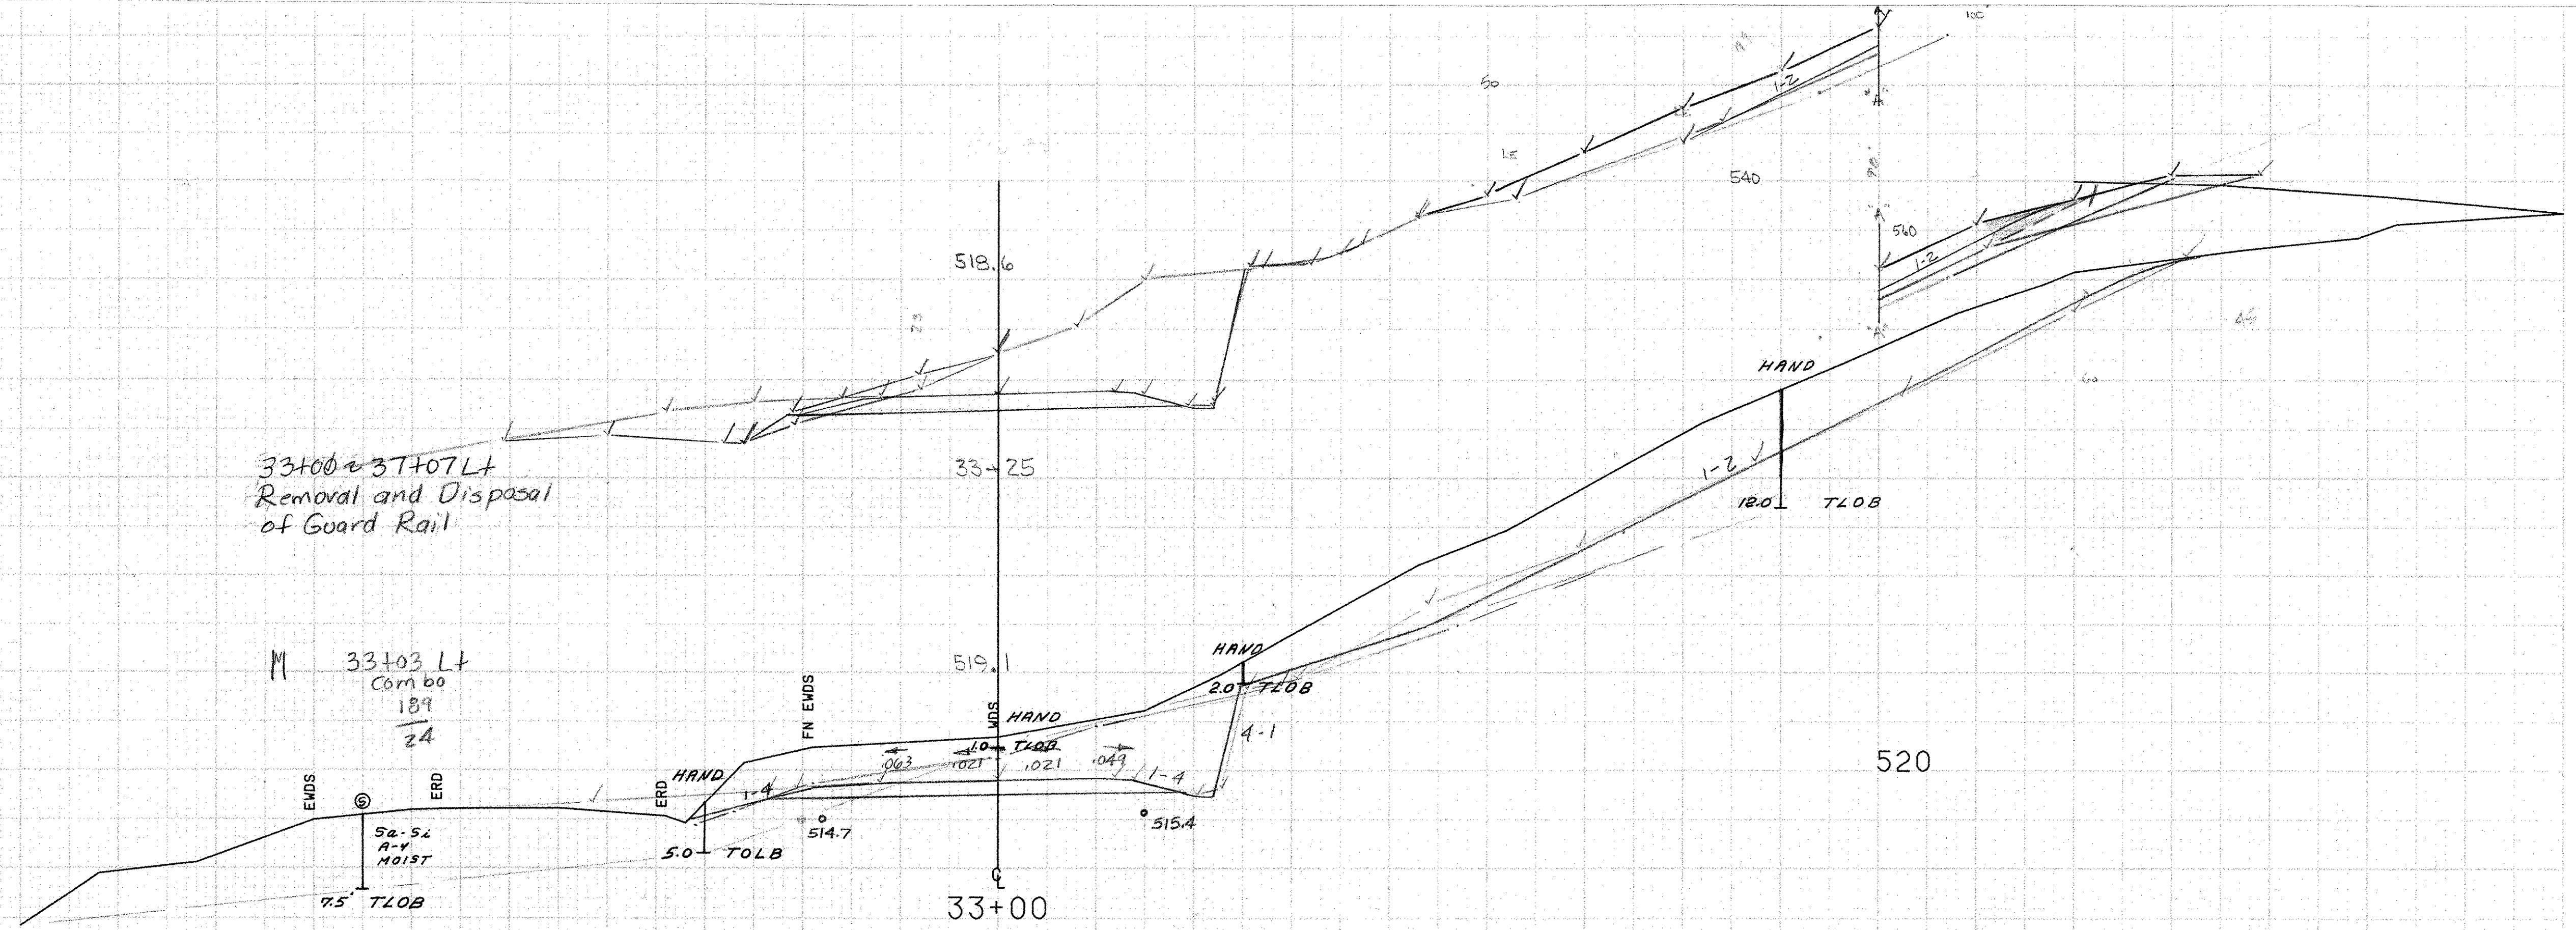

519.36

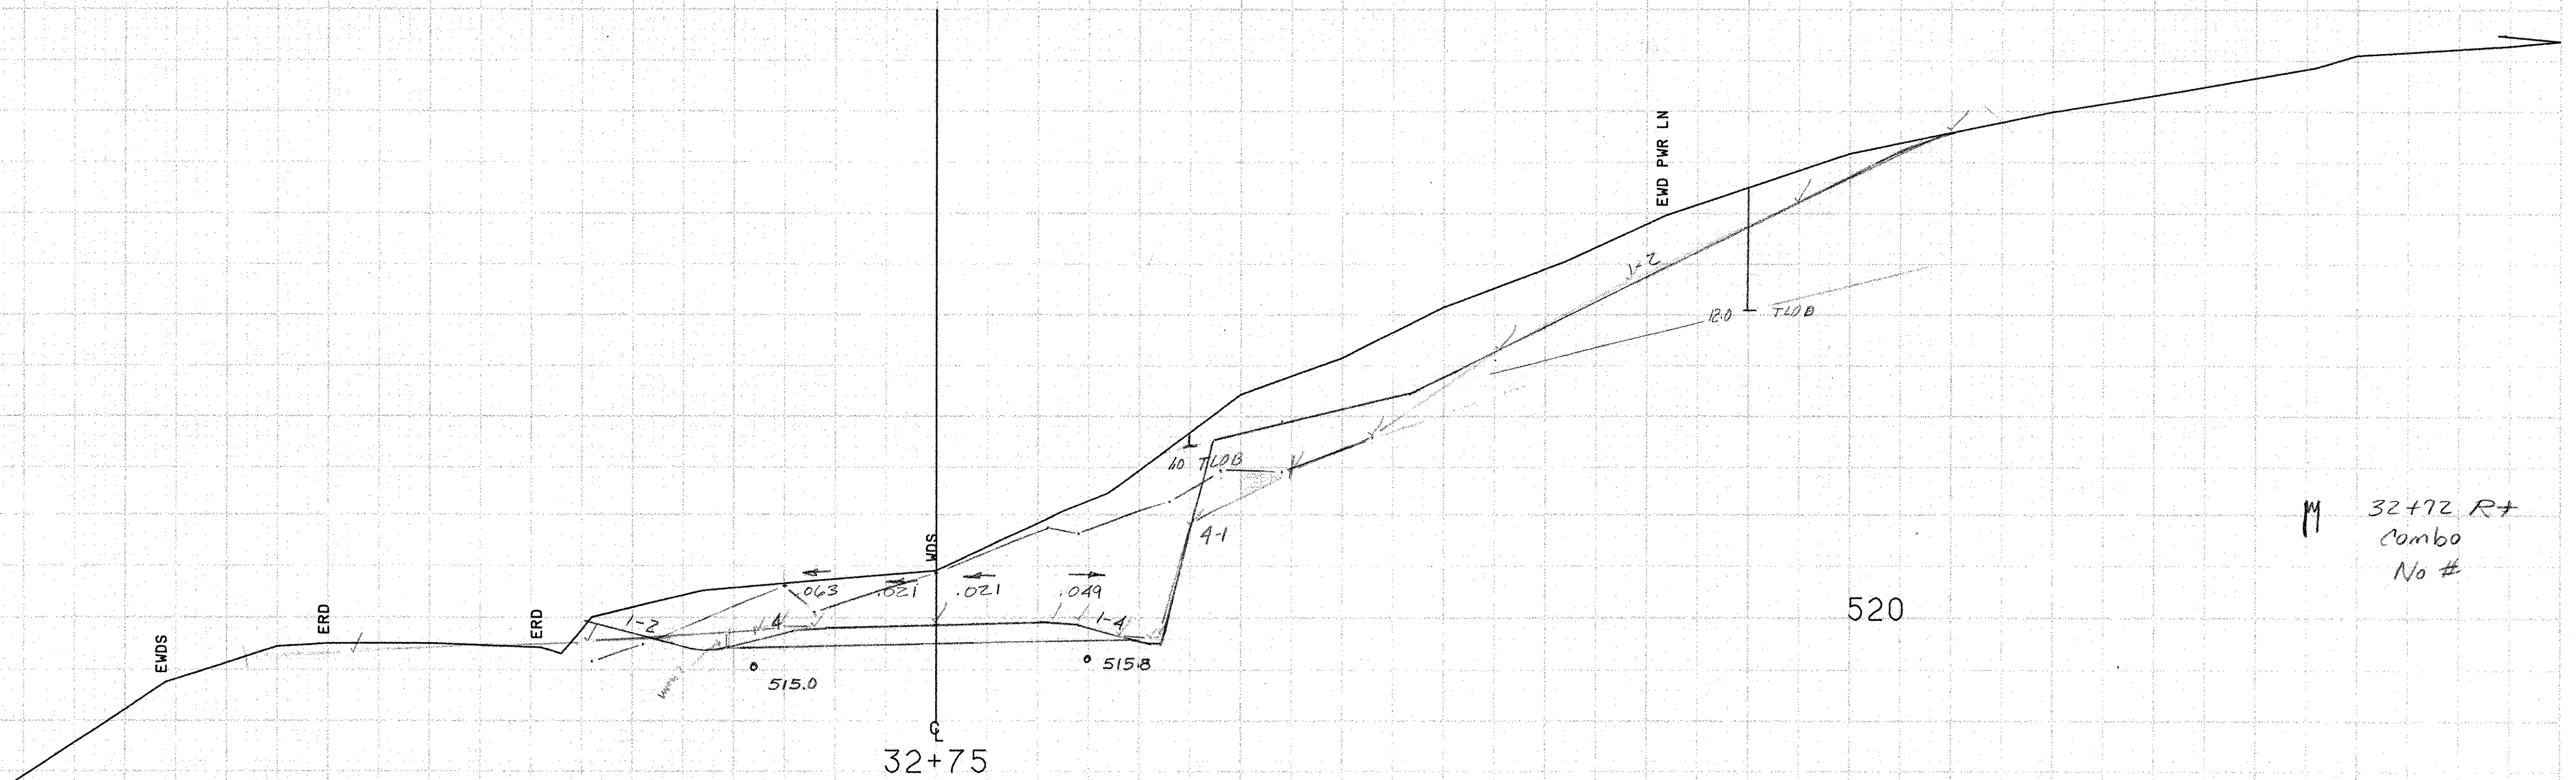

M 32+72 RT  
Combo  
No #

FROM STA. 32+75 TO STA. 33+00  
PROJECT NAME MORETOWN-MIDDLESEX TH2  
NO. 18 E6CRS0167 (9) PLOTTED 06/09/86  
SURVEYED BY NYE JAN 1985  
SHEET 23 OF 23 SHEETS

SCALE 1" = 10 FEET