
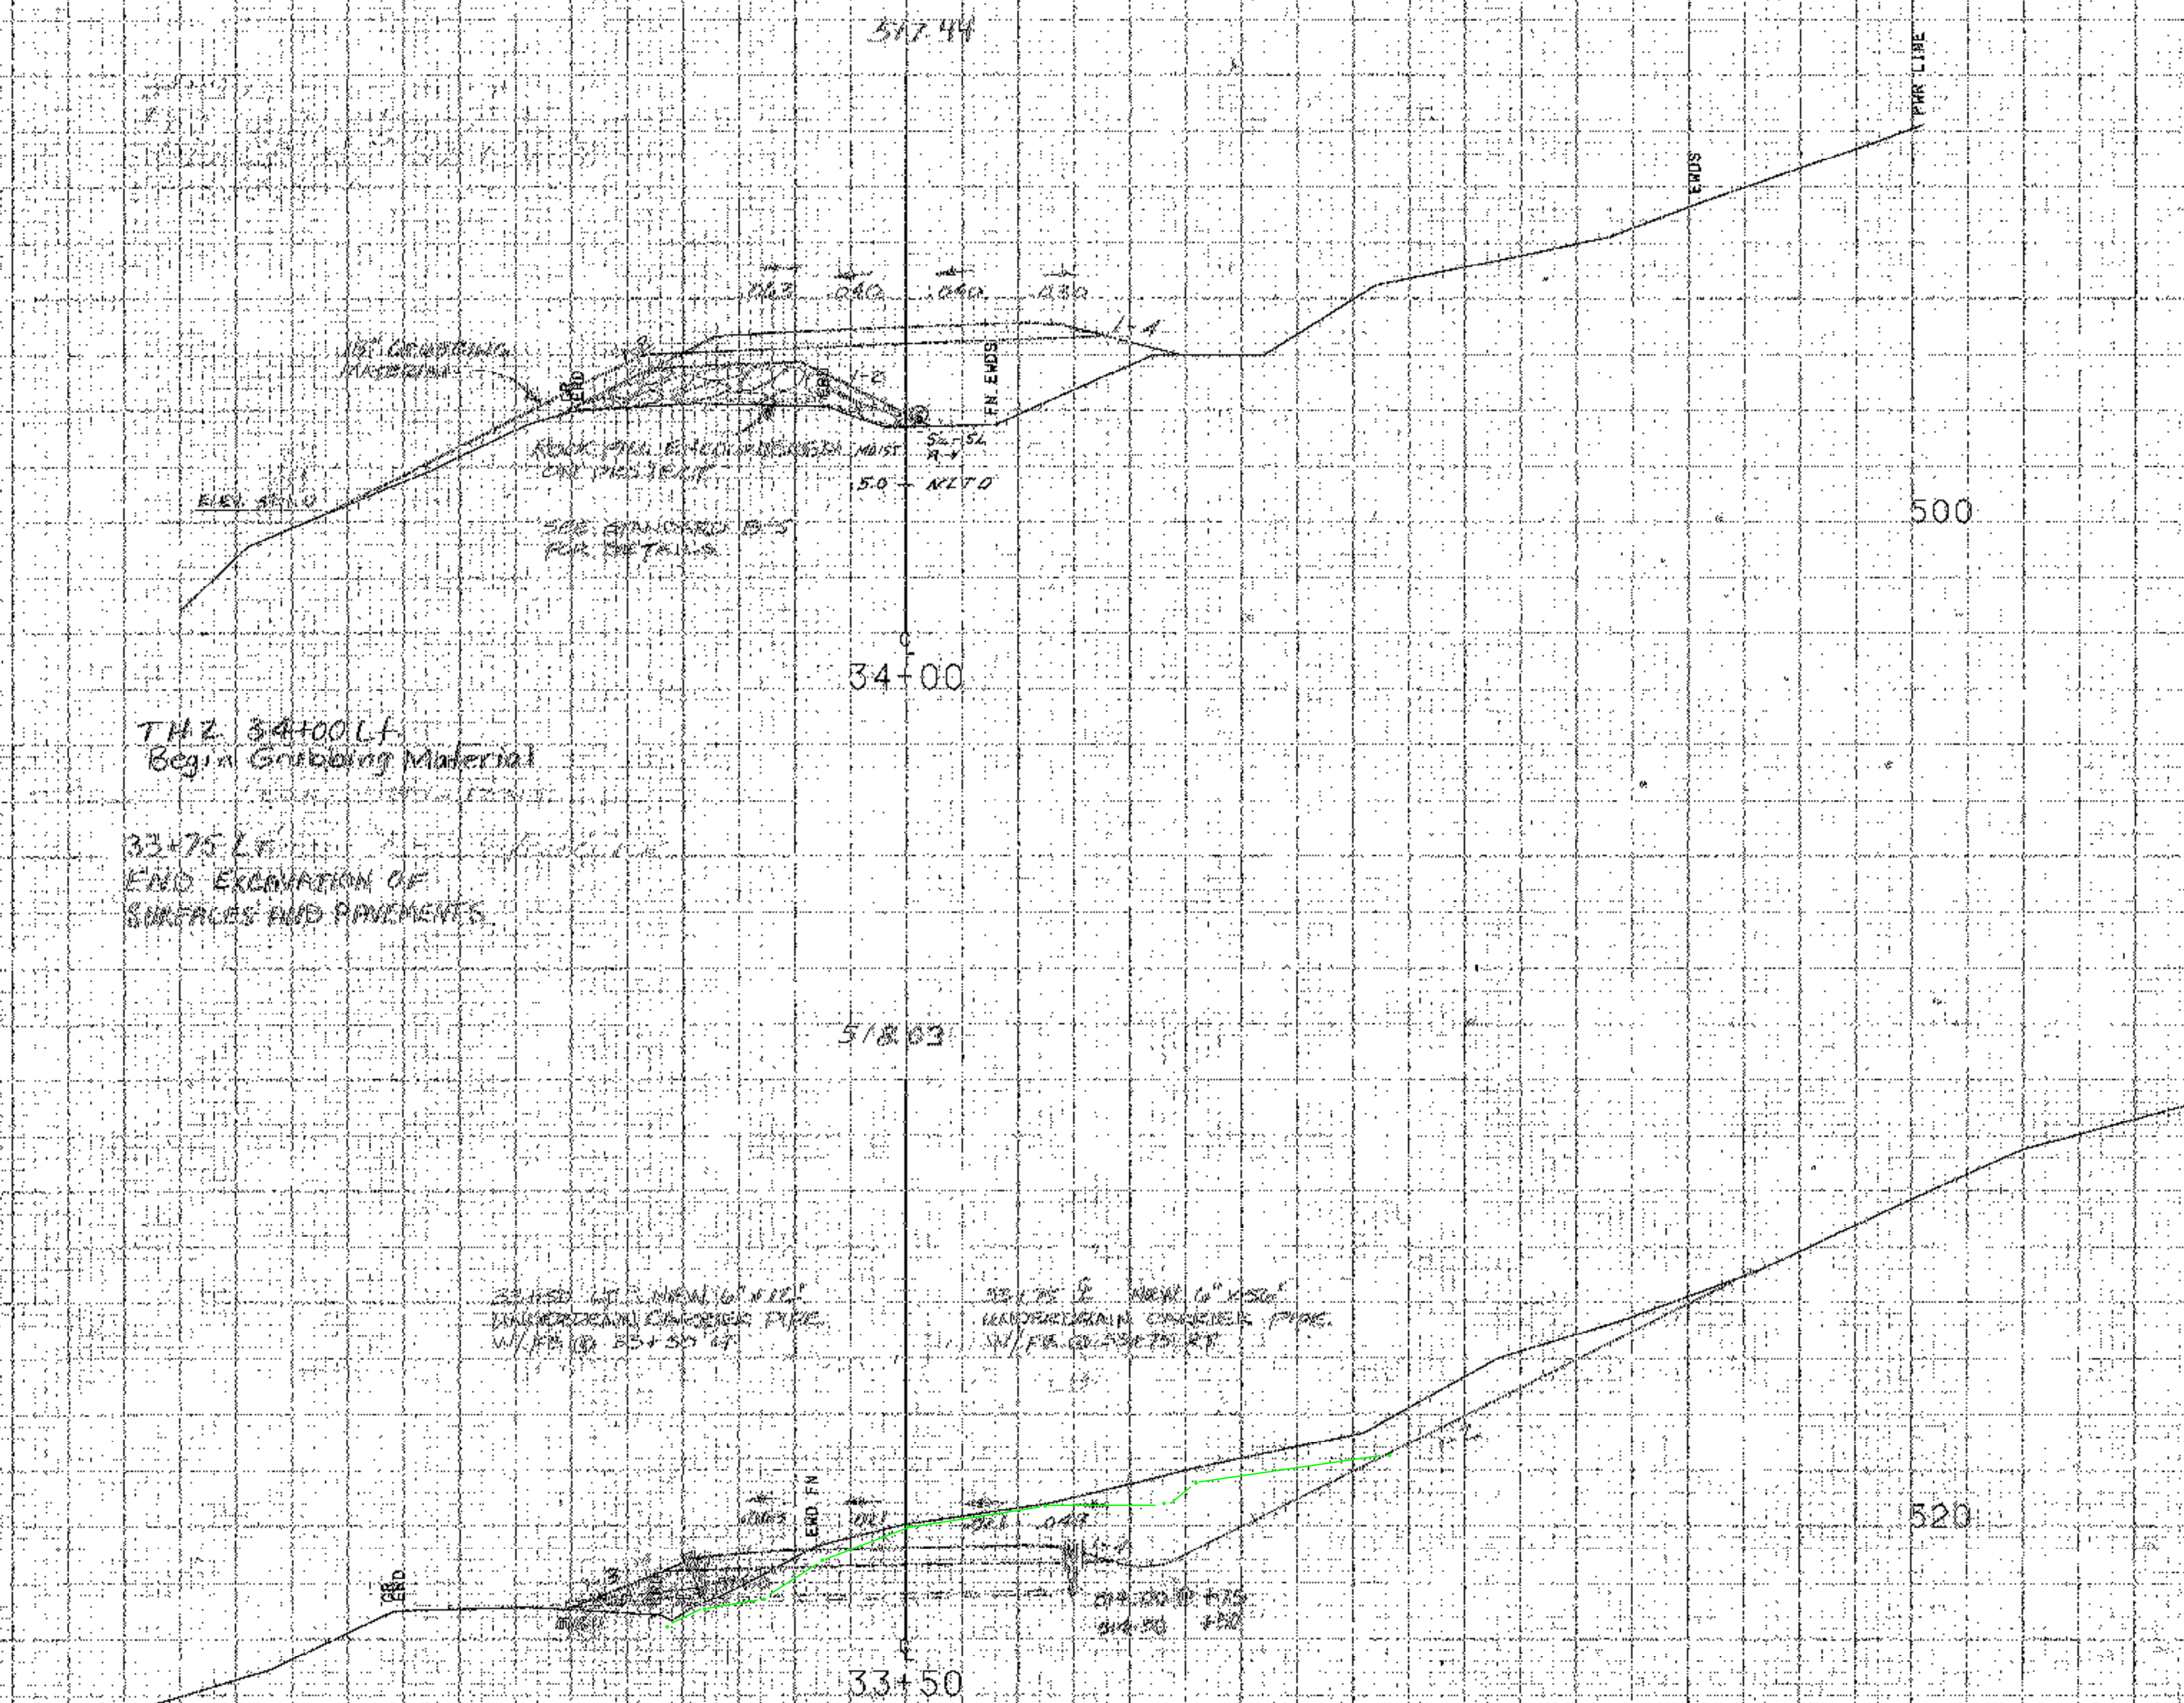


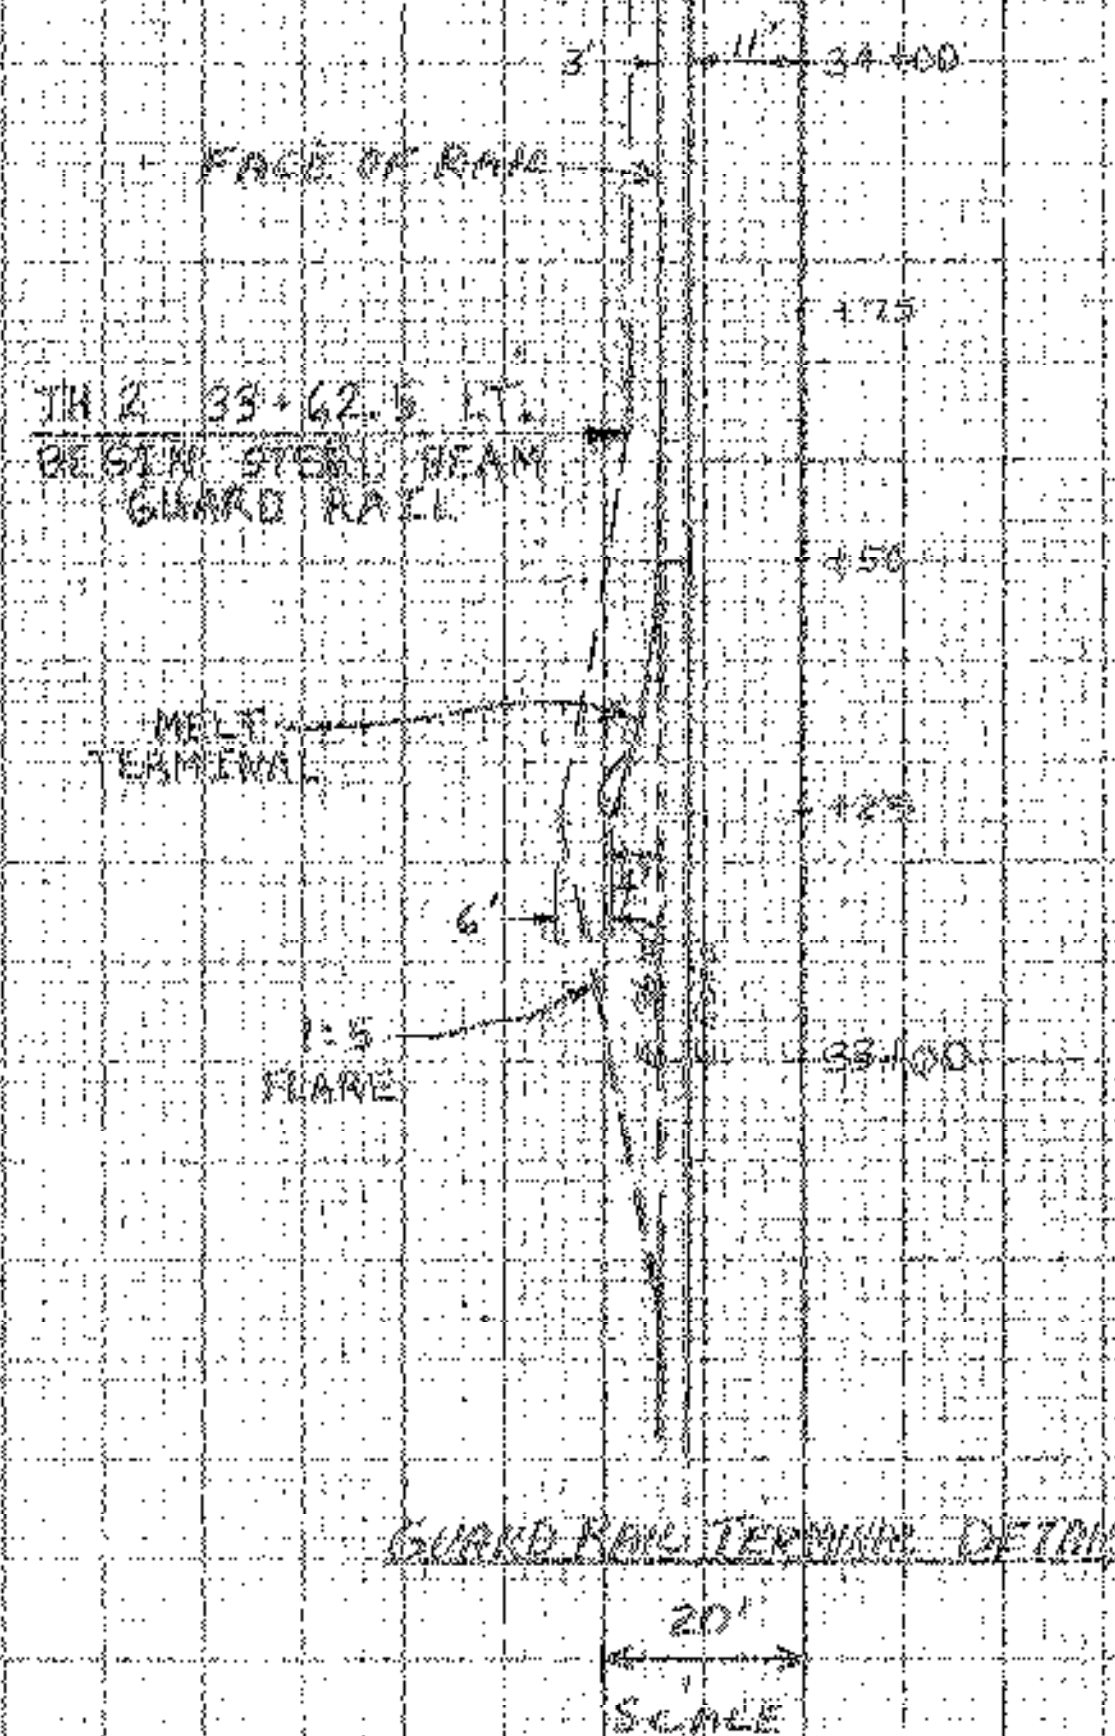

FROM STA.	33+50	TO STA.	34+00
PROJECT NAME	MORROW TOWN TUNNEL		
NO.	290167 (S)	DATE	06/09/86
SURVEYED BY	NYE	PLOTTED	JAN 1985
SHEET	266	OF	267 SHEETS

SCALE 1" = 10 FEET