


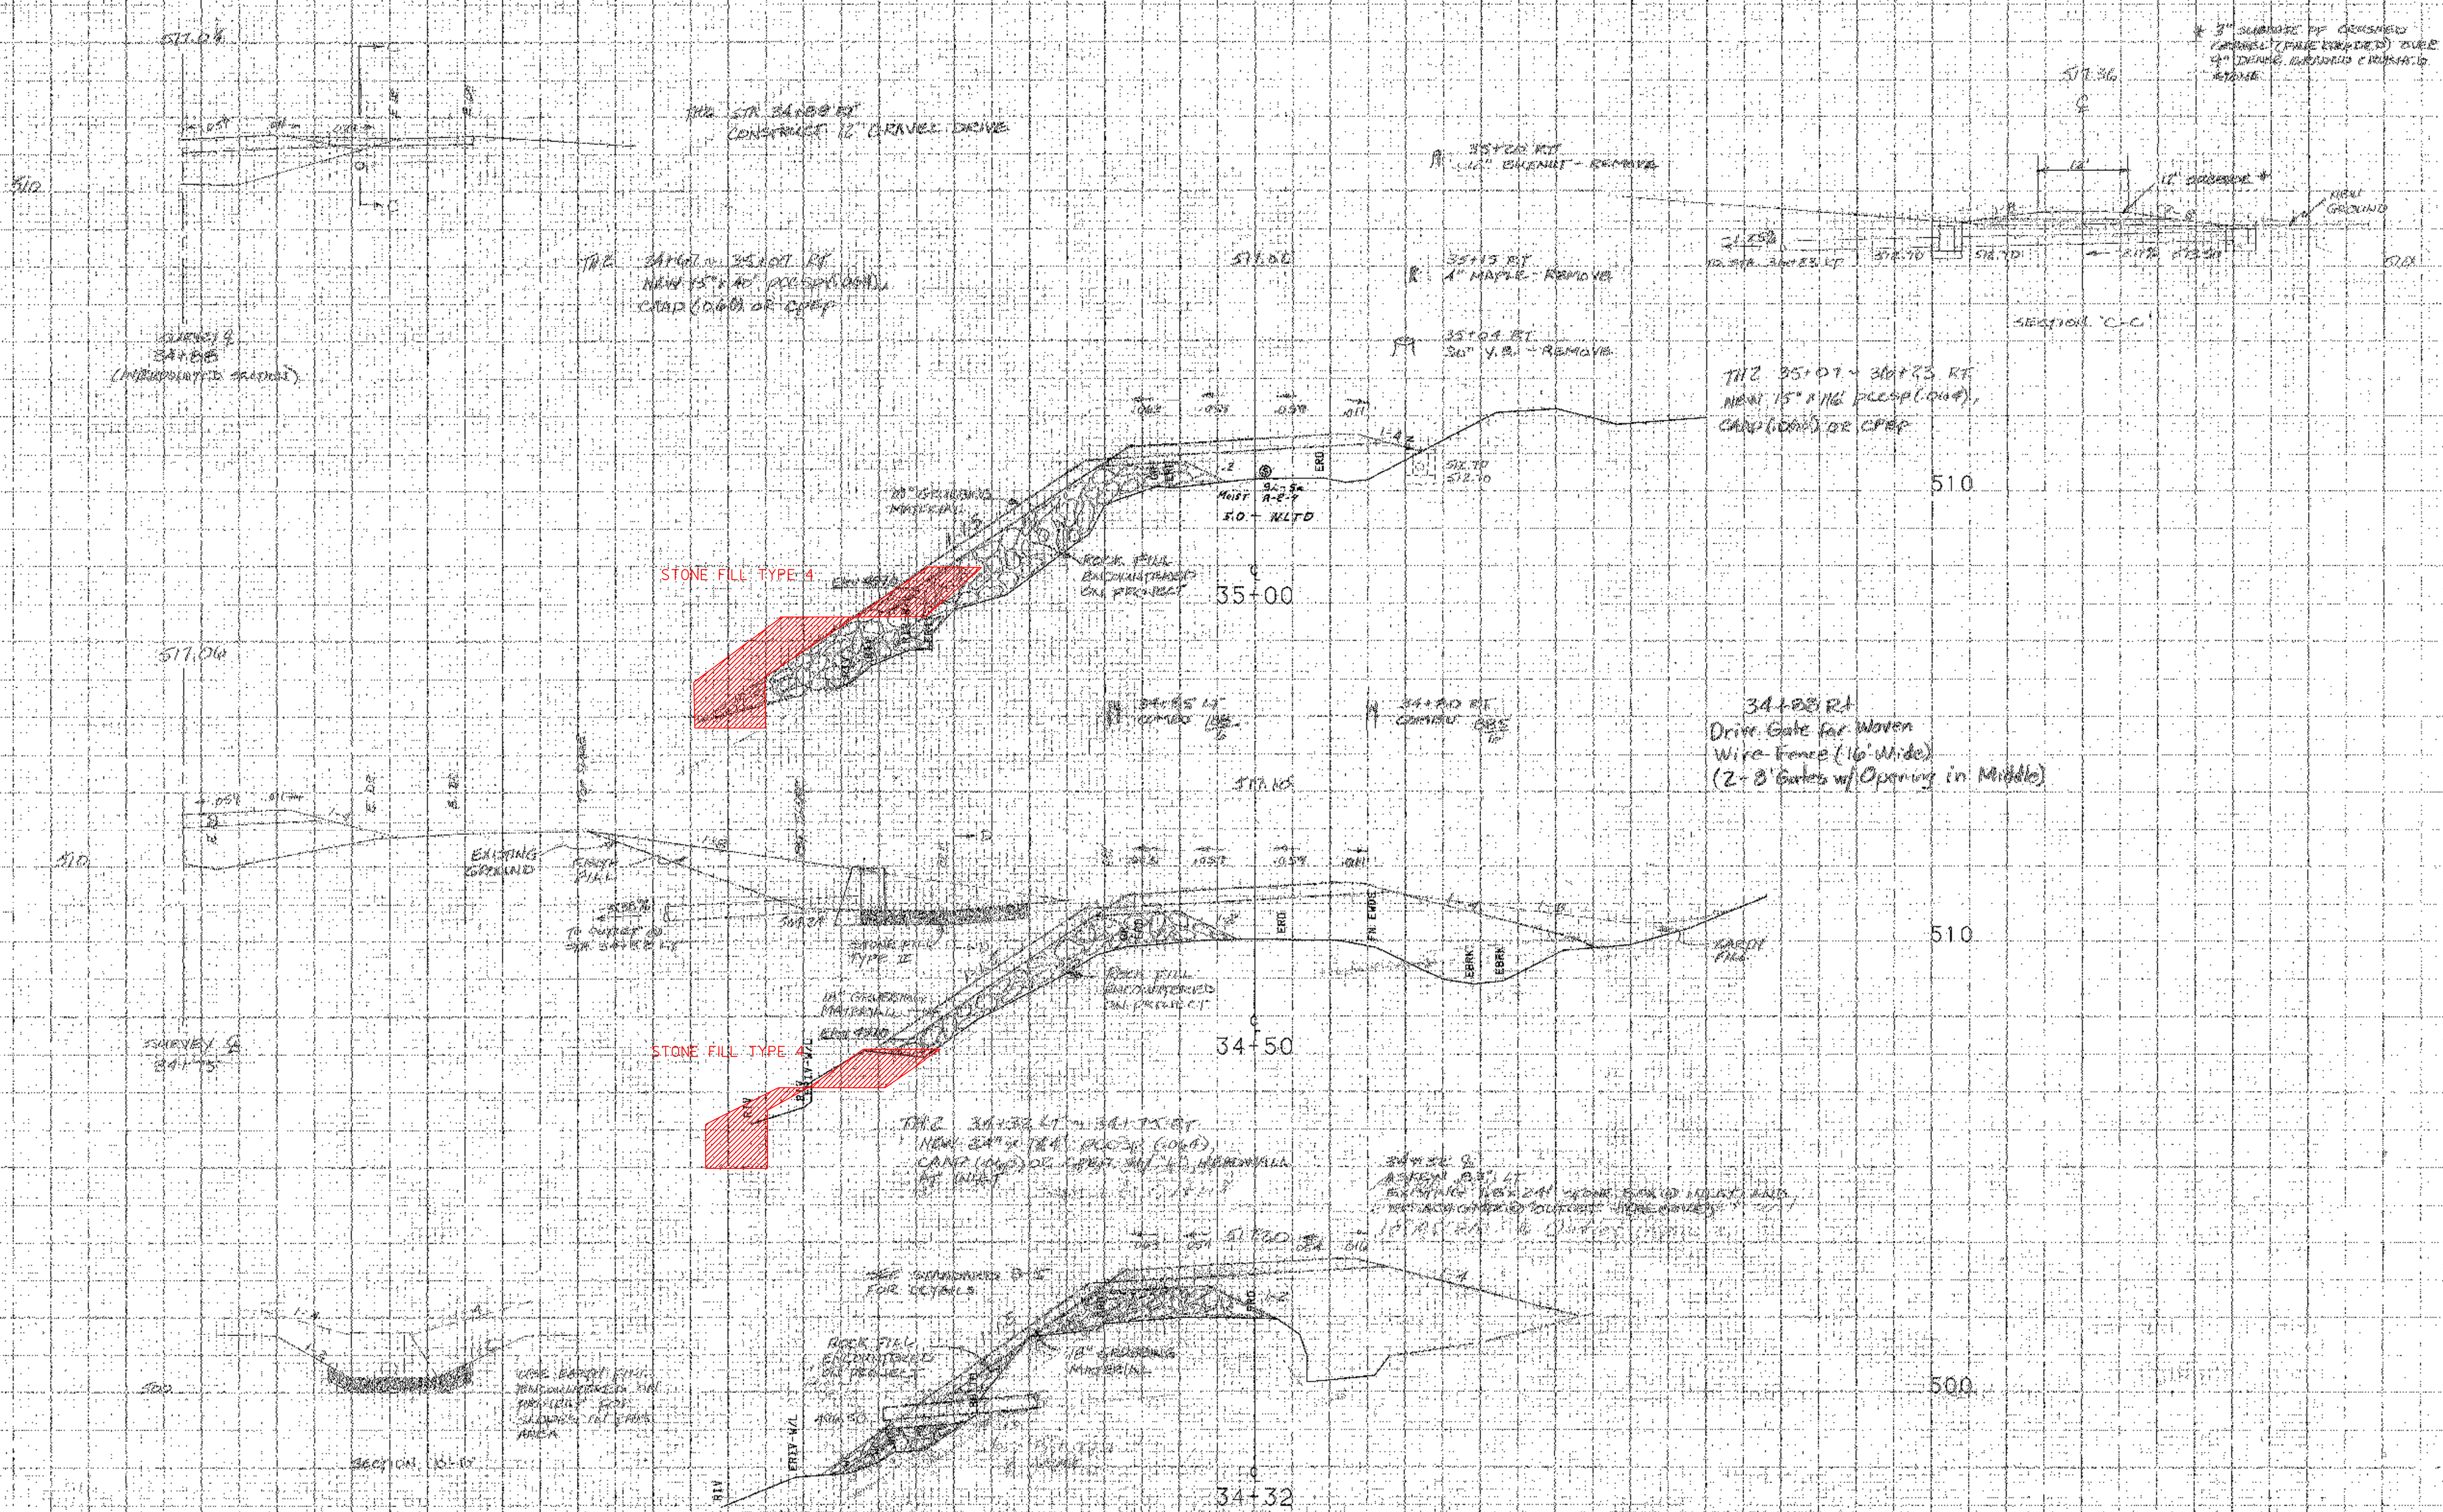

FROM STA.	34+32	TO STA.	35+00
PROJECT NAME	MORTON-HUBBARD CORP. TH2		
NO.	250000187 (9)	DATE	05/09/85
SURVEYED BY	NYE	DATE	JAN 1985
SHEET	250000187 (9)	SHEETS	1