
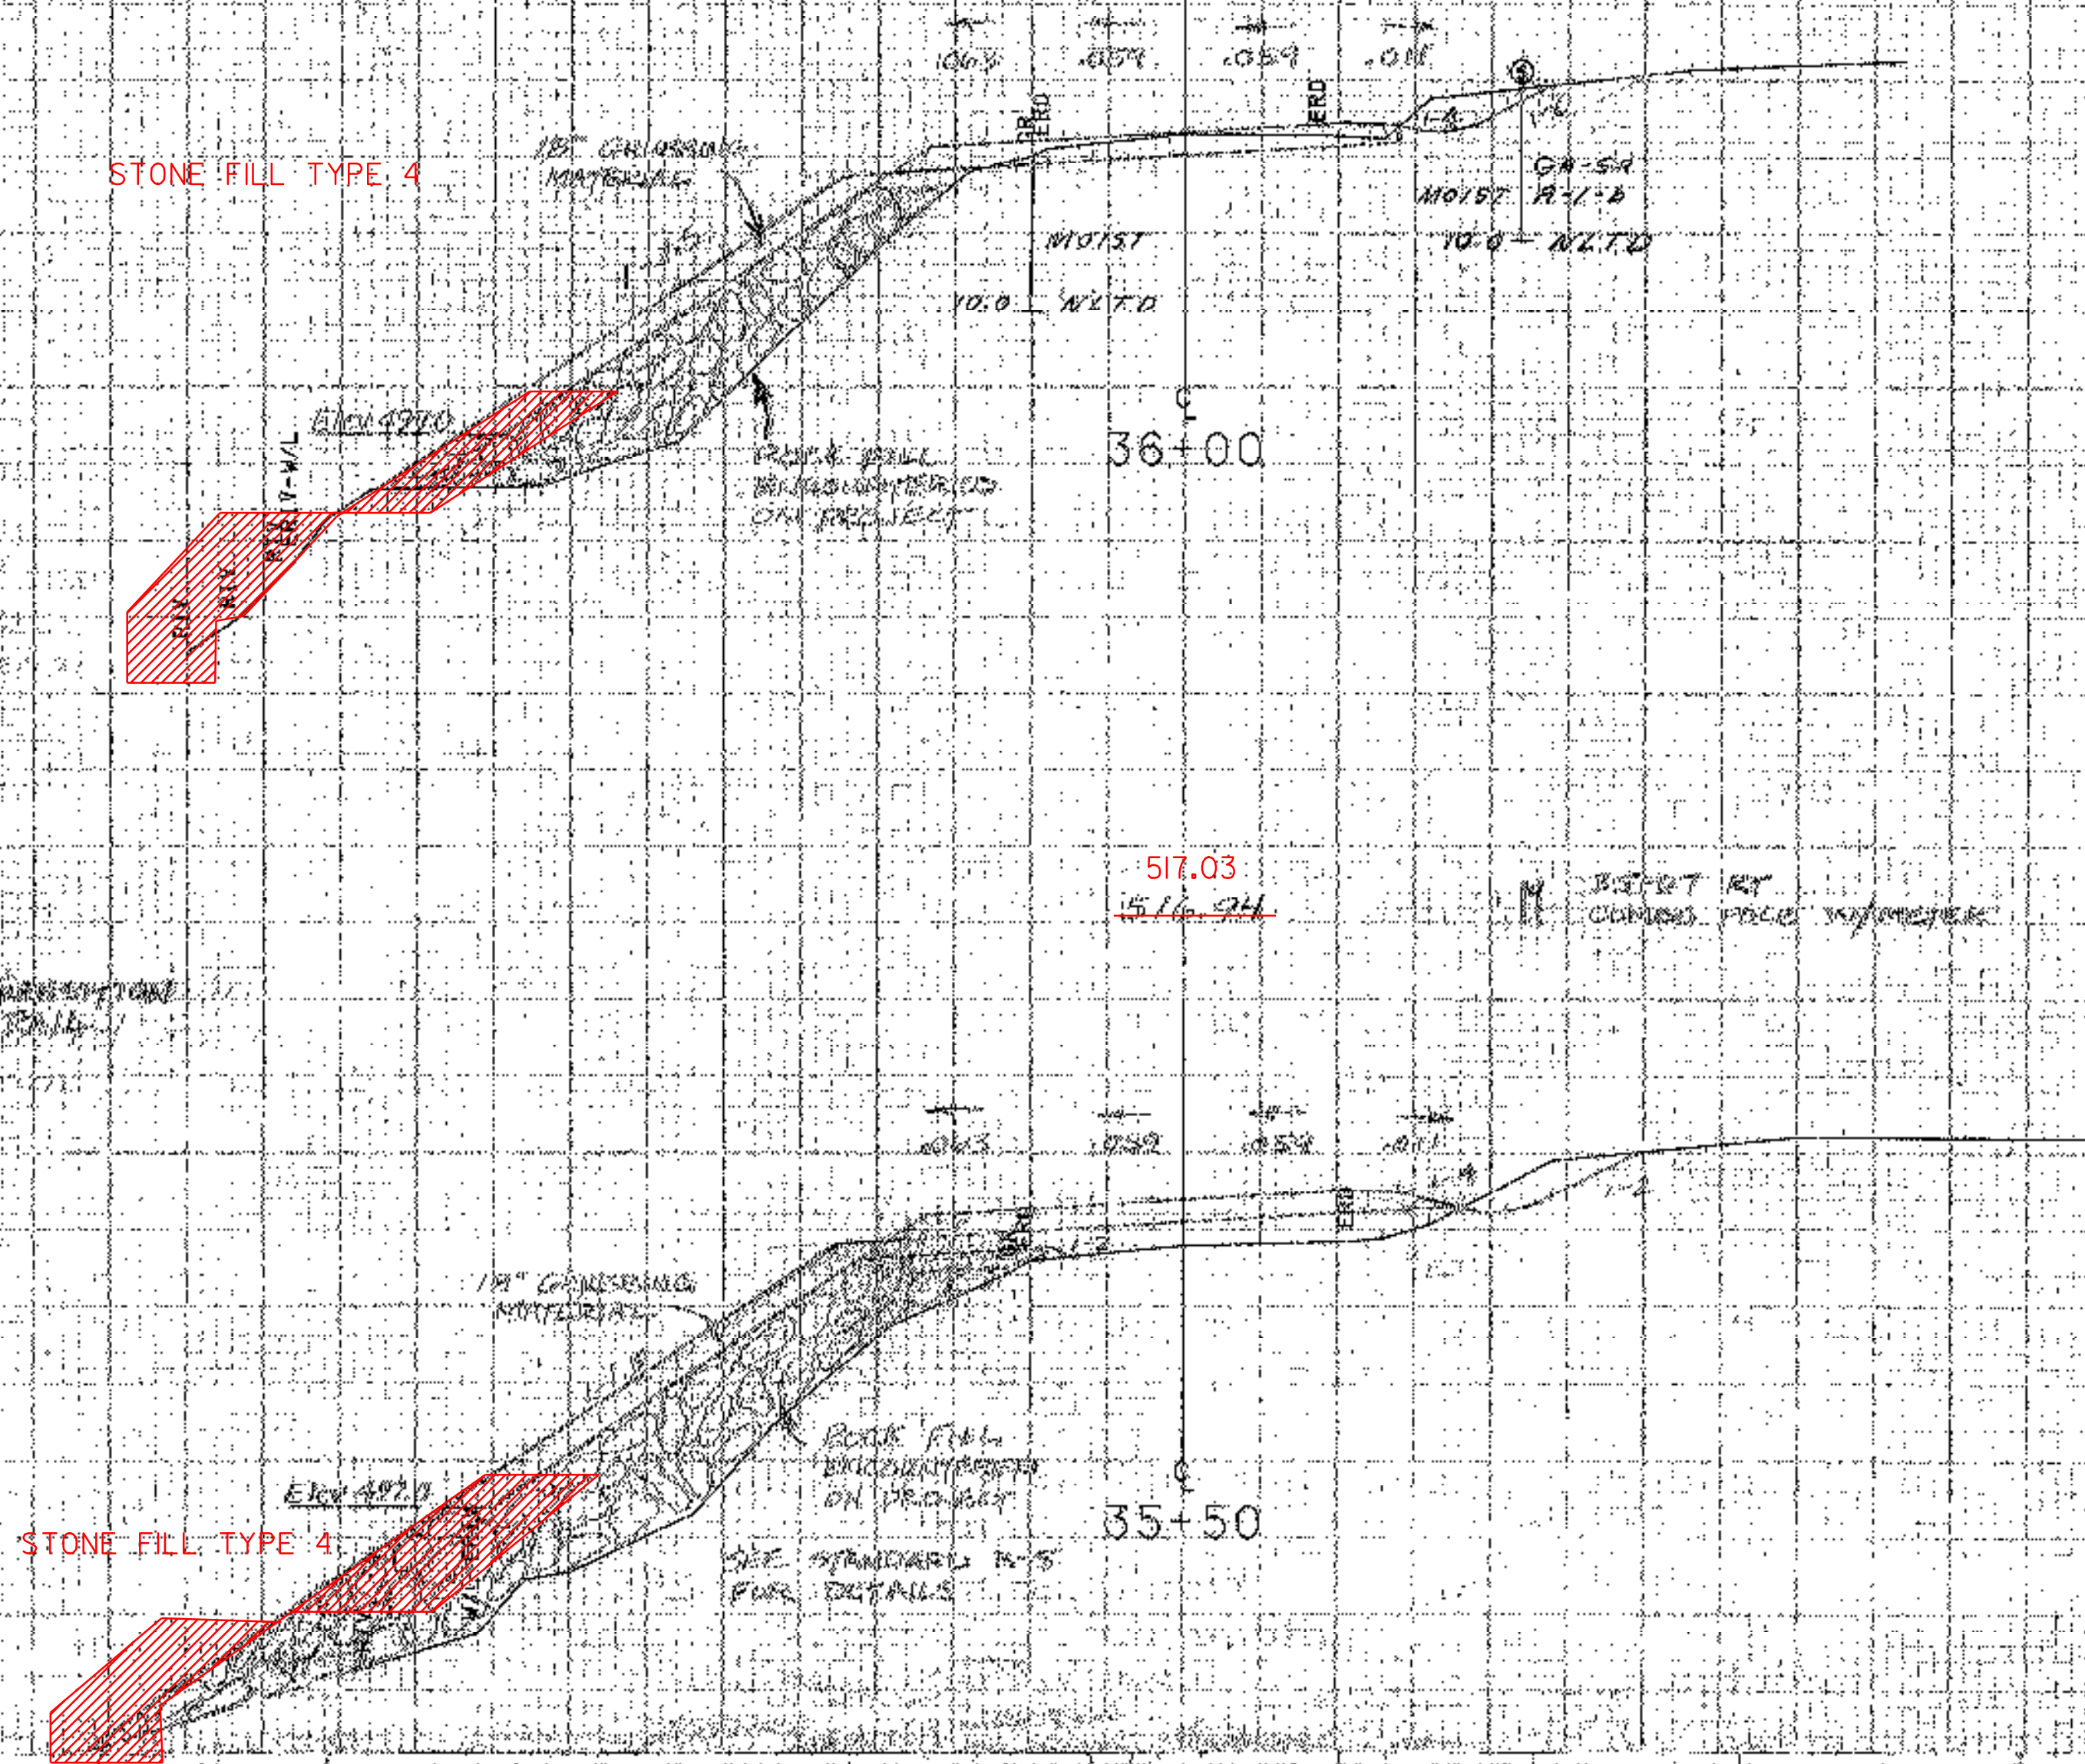
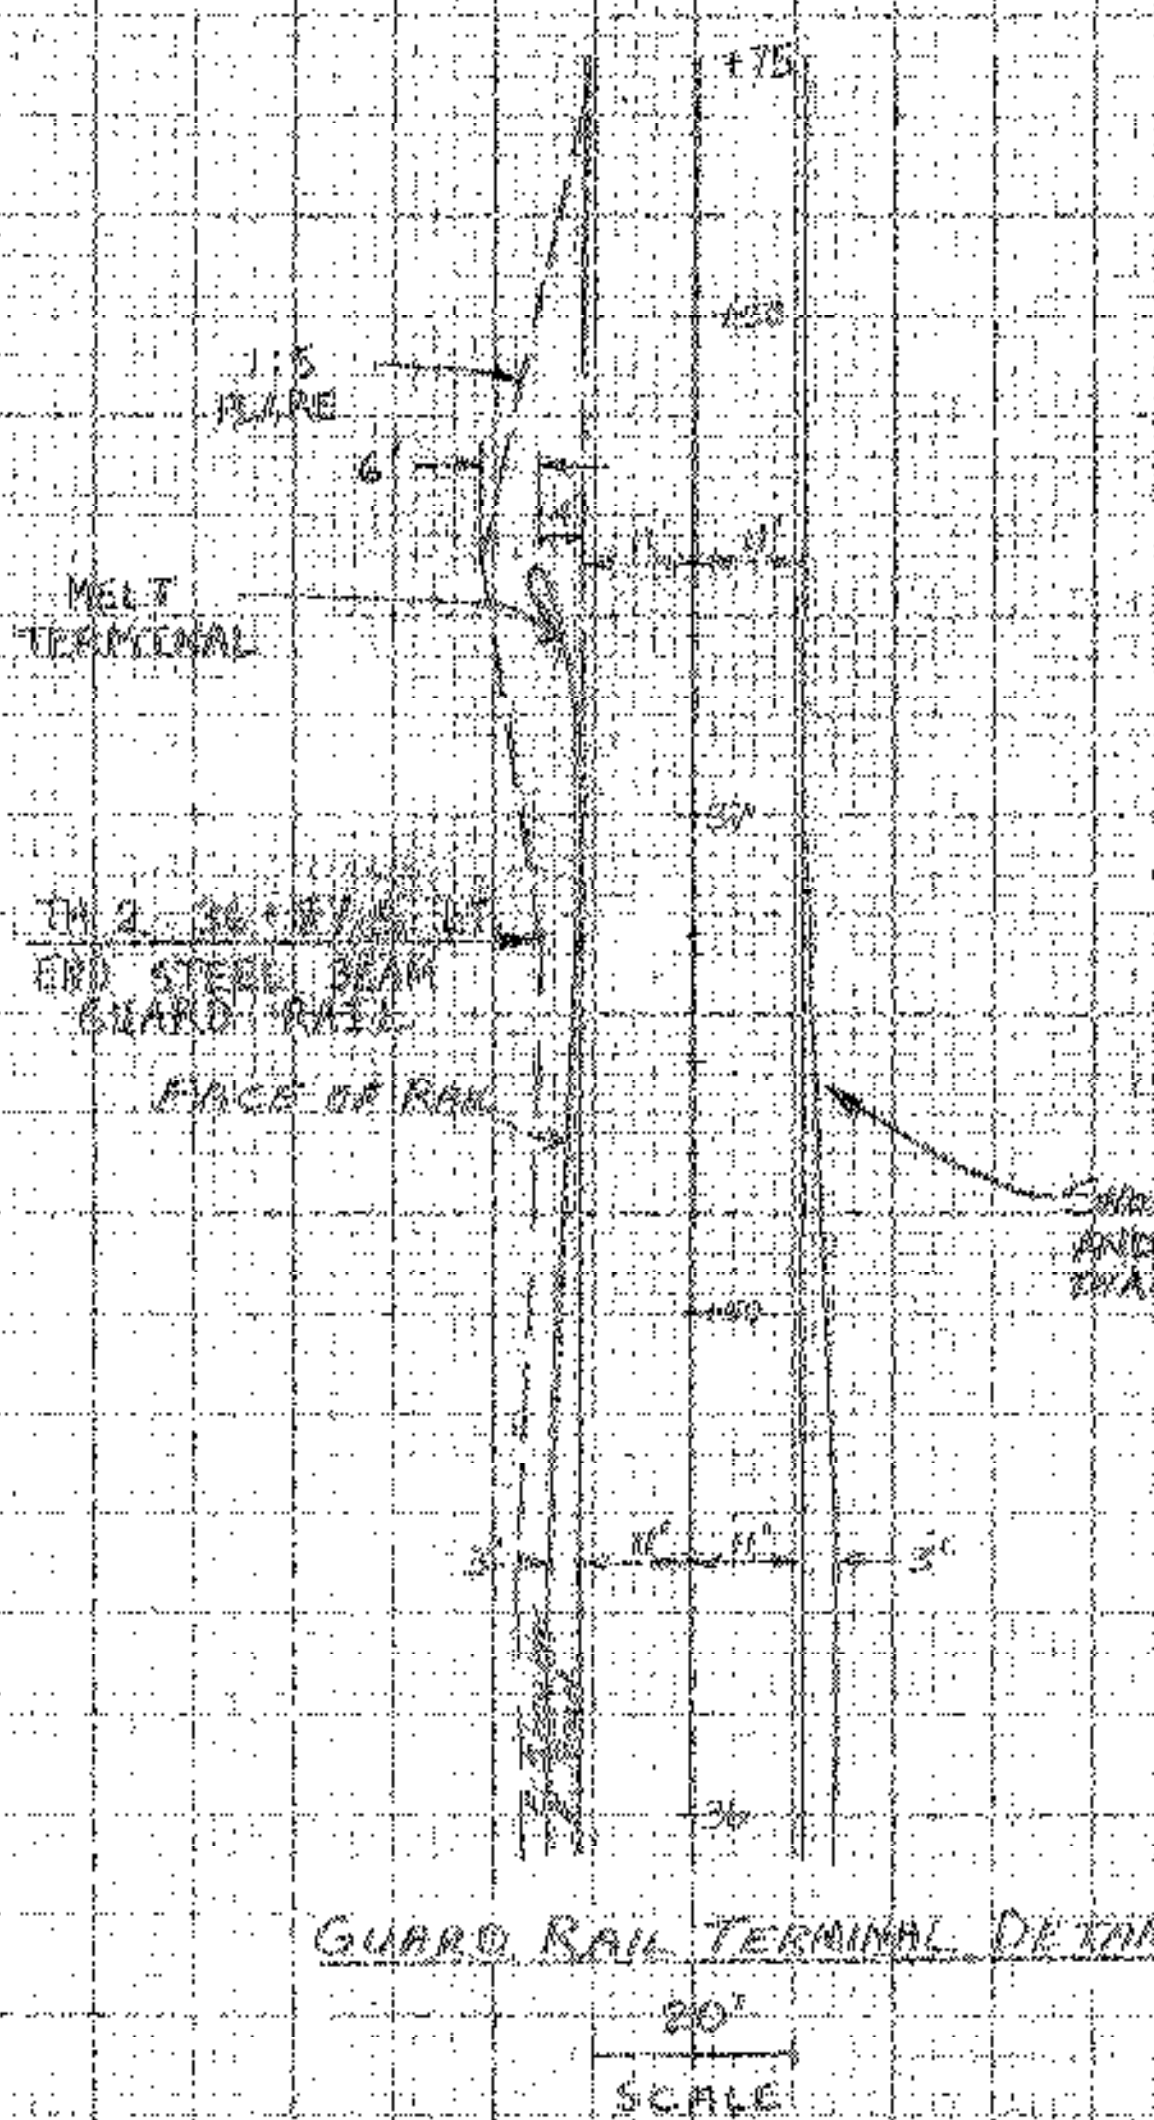
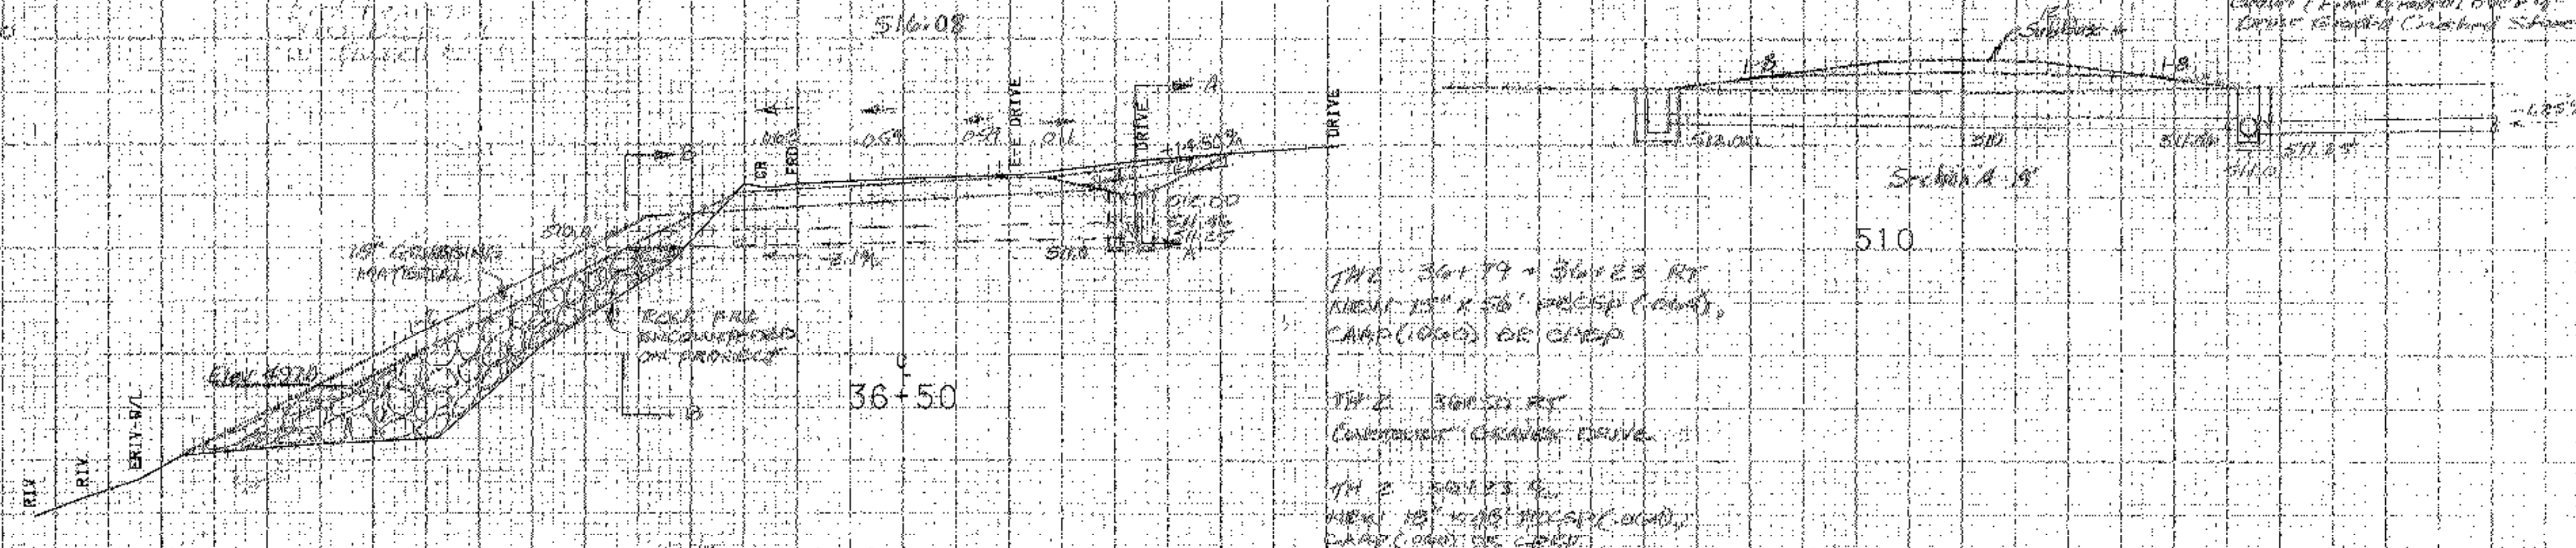


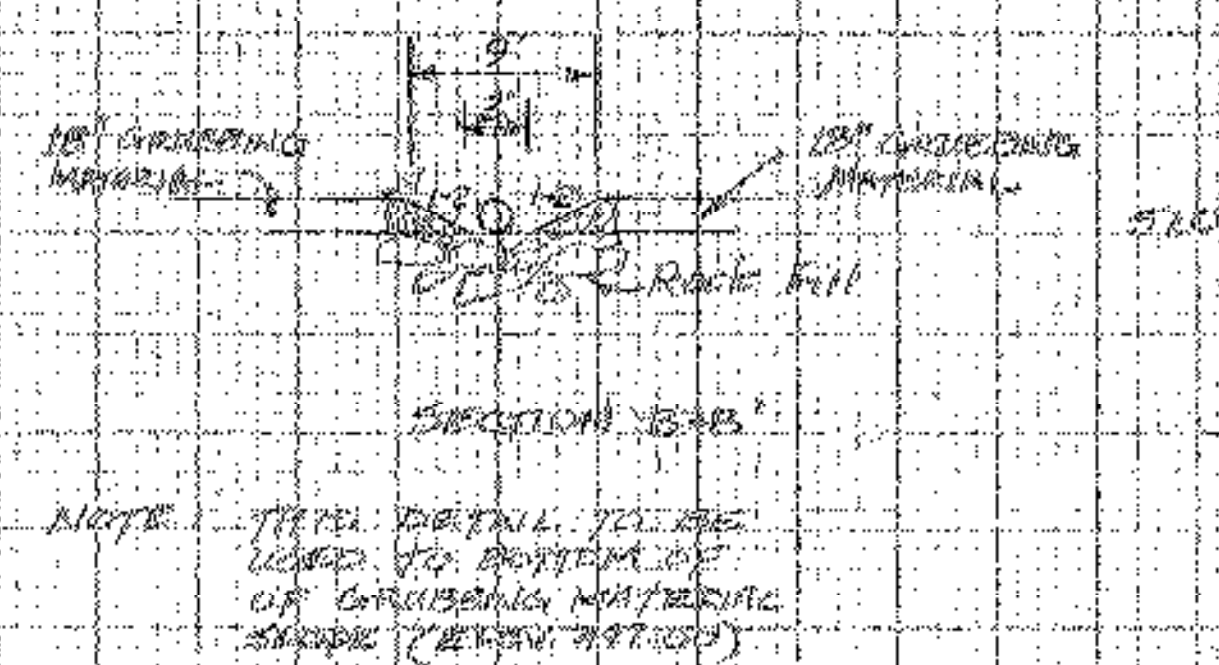

FROM STA.	35+50	TO STA.	36+50
PROJECT NAME	MORTOWN PLUMBING		
NO.	2	CURS	67 (9)
SURVEYED BY	NYE		
SHEET	126	OF	222 SHEETS
DATE	JAN 1985		