


520


REV. TH 12 20+34 ~ REV TH 12 22+98 LT  
CONSTRUCT SPECIAL DITCH  
W/ STONE FILL, TYPE II  
(PAY AS COMMON EXCAVATION)

REV TH 12 20+34 ~ 22+75 LT  
NEW 6" x 275 LF UNDERDRAIN  
W/ F.B. @ 22+75 LT

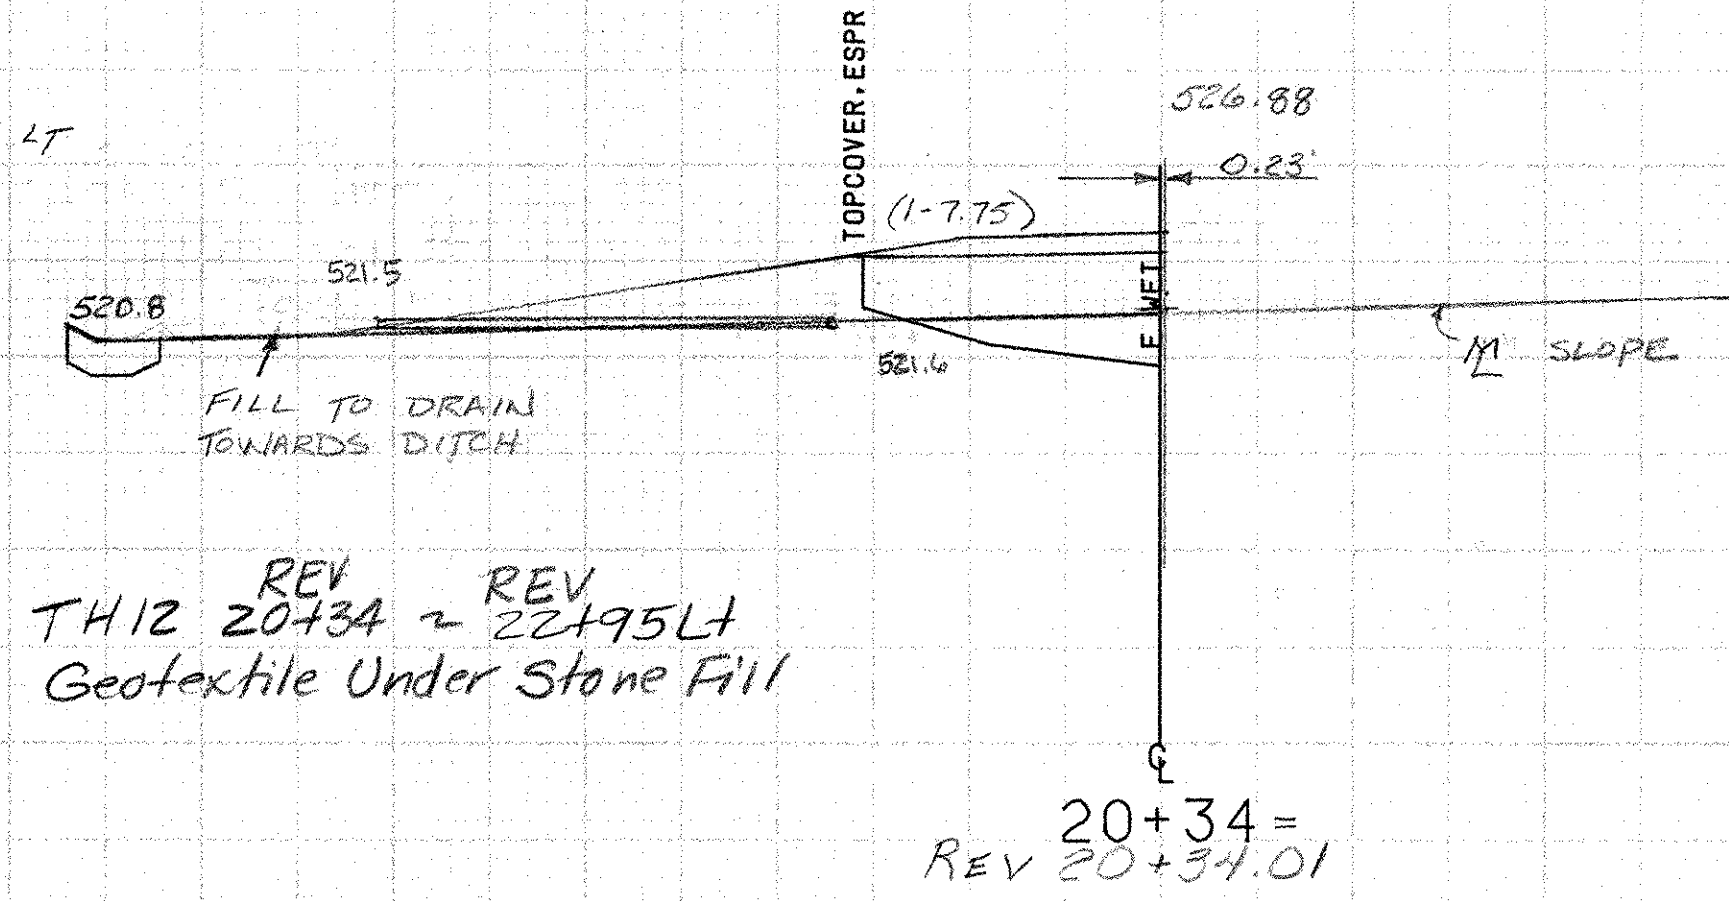

510

REV TH 12 20+34 ~ REV 22+95 LT  
Geotextile Under Stone Fill

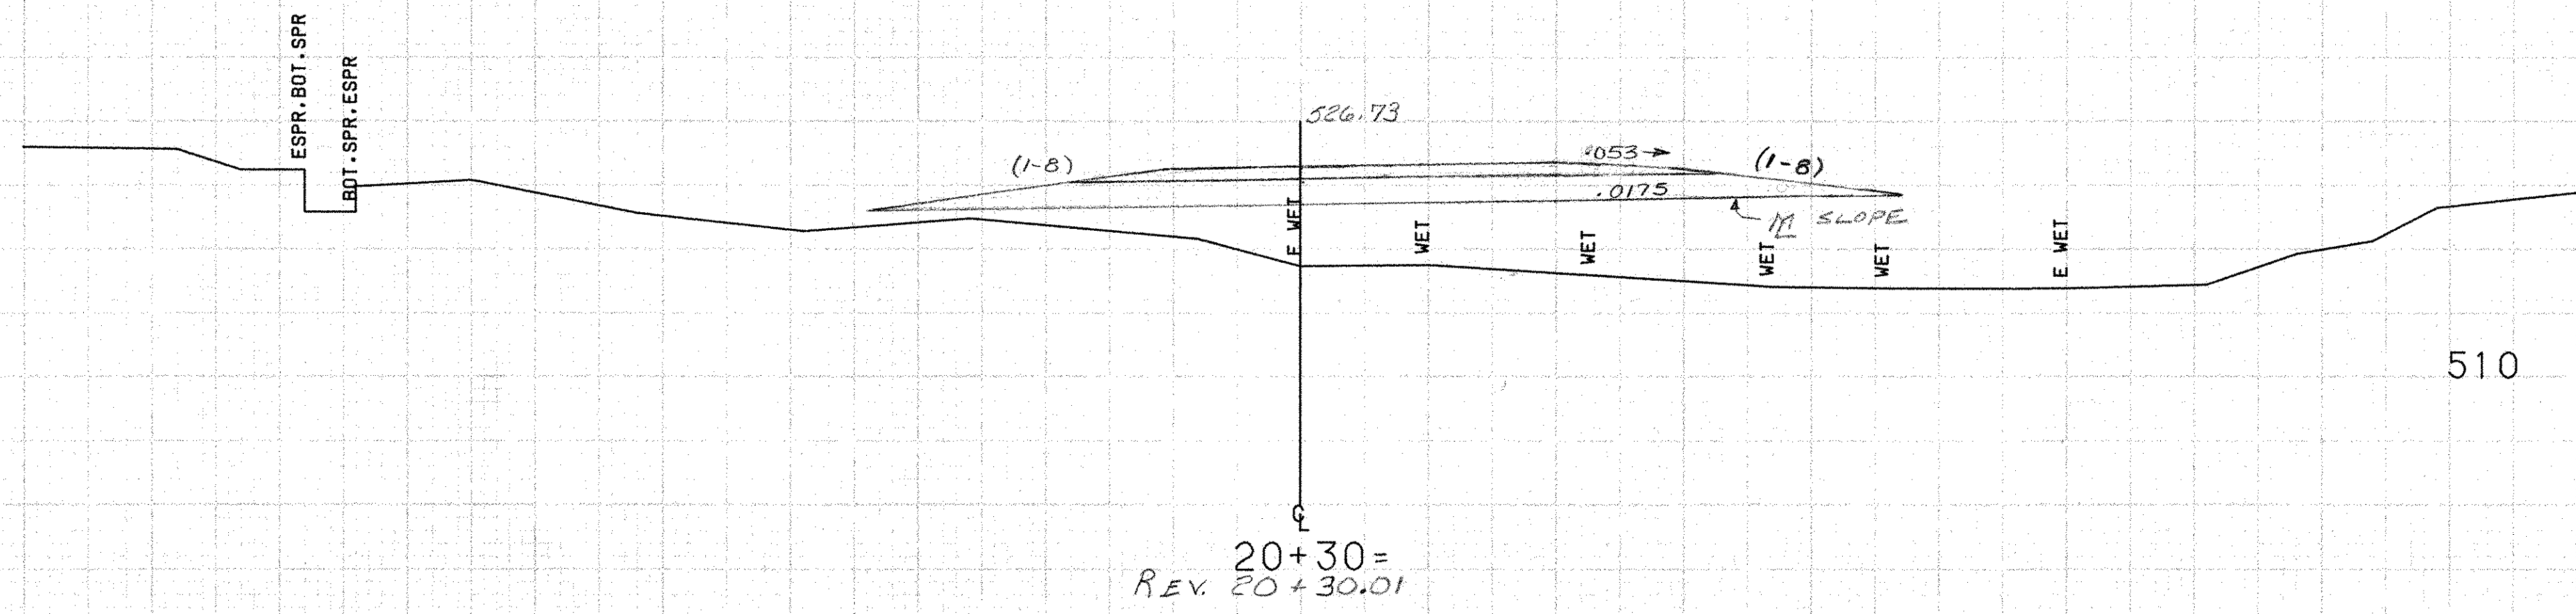

510

510

20+00.07

FROM STA. 20+00.07 TO STA. 20+43  
PROJECT NAME MORETOWN  
NO. R5EG(RS0167(9) TH#12 PLOTTED 10/07/86  
SURVEYED BY FANTONI SEPT 86  
SHEET 128 OF 243 SHEETS

SCALE 1" = 10 FEET