
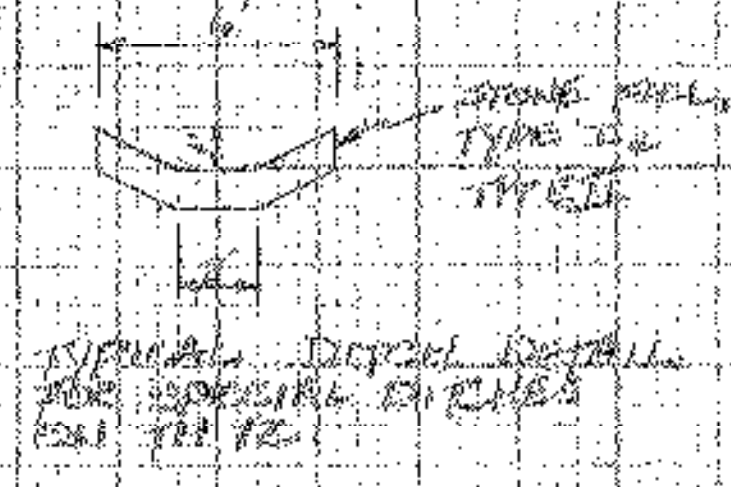


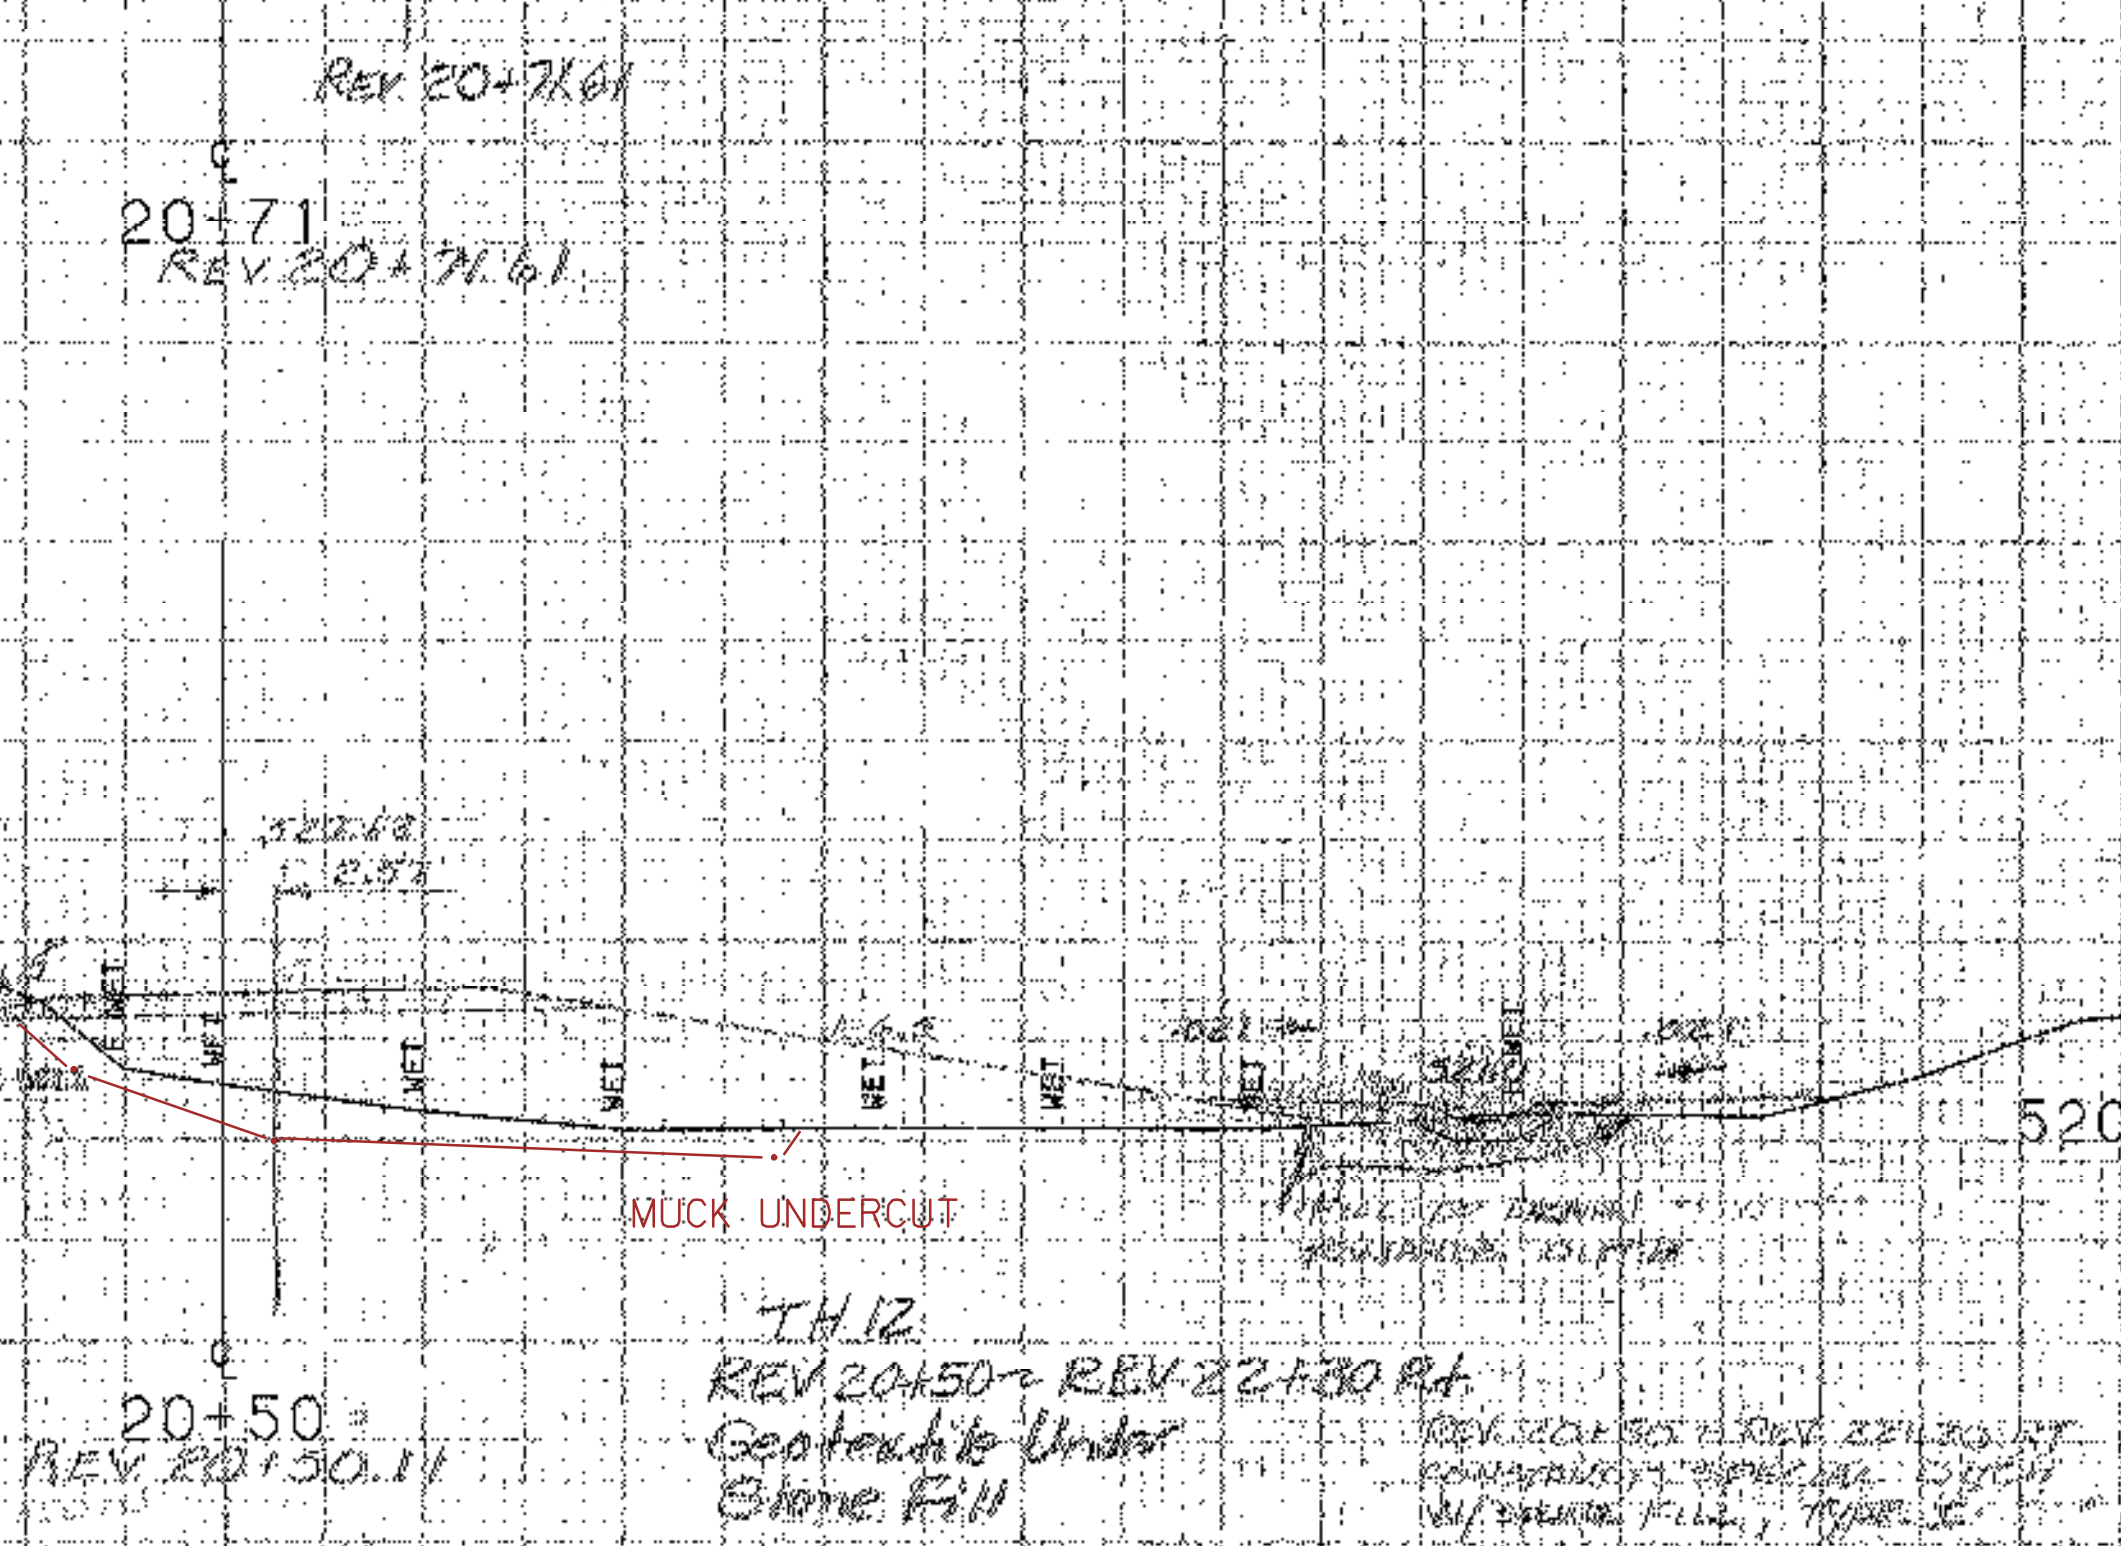

FROM STA. 20+50		TO STA. 20+93	
PROJECT NAME: MORETOWN		PLOTTED 10/07/86	
NO. 45350157 (9)		SEPT 86	
SURVEYED BY: FANTONI			
SHEET NO. 2 OF 23 SHEETS			