


529.00

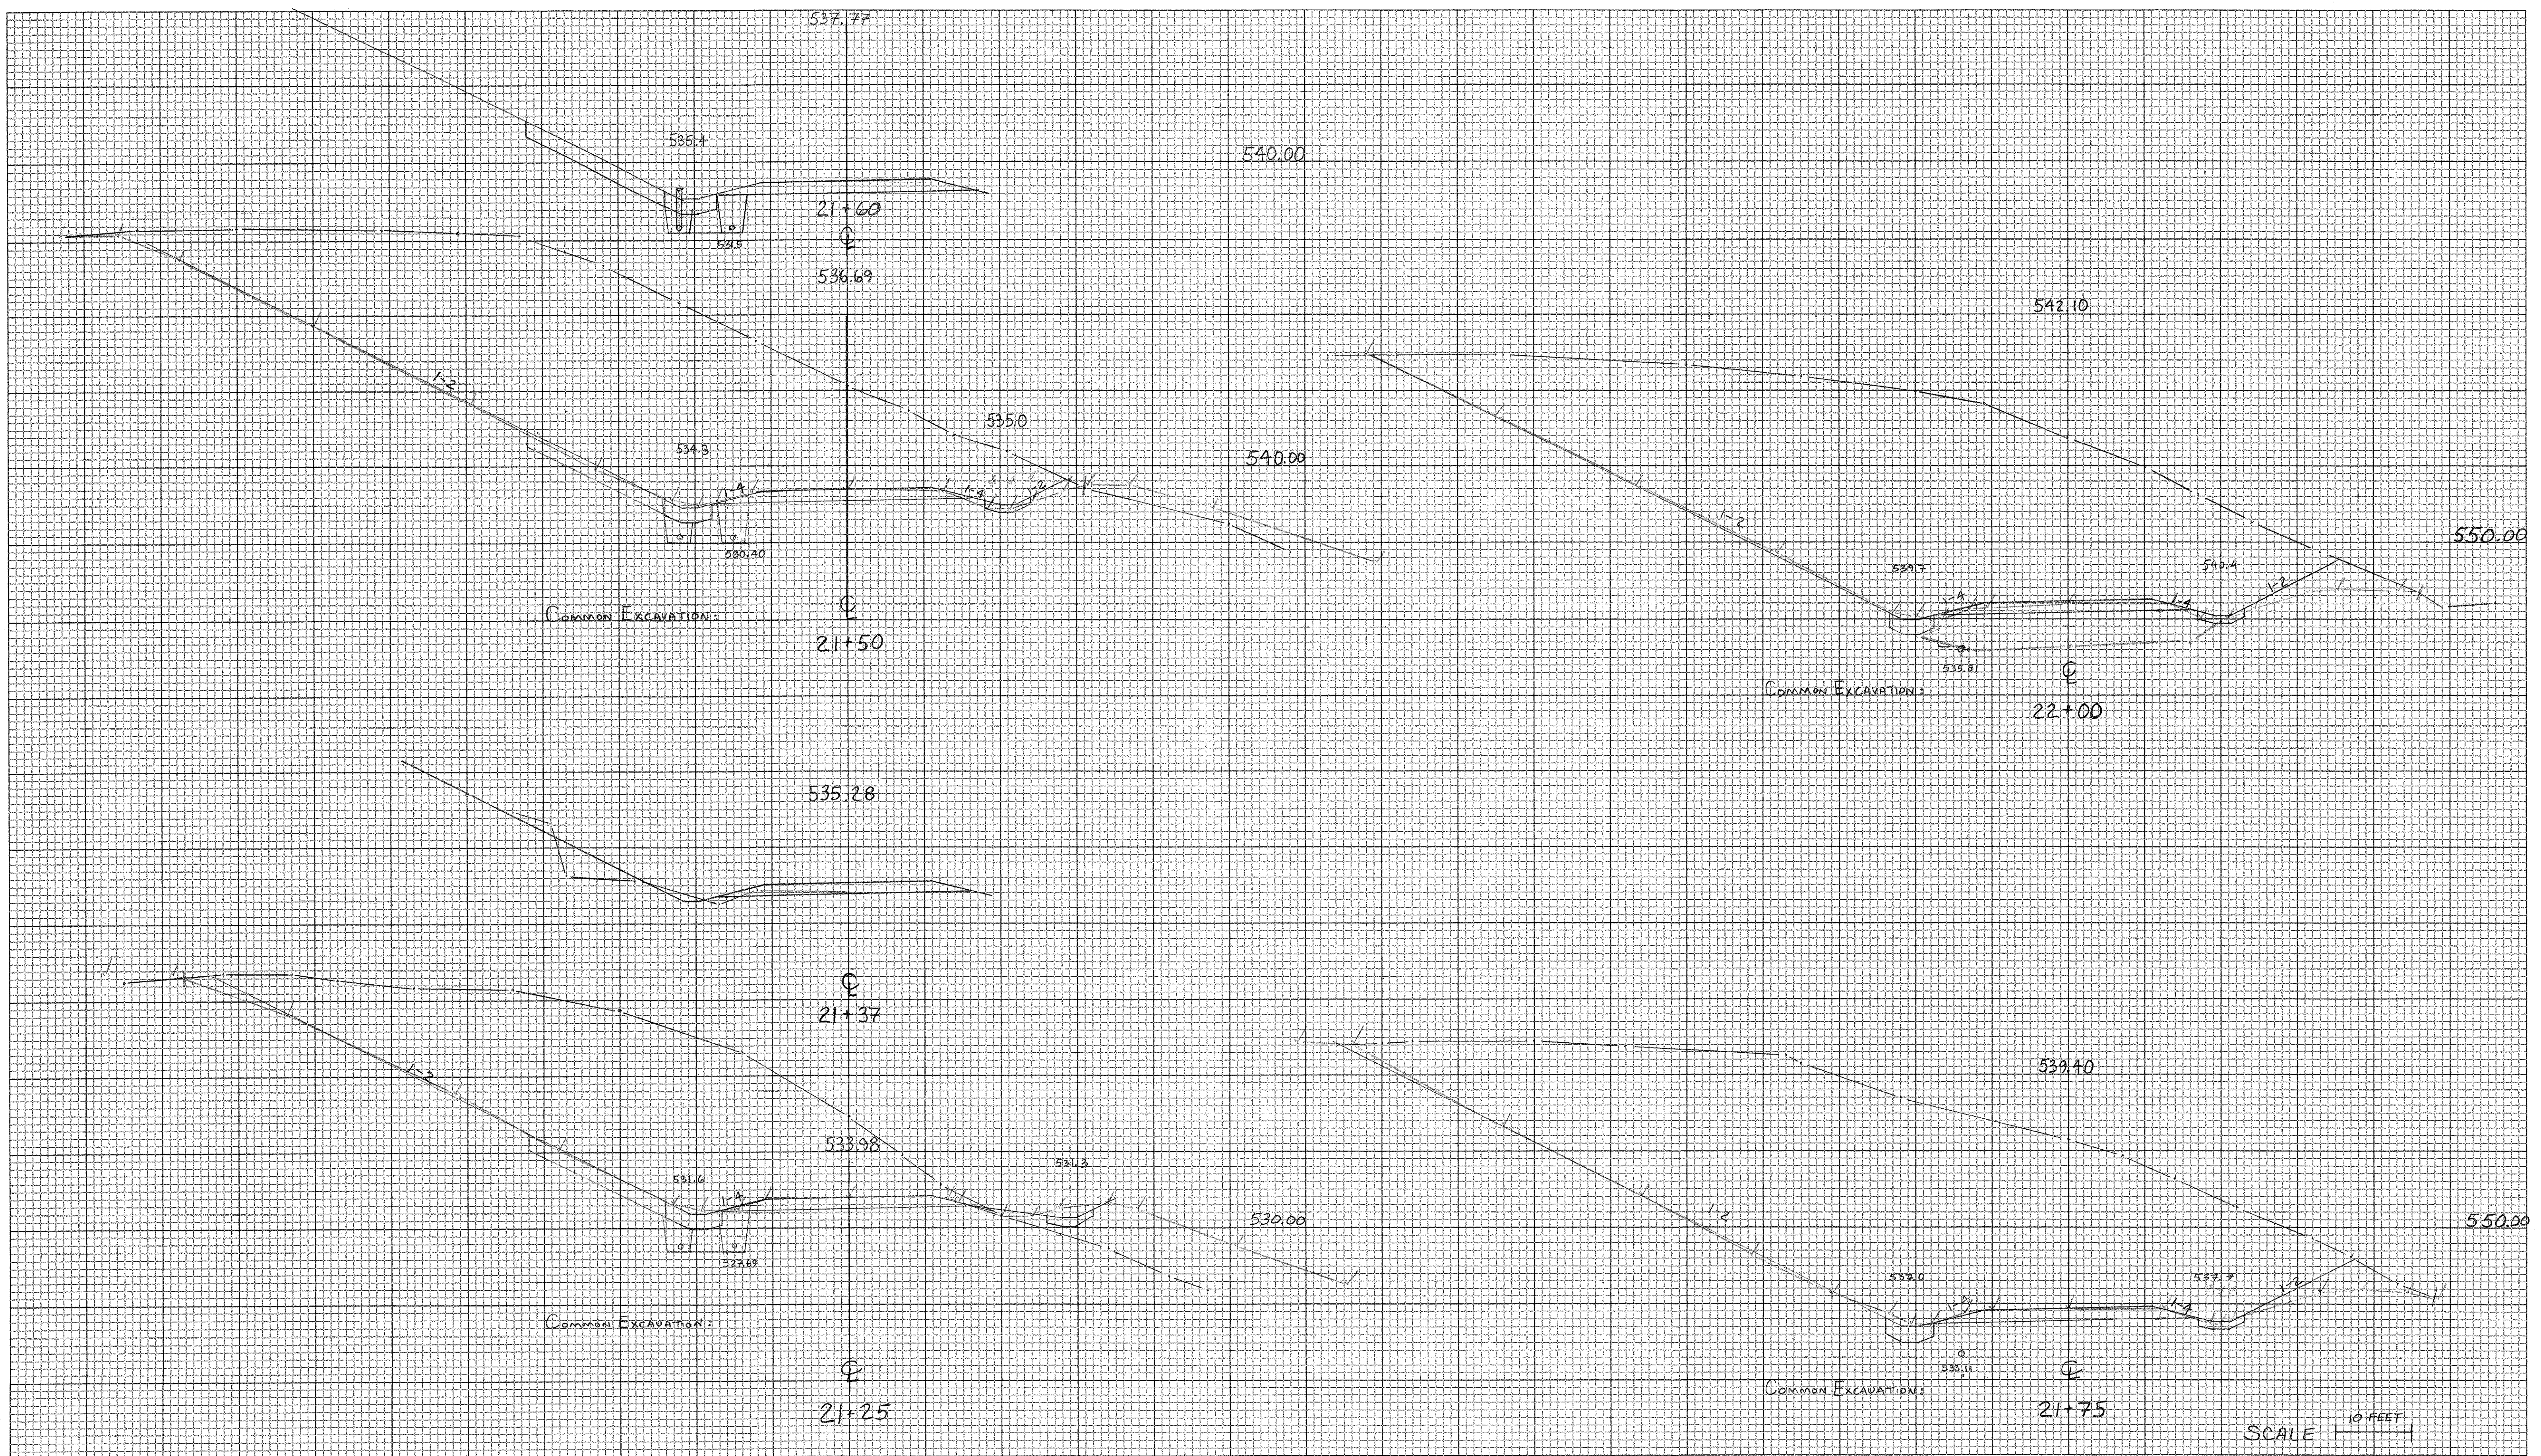

CROSS SECTION SHEET

PROJECT NAME: MORETOWN
 PROJECT NUMBER: RSEGC R50167(9)
 FILE NAME: TH# 12 PLOT DATE: 05-JUN-2000 09
 PROJECT LEADER: _____ DRAWN BY: STW 10-2-00
 DESIGNED BY: _____ CHECKED BY: _____
 const: g:/common/cadd/e-xsection.dgn SHEET 2 OF 5